

April 30, 2021

ADDENDUM NO. 2

TO THE CONTRACT DOCUMENTS

FOR

PACIFIC HIGH SCHOOL - NEW ADMINISTRATION BUILDING

FOR THE SAN BERNARDINO CITY UNIFIED SCHOOL DISTRICT 777 North F Street San Bernardino, CA 92410

DSA No. 04-119637 File No. 36-H7 RCA Job No. 1-78-28

NOTICE TO BIDDERS

This Addendum forms a part of the Contract and modifies the original documents DSA Approved on February 25, 2021. It is intended that all work affected by the following modifications shall conform with related provisions and general conditions of the contract of the original drawings and specifications. Modify the following items wherever appearing in any drawing or sections of the specifications. Acknowledge receipt of Addendum No. 2 in the space provided on the Bid Form. Failure to do so may subject bidder to disqualification.

GENERAL

Item No. 2.1 2.1.1	General Items: Construction duration is listed as "360 calendar days from receipt of NTP". See Agreement Form, Page 46 in Bid Specs.
2.1.2	NTP is anticipated 1-2 weeks after the Board Meeting. Therefore, tentative construction start date is week of June 14, 2021.
2.1.3	Reference Front End Bid Documents, a revised Attachment 1 – Bid Form will be available for bidder reference at Crisp Imaging public plan room website <u>www.crispimg.com</u>
2.1.4	Reference Front End Bid Documents, a revised Agreement Form will be available for bidder reference at Crisp Imaging public plan room website <u>www.crispimg.com</u>
2.1.5	Reference Front End Bid Documents, a revised Supplementary General Conditions will be available for bidder reference at Crisp Imaging public plan room website <u>www.crispimg.com</u>
2.1.6	Reference Front End Bid Documents, new document Exhibit 'A' – Phasing Plan of Site Work will be available for bidder reference at Crisp Imaging public plan room website <u>www.crispimg.com</u>
2.1.7	Contractor's Pre-Qualification List as of 4/29/2021, is available for bidder reference at District's website https://sbcusdfacilities.com/transforming-schools/bid-opportunities/

CHANGES TO THE SPECIFICATIONS

Item No. 2.2	Reference Section 07 26 16 – Under-Slab Vapor Retarder:
2.2.1	Replace in its entirety per attached revised Section 07 26 16.
ltem No. 2.3	Reference Section 07 54 00 – Thermoplastic Membrane Roofing:
2.3.1	Replace in its entirety per attached revised Section 07 54 00.
Item No. 2.4	Reference Section 27 10 00 – Voice Data Infrastructure:
2.4.1	Replace in its entirety per attached revised Section 27 10 00.
Item No. 2.5	Reference New Section 27 21 00 – Networking Electronics:
2.5.1	Add new section in its entirety per attached Section 27 21 00.
CHANGES TO TH	IE DRAWINGS
Item No. 2.6	Reference Sheet AS-1.0:
2.6.1	Revise per clouded areas of attached revised Sheet AS-1.0
Item No. 2.7	Reference Sheet AS-1.4
2.7.1	Revise per clouded areas of attached revised Sheet AS-1.4
\Item No. 2.8	Reference Sheet A-1.1:
2.8.1	Add new room signage per clouded area of attached Sketch ASK-2.1
Item No. 2.9 2.9.1	Reference Sheet A-4.1: Revise per clouded area of attached Sheet A-4.1: a. Revise window mullion pattern b. Revise plaster control joints
Item No. 2.10	Reference Sheet A-8.1:
2.10.1	Revise windows per clouded area of attached Sheet A-8.1.
Item No. 2.11	Reference Sheet AD-5.1:
2.11.1	Revise casework edge details per clouded areas of added revised Sheet AD-5.1
Item No. 2.12 2.12.1	 Reference Sheet M-0.2: Revise per clouded areas of attached revised Sheet M-0.2: a. Package gas-electric AC unit schedule: added notes 16 and 17 on the remarks and included it in areas where it applied. Revised note 15 to only be a temperature sensor. b. Exhaust fan schedule: added note 8 on the remarks and included it in areas where it applied. c. Zone damper schedule: added note 2 and 3 on the remarks and included it in areas where it applied. d. By-pass damper schedule: added note 1 on the remarks and included it in areas where it applied.
Item No. 2.13 2.13.1	 Reference Sheet M-1.2: Revise per clouded areas of attached revised Sheet M-1.2: a. Added construction note #6. b. Located control panel (CP-4) for hot water circulating pump in Cust. 119.
Item No. 2.14 2.14.1	 Reference Sheet M-1.3: Revise per clouded areas of attached revised Sheet M-1.3: a. Added construction note #6. b. Located control panel (CP-1, CP-2 and CP-3) for EMS router, exterior lighting and exhaust fan in Data 122.

- Item No. 2.15 Reference Sheet MD-2.1:
 - 2.15.1 Add new Wiring Diagram Details 8 & 9, per clouded areas of attached revised Sheet MD-2.1

- Item No. 2.16 Reference Sheet MD-3.1:
 - 2.16.1 Revise EMS per clouded areas of attached revised Sheet MD-3.1:
 - a. Revised EMS BACS riser diagram to include the 3 additional control panels and revised their actual location.
 - b. Revised VVT zone damper EMS detail to include note for when a temperature/CO2 sensor is required.
 - c. Included sequences of operations for zone dampers that include CO2.
 - d. Included sequences of operations for VVT rooftop occupied mode. Revised set points to District's standards
 - e. Removed set points tables as they are shown within the diagrams.
- Item No. 2.17 Reference Sheet MD-3.2:
 - 2.17.1 Revise EMS per clouded areas of attached revised Sheet MD-3.2:
 - a. Included sequences of operations for 3-cool/2-heat stage rooftop occupied mode. Revised set points to District's standards
 - b. Included sequences of operations for 2-cool/1-heat stage rooftop occupied mode. Revised set points to District's standards
 - c. Removed set points tables as they are shown within the diagrams.
 - d. Removed CO2 portion of sequences of operations for both units since it does not apply.
 - e. Added circulating pump and exterior lighting controls details. Revised exhaust fan control detail.
- Item No. 2.18 Reference Sheet P-0.2:
 - 2.18.1 Revise per clouded areas of attached revised Sheet P-0.2:
 - a. Circulating pump schedule: added note 1 on the remarks.
- Item No. 2.19 Reference Sheet P-7.1:
 - 2.19.1 Revise per clouded areas of attached revised Sheet P-7.1:
 - a. Added construction note #8.
 - b. Included location of circulating pump control panel in Cust 119.
- Item No. 2.20 Reference Sheet PD-1.2:
 - 2.20.1 Revise per clouded areas of attached revised Sheet PD-1.2:
 - a. Detail 1, revised EMS detail callout for circulating pump to 2/MD-3.2.
- Item No. 2.21 Reference Sheet E3.1:
 - 2.21.1 Revise power for mechanical & plumbing panels, per clouded areas of attached revised Sheet E3.1
- Item No. 2.22 Reference Sheet E4.1:
 - 2.22.1 Revise per clouded areas of attached revised Sheet E4.1:
 - a. Added Keynote #10, for data connection to "Aiphone" camera/receiver
 - b. Revised quantity of data ports in offices
- Item No. 2.23 Reference Sheet E4.2:
 - 2.23.1 Revised riser diagram to remove OFOI note for Network switches, per clouded areas of attached revised Sheet E4.2

Item No. 2.24 Reference Sheet E4.4:

- 2.24.1 Revised Communications details to remove horizontal wire managers and WAPs to be CFCI, per clouded areas of attached revised Sheet E4.4
- Item No. 2.25 Reference Sheet E6.1:
 - 2.25.1 Added power connections to all zone/bypass dampers, per clouded areas of attached revised Sheet E6.1
- Item No. 2.26 Reference Sheet E6.2:
 - 2.26.1 Added zone and bypass dampers to schedule, per clouded areas of attached revised Sheet E6.2

Item No. 2.27Reference Sheet E9.1:2.27.1Revised Panel Schedule AB, per clouded areas of attached revised Sheet E9.1

ATTACHMENTS	
Exhibits	N/A
General	N/A
Specifications	07 26 16, 07 54 00, 27 10 00, 27 21 00
Sketches	ASK-2.1
Sheets	AS-1.0, AS-1.4, A-4.1, A-8.1, AD-5.1, M-0.2, M-1.2, M-1.3, MD-2.1, MD-3.1, MD-3.2, P-0.2, P-7.1,
	PD-1.2, E3.1, E4.1, E4.2, E4.4, E6.1, E6.2, E9.1

END OF ADDENDUM NO. 2

Roger Clarke, Principal #C-21340

Attachment 1 - Bid Form

SAN BERNARDINO CITY UNIFIED SCHOOL DISTRICT

Project:	PACIFIC HIGH SCHOOL – NEW ADMINISTRATION		
Project Address:	Pacific High School, 1020 Pacific Street, San Bernardino CA		
	Bid No. F21-03		
CONTRACTOR NAME:			
DIR REGISTRATION NUMBER:			
ADDRESS:			
TELEPHONE:	_()		
FAX:	_()		
EMAIL:			

- TO: SAN BERNARDINO CITY UNIFIED SCHOOL DISTRICT, acting by and through its Governing Board, herein called "DISTRICT".
- 1. Pursuant to and in compliance with your Notice Inviting Bids and other documents relating thereto, the undersigned bidder, having familiarized himself with the terms of the contract, the local conditions affecting the performance of the contract, the cost of the work at the place where the work is to be done, with the drawings and specifications, and other contract documents, hereby proposes and agrees to perform within the time stipulated, the contract, including all of its component parts, and everything required to be performed, including its acceptance by the DISTRICT, and to provide and furnish any and all labor, materials, tools, expendable equipment, and utility and transportation services necessary to perform the contract and complete all of the work in a workmanlike manner required in connection with the construction of:

Bid No. F21-03 PACIFIC HS - NEW ADMINISTRATION

In the DISTRICT described above, all in strict conformance with the drawings and other contract documents on file at the Purchasing Office of said DISTRICT for amounts set forth herein.

2. <u>Bidder acknowledges the following Addenda:</u>

Addenda Number:	Addenda Number:	Addenda Number:	Addenda Number:	Addenda Number:
A (Inc. in Bid Set)				

3. <u>Total Base Bid</u>

A.	Base Bid	(\$		_)
B.	Allowance #1 General	(\$	200,000.00	_)
C.	Allowance #2 Solar Carport Removal	(\$	460,000.00	_)

TOTAL PRICE – ENTIRE JOB (Base Bid A + Allowance B + Allowance C)

TOTAL CASH PURCHASE PRICE IN WORDS & NUMBERS:

	DOLLARS
(\$)

4. <u>Alternate Bids:</u> N/A

5. <u>Time for Completion</u>:

The DISTRICT may give a notice to proceed within ninety (90) days of the award of the bid by the DISTRICT. Once the CONTRACTOR has received the notice to proceed, the CONTRACTOR shall complete the work in the time specified in the Agreement. By submitting this bid, CONTRACTOR has thoroughly studied this Project and agrees that the time period for this Project was adequate for the timely and proper completion of the Project. Further, CONTRACTOR has included in the analysis of the time required for this Project, Rain Days, Governmental Delays, and the requisite time to complete Punch List.

In the event that the DISTRICT desires to postpone giving the notice to proceed beyond this ninety (90) day period, it is expressly understood that with reasonable notice to the CONTRACTOR, giving the notice to proceed may be postponed by the DISTRICT. It is further expressly understood by the CONTRACTOR, that the CONTRACTOR shall not be entitled to any claim of additional compensation as a result of the postponement of giving the notice to proceed.

If the CONTRACTOR believes that a postponement will cause a hardship to it, the CONTRACTOR may terminate the contract with written notice to the DISTRICT within ten (10) days after receipt by the CONTRACTOR of the DISTRICT's notice of postponement. Should the CONTRACTOR terminate the contract as a result of a notice of postponement, the DISTRICT shall have the authority to award the contract to the next lowest responsible bidder, if applicable.

It is understood that the DISTRICT reserves the right to reject any or all bids and/or waive any irregularities or informalities in this bid or in the bid process. The CONTRACTOR understands that it may not withdraw this bid for a period of ninety (90) days after the date set for the opening of bids.

6. Bid Security:

Attached is bid security in the amount of not less than ten percent (10%) of the total bid:

Bid bond (10% of the Bid), certified check, or cashier's check (circle one)

7. <u>Designated Subcontractors</u>:

The required List of Designated Subcontractors is attached hereto.

8. Non-Collusion Declaration

The required is attached hereto.

9. <u>Substitution Request Form</u>:

The Substitution Request Form, if applicable, is attached hereto.

10. Acceptance:

It is understood and agreed that if written notice of the acceptance of this bid is mailed, telegraphed, or delivered to the undersigned after the opening of the bid, and within the time this bid is required to remain open, or at any time thereafter before this bid is withdrawn, the undersigned will execute and deliver to the DISTRICT a contract in the form attached hereto in accordance with the bid as accepted, and that he will also furnish and deliver to the DISTRICT the Performance Bond and Payment Bond, all within **five (5) calendar days** after award of contract, and that the work under the contract shall be commenced by the undersigned bidder, if awarded the contract, by the start date provided in the DISTRICT's Notice to Proceed, and shall be completed by the CONTRACTOR in the time specified in the contract documents.

11. Notices:

All notices or other correspondence should be addressed to the undersigned at the address stated below:

The names of all persons interested in the foregoing proposal as principals are as follows:

(IMPORTANT NOTICE: If bidder or other interested person is a corporation, state the legal name of such corporation, as well as the names of the president, secretary, treasurer, and manager thereof; if a co-partnership, state the true names of the firm, as well as the names of all individual co-partners comprising the firm; if bidder or other interested person is an individual, state the first and last names in full.)

12. Protest Procedures:

If there is a bid protest, the grounds shall be submitted as set forth in the Instructions to Bidders.

13. CONTRACTOR's License:

a. The undersigned bidder shall be licensed and shall provide the following California CONTRACTOR's license information:

License Number:

License expiration date:	

Name on License:

Class of License:

DIR Registration Number:

b. If the bidder is a joint venture, each member of the joint venture must include the above information.

14. <u>Time is of the Essence:</u>

Time is of the essence regarding this contract, therefore, in the event the bidder to whom the Contract is awarded fails or refuses to post the required bonds and return executed copies of the Agreement form within **five (5) calendar days** from the date of receiving the Notice of Award, the DISTRICT may declare the bidder's bid deposit or bond forfeited as damages.

15. Declaration:

The bidder declares that he/she has carefully examined the location of the proposed work, that he/she has examined the Contract Documents, including the Plans, General Conditions of the

contract, Supplemental Conditions, Addenda, and Specifications, all other documents issued to bidders and read the accompanying instructions to bidders, and hereby proposes and agrees, if this proposal is accepted, to furnish all materials and do all work required to complete the said work in accordance with the Contract Documents, in the time and manner therein prescribed for the unit cost and lump sum amounts set forth in this Bid Form.

16. Debarment:

In addition to seeking remedies for False Claims under Government Code Section 12650 et seq. and Penal Code Section 72, the DISTRICT may debar a CONTRACTOR pursuant to Article 15 of the General Conditions if the Board or the Board may designate a hearing officer who, in his or her discretion, finds the CONTRACTOR has done any of the following:

- a. Intentionally or with reckless disregard, violated any term of a contract with the DISTRICT;
- b. Committed an act or omission which reflects on the CONTRACTOR's quality, fitness or capacity to perform work for the DISTRICT;
- c. Committed an act or offense which indicates a lack of business integrity or business honesty; or,
- d. Made or submitted a false claim against the DISTRICT or any other public entity (See Government Code Sections 12650, et. seq., and Penal Code Section 72)

17. Designation of Subcontractors:

In compliance with the Subletting and Subcontracting Fair Practices Act (California Public Contract Code Sections 4100 et. seq.) and any amendments thereof, each bidder shall list subcontractors on the DISTRICT's form Subcontractor list. This subcontractor list shall be submitted with the bid and is a required form.

18. Bid Certification

I agree to receive service of notices at the e-mail address listed below.

I, the below-indicated bidder, declare under penalty of perjury that the information provided and representations made in this bid are true and correct.

Proper Name of Company	
Name of Bidder Representative	
Street Address	
City, State, and Zip	
Phone Number	Fax Number
E-mail	
Signature of Authorized Bidder Representative	Date

Signatory Name & Title (Printed)

NOTE: If bidder is a corporation, the legal name of the corporation shall be set forth above together with the signature of authorized officers or agents and the document shall bear the corporate seal; if bidder is a partnership, the true name of the firm shall be set forth above, together with the signature of the partner or partners authorized to sign contracts on behalf of the partnership; and if bidder is an individual, his signature shall be placed above.

All signatures must be made in blue ink

AGREEMENT FORM

THIS AGREEMENT, entered into this **INSERT DATE (DAY AFTER BOARD APPROVAL)** 20__ in the County of San Bernardino of the State of California, by and between the SAN BERNARDINO CITY UNIFIED SCHOOL DISTRICT, hereinafter called the "DISTRICT", and **INSERT COMPANY NAME**, hereinafter called the "CONTRACTOR".

WITNESSETH that the DISTRICT and the CONTRACTOR for the consideration stated herein agree as follows:

ARTICLE 1 - SCOPE OF WORK: The CONTRACTOR shall furnish all labor, materials, equipment, tools, and utility and transportation services, and perform and complete all work required in connection with <u>F21-03 PACIFIC HIGH SCHOOL – NEW ADMINISTRATION</u> ("Project") in strict accordance with the Contract Documents enumerated in Article 7 below. The CONTRACTOR shall be liable to the DISTRICT for any damages arising as a result of a failure to comply with that obligation, and the CONTRACTOR shall not be excused with respect to any failure to so comply by an act or omission of the Architect, Engineer, Inspector, Division of the State Architect (DSA), or representative of any of them, unless such act or omission actually prevents the CONTRACTOR from fully complying with the Contract Documents. Such protest shall not be effective unless reduced to writing and filed with the DISTRICT office within seven (7) days of the date of occurrence of such act or omission preventing the CONTRACTOR from fully complying with the Contract Documents.

ARTICLE 2 - TIME OF COMPLETION: The DISTRICT may give notice to proceed within ninety (90) days of the award of the bid by the DISTRICT. Once the CONTRACTOR has received a notice to proceed, the CONTRACTOR shall reach Substantial Completion (See Article 1.1.46) of the Work within <u>360 calendar days</u> from receipt of the Notice to Proceed. This shall be called Contract Time. (See Article 8.1.1). It is expressly understood that time is of the essence.

CONTRACTOR has thoroughly studied the Project and has satisfied itself that the time period for this Project was adequate for the timely and proper completion of the Project within each milestone and within the Contract time. Further, CONTRACTOR has included in the analysis of the time required for this Project, items set forth in General Conditions Article 8.3.2.1, Submittal Schedules, Rain Day Float, and Governmental Delay Float.

In the event that the DISTRICT desires to postpone giving the notice to proceed beyond this ninety (90) day period, it is expressly understood that with reasonable notice to the CONTRACTOR, giving the notice to proceed may be postponed by the DISTRICT. It is further expressly understood by the CONTRACTOR, that the CONTRACTOR shall not be entitled to any claim of additional compensation as a result of the DISTRICT's postponement of giving the notice to proceed.

If the CONTRACTOR believes that a postponement will cause hardship to it, the CONTRACTOR may terminate the Contract with written notice to the DISTRICT within ten (10) days after receipt by the CONTRACTOR of the DISTRICT's notice of postponement. It is further understood by the CONTRACTOR that in the event that the CONTRACTOR terminates the Contract as a result of postponement by the DISTRICT, the DISTRICT shall only be obligated to pay the CONTRACTOR for the work performed by the CONTRACTOR at the time of notification of postponement. Should the CONTRACTOR terminate the Contract as a result of a notice of postponement, the DISTRICT shall have the authority to award the Contract to the next lowest responsible bidder.

ARTICLE 3 - LIQUIDATED DAMAGES: It being impracticable and infeasible to determine the amount of actual damage, it is agreed that the CONTRACTOR will pay the DISTRICT the sum of <u>one thousand five dollars (\$1,500.00</u>) per calendar day for each and every day of delay beyond the Contract Time set forth in Article 2 of this Agreement (inclusive of Milestones that are critical on the critical path or noted as critical to the DISTRICT) based on scheduling required pursuant to Article 8 of the General Conditions, among other contract clauses, for completing each milestone and said work as liquidated damages and not as a penalty or forfeiture. In the event Liquidated Damages are not paid, the CONTRACTOR further agrees that the DISTRICT may deduct such amount thereof from any money due or that may become due the CONTRACTOR under the Contract (See Article 9.6 and 2.2 of the General Conditions). This Article shall not be construed as preventing the DISTRICT from the recovery of damages under provisions of the contract documents.

ARTICLE 4 - CONTRACT PRICE: The DISTRICT shall pay to the CONTRACTOR as full consideration for the faithful performance of the Contract, subject to any additions or deductions as provided in the Contract Documents, the sum of <u>INSERT AMOUNT</u> DOLLARS (<u>\$XXX,XXX.00</u>), said sum being the total amount stipulated in the proposal submitted. Payment shall be made as set forth in the General Conditions.

Should any Change Order result in an increase in the Contract Price, the cost of such Change Order shall be agreed to in advance by the CONTRACTOR and the DISTRICT, subject to the monetary limitations set forth in Public Contract Code section 20118.4. In the event that the CONTRACTOR proceeds with a Change in work without an agreement between the DISTRICT and CONTRACTOR regarding the cost of a Change Order, the CONTRACTOR waives any Claim of additional compensation

ARTICLE 5 - HOLD HARMLESS AGREEMENT: CONTRACTOR shall defend, indemnify and hold harmless DISTRICT, Architect, Inspector, the State of California and their officers, employees, agents and independent CONTRACTORs from all liabilities, claims, actions, liens, judgments, demands, damages, losses, costs or expenses of any kind arising from death, personal injury, property damage or other cause based or asserted upon any act, omission, or breach connected with or arising from the progress of Work or performance of service under this Agreement or the Contract Documents. As part of this indemnity, CONTRACTOR shall protect and defend, at its own expense, DISTRICT, Architect, Construction Manager, Inspector, the State of California and their officers, employees, agents and independent CONTRACTORs from any legal action including attorney's fees or other proceeding based upon such act, omission, breach or as otherwise required by this Article.

Furthermore, CONTRACTOR agrees to and does hereby defend, indemnify and hold harmless DISTRICT, Architect, Construction Manager, Inspector, the State of California and their officers, employees, agents and independent CONTRACTORs from every claim or demand made, and every liability, loss, damage, expense or attorney's fees of any nature whatsoever, which may be incurred by reason of:

(a) Liability for (1) death or bodily injury to persons; (2) damage or injury to, loss (including theft), or loss of use of, any property; (3) any failure or alleged failure to comply with any provision of law or the Contract Documents; or (4) any other loss, damage or expense, sustained by any person, firm or corporation or in connection with the Work called for in this Agreement or the Contract Documents, except for liability resulting from the sole or active negligence, or the willful misconduct of the DISTRICT.

(b) Any bodily injury to or death of persons or damage to property caused by any act, omission or breach of CONTRACTOR or any person, firm or corporation employed by CONTRACTOR, either directly or by independent contract, including all damages or injury to or death of persons, loss (including

for such additional work.

theft) or loss of use of any property, sustained by any person, firm or corporation, including the DISTRICT, arising out of or in any way connected with Work covered by this Agreement or the Contract Documents, whether said injury or damage occurs either on or off DISTRICT property, but not for any loss, injury, death or damages caused by the sole or active negligence or willful misconduct of the DISTRICT.

(c) Any dispute between CONTRACTOR and CONTRACTOR's subcontractors/suppliers/sureties, including, but not limited to, any failure or alleged failure of the CONTRACTOR (or any person hired or employed directly or indirectly by the CONTRACTOR) to pay any Subcontractor or Material man of any tier or any other person employed in connection with the Work and/or filing of any stop notice or mechanic's lien claims.

(d) Any claims, allegations, penalties, assessments, or liabilities to the extent caused by the CONTRACTOR's failure or the failure of any Subcontractor of any tier, to fully comply with the DIR registration requirements under Labor Code section 1725.5 at all times during the performance of any Work on the Project and shall reimburse the DISTRICT for any penalties assessed against the DISTRICT arising from any failure by the CONTRACTOR or any Subcontractor of any tier from complying with Labor Code sections 1725.5 and 1771.1. Nothing in this paragraph, however, shall require the CONTRACTOR or any Subcontractor to be liable to the DISTRICT or indemnify the DISTRICT for any penalties caused by the DISTRICT in accordance with Labor Code section 1773.3 (g).

CONTRACTOR, at its own expense, cost, and risk, shall defend any and all claims, actions, suits, or other proceedings that may be brought or instituted against the DISTRICT, its officers, agents or employees, on account of or founded upon any cause, damage, or injury identified herein Article 5 and shall pay or satisfy any judgment that may be rendered against the DISTRICT, its officers, agents or employees in any action, suit or other proceedings as a result thereof.

The CONTRACTOR's and Subcontractors' obligation to defend, indemnify and hold harmless the Owner, Architect, Inspector, the State of California and their officers, employees, agents and independent CONTRACTORs hereunder shall include, without limitation, any and all claims, damages, and costs for the following: (1) any damages or injury to or death of any person, and damage or injury to, loss (including theft), or loss of use of, any property; (2) breach of any warranty, express or implied; (3) failure of the CONTRACTOR or Subcontractor(s) to comply with any applicable governmental law, rule, regulation, or other requirement; (4) products installed in or used in connection with the Work; and (5) any claims of violation of the Americans with Disabilities Act ("ADA").

ARTICLE 6 - PROVISIONS REQUIRED BY LAW: Each and every provision of law and clause required to be inserted in this Contract shall be deemed to be inserted herein, and this Contract shall be read and enforced as though it were included herein, and if through mistake or otherwise any such provision is not inserted or is not inserted correctly, then upon application of either party the contract shall forthwith be physically amended to make such insertion or correction.

ARTICLE 7 - COMPONENT PARTS OF THE CONTRACT: The Contract entered into by this Agreement consists of the following Contract Documents, all of which are component parts of the contract as if herein set out in full or attached hereto.

- Notice Inviting Bids
- Instructions to Bidders
- Bid Cover Sheet
- Bid Form (attachment 1 Bid Package)
 - Request for Substitution (if applicable) (attachment 2 Bid Package)
 - Non-Collusion Declaration (attachment 3 Bid Package)
 - Site Visit Certification (attachment 4 Bid Package)
 - Certification of Compliance with DVBE Policy (attachment 5 Bid Package)

- Designation of Subcontractors (attachment 6 Bid Package)
- o Bid Bond Form (or Bid Guarantee Form) (attachment 7 or 8 Bid Package)
- o Bidder References & Responsibility Information (attachment 9 Bid Package)
- Contractors Certificate Regarding Worker's Compensation Form / Bid Guarantee Form (attachment 10 Bid Package)
- o Acknowledgment of Bidding Practices Regarding Indemnity (attachment 11 Bid Package)
- Local Business Outreach Program (LBOP) Form (attachment 12 Bid Package)
- Covid-19 Safety Plan (attachment # 13 Bid Package)
- Agreement
 - Attachment #1 Certificate Regarding Workers' Compensation
 - Attachment #2 Insurance Documents & Endorsements
 - Attachment #3 Contractor's Certificate Regarding Drug-Free Workplace
 - Attachment #4 Contractor's Certificate Regarding Alcoholic Beverage and Tobacco-Free Campus Policy
 - Attachment #5 Disabled Veterans Business Enterprise (DVBE) Participation Statement
 - Attachment #6 Payment Bond
 - Attachment #7 Performance Bond
 - Attachment #8 Prime/General Contractor Information
 - Attachment #9 W-9 Vendor Tax Information
 - Attachment #10 Vendor Application
 - Attachment #11 Certification of Non-Utilization of Asbestos Material
 - Attachment #12 Contractor Prevailing Wage Compliance Certification
 - Attachment #13 Guarantee
 - Attachment #14 Contractor Certification Regarding Background Checks
 - Attachment #15 Escrow Agreement for Security Deposit In Lieu of Retention (Optional)
 - Attachment #16 Disabled Veterans Business Enterprise (DVBE) Contractor Close-Out Statement
- Requirements, Reports, Specifications and/or Documents in the Project Manual or Other Documents Issued to Bidders
- Project Drawings

All of the above-named Contract Documents are intended to be complementary. Work required by one of the above-named Contract Documents and not by others shall be done as if required by all.

ARTICLE 8 - PREVAILING WAGES: Wage rates for this Project shall be in accordance with the general prevailing rate of holiday and overtime work in the locality in which the work is to be performed for each craft, classification, or type of work needed to execute the contract as determined by the Director of the Department of Industrial Relations. Copies of schedules of rates so determined by the Director of the Department of Industrial Relations are on file at the administrative office of the DISTRICT and are also available from the Director of the Department of Industrial Relations. Monitoring and enforcement of the prevailing wage laws and related requirements will be performed by the Labor Commissioner/ Department of Labor Standards Enforcement (DLSE).

The following are hereby referenced and made a part of this Agreement and CONTRACTOR stipulates to the provisions contained therein.

1. Chapter 1 of Part 7 of Division 2 of the Labor Code (Section 1720 et seq.)

2. California Code of Regulations, Title 8, Chapter 8, Subchapters 3 through 6 (Section 16000 et seq.)

Effective January 1, 2015:

3. No contractor or subcontractor may be listed on a bid proposal for a public works project (submitted on or after March 1, 2015) unless registered with the Department of Industrial Relations pursuant to Labor Code section 1725.5 [with limited exceptions from this requirement for bid purposes only under Labor Code section 1771.1(a)].

4. No contractor or subcontractor may be awarded a contract for public work on a public works project (awarded on or after April 1, 2015) unless registered with the Department of Industrial Relations pursuant to Labor Code section 1725.5.

5. Monitoring and enforcement of the prevailing wage laws and related requirements will be performed by the Labor Commissioner/ Department of Labor Standards Enforcement (DLSE).

ARTICLE 9 - RECORD AUDIT: In accordance with Government Code section 8546.7(and Davis Bacon, if applicable) and Article 13.11 of the General Conditions, records of both the DISTRICT and the CONTRACTOR shall be subject to examination and audit for a period of five (5) years after a Final Retention Payment or the Recording of a Notice of Completion, whichever occurs first.

ARTICLE 10 - CONTRACTOR'S LICENSE: The CONTRACTOR must possess throughout the Project a <u>**Class B**</u> Contractor's License, issued by the State of California, which must be current and in good standing.

(Continued next page)

IN WITNESS WHEREOF, this Agreement has been duly executed by the above-named parties, on the day and year first above written.

San Bernardino City Unified School DISTRICT	CONTRACTOR:
By:	Typed or Printed Name
By: Purchasing Director	Title
Dated:	Signature
	Type or Printed Name
	Title (Authorized Officers or Agents)

Signature

(CORPORATE SEAL)

SUPPLEMENTARY GENERAL CONDITIONS

The following supplements modify the General Conditions. Where a portion of the General Conditions is modified and or deleted by these Supplementary Conditions, the unaltered portions of the General Conditions shall remain in effect.

Drawings Scope of Work: Contractor shall coordinate with the District during construction for specific locations of the new door buzzer camera phone on counter(s).

Coordination: In addition to coordination indicated in the contract documents. Provide coordination as may be needed for the removal of the existing solar carport required for the construction of the new parking lot.

Packing/Moving of Site Furniture and Belongings: Contractor shall be responsible for coordinating with the District school site for the packing and moving of furniture and belongings to New Administration Building once project is complete. After construction is completed, the contractor also coordinate the packing and moving of individual site furniture and belongings back into the New Administration areas/spaces. Contractor shall provide all materials (moving boxes / supplies) and labor, as needed for the moving of office furniture/belongings from the existing area/areas within the current school property.

ARTICLE 3 – THE CONTRACTOR

Article 3.10.4 Add the following: The CONTRACTOR shall require all Subcontractors to prepare and submit to the CONTRACTOR, within *fifteen (15)* days of execution of the Subcontract, comprehensive lists, in quadruplicate, of the manufacturers and products proposed for the Project, including information on materials, equipment, and fixtures required by the Contract Documents, as may be required for the CONTRACTOR's or Architect's approval.

ARTICLE 8 – TIME

Article 8 Schedule Inclusion Requirements – The Baseline Schedule shall include the following Milestone Schedule:

Parking Lot Completion	Contractor to coordinate with District and School on completion of parking lot work.
	AREA OF WORK to be completed first and coordinated with CTE and/or CLASSROOM MODERNIZATION contractors who are currently performing work on this campus.
	Refer to Exhibit 'A' that indicates the utility installation that shall commence at the start of construction activities, including but not limited to MAIN DOMESTIC WATER LINE, MAIN ELECTRICAL & COMM. LINES, MAIN GAS LINE, MAIN IRRIGATION LINE & PORTION OF STORM DRAIN LINE.

SUPPLEMENTARY GENERAL CONDITIONS

Solar Carport Removal	Allowance #2 has been increased from \$420,000 to \$460,000. The additional amount is to cover and include the removal of the solar array footings (Total of 5) that will need to be removed by the winning Bid Contractor. The solar array lease company will only remove the existing footings down to a couple of inches below the existing surface/asphalt. The winning Bid Contractor shall coordinate with and contract out directly with the following (2) Solar Array Lease companies who will perform the removal of the Solar Array at Pacific HS immediately after award of project in order to avoid project delays. The District is currently leasing the solar arrays at Pacific HS with these companies, requiring that any / all related work be coordinated with and performed through them. Solar Array Lease Companies: ARC Alternatives Simon Olivieri, P.E., Senior Engineer (510) 852-4840 <u>simon@arc-alternatives.com</u>
	Brookfield Renewable US
	Douglas Hooper, Sr. Project Manager
	(410) 916-8357
	douglas.hooper@brookfieldrenewable.com

Article 8.2.2 Performance During Working Hours – delete this Article and replace with the following:


8.2.2 Where a single shift is worked, eight (8) consecutive hours between **7am** and **5pm** shall constitute a work day at the applicable prevailing wage rate(s).

Article 8.2.2 Performance During Working Hours – delete this Article and replace with the following:

8.2.2 Forty (40) hours between **Monday**, **7am** and **Friday**, **5pm** shall constitute a work week at the applicable prevailing wage rate(s);

ARTICLE 11 – INSURANCE AND BONDS

Article 11.10 Performance and Payment Bonds – The number of executed copies of the Performance Bond and the Payment Bond required is <u>three (3)</u>.

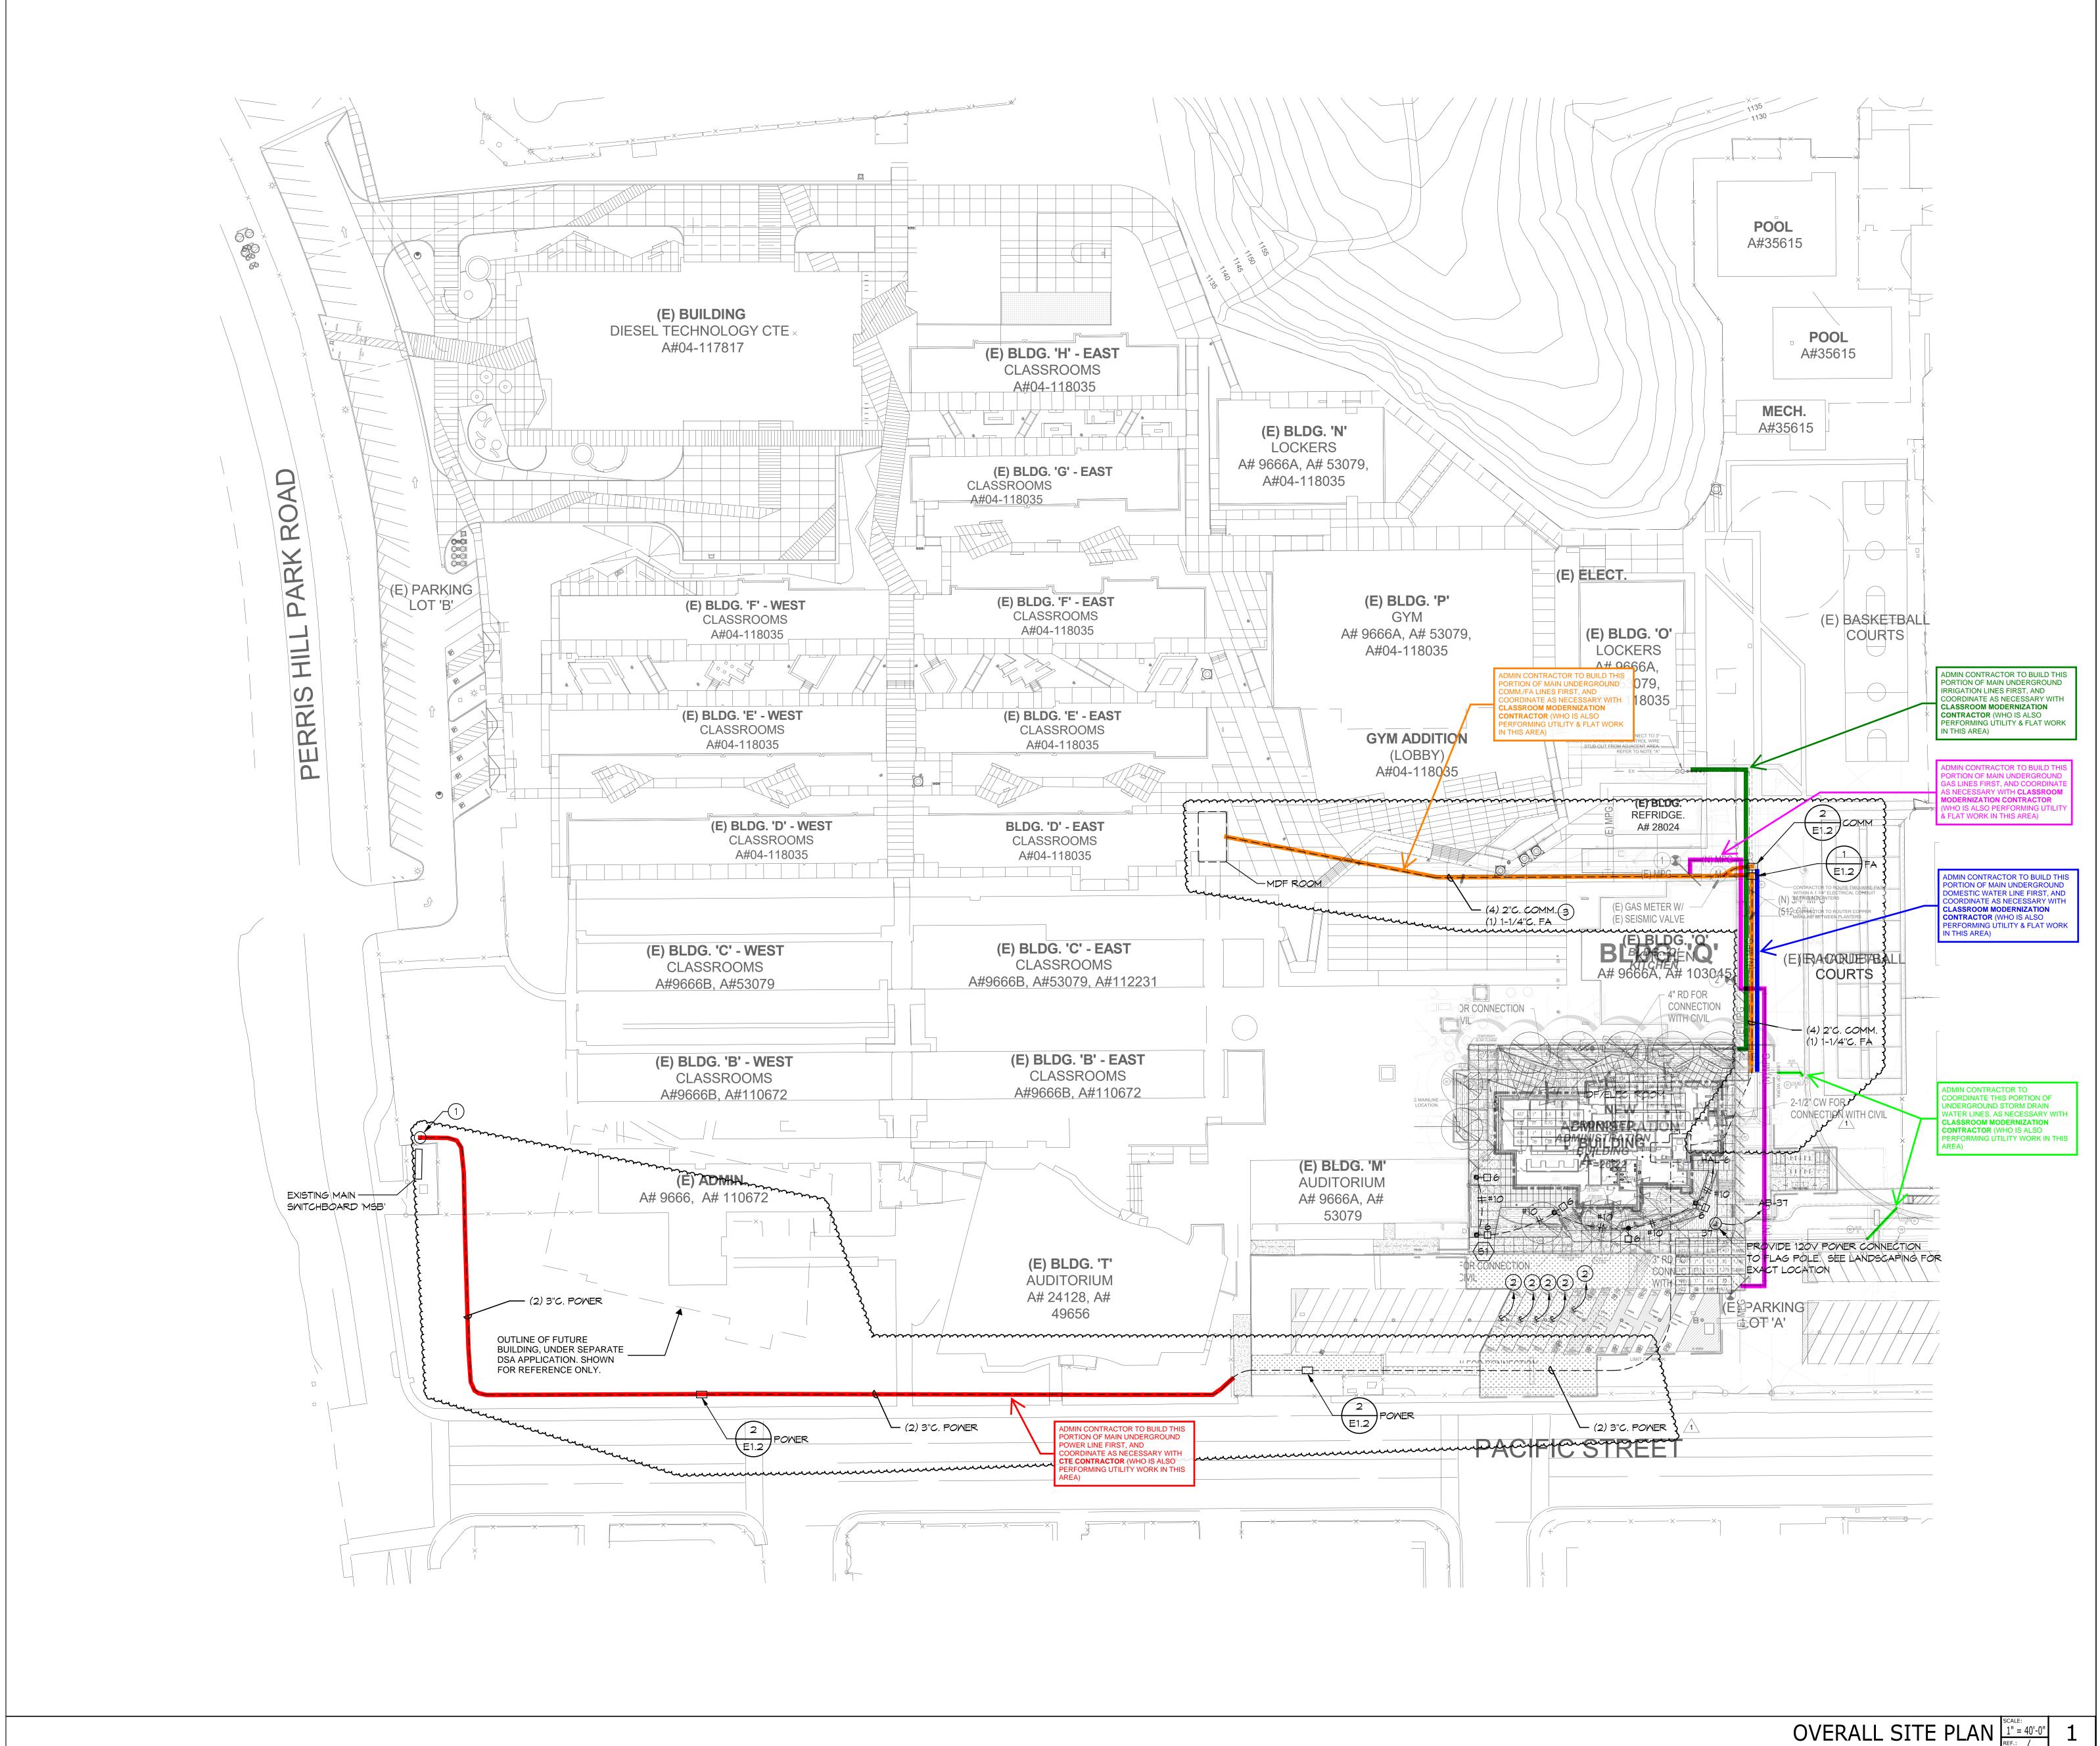

PROJECT No. :Project Number 3/31/2021 3:55:08 PM

DRAWN BY:		CHECKED BY:
ISSUE No	DATE	DESCRIPTION
ISSUE No.	DATE	DESCRIPTION
ISSUE No.	DATE	DESCRIPTION
ISSUE No.	DATE	DESCRIPTION

RUHNAUCLARKE.COM 3775 TENTH STREET, RIVERSIDE CALIFORNIA 92501(951) 684 4664 / 5751 PALMER WAY, SUITE C, CARLSBAD CALIFORNIA 9201(9760) 438 5899

NEW ADMINISTRATION BUILDING EXHIBIT 'A' PHASING PLAN OF SITE WORK

1020 PACIFIC STREET, SAN BERNARDINO, CA 92404 SAN BERNARDINO CITY UNIFIED SCHOOL DISTRICT

SECTION 07 26 16 UNDER-SLAB VAPOR RETARDER

PART 1 - GENERAL

1.01 SECTION INCLUDES

A. Sheet vapor retarder under concrete slabs on grade.

1.02 RELATED REQUIREMENTS

- A. Section 03 10 00 Concrete Forming and Accessories: Forms and accessories for formwork.
- B. Section 03 20 00 Concrete Reinforcing: Coordination of placement of reinforcement with vapor retarder/barrier.
- C. Section 03 30 00 Cast-in-Place Concrete: Preparation of subgrade, granular fill, placement of concrete.
- D. Section 31 22 00 Grading: Preparation of building pad and base placed beneath vapor barrier.

1.03 REFERENCE STANDARDS

- A. ACI 302.1R Guide to Concrete Floor and Slab Construction.
- B. ACI 302.2R Guide for Concrete Slabs that Receive Moisture-Sensitive Flooring Materials.
- C. ASTM D1709 Standard Test Methods for Impact Resistance of Plastic Film by the Free-Falling Dart Method.
- D. ASTM E1643 Standard Practice for Selection, Design, Installation and Inspection of Water Vapor Retarders Used in Contact with Earth or Granular Fill Under Concrete Slabs.
- E. ASTM E1745 Standard Specification for Plastic Water Vapor Retarders Used in Contact with Soil or Granular Fill under Concrete Slabs.
- F. ASTM E96/E96M Standard Test Methods for Water Vapor Transmission of Materials.

1.04 SUBMITTALS

- A. See Section 01 30 00 Administrative Requirements, for submittal procedures.
- B. Product Data: Provide manufacturers product data identifying specific product to be utilized.
- C. Shop Drawings: Indicate the following:
 - 1. Seaming Layout
 - 2. Penetration and termination details.
- D. Samples: Submit six material samples, 6 x 6 inch in size, illustrating actual materials to be installed.
- E. Specimen Warranty.
- F. Certificate: Certify that products of this section meet or exceed specified requirements.
- G. Test Reports: Indicate compliance with requirements listed in this section.
 - 1. Independent laboratory test results showing compliance with ASTM and ACI Standards.

- H. Manufacturer's Installation Instructions: Indicate installation procedures and interface required with adjacent construction.
- I. Manufacturer's Field Reports: Indicate Manufacturers review of field conditions at 50% installation and after installation of reinforcing, prior to placement of concrete..
- J. Warranty: Submit manufacturer warranty and ensure that forms have been completed in District's name and registered with manufacturer.

1.05 QUALITY ASSURANCE

- A. Preinstallation Meeting: Convene a preinstallation meeting 2 weeks before start of installation of reinforced vapor retarders. Require attendance of parties directly affecting work of this section, including Manufacturer's Representative, Contractor, Architect, and installer. Review installation, protection, and coordination with other work.
- B. Coordination: Coordinate installation timing and sequence to maintain required moisture content in prepared subgrade.
- C. Copies of Documents at Project Site: Maintain at the project site a copy of each referenced document that prescribes execution requirements.

PART 2 - PRODUCTS

2.01 MANUFACTURERS

- A. Manufacturers and Products:
 - 1. Fortifiber Building Products Systems; Moistop Ultra 15, 15 mils thick (0.010 max. permeance), Class A, unreinforced polyolefin: www.fortifiber.com.
 - 2. ISI Building Products; Viper VaporCheck II 15-mil (Class A): www.isibp.com/#sle..
 - **23**. Raven Industries; VaporBlock VB15, 15 mils thick (0.01 perms), Class A, unreinforced polyolefin: ravenefd.com,
 - **34**. Reef Industries, Inc.; Vaporguard, 15 mil (E-96 0.000 perms), Class B: www.reefindustries.com
 - 45. Stego Industries LLC; Stego Wrap Vapor Barrier, 15 mils: www.stegoindustries.com.
 - **56**. W.R. Meadows; Perminator, 15 mils thick (0.0063 perms, puncture resistant) Class A: www.wrmeadows.com..
 - **67**. Substitutions: See Section 01 60 00 Product Requirements.

2.02 PERFORMANCE REQUIREMENTS

- A. Comply with ACI 302.1R and ACI 302.2R.
- B. Water Vapor Permeance: Not more than 0.010 perms, maximum.
 - 1. Permeance as tested after conditioning (ASTM E1745).
- C. Comply with ASTM E1745 Class A.
- D. Puncture Resistance, ASTM D1709: 2,300 gms.

2.03 MATERIALS

A. Reinforced Vapor Barrier:

- 1. Minimum Thickness ACI 302.1R: 15 mil.
- 2. Material: Multi-ply laminate/extrusion of Polyolefin.
- B. Sheet polyethylene membrane not acceptable.

2.04 ACCESSORIES

- A. General: Ensure accessories are from same manufacturer as reinforced vapor retarders.
 - 1. Vapor barrier manufacturer's recommended tape, adhesive, mastic, etc., for sealing seams and penetrations in vapor barrier.
- B. Adhesive Mastic: Adhesive compatible with sheet retarder/barrier and substrate materials, water vapor transmission rate of 0.3 perms or lower per ASTM E96/E96M. Membrane manufacturer's recommended elastomeric sealant.
- C. Adhesive Tape for Sheet Joint Sealing and Repair and Sealing of Miscellaneous Penetrations: Membrane manufacturer's recommended double sided tape with water vapor transmission rate of 0.03 perms or lower per ASTM E96/E96M.
 - 1. Mastic Tape: Manufacturer's system tape.
 - 2. Self-Adhesive Repair Tape: Manufacturer's system tape.
- D. Pipe and Conduit Boot:
 - 1. Manufacturers factory fabricated pipe boots.

PART 3 - EXECUTION

3.01 EXAMINATION

- A. Examine areas to receive reinforced vapor retarders. Notify Architect if areas are not acceptable. Do not begin installation until unacceptable conditions have been corrected.
- B. Subbase: Per ACI 302.1R.
 - 1. As indicated on Drawings and approved by the Geotechnical Engineer.
 - a. Minimum 4 inch thick (or larger) base of 1/2 inch or larger clean aggregate, per CA Green Code 4.505.2.1 and CBC 1907.1A.
- C. Preparation: Ensure that crushed rock or sand base is tamped or rolled and level.
- D. Ensure subgrade beneath vapor retarder is smooth, level, and compacted with no sharp projections.
- E. Beginning installation shall indicate acceptance of conditions.

3.02 UNDERSLAB VAPOR RETARDER / BARRIER INSTALLATION

- A. Install vapor barrier in accordance with manufacturer's instructions and ASTM E1643.
- B. Location: Provide vapor retarder/barrier under building slabs on grade to limits indicated on Drawings.
- C. Installation: Place sheet over crushed rock, as detailed on Drawings, without damaging sheeting.
 - 1. Unroll vapor barrier with the longest dimension parallel with the direction of the concrete placement.

- a. Install vapor retarders in largest practical widths.
- 2. Place sheets continuous between footings or foundation walls, without voids.
- 3. Lap vapor barrier over footings and/or seal to foundation walls.
- 4. Lap all joints 6 inches minimum. Seal seams as noted below.
- 5. Turn down sheeting 12 inches minimum along inside face of perimeter grade beams and/or continuous perimeter footings.
- 6. Fit sheeting tightly around column, pipe and conduit penetrations. Install standard pipe boot where possible, following manufacturer's instructions.
 - a. No penetration of the vapor barrier is allowed except for reinforcing steel and permanent utilities.
- D. Seam and Lap Sealing: With adhesive mastic and adhesive sealing tape, seal all seams, edges and penetrations of vapor retarder/barrier.
 - 1. For adhesive mastic seal, apply adhesive to both surfaces, allow approximately 10 minutes to set up and then press together smoothly and evenly, without gaps or fishmouths, for full contact bond.
 - 2. For adhesive tape seal, comply with manufacturer's instructions and recommendations.
 - 3. Seal all penetrations with both adhesive sealing tape and adhesive mastic.
 - 4. Seal sheets to concrete footing faces and penetrating components with adhesive mastic or double sided tape as recommended by membrane manufacturer.
- E. Ensure there is no moisture entrapment by vapor retarder due to rainfall or ground water intrusion.
- F. Immediately repair holes in vapor retarder with self-adhesive repair tape.
- G. Remedial Work: Inspect sheeting installation prior to placing fill materials. Repair all apparent and suspected damaged areas.
 - 1. Clean surface of sheeting.
 - 2. Cut patch from new sheeting material, overlapping damaged area 6 inches minimum, and apply over damaged area sealing in place with adhesive and tape.

3.03 PROTECTION

- A. Protect reinforced vapor retarders from damage during installation of reinforcing steel and utilities and during placement of concrete slab or granular materials.
- B. Immediately repair damaged vapor retarder in accordance with manufacturer's instructions

END OF SECTION

SECTION 07 54 00

THERMOPLASTIC MEMBRANE ROOFING

PART 1 GENERAL

1.01 SECTION INCLUDES

- A. Adhered system with thermoplastic roofing membrane.
- B. Insulation, tapered Deck sheathing.
- C. Cover boards.
- D. Flashings.
- E. Roofing cant strips, stack boots, and walkway pads

1.02 RELATED REQUIREMENTS

- A. Section 06 10 00 Rough Carpentry: Wood nailers, cant strips, and curbs.
- B. Section 07 62 00 Sheet Metal Flashing and Trim: Counterflashings, reglets.
- C. Section 07 72 00 Roof Accessories: Roof-mounted units; prefabricated curbs.
- D. Division 22 -Plumbing: Roof drains.
- E. Division 26 Electrical: Conduit penetrating roofing membrane.

1.03 REFERENCE STANDARDS

- A. ASCE 7 Minimum Design Loads and Associated Criteria for Buildings and Other Structures.
- AB. ASTM C1177/C1177M Standard Specification for Glass Mat Gypsum Substrate for Use as Sheathing.
 - 1. Use 2013 as indicated in 2019 CBC Ch. 35 Referenced Standards.
 - 2. Use 2006 as indicated in 2013 CBC Ch. 35 Referenced Standards.
- **BC**. ASTM C1289 Standard Specification for Faced Rigid Cellular Polyisocyanurate Thermal Insulation Board.
 - 1. Use 2015 as indicated in 2019 CBC Ch. 35 Referenced Standards.
- CD. ASTM D4434/D4434M Standard Specification for Poly(Vinyl Chloride) Sheet Roofing.
 - 1. Use 2012 as indicated in 2019 CBC Ch. 35 Referenced Standards.
- E. ASTM E1980 Standard Practice for Calculating Solar Reflectance Index of Horizontal and Low-Sloped Opaque Surfaces.
- **DF**. FM DS 1-28 Wind Design.
- **EG.** NRCA (RM) The NRCA Roofing Manual.
- FH. NRCA (WM) The NRCA Waterproofing Manual.
- I. UL (FRD) Fire Resistance Directory.

1.04 ADMINISTRATIVE REQUIREMENTS

A. Preinstallation Meeting: Convene one week before starting work of this section.

- 1. Review preparation and installation procedures and coordinating and scheduling required with related work.
- 2. Notification: Two weeks prior to pre-application conference, inform District and Architect of scheduled roofing beginning and completion dates, such that District may arrange for independent inspection of roofing Work, and presence of independent testing and inspection agency at pre-application conference.
- 3. Attendance: Require attendance by Contractor's superintendent and other supervisory and quality control personnel having responsibility for roofing, supervisory personnel of roofing applicator and, if required for warranty provisions, representative of roofing products manufacturer.
 - a. Construction Manager, Architect's insurer, independent testing and inspection agency and Architect, if authorized by District, will attend.
 - b. Require attendance of installers of each component of related Work, including deck or substrate construction, rigid insulation, metal flashing, rooftop equipment, penetrations of roof deck, and other Work integral with or adjacent to roofing may attend.
 - c. If required, attendance shall include authorities having jurisdiction. Contractor shall verify requirement with authorities having jurisdiction and arrange for attendance.
 - d. Agenda:
 - 1) Meeting purpose is to review Drawings and Specifications for suitability for application of roofing system.
 - Review application procedures and coordination required with related Work. Discuss changes and deviations from Drawings and Specifications, if any, recommended or required.
 - 3) Walk roof areas to review and discuss substrate preparation including repair of unacceptable surfaces, roof drainage, penetrations, equipment curbs, and work performed by other trades, which require coordination with roofing system.
 - 4) Review contract document requirements and submittals for roofing system, including roofing schedule, inspection and testing, and environmental conditions. Identify which governing regulations or insurance requirements will affect roofing system installation.
 - 5) Discuss anticipated weather, as well as procedures for responding to unacceptable weather, including using temporary roofing. Temporary roofing, if necessary, will be added to scope of the Work by contract modification (change order or construction change directive), with acceptable adjustment in Contract Time and Contract Sum.
 - 6) Document discussions in writing, including actions required, and distribute copy of report to each meeting participant.
 - 7) Attendance by Construction Manager, Architect and independent testing and inspection agency shall not relieve Contractor of sole responsibility for means, methods, techniques and sequence of construction, in accordance with provisions of the Conditions of the Contract.

1.05 SUBMITTALS

A. See Section 01 30 00 - Administrative Requirements for submittal procedures.

- B. Product Data: Provide data indicating membrane materials, flashing materials, insulation, vapor retarder, surfacing, and fasteners.
 - 1. Material Safety Data Sheet: For all products submitted. For Contractor's use only.
- C. Shop Drawings: Submit drawings that indicate joint or termination detail conditions, conditions of interface with other materials, and paver layout.
- D. Manufacturer's Certificate: Certify that products meet or exceed specified requirements.
- E. Manufacturer's Installation Instructions: Indicate membrane seaming precautions and perimeter conditions requiring special attention.
- F. Manufacturer's qualification statement.
- G. Installer's qualification statement.
- H. Specimen Warranty: For approval.
 - 1. Applicator's(Contractor) Specimen Warranty: For approval.
- I. Warranty Documentation:
 - 1. Submit manufacturer warranty and ensure that forms have been completed in District's name and registered with manufacturer.
 - 2. Submit installer's certification that installation complies with warranty conditions for waterproof membrane.
 - 3. Applicator Warranty: Submit applicators/ contractor's warranty and ensure forms have been completed in District's name and registered with manufacturer.

1.06 QUALITY ASSURANCE

- A. Manufacturer Qualifications: Company specializing in manufacturing the products specified in this section with minimum twenty-five years of documented experience.
- B. Installer Qualifications: Company specializing in performing the work of this section with at least five years of documented experience and approved by manufacturer.
- C. Industry Standards:
 - 1. Conform to manufacturer's product data and application instructions.
 - 2. Perform work in accordance with NRCA (RM) and NRCA (WM) and and Western States Roofing Contractors Association (WSRCA).
 - a. Maintain one copy on site.
- D. Testing and Inspection:
 - 1. District's independent inspection and testing agency will perform inspections and tests of roofing work.
 - 2. Costs of this service will be paid for by District.
 - 3. Contractor shall cooperate with independent testing and inspection agency.
 - 4. Refer to general requirements specified in Section 01 40 00 Quality Requirements and 01 45 33 Code-Required Special Inspections.
- E. Private label and third-party-manufactured membranes are not permitted.

1.07 DELIVERY, STORAGE, AND HANDLING

- A. Deliver materials in manufacturer's original containers, dry and undamaged, with seals and labels intact.
- B. Store materials in weather protected environment, clear of ground and moisture.
- C. Ensure storage and staging of materials does not exceed static and dynamic load-bearing capacities of roof decking.
- D. Protect foam insulation from direct exposure to sunlight.

1.08 FIELD CONDITIONS

- A. Do not apply roofing membrane during unsuitable weather.
- B. Do not apply roofing membrane when ambient temperature is below 40 degrees F or above 95 degrees F.
- C. Do not apply roofing membrane to damp or frozen deck surface or when precipitation is expected or occurring.
- D. Do not expose materials vulnerable to water or sun damage in quantities greater than can be weatherproofed the same day.
- E. Schedule applications so that no partially completed sections of roof are left exposed at end of workday.
 - 1. Provide temporary roof membrane if necessary to protect portions of the Work before final roofing can be installed.
 - a. Record by way of change order the District's agreement to proceed with temporary roofing, along with additional costs and other changes (if any) to Contract Documents.
 - b. Remove temporary roofing before starting installation of final roofing system.
- F. Arrange work sequence to avoid use of newly constructed roofing as a walking surface or for equipment movement and storage.
 - 1. Provide all necessary protection and barriers to segregate the work area and to prevent damage to adjacent areas.
 - 2. Provide a substantial protection layer consisting of plywood over felt or plywood over insulation board for all new and existing roof areas that receive rooftop traffic during construction.

1.09 WARRANTY

- A. See Section 01 78 00 Closeout Submittals for additional warranty requirements.
- B. System Warranty: Provide manufacturer's system warranty agreeing to repair or replace manufacturer supplied roofing system components that leak or are damaged due to wind or other natural causes. Include contractor labor in system warranty.
 - 1. Warranty Term: 20 years, Non-Prorated and no dollar limit (NDL).
 - a. Provide a written guarantee signed by the manufacturer's authorized official, agreeing to correct failures in product and installation, with no dollar limit on such corrections, for the noted warranty term from date established in Notice of Completion.

- 2. Include insulation and flashing as part of the roofing system and all other manufacturer supplied system components to be used as part of the roofing assembly..
- 3. For repair and replacement include costs of both material and labor in warranty.
- 4. Exceptions are not Permitted:
 - a. Damage due to roof traffic.
 - b. Damage due to wind speed up 60-90 mph.
 - c. Damage due to ponding water; assign no time limit for any such ponding water during the warranty period.
 - d. Roof system maintenance.
- C. Applicator/Roofing Contractor Warranty:
 - 1. Applicator to supply the District with a separate five-year workmanship warranty.
 - 2. In the event any work related to roofing, flashing, or associated metal is found to be within the Applicator warranty term, defective or otherwise not in accordance with the Contract Documents, the Applicator shall repair that defect at no cost to the District.
 - 3. The Applicator's warranty obligation shall run directly to the District, and a copy shall be sent to the manufacturer.

PART 2 PRODUCTS

2.01 MANUFACTURERS

- A. Thermoplastic Polyolefin (TPO) Membrane Roofing Materials:
 - 1. Carlisle Roofing Systems, Inc; Sure-Weld TPO: www.carlisle-syntec.com/#sle.
 - 2. Firestone Building Products, LLC: www.firestonebpco.com/#sle.
 - 3. GAF; EverGuard Extreme TPO 60 mil: www.gaf.com/#sle.
 - 4. Johns Manville; JM TPO 45 mil: www.jm.com/#sle.
 - 5. Substitutions: See Section 01 60 00 Product Requirements.
- BA. Thermoplastic Polyvinyl Chloride (PVC) Membrane Roofing Materials:
 - 1. Basis of Design Product: G-410 ES as manufactured by Sika Sarnafil, a Division of Sika Corporation, or approved equal.
 - 2. Basis of Design Product: Decor Roof Systems as manufactured by Sika Sarnafil, a Division of Sika Corporation, or approved equal.
 - 3. Carlisle Roofing Systems, Inc; Sure-Flex PVC KEE: www.carlisle-syntec.com/#sle.
 - **42**. Johns Manville; JM PVC Fleece Backed ES (Energy Saving), 80 mil, SP8PA: www.jm.com/#sle.
 - **53**. Sika Corporation Roofing; Sarnafil PVC: usa.sika.com/sarnafil/#sle.
 - 6. Sika Corporation Roofing; Decor Roof Systems: usa.sika.com/sarnafil/#sle.
 - 7. Tremco, Inc.; TPA: www.tremco.com.
 - 8. Versico Roofing Systems; VersiFleece PVC Polyester Reinforced Membrane: www.versico.com/#sle.
 - 94. Substitutions: See Section 01 60 00 Product Requirements.

- C. Insulation:
 - 1. Insulation manufacturer as part of the tested and warrantable roofing system membrane assembly.
 - 2. Substitutions: See Section 01 60 00 Product Requirements.

2.02 PERFORMANCE REQUIREMENTS

- A. General: Provide installed roofing membrane and base flashings that remain watertight; do not permit the passage of water; and resist specified uplift pressures, thermally induced movement, and exposure to weather without failure.
- B. Material Compatibility: Provide roofing materials that are compatible with one another under conditions of service and application required, as demonstrated by roofing manufacturer based on testing and field experience.

2.03 ROOFING - UNBALLASTED APPLICATIONS

- A. Thermoplastic Membrane Roofing: One ply membrane, fully adhered, over insulation.
- B. Roof Assembly: (from the top down)
 - 1. Typical assembly:
 - a. Roofing Membrane
 - b. Cover Board Glass mat gypsum panel.
 - c. Insulation Rigid board. R-30
 - **dc**. Tapered Insulation layers for crickets.
 - e. Deck Sheathing.
 - fd. Roof deck.
- C. Roofing Assembly Requirements:
 - 1. Solar Reflectance Index (SRI): 78, minimum, calculated in accordance with ASTM E1980.
 - a. Field applied coating may not be used to achieve specified SRI.
 - 2. Roof Covering External Fire Resistance Classification: UL (FRD) Class A.
 - 3. Roofing System Design: Provide a roofing system that is identical to systems that have been successfully tested by a qualified testing and inspecting agency to resist uplift pressure calculated according to ASCE 7.
 - a. Safety Factor: As required by code; minimum 2.0
 - 4. Factory Mutual Classification: Class 1 and windstorm resistance of 1-90, in accordance with FM DS 1-28.
- C. Acceptable Insulation Types Constant Thickness Application: Any type that meets requirements and is approved by membrane manufacturer for application.
 - 1. Minimum 2 layers of polyisocyanurate board.
 - a. Use two layers if total thickness is over 2-1/2 inches.
 - 2. Bottom layer of polyisocyanurate board covered with single layer of polyisocyanurate board.

- D. Acceptable Insulation Types Tapered Application: Any type that meets requirements and is approved by membrane manufacturer for application.
 - 1. Tapered polyisocyanurate board.

2.04 MEMBRANE ROOFING AND ASSOCIATED MATERIALS

- A. Membrane Roofing Materials:
 - 1. PVC: Polyvinyl chloride (PVC) complying with ASTM D4434/D4434M, Type II, sheet contains reinforcing fibers or reinforcing fabrics.
 - a. Thickness: 80 mil, 0.080 inch, minimum.
 - b. Backing: 9 oz. Feltback fabricated as part of the membrane.
 - 2. Sheet Width: Factory fabricated into largest sheets possible.
 - 3. Solar Reflectance: 0.75, minimum, initial, and 0.65, minimum, 3 year, certified by Cool Roof Rating Council.
 - 4. Thermal Emissivity: 0.80, minimum, initial, and 0.79, minimum, 3-year, certified by Cool Roof Rating Council.
 - 5. Color, Integral: White
- B. Seaming Materials: As recommended by membrane manufacturer.
- C. Flexible Flashing Material: Same material as membrane.

2.05 DECK SHEATHING

- A. Deck Sheathing: Glass-mat faced gypsum panels complying with ASTM C1177/C1177M.
 - 1. Thickness: 1/4 inch, fire-resistant.
 - 2. Thickness at Parapets: 1/2 inch, fire-resistant.
 - 3. Products:
 - a. Georgia-Pacific; DensDeck Prime with EONIC Technology: www.densdeck.com/#sle.
 - b. National Gypsum Company; DEXcell FA Glass Mat Roof Board: www.nationalgypsum.com/#sle.
 - c. USG Corporation; Securock Ultralight Glass-Mat Roof Board: www.usg.com/#sle.
 - d. Substitutions: See Section 01 60 00 Product Requirements.

2.0605 COVER BOARDS

- A. Cover Boards: Glass-mat faced gypsum panels complying with ASTM C1177/C1177M.
 - 1. Thickness: 1/4 inch, fire-resistant.
 - 2. Products:
 - a. Georgia-Pacific; DensDeck Prime with EONIC Technology: www.densdeck.com/#sle.
 - b. Substitutions: See Section 01 60 00 Product Requirements.

2.07 INSULATION

- A. Polyisocyanurate (ISO) Board Insulation: Rigid cellular foam, complying with ASTM C1289.
 - 1. Classifications:
 - a. Type II:

- 1) Class 1 Faced with glass fiber reinforced cellulosic felt facers on both major surfaces of core foam.
- 2) Compressive Strength: Classes 1-2-3, Grade 3 25 psi (172 kPa), minimum.
- Thermal Resistance, R-value: At 1-1/2 inches thick; Class 1, Grades 1-2-3, 8.4 (1.48) at 75 degrees F.
- 2. Board Size: 48 by 96 inches, maximum.
- 3. Board Thickness: 4.0 inch, maximum.
- 4. Tapered Board: Slope as indicated; minimum thickness 1/2 inch; fabricate of fewest layers possible.
- 5. Board Edges: Square.
- 6. Products:
 - a. Basis of Design Product: Sarnatherm (ACFoam[®]-II) as manufactured by Atlas Roofing, or approved equal.
 - b. Dow Chemical Company: www.dowbuildingsolutions.com.
 - c. GAF; EnergyGuard Polyiso Insulation: www.gaf.com/#sle.
 - d. Rmax Inc.; ECOMAXci: www.rmax.com.
 - e. Versico Roofing Systems; SecurShield Insulation: www.versico.com/#sle.
 - f. Substitutions: See Section 01 60 00 Product Requirements.

2.08 ACCESSORIES

- A. Clad Metal Flashing:
 - 1. Description: Membrane-coated, heat-weldable sheet metal capable of being formed into a variety of shapes and profiles.
 - 2. Materials: 24 gauge, G90 galvanized metal sheet with a 20 mil unsupported roofing membrane laminated on one side.
 - 3. Color: Clad metal to match roofing membrane.
 - 4. Product: Sarnaclad manufactured by Sarnafil.
- B. Stack Boots: Prefabricated flexible boot and collar for pipe stacks through membrane; same material as membrane.
- C. Sheathing Joint Tape: Two-sided butyl rubber type type, 6 inch wide, self-adhering.
- D. Insulation Joint Tape: Glass fiber reinforced type as recommended by insulation manufacturer, compatible with roofing materials; 6 inches wide; self adhering.
- E. Insulation Fasteners: Appropriate for purpose intended and approved by roofing manufacturer.
 - 1. Length as required for thickness of insulation material and penetration of deck substrate, with metal washers.
- F. Membrane Adhesive: As recommended by membrane manufacturer.
- G. Surface Conditioner for Adhesives: Compatible with membrane and adhesives.
- H. Thinners and Cleaners: As recommended by adhesive manufacturer, compatible with membrane.
- I. Insulation Adhesive: As recommended by insulation manufacturer.

- J. Strip Reglet Devices: Galvanized steel, maximum possible lengths per location, with attachment flanges.
- K. Insulation Perimeter Restraint: Stainless steel edge device configured to restrain insulation boards in position and provide top flashing over ballast.
- L. Sealants: As recommended by membrane manufacturer.
- M. Walkway Pads: Suitable for maintenance traffic, contrasting color or otherwise visually distinctive from roof membrane.
 - 1. Composition: Asphaltic with mineral granule surface or Roofing membrane manufacturer's standard.
 - 2. Size: Manufacturers standard size.
 - 3. Surface Color: Manufacturer's standard White or yellow.

PART 3 EXECUTION

3.01 EXAMINATION

- A. Verify that surfaces and site conditions are ready to receive work.
- B. Verify deck is supported and secure.
- C. Verify deck is clean and smooth, flat, free of depressions, waves, or projections, properly sloped and suitable for installation of roof system.
- D. Verify deck surfaces are dry and free of snow or ice.
- E. Verify that roof openings, curbs, and penetrations through roof are solidly set, and cant strips are in place.

3.02 PREPARATION - WOOD DECK

- A. Composition:
 - 1. Non-FM Approved Wood Deck: Minimum 1-1/2 inch thick lumber or 15/32 inch thick plywood.
 - a. Install deck according to local code requirements.
 - b. Contact Manufacturer's Technical support for fastening patterns and methods.
- B. Verify flatness and tightness of joints of wood decking. Fill knot holes with latex filler.
- C. Confirm dry deck by moisture meter with 12 percent moisture maximum.

3.03 INSTALLATION, GENERAL

- A. Perform work in accordance with manufacturer's instructions, NRCA (RM), and NRCA (WM) applicable requirements.
- B. Do not apply roofing membrane during cold or wet weather conditions.
- C. Do not apply roofing membrane when ambient temperature is outside the temperature range recommended by manufacturer.
- D. Do not apply roofing membrane to damp or frozen deck surface or when precipitation is expected or occurring.
- E. Do not expose materials vulnerable to water or sun damage in quantities greater than can be weatherproofed the same day.

F. Coordinate this work with installation of associated counterflashings installed by other sections as the work of this section proceeds.

3.04 INSTALLATION - VAPOR RETARDER AND INSULATION, UNDER MEMBRANE

- A. Attachment of Insulation:
 - 1. Mechanically fasten **first layer of tapered** insulation to deck in accordance with roofing manufacturer's instructions and FM DS 1-28 Factory Mutual requirements.
 - 2. If required; Embed second layer of insulation into full bed of adhesive in accordance with roofing and insulation manufacturers' instructions
- B. Cover Boards: Mechanically fasten cover boards in accordance with roofing manufacturer's instructions.
- C. Lay subsequent layers of insulation with joints staggered minimum 6 inches from joints of preceding layer.
- D. Place tapered insulation to the required slope pattern in accordance with manufacturer's instructions.
- E. Lay boards with edges in moderate contact without forcing. Cut insulation to fit neatly to perimeter blocking and around penetrations through roof.
- F. Tape joints of insulation in accordance with roofing and insulation manufacturers' instructions.
- G. At roof drains, use factory-tapered boards to slope down to roof drains over a distance of 18 inches.
- H. Do not install more insulation than can be covered with membrane in same day.

3.05 INSTALLATION - MEMBRANE

- A. Roll out membrane, free from wrinkles or tears. Place sheet into place without stretching.
- B. Shingle joints on sloped substrate in direction of drainage.
- C. Fully Adhered Application: Install adhesive to substrate at rate of 0.69 gal/sq ft. Fully embed membrane in adhesive except in areas directly over or within 3 inches of expansion joints. Fully adhere one roll before proceeding to adjacent rolls.
- D. Overlap edges and ends and seal seams by contact adhesive, minimum 3 inches. Seal permanently waterproof. Apply uniform bead of sealant to joint edge.
- E. At intersections with vertical surfaces:
 - 1. Extend membrane over cant strips and up a minimum of 8 inches onto vertical surfaces.
 - 2. Fully adhere flexible flashing over membrane and up to nailing strips.
 - 3. Secure flashing to nailing strips at 4 inches on center.
 - 4. Insert flashing into reglets and secure.
- F. At gravel stops, extend membrane under gravel stop and to the outside face of the wall.
- G. Around roof penetrations, seal flanges and flashings with flexible flashing.
- H. Coordinate installation of roof drains and sumps and related flashings.

3.06 BUILDING IDENTIFICATION

- A. Face the numbering/lettering toward the street. Locate as close to center of roof as possible.
- B. Numbers/Letters Character Shape: Block type.
 - 1. Character height: 72 inches, minimum.
 - 2. Stroke Width: 6 inches, minimum.
- C. Provide the same roofing product specified to stencil building numbers and building description at each roof.
- D. Coating Thickness: Minimum 25 mils dry. Color: Black.
- E. Color: Black.

3.07 TEMPORARY CUT OFF

- A. Install flashings concurrently with the roof membrane in order to maintain a watertight condition as the work progresses.
 - 1. Construct all temporary waterstops to provide a 100% watertight seal.
 - 2. Make staggered insulation joints even by installing partial panels of insulation.
 - 3. Carry new membrane into the waterstop.
 - 4. Seal waterstop to the deck and/or substrate so that water will not be allowed to travel under the new or previous roofing.
 - 5. Seal the edge of the membrane in a continuous heavy application of sealant as described in Part 2 above.
 - 6. When work resumes, cut out the contaminated membrane.
 - a. Remove all sealant, contaminated membrane, insulation fillers, etc.; from the work area and properly disposed of off site.
 - b. Do not use these materials in the new work.
- B. If inclement weather occurs while a temporary waterstop is in place, provide the labor necessary to monitor the situation to maintain a watertight condition.
- C. If any water is allowed to enter under the newly-completed roofing, remove and replace the affected area at Applicator's expense

3.08 FIELD QUALITY CONTROL

- A. District will provide testing services in accordance with Section 01 40 00 Quality Requirements. Contractor to provide temporary construction and materials for testing.
- B. Provide daily on-site attendance of roofing and insulation manufacturer's representative during installation of this work.
 - 1. Provide regular daily written reports to the Contractor and Architect for every day of roofing installation work.
 - 2. Provide to Architect a written on-site approval by the roofing system manufacturer and sign-off on pre-roofing deck, insulation installation, membrane installation, flashing details and completed assembly.
 - 3. Provide to Architect a Project Closeout Report by the roofing system manufacturer upon delivery of the project warranty. This report shall include the following sections:

- a. Project Specifications.
- b. Project Summary.
- c. Progress reports as a result of roof inspections.
- d. Job progress photos.
- e. Warranty document with Maintenance Manual describing maintenance and emergency repair.
- C. Roofing Inspection and Testing Services by Independent Agency: District's independent agency will provide inspection and testing services during application of roofing system.
 - 1. Unless otherwise directed, inspection, including test cuts and evaluation procedures, will be performed in accordance with Chapter V, "Quality Control," of The NRCA Low-Slope Roofing Manual.
 - 2. Independent agency will provide reports of inspections and tests to Construction Manager and Architect. Copies of reports will also be provided to Contractor.
 - 3. Water Test: Conduct simulated rain storm test by indirect spray of water for 15 minutes over entire roof surface. Check area below roofing for leaks and check top surface for standing water.
 - a. Record test and inspection by video tape or digital recording.
 - 4. Remedial Work: Correct all defects and irregularities reported from inspections and tests, at no change in Contract Sum or Contract Time.

3.09 CLEANING

- A. See Section 01 74 19 Construction Waste Management and Disposal for additional requirements.
- B. Remove bituminous markings from finished surfaces.
- C. In areas where finished surfaces are soiled by work of this section, consult manufacturer of surfaces for cleaning advice and comply with their documented instructions.
- D. Repair or replace defaced or damaged finishes caused by work of this section.

3.10 PROTECTION

- A. Protect installed roofing and flashings from construction operations.
- B. Where traffic must continue over finished roof membrane, protect surfaces using durable materials.

END OF SECTION

SECTION 27 10 00

VOICE / DATA/ IP INFRASTRUCTURE

PART 1 – GENERAL

- 1.1 Include all labor, equipment, and materials necessary for providing a complete networking infrastructure system as described herein and/or as indicated on the drawings.
- 1.2 Related specification sections:
 - 1.2.1 Section 26 01 00 General Provisions
 - 1.2.2 Section 26 05 19 Conductors
 - 1.2.3 Section 26 05 33 Conduit and Fittings
 - 1.2.4 Section 26 05 34 Outlet and Junction Boxes
- 1.3 Contractors working on SBCUSD work projects shall possess as a minimum the following qualifications. Proof of qualification for each item shall be submitted with the project response. Failure to submit proper proof of compliance with each qualification may result in project disqualification. Provide documentation with the project response confirming the following qualifications:
 - 1.3.1 A manufacturer's Certified Installer/Contractor agreement in force at the time of submittal and throughout the entire construction process. A current support document shall be included in the Contractor's response.
 - 1.3.2 Certified to provide factory warranties including a product component warranty and a system performance warranty. The factory warranty period shall not be less than 20 years. Provide current Manufacturer Certificate with response.
 - 1.3.3 Have a Registered Communications Distribution Designer (RCDD[®]) directly employed by the vendor who will be ultimately responsible for this project. Submit current RCDD Certificate with response.
 - 1.3.4 The contractor shall ensure that 100% of the technicians installing a copper system have received a manufacturer's training certificate for copper systems. Submit current certifications for each technician with response.
 - 1.3.5 The contractor shall ensure that 100% of the technicians installing a fiber optic system have received a manufacturer's training certificate for fiber optic systems. Submit current certifications for each technician with response.
 - 1.3.6 The contactor shall have copies of the technicians' certificates available for inspection by the SBCUSD IT Representative upon request.

- 1.3.7 Vendor shall hold in good standing a California C-10 license and a valid California C-7 license. A copy of the license(s) is/are to be included in the vendor's response.
- 1.3.8 Employ Technicians with current Voice Data Video certification by State of California Department of Industrial Relations. Submit proof with response.
- 1.3.9 Employ technicians with minimum of 10 hours of Construction Safety and Health training as provided by Cal/OSHA. Submit with response.
- 1.3.10 The Vendor must have completed a minimum of five projects of similar size and scope for public School District entities within the past three years, and have a successful history of sales, installation, service, and support. Provide references of similar projects with response.
- 1.3.11 All Low Voltage and High Voltage work shall be done "in-house", no subcontractors for this type of work.
 - 1.3.11.1 Any subcontractors for any work outside of Low Voltage/High Voltage work must be included in the response or that subcontractor will not be allowed to be utilized later (i.e., trenching subcontractor). Vendor must act as prime.
- 1.4 Supporting Codes and Standards Documents

It is not possible to list all of the applicable Codes and Standards documents. A noninclusive list of key documents is presented below as a minimum:

- 1.4.1 ANSI/EIA/TIA-568-B: Commercial Building Telecommunications Cabling Standard
- 1.4.2 ANSI/EIA/TIA-569-A: Commercial Building Standard for Telecom Pathways and Spaces
- 1.4.3 ANSI/EIA/TIA-606: Administration Standard for the Telecommunications Infrastructure of Commercial Buildings
- 1.4.4 ANSI/EIA/TIA-607: Commercial Building Grounding/Bonding Requirements
- 1.4.5 NFPA 70: National Electrical Code
- 1.4.6 ISO/IEC 11801: Generic Cabling for Customer Premises
- 1.4.7 BICSI :Telecommunications Distribution Methods Manual (TDDM)
- 1.5 The latest revision of each document, and other related documents, is to be considered the one in force at the time of system construction and delivery to SBCUSD. The vendor is required to comply with the applicable documents in content and intent as well.

ADDENDUM # 02

1.6 If any applicable documents are in conflict, then the more stringent requirement shall apply. The Contractor is required to advise the SBCUSD Information Technology (IT) Representative of any conflict that could result in work deficiencies.

1.7 Cabling System

All copper and fiber optic components of the cabling system are either to be of a single manufacturer, or of a manufacturer partnership under a system trade name offering a single point of contact for SBCUSD in the event of a warranty claim. The SBCUSD has chosen the Panduit TX6A 10 Gig UTP Copper Cabling solution as the baseline for all equivalents to be measured.

1.7.1 **Panduit/General Cable**

- 1.7.1.1 Installing Contractor must be NetKey Certified Installer certified to install this system.
- 1.7.1.2 Warranty provision and training must be for the Panduit Certification Plus System Warranty – 25-Year Performance program.
- 1.7.2 Warranty shall be to the District, for the period as defined by the Network Infrastructure System selected for installation, after District acceptance and sign-off of the completed system. The Contractor must provide documentation from one of the approved manufacturers, as indicated in Section 1.4, indicating their qualifications for installation of this system in compliance with the manufacturer/s warranty period requirements as warranted Contractor.
- 1.7.3 Equipment qualifications: It is the intent of these specifications that each bidder provides all hardware, components and installation services that are necessary to ensure a fully operational wiring system including warranties, as shown in the EIA/TIA Category-6 and the Augmented Category-6 (6A) guidelines.
- 1.7.4 Copper System: SBCUSD requires a high performing Category 6A system that meets the following system performance guaranteed headroom as a minimum based on worst pairs:

Electrical Value	TIA/EIA	ISO
	Category 6A	Class EA
Insertion Loss	3%	3%
NEXT	3.5 dB	2.5 dB
PSNEXT	5 dB	4 dB
PSACR-F	10 dB	10 DB
Return Loss	3 dB	3 dB
PSACR-N	6.5 dB	6.5 dB
PSANEXT	2 dB	2 dB
PSAACR-F	10 dB	10 dB

- 1.7.5 All components, parts, infrastructure, patch cables, termination panels and cables must be classified by the manufacturer or manufacturers as a part of the "Extended Warranty" program. Contractor may not mix in components from other certified programs or materials that are not considered part of the "Lifetime" warranty.
- 1.7.6 Systems or components as manufactured by any other manufacturer which, are not specifically listed in 1.4 1.7.1 are <u>not</u> approved for use on this project.
- 1.8 Installing Contractor qualifications: Firms and their personnel must be regularly engaged in the installation of data networking cabling and equipment for systems of similar type and scope. The Contractor must have a full-service office able to respond to emergency callouts during the warranty period. The Contractor must also provide complete installation of all wiring and devices or equipment. Subcontractors with Electrical Contractors or other warranted or non-warranted Contractors for supervised installation of any part of this system are not approved.
 - 1.8.1 Contractor shall have on staff a minimum of (1) BICSI RCDD as full-time employees.
 - 1.8.2 The successful Contractor shall be a California licensed C7 or C10 Premise Wiring Contractor as defined in this specification.
 - 1.8.3 All work shall be performed under the supervision of a company accredited and trained by the Manufacturer of the components and cable and such accreditation must be presented with the bid submittal. All personnel performing work on this project must have successfully completed the manufacturer's training courses to completely comply with the extended warranty requirements prior to performance of any work on this project. Accreditation will consist of individual employee certifications issued by the manufacturer or manufacturers.
 - 1.8.4 All personnel engaged in the testing of premises fiber optic and copper UTP cable systems must have successfully completed the test equipment manufacturer's training courses. Certification of such training must be presented with the bid submittal. Cut sheets of the test equipment to be utilized shall be provided with Phase I project material submittals.
 - 1.8.5 This project shall employ Augmented Catefory-6 cabling ONLY. The Contractor shall install the related components in relation to the performance requirements for the type of cable installed.
 - 1.8.6 If Contractor routes cable and/or associated pathways in another route than indicated on the drawings, they shall maintain all maximum cable installation distances as required by the manufacturer's distance limitations.

- 1.9 In order to ensure project cohesion, a single point of contact is required to provide a "TURNKEY" solution. The work covered under this section of the specification consists of furnishing all: labor, cabling, equipment, supplies, materials, and training.
- 1.10 The drawings indicate a schematic routing of cables above-ceiling cable prior to bid. Where cables penetrate through walls a conduit sleeve shall be provided. Where cables pass through fire rated walls, the conduit sleeve shall be sealed to maintain the rating of wall assembly.
- 1.11 Unless otherwise noted in the project drawings or these specifications, the Division 26 Contractor shall provide the installation of all conduits, outlet and junction boxes, trenching and pull box installation.
- 1.12 General Submittal Requirements
 - 1.12.1 **Phase I Submittal** shall be made in electronic format within (20) working days after the award of the contract by the District. This submittal shall include the following:
 - 1.12.1.1 Complete Bill of Materials in Excel Spreadsheet format with bills of quantities, including all materials, components, devices, and equipment required for the work. The bills of quantities shall be tabulated respective of each and every system as specified, and shall contain the following information for each Section listed:
 - 1.12.1.2 Description and quantity of each product.
 - 1.12.1.3 Manufacturer's Name and Model Number.
 - 1.12.1.4 Manufacturer's Specification Sheet or Cut Sheet.
 - 1.12.1.5 Specification Item Number reference for each required product or if not shown in the specification, Drawing Detail Number being referenced (i.e. Spec 2710000 Item 2.1 or DWG E4.15/#1).
 - 1.12.1.6 Include with submittals all warranty information and a description of support and maintenance services to be provided. Also include all licenses and maintenance agreements required for continued operation of the equipment.
 - 1.12.2 **Phase II Submittal** shall be provided with (20) working days after the approval of the Phase I submittals and prior to any fabrication of field conduit installations. All shop drawings shall be engineered in a CAD Software. Submission shall include electronic print copies to match the contract drawings, and Phase II submittals drawings shall include the following:

- 1.12.2.1 MDF and IDF equipment rack or cabinet elevations will be required to be provided including cable routing, grounding, support, UPS, network electronics, etc. and position of all components in the rack or cabinet.
- 1.12.2.2 Provide labeling plan which identifies the proposed scheme for identifying all components including racks, patch panels (fiber and copper), site distribution feed cables, horizontal station cables and site conduit systems (handholes, pullboxes, etc.).
- 1.12.2.3 Provide shop drawings showing all end device locations, tap values, paging zones and amplifier sizing for each zone for analog speakers and horns, including devices connected to IP-Based zone controllers.
- 1.12.3 Common submittal mistakes which will result in submittals being rejected:
- 1.12.3.1 Not including the qualifications of the installing Contractor Company and Contractor's Staff.
- 1.12.3.2 Not including all items listed in the above itemized description.
- 1.12.3.3 Including catalog cut sheets which have several items on a page, and not clearly identifying by highlights, underlining or clouding the items to be reviewed (provided for the project) or crossing out the items which are not applicable.
- 1.12.3.4 Not including actual manufacturer's cut sheets or catalog information of proposed products.
- 1.12.3.5 Do not include multiple manufacturers for similar products and do not indicate "or approved equal" statements, or "to be determined later" statements. The products being submitted must be the products installed.
- 1.12.4 The Contractor shall make a written request directly to Johnson Consulting Engineers for electronic drawing files (CAD). As a part of the written request, please include the following information:
 - 1.12.4.1 Clearly indicate Project Name and Client, Johnson Consulting Job Number (located in the bottom left corner of JCE Engineering Stamp) and each drawing Sheet Number required (i.e. E1.1, E2.1, E4.1 etc.)
 - 1.12.4.2 Identify the Name, Company, Title, phone number, mailing address and e-mail address of the person to receive the files.

ADDENDUM # 02

- 1.12.4.3 Detail or Riser diagram sheet, System Schematic drawings or any other drawings other than floor plans or site plans, will not be made available to the Contractor.
- 1.12.4.4 Files will only be provided in the AutoCAD format in which they were created (i.e. version 2015 or version 2016). Files will not be made available in REVIT format.
- 1.12.4.5 Requests for files will be processed as soon as possible; a minimum of (7) working days should be the normal processing time. The Contractor shall be completely responsible for requesting the files in time for their use and delays in requesting files will not alleviate the Contractor from submitting required documents within the required timeline.
- 1.13 Copper Cable Color Standards for Horizontal Cabling, Jack Inserts and Patch Cords:

The following colors are the District Standards for the specific network devices and services listed below:

- 1.13.1 <u>Yellow:</u> The Default color to be utilized when the project to install cabling has no specific device/service usage already determined, or will be used for general Data services (i.e. Internet Access by wired classroom drops) or is not specified to be one of the other color definitions. The District has standardized on the color Yellow for horizontal cabling and jack inserts and patch cables on both ends of the horizontal cabling must also be Yellow in color if the devices/services are still not identified at the time of installation. Otherwise, at any point prior to the installation of the cabling, inserts or patch cables, if the device types and services become known, the color is to be switched to the identified color standard in support of those now identified devices and services listed below.
- 1.13.2 <u>Red</u>: To be utilized when the project to install cabling has determined that the devices and services are in support of Alarms, Energy Management Systems (EMS), and Environmental monitoring. The District has standardized on the color Red for horizontal cabling and jack inserts and patch cables on both ends of the horizontal cabling must also be Red in color.
- 1.13.3 <u>Orange</u>: To be utilized when the project to install cabling has determined that the devices and services are in support of Wireless Access Points (internal and external). The District has standardized on the color Orange for horizontal cabling and jack inserts and patch cables on both ends of the horizontal cabling must also be Orange in color.
- 1.13.4 <u>Green:</u> To be utilized when the project to install cabling has determined that the devices and services are in support of IP Cameras for Video Surveillance. The District has standardized on the color Green for horizontal cabling and jack

inserts and patch cables on both ends of the horizontal cabling must also be Green in color.

- 1.13.5 <u>Blue:</u> to be utilized when the project to install cabling has determined that the devices and services are in support of Audio/Visual displays and devices that connect clients to those projectors/TVs. This includes all Wi-Di devices, Projectors and Apple TVs. The District has standardized on the color Blue for horizontal cabling and jack inserts and patch cables on both ends of the horizontal cabling must also be Blue in color
- 1.13.6 <u>Purple:</u> To be utilized when the project to install cabling has determined that the devices and services are in support of VOIP/Voice Phones/VOIP Hardware. The District has standardized on the color Purple for horizontal cabling and jack inserts and patch cables on both ends of the horizontal cabling must also be Purple in color.
- 1.13.7 <u>Black:</u> To be utilized when the project to install cabling has determined that the devices and services are in support of IP-based Bells and Paging. The District has standardized on the color Black for horizontal cabling and jack inserts and patch cables on both ends of the horizontal cabling must also be Black in color.

1.14 Cable

SBCUSD requires all cabling being installed within a building to be plenum rated in all environments. Even though quite desirable, SBCUSD is not aware of a Category 6A indoor/outdoor plenum-rated cable. As a result, SBCUSD is willing to accept an indoor/outdoor CM rated cable as long as the NEC termination and pathway requirements are met. Regardless of environment, the cabling shall be of the same electrical performance as Category 6A and be warranted by the same cabling system manufacturer, as Panduit or equivalent.

- 1.14.1 Ethernet patch cords must be made of 100% pure bare copper wire, as opposed to copper clad aluminum (CCA) wire, to be fully compliant with UL Code 444 and National Electrical Code TIA-568-C.2 fire and safety standards, which require pure bare copper wire in communications cable.
- 1.14.2 Installation of cabling shall be of continuous length from each termination point.
- 1.14.3 No length of cable shall exceed 285 feet (tested length)
- 1.14.4 The bend radius of any cable shall not exceed 4 times the diameter of the cable.
- 1.14.5 Should the cable become kinked while being installed, the contractor shall not attempt to repair the cable, but shall remove and replace the entire run. All cable runs are potential inspection items for the SBCUSD IT Representative.
- 1.14.6 The cable jacket shall be maintained as close to the point of termination as possible.

- 1.14.7 The cable pairs shall not be untwisted more than 1/2" from the termination point.
- 1.14.8 All cabling is to be installed in its own pathway and fully supported.
- 1.14.9 Cabling shall be installed with no more than a 4-foot space between supports.
- 1.14.10 Cabling can be installed in pathways such as cable tray and ladder racking, as long as the pathway is low-voltage cabling only, the pathway is appropriately bonded to the building grounding system, and the Data System cables are bundled separately from other low voltage cabling
- 1.14.11 Underground cabling can be installed inside buildings to the ultimate termination point without transition as long as the cabling is rated for such applications.
- 1.14.12 Industry Standard cable waste varies between 7% and 10% per project and the District will not accept final invoices for cabling where cable waste exceeds 10%
- 1.15 Terminations
 - 1.15.1 Jack modules shall be of insulation-displacement termination construction and may offer mass termination of all four pairs simultaneously. In addition, a jack module must be available as part of the cabling system, and facilitate the same system performance and warranties, that can be utilized in existing workstation outlet faceplates from other manufacturers. The most common situation is the Avaya (Lucent) system. Another common situation is Wiremold 5400 raceway.
 - 1.15.2 In an effort maximize space, SBCUSD has standardized on a discrete modular patch panel system. The system must allow the following:
 - 1.15.2.1 Presentation of 48 individual module ports in a 1U (1.75") rack height, preferred.
 - 1.15.2.2 Presentation of 24 individual module ports in a 1U (1.75") rack height.
 - 1.15.2.3 Presentation of 12 individual module ports to be mounted in an 89B type wall bracket.
 - 1.15.2.4 Category 6A connectivity
 - 1.15.3 Cabling shall be dressed cleanly and fully supported via hook & loop straps and cabinet/rack supports. All cabling bundles are to be loosely secured with hook & loop straps only. Cable ties are not to be utilized. In addition, hook & loop straps must not be spaced at regular intervals but must vary between 4-6 inches at random over the length of the secured cable section.

- 1.15.4 Cabling slack can be placed in the cabinet/rack area as well as the ceiling areas if fully supported by the proper pathway device. No more than 4 feet per horizontal run shall be stored.
- 1.15.5 It is preferred that horizontal cabling does not bypass a patch panel and be terminated and directly plugged into a switch. Any cases would need to be signed off by SBCUSD IT Representative(s).
- 1.15.6 No particular order is required between workstation cabling terminations or Access Point cabling terminations, though there are instances where AP cabling must be on a specific patch panel associated with an AP supporting edge switch and other existing AP cabling.
- 1.15.7 The patch panel ports are to be populated beginning with port one in sequence (left to right), leaving no open ports. The only exception will be with 24-port switches that have their ports only on the right side of the faceplate and will require patch panel ports to be populated from right to left to allow for the desired patch cord lengths to work.
- 1.15.8 Provide a minimum of 20% spare ort capacity for future use.
- 1.15.9 Any new copper cabling to patch panels should be patched into an open switchport if available. If no ports are available, do not unplug any existing connectivity. Notify SBCUSD IT Representative(s) that a new switch is needed.
- 1.15.10 Fiber optic cabling shall be terminated in a fiber enclosure of appropriate size for the cabling being terminated. Unused adaptor panel ports shall be filled with blank panels
- 1.15.11 Provide a spreadsheet indicating what drops are cabled to the active switch port to be turned over to the SBCUSD IT Representative.

PART 2 – PRODUCTS

- 2.1 Equipment racks have been detailed on the drawings and additional component information requirements have been described in the following sections and on the drawings. The following is a list of approved manufacturers for each type of rack to be furnished.
 - 2.1.1 Alternate equipment manufacturers other than those indicated will not be reviewed or approved for use on this project.
 - 2.1.2 (Open Frame 4-Post) shall be manufactured by Southwest Data Products , Chatsworth CPI Quadrarack #50120-703 or Middle Atlantic R4 Series. Reference drawing details and specifications for complete requirements.

ADDENDUM # 02

- 2.2 Open Frame 4-Post Racks, 19" mounting Width by 84" High by 29" Deep with #12-24 mounting holes as shown in the MDF of IDF Room layouts. Contractor shall be responsible for providing all racks and accessories. Furnish and install with the following:
 - 2.2.1 The racks shall be provided with structural seismic bracing using cable runway to the top of the rack.
 - 2.2.2 Universal 12" cable runway shall be as manufactured by Southwest Data Products or CPI. The cable runway shall be furnished with the additional adapters, connectors, support components, bends and offsets and extensions as required to fit the room and layout.
 - 2.2.3 Anchor the cable runway to the wall with the appropriate width angle bracket and bolts as manufactured by Southwest Data Products or CPI.
 - 2.2.4 The cable runway shall also be attached to the top of the rack with the appropriate adapter panel. Cable runway shall be directly attached to the 4-Post racks with J-Hooks.
 - 2.2.5 Cable runway routed along walls, shall be offset from the wall a minimum of 6" and shall be supported with cantilevered wall mount brackets.
 - 2.2.6 Floor mounted racks shall be structurally anchored to the floor with the anchors and bolts.
 - 2.2.7 Provide full length vertical wire managers, CPI Double-Sided Narrow Vertical Manager, Part #12096-703, on each side of each rack. Vertical managers between racks may be substituted with the CPI #11729-703 6" wide double-sided manager. Single narrow vertical managers shall be provided on each end of the group of racks.
 - 2.2.8 Provide Middle Atlantic Model #VDC-6-45-DC vertical managers when installing the Middle Atlantic R4 Series racks.
 - 2.2.9 Provide (1) adjustable full depth vented shelf for each 4-Post equipment rack as manufactured by Southwest Data Products or CPI #12700-719.
 - 2.2.10 Patch panels and switches must be directly adjacent to each other, and patch cords shall be 8". Provide horizontal wire managers between each patch panel or (1) manager per patch panel. Provide (1) spare manager per rack. Provide 2RMU height managers for each 48-Port patch panel and 1RMU height managers for 24-Port patch panels. CPI part #30130-719 and #30139-719.
 - 2.2.11 Provide (1) minimum or more where detailed on drawings. Rack mounted surge arrest style power distribution unit per rack. 1 rack unit in height. TrippLite Model #PDUMH15NET2 with (8) NEMA 5-15R outlets, built-n SNMP Ethernet interface and NEMA L5-15P input with 5-20P adapter or approved equal by APC. Provide with minimum 10-foot cord for the PDU.

- 2.2.12 Contractor shall be responsible for neatly routing, storing and connecting the power cords from the PDUs to the electrical outlet or UPS as directed by the District. Power cords shall be dressed separately from the UTP cables or any other low voltage cable and shall be secured to the back of the rack or cable runway with Velcro ties.
- 2.2.13 Furnish grounding to each rack. Each rack shall be provided with a grounding terminal block, #6 Ground wire from the rack to the bus bar and a compression lug on the end of the ground wire at the bus bar. Provide grounding components as manufactured by CPI #40167-001 terminal block and #40162-901 compression lug or approved equal.
- 2.2.14 Provide (1) ground bus bar kit per MDF Room. Ground Bus Bar Kit as manufactured by CPI #40158-012 or approved equal. Ground Bus Bar and all bonding conductors to the bus bar shall be labeled. Grounding conductors shall be routed to the equipment racks, cable runway and electrical panel.
- 2.2.15 All fiber optic feed cables routed to the MDF Room shall be provided with 20-feet of slack for a service loop mounted on the backboard behind the racks. Contractor shall provide a 24" diameter wall mounted service loop manager for the fiber optic feed cables as manufactured by Leviton #48900-FR. Maximum of (3) fiber feed cables per manager. Provide quantity of managers as required to manage all service loops.

MDF Room Requirements

- 2.3 The main Distribution Frame (MDF) Room shall be the central wiring and equipment location for the network infrastructure systems. This room is existing for this project.
- 2.4 Provide Fiber Optic Feed Cable Patch Panels Fiber optic termination equipment (rack mounted), including all associated installation hardware. The equipment must have a sufficient number of ports to connect all fibers in every cable terminated at this location. Provide 25% spare capacity for future wiring requirements, including bulkheads in the fiber patch panel. Provide blank fillers for all used portions of the panel. All fiber feed cables shall be terminated in a single fiber optic patch panel up to 144 strands. Additional strands shall be terminated in the largest size required to continue the remaining fibers.
 - 2.4.1 Contractor shall provide a minimum of 6-feet of slack on the fiber feed cable in the fiber optic patch panel. The first 48" of a tight buffered cable or the first 24" of a loose tube cable shall not be stripped back in the patch panel. Each type of cable shall have a minimum of 24" of stripped slack within the patch panel. Total slack within the patch panel shall not be less than 6-feet in length.
 - 2.4.2 All fiber cables shall be secured to the patch panel with the Kevlar strength members at the manufacturer provided anchor point at the rear of the panel.

IDF Location Requirements

- 2.5 The Intermediate Distribution Frame (IDF) Room shall be a secondary wiring and equipment location for the data networking system. The Contractor shall include the following items at this location:
 - 2.5.1 Provide backboard 8'-0" high x ³/₄" thick, with a minimum 48" width with minimum 2 coats of fireproof paint(not over labels).Refer to the floorplans for the actual layout of the backboard coverage. Plywood mounting backboard shall be flame resistant, painted with fire resistant paint "white" or color to match the room finish. Contractor shall provide minimum one side finish grade plywood. Backboard shall be mounted with finish side out, regardless of location of fire rating stamp. Show proof of fire rating stamp to IOR on Inspector prior to installation.
- 2.6 Provide Fiber Optic Feed Cable Patch Panels Fiber optic termination equipment (rack mounted), including all associated installation hardware. The equipment must have a sufficient number of ports to connect all fibers in every cable terminated at this location. Provide 25% spare capacity for future wiring requirements. Provide blank fillers for all used portions of the panel. All fiber feed cables shall be terminated in a single fiber optic patch panel.
 - 2.6.1 Each IDF location shall be furnished with a minimum 24-Port patch panel, fully loaded with bulkheads. Type of connectors in the bulkheads shall be determined by the type of connectors used for termination of the fiber feed cables.
 - 2.6.2 Contractor shall provide a minimum of 6-feet of slack on the fiber feed cable in the fiber optic patch panel. The first 48" of a tight buffered cable or the first 24" of a loose tube cable shall not be stripped back in the patch panel. Each type of cable shall have a minimum of 24" of stripped slack within the patch panel. Total slack within the patch panel shall not be less than 6-feet in length.
 - 2.6.3 All fiber cables shall be secured to the patch panel with Kevlar strength members at the manufacturer provided anchor point at the rear of the panel.
- 2.7 Augmented Category-6 Patch Panels (rack mounted) with RJ45 style connectors, for terminating all twisted pair cable from each Voice/Data/IP outlet served from this location. Provide 25% spare capacity for future wiring requirements. All patch panels shall be 24 or 48-ports maximum. Provide cable support bars at the rear of each patch panel. All cable shall be secured to bars with Velcro straps.
- 2.8 All fiber optic feed cables routed to the IDF locations shall be provided with 20-feet of slack for a service loop mounted on the backboard behind the racks, or stored in the back of the wall mounted cabinets. Contractor shall provide a 24" diameter wall mounted service loop manager for the fiber optic feed cables as manufactured by Leviton #48900-FR. Maximum of (3) fiber feed cables per manager as required to manage all service loops. Provide a 12" diameter service loop manager in the rear of wall mount IDF cabinets by Leviton #48900-FR.

2.9 Cabinets/Racks Redressing Requirements

In compliance the SBCUSD efforts to maximize space, equipment shall be placed as follows:

- 2.9.1 Incoming IDF/LDF Fiber Tray at the top.
- 2.9.2 The 1U 48-port discrete modular patch panel to be positioned below the fiber tray(s).
- 2.9.3 The first switch to be positioned next.
- 2.9.4 The second 1U 48-port modular patch panel follows the first switch.
- 2.9.5 The second switch next.
- 2.9.6 The third 1U 48-port modular patch panel next.
- 2.9.7 Another switch next.
- 2.9.8 And so forth.

IDF UPS Requirements

- 2.10 General UPS Requirements The Contractor shall coordinate with the Division 26 Contractor to properly locate the power outlet connection for the UPS in the IDF Room or Cabinet. The location shown on the floor plans is diagrammatical and does not give the Division 26 Contractor an exact placement. In addition, all UPSs must be furnished with heavy duty mounting bracket kits. A UPS installed in a wall mounted IDF Cabinet must be furnished with a 2-Post kit that can support the full weight of the unit.
- 2.11 Final location for the UPS, within the equipment racks or IDF locations with multiple racks, must be verified by the District IT Director or District Construction Project Manager prior to the installation of the UPS or the electrical outlet for the UPS.
- 2.12 UPS Requirement for an IDF location with (1) 2 or 4-Post equipment racks being installed at the IDF closet:
 - 2.12.1 Provide with a minimum of Four 5-15R and four 5-15/20R outlets.
 - 2.12.2 Provide with Two independently switched single-outlet load banks (one 5-15R and one 5-15/20R)
 - 2.12.3 Provide network interface card Model Optional WEBCARDLX Network Interface option in UPS. Software shall be included with the UPS.
 - 2.12.4 Provide (1) environmental sensor/monitor in each IDF cabinet location. Provide TrippLite Model #ENVIROSENSE monitor unit and connect it to the UPS.

2.12.5 Provide TrippLite Model # SMART2000RMXL2U 120V 2000VA 1920W Line-Interactive UPS with 8 Outlets (or approved equal by APC).

Fiber Optic Patch Cords

- 2.13 Fiber optic patch cords shall be furnished and installed by the Contractor.
- 2.14 All fiber optic patch cords furnished by the Contractor shall match the grade and glass of the fiber optic feed cable installed for the network infrastructure cabling system. The Contractor shall confirm with the District IT Department the type of connector required at the network equipment prior to ordering or installing the patch cords.
- 2.15 Multimode Fiber Optic Patch Cords Parch cords shall be duplex 50/125um, laseroptimized, OM4 (OM4+) grade multimode optical glass. Fiber optic patch cords shall be furnished with LC connectors at the network switch port end and LC connectors at the fiber optic patch panel end. Fiber patch cords shall be furnished with ceramic ferrules. All Multimode patch cords shall be Aqua (Lt. Blue) in color. Patch cords shall be 6-feet (2-meters) 3-feet (1 meter) in length. Provide adequate patch cords to patch all strands of the fiber cables.
- 2.16 Contractor shall be responsible for confirming the network switch connections with the District IT Director prior to ordering or installing the patch cords.

Copper Patch Cords

- 2.17 Copper patch cords shall be furnished and installed by the Contractor.
- 2.18 Provide Augmented Category-6 (Patch Panel End) patch cords with pre-molded boot; provide quantity equal to:
 - 2.18.1 Provide 100% of the total Category-6A cable ports provided on the patch panels.
 - 2.18.2 All patch cords to be installed by Contractor. Provide 100% of total copper patch cords required to be (4) feet (8") in length.
- 2.19 Provide **Augmented Category-6** (Workstation End) patch cords with pre-molded boot, provide quantify equal to:
 - 2.19.1 Provide 100% of the total Category-6A cable drops provided on the patch panels.
 - 2.19.2 All patch cords to be installed by Contractor. Provide 100% of total copper patch cords required to be (10) feet in length, unless otherwise noted.
 - 2.19.3 Patch cords installed at WAP (Wireless Access Point) locations, IP Camera and IP Intercom locations shall be (2) feet in length.
- 2.20 Requirements for all copper patch cords furnished:

- 2.20.1 Color of patch cords shall be determined by the color code indicated above.
- 2.20.2 Patch cords shall as manufactured by Panduit, based on the network infrastructure system furnished by the Contractor.
- 2.20.3 Patch cords furnished must be in compliance with the manufacturer's "Channel" warranty requirements. Patch cords not warranted through the selected manufacturer Channel warranty program will not be approved for use with the network infrastructure.
- 2.20.4 Provide all other items as detailed on the drawings.

Campus Indoor/Outdoor Fiber Optic Feed Cable

- 2.21 Provide one continuous 12 strand fiber optic cable routed from the Main Distribution Frame fiber patch panel to each intermediate Distribution Frame fiber patch panel, and/or other locations as shown on the drawings.
- 2.22 SBCUSD would like to utilize no less than Laser Optimized OM4-rated (defined in TIA-492-AAAD) graded-index Multi Mode Fiber with 850 nm VCSELs (vertical- cavity surfaceemitting lasers) for all backbone cabling where the distance run is 400m or less which is capable of 10Gb/s connectivity from end-to-end. For all distances exceeding 400m, then Single Mode Fiber is to be utilized to achieve 10Gb/s connectivity end-to-end.
- 2.23 Innerduct pathway, as manufactured by Carlon (or approved equivalent) shall be utilized as specifically located on the construction drawings. Plenum rated innerduct for exclusive indoor use shall be required. OSP rated innerduct for exclusive outdoor use shall be required and for instances where the innerduct enters a building for no more than 50'. Indoor/outdoor rated innerduct shall be required for instances where the innerduct will enter a building for more than 50'.
- 2.24 Outdoor Fiber Feed Cable Applications Fiber optic cable shall be rated for indoor/outdoor Plenum rated applications. Construction shall consist of, all dielectric, tight buffer with central strength member, flame retardant PVC or PE jacket, rated OFNR, dry water-blocking compound only, and blank fillers are required. Central tube type fiber will not be considered equal.
- 2.25 Fiber optic feed cables for the data infrastructure must be installed as follows:
 - 2.25.1 Multimode Fiber Optic feed cable runs Fiber optic feed cable containing only Multimode strands shall be installed as a single feed cable. Provide a 12-strand of multimode fiber optic feed cable in a single jacket, as shown on the riser diagram, to the IDF locations.
 - 2.25.2 Feed cables shall be clearly defined and labeled for each system. Provide color coding designations with a different color marker for the multimode and/or single mode fiber feed terminations in the fiber patch panels.

- 2.26 Cable shall contain one or all types of fibers listed below:
 - 2.26.1 Provide Multimode 50/125-micron fiber optic glass, (minimum OM4+ laseroptimized grade, extended distance) for dual mode operation at 850 nm and 1300 nm wave lengths.

2.26.1.1 Maximum attenuation at 3.0dB/km @ 850nm and 1.0dB/km @ 1310nm. Minimum 1-gigabit Ethernet distance guarantee of 1110 meters @ 850nm and 600 meters @ 1300nm. Minimum 10-gigabit Ethernet distance guarantee of 550 meters @ 850nm/1300nm. Fiber shall be ISO-TIA OM4 plus rated.

- 2.26.2 Refer to drawings for cable types required. Refer to acceptable cables section for additional information and approved manufacturers.
- 2.27 Each fiber optic cable shall contain the quantity of strands of optical fibers as detailed on the drawings.
- 2.28 All fibers in a multi-fiber cable shall be fully operational within the required performance characteristics. If any individual fiber does not meet the minimum standards, the entire cable must be replaced, end to end, including connectors, without any additional expense to the customer.
- 2.29 Acceptable cables shall be:

General Cable Multimode – NextGen OM4+ (Type BM)

Above glass types are an example of product names per manufacturer. Confirm requirements for indoor/outdoor, riser and plenum rated cable with riser drawings and site plans. Part numbers for composite style cable will vary greatly. Confirm part numbers with manufacturer.

Augmented Category-6 Station Cable

- 2.30 Contractor shall provide one Augmented Category-6 UTP cable to each Data, Voice, IP Page, Audio-Visual Data Connection, or any other location as indicated on the drawings and specifications. Provide quantity of cables as indicated on the drawings at each location. IP Camera, Wireless Access Points shall require a total of (2) Augmented Category 6 cable to each location unless otherwise noted.
- 2.31 Provide one Augmented Category-6, 4-pair unshielded twisted pair (UTP) cable from the nearest MDF or IDF location to each RJ45 data outlet port indicated on the drawings. Dual port outlets will require two such cables. Four port outlets will require four cables. Refer to the drawing details for jacket color requirements for each type of connections. Color of cable jacket for each type of connection shall be determined by the drawing

details. Confirm color of cable jacket prior to ordering with the District IT Director. Contractor shall be responsible for providing the correct jacket color per the drawings per District Standards.

- 2.32 Unless otherwise shown in drawing details, the color of the Augmented Category 6 UTP cables shall be per District Standard, individually insulated and color coded.
- 2.33 The cable shall be UL or ETL rated and UL verified in compliance with Augmented Category7-6 EIA/TIA standards. Approved cables for Network Infrastructure System:

General Cable− GenSPEED[®] 10 MTP[™] Small Diameter Category 6A Cable (or approved equal)

- 2.34 On projects requiring plenum rated cabling, provide the plenum jacketed version of the type of cable shown in the specifications. Refer to the contract drawing for areas requiring plenum rated cabling.
- 2.35 Where data cables are indicated to run underground, Contractor shall use an Augmented Category-6 OSP-rated cable. Approved cables for Network Infrastructure System:

GenSPEED[®] 10 UTP Indoor/Outdoor Plenum Category 6A Cable

2.36 Contractor shall provide shielded termination products for all drop locations and terminations panels and shall ground all products per manufacturer's instructions and warranty requirements.

IDF to MDF Voice Feed Cables

- 2.37 Provide multi-pair UTP Category-5E cable from each IDF to the MDF, unless otherwise shown on the drawings. Cable must be 24 AWG, 22 AWG conductors will not be approved as an acceptable equal. Refer to the Riser Diagram for size of feed cables to be provided. Cables shall be 25-Pair to each of the IDF locations.
- 2.38 The outside plant cable shall have an aluminum shield, conductors surrounded by FLEXGEL III filling compound (or other water-blocking compound), and have a black polyethylene jacket.
- 2.39 For voice feed cables, terminate all pairs on both ends of the cable on building entrance protectors on the termination blocks. Follow standard voice color codes for termination. Building entrance protectors shall be furnished with a ground wire to the local ground bus in the MDF/IDF Room.
- 2.40 Plug in Surge Protection Modules shall be provided for each pair terminated on the protector chassis. Protector module shall be solid state type unless otherwise noted:

- 2.40.1 240VDC/300VDC solid state protector modules shall provide transient and power fault protection for standard telephone line applications. The modules shall be fast acting, self-resetting current limiters to protect against sneak current type faults. These modules shall be UL Listed with int30VDC/75VDC solid state.
- 2.40.2 30VDC/75FCD solid state protector modules shall provide transient and power fault protection for digital and data line applications. The modules shall be fast acting, self-resetting current limiters to protect against sneak current type faults. These modules shall be UL Listed with integrated test points and Red in color.
- 2.40.3 In the event that protector modules are not called out in the drawings, Contractor shall include all costs in base bid to provide the 75v solid state modules w/sneak current protection. Confirm module color with District's Engineer prior to ordering. In all cases, Contractor is responsible to coordinate appropriate module with District prior to ordering material.
- 2.40.4 Approved manufacturers shall include: Circa, Emerson and Marconi.
- 2.41 All voice feed cables will be tagged on the incoming cable with a typed permanent label with information as to its origin, house pair count, and cable destination. All termination blocks shall be labeled with type written labels that fit between the termination blocks (e.g. clear snap-on covers, adhesive labels and holders). Pairs shall be identified a minimum of every 5 pair on the block.
- 2.42 Provide distribution rings for the termination blocks and entrance protectors mounted at the MDF and IDF locations.
- 2.43 Ground and bond feed cables at one end of cable to aluminum shield with approved "bullet bond" type ground lug and #10 AWG green ground wire. Connect ground wire to closet ground buss bar.
- 2.44 Acceptable manufacturers shall be: Superior Essex or equal, for outdoor riser cable applications.
- 2.45 Data Contractor is responsible for providing the District with detailed feed cable documentation as well as identifying all of the physical cable in the MDF and IDF locations. Contractor shall have all installation, termination and documentation of voice feed cable completed and released to the telephone equipment vendor, a minimum of three weeks prior to the cut-over date set by the District.
- 2.46 Data Contractor is responsible for testing port connectivity from the punch blocks in the IDF closets to the main feed cable blocks in the MDF Room. Test all pairs for continuity and polarity. All testing must be completed a minimum of three weeks prior to the cut-over date set by the District.

Augmented Category-6 Outlets

- 2.47 Unshielded twisted pair Augmented Category-6A outlets shall be an RJ45 Enhanced performance type 8-position / 8 conductor modular jacks, and shall comply with Category-6 performance requirements. Provide single port, dual port, four port or quantity as indicated on the floor plans at each outlet location. All outlets shall be wired in an EIA/TIA 568B configuration.
- 2.48 Provide Category-6 inserts, wired for EIA 568B. Provide installation kits for all locations furnished with Category-6 UTP cabling.
- 2.49 Refer to the detail drawings for color of the Category-6 outlets required. Contractor shall be responsible for confirming all color requirements prior to ordering.
- 2.50 Provide the following Category-6 UTP data connector per Network infrastructure warranty requirements:

2.50.1 Panduit MiniCom TX6 Plus Series CJ688TG

- 2.51 Unshielded twisted pair Augmented Category-6 outlets shall be an RJ45 Enhanced performance type 8-position / 8 conductor modular jacks, and shall comply with Augmented Category-6 performance requirements. Provide single port, dual port, four port or quantity as indicated on the floor plans at each outlet location. All outlets shall be wired in an EIA/TIA 568B configuration.
- 2.52 Provide unshielded Augmented Category-6 inserts, wired for EIA 568B. Provide unshielded installation kits for all locations furnished with Augmented Category-6 UTP cabling.
- 2.53 For outlet locations cabled with OSP-rated Augmented Category-6 wire, provide shielded Augmented Category-6 inserts, wired for EIA 568B. Provide shielded installation kits for all locations furnished with OSP-rated Augmented Category-6 UTP cabling. Cable connections must be grounded at the patch panel location.
- 2.54 Refer to the detail drawings for color of the Category-6 outlets required. Contractor shall be responsible for confirming all color requirements prior to ordering.
- 2.55 Provide the following unshielded Augmented Category-6 UTP data connector per Network infrastructure warranty requirements:
 - 2.55.1 Panduit MiniCom TX6 Plus Series CJ688TG(or approved equal by Panduit/Gen Cable).
- 2.56 Provide the following shielded Augmented Category-6 UTP data connector for OSPrated cable ports per Network Infrastructure warranty requirements.
 - 2.56.1 Panduit MiniCom TX6A 10Gig Shielded Series CJ6X88TG

Outlet Faceplates

- 2.57 Provide a two-port faceplate for all one and two port outlet locations. Provide blanks for all unused openings. All Faceplates must be white in color to adhere to SBCUSD standards.
- 2.58 Provide a four-port faceplate for all three and four port outlet locations. Provide blanks for all unused openings.
- 2.59 Provide a six-port faceplate for all five and six port outlet locations. Provide blanks for all unused openings.
- 2.60 All fax/modem locations shall be provided as single port outlets. Requirements shall be the same as a single port data outlet as shown on the Technology Legend.
- 2.61 For single port voice outlet locations intended for wall telephone connections, a wall telephone type faceplate with attachment studs shall be provided. The wall telephone jack shall be 8-pin, RJ45 type and use IDC wire terminations only. Provide Category-6A insert, within stainless steel wall plate faceplate. Provide faceplate from the approved manufacturers listed in the specifications.
- 2.62 Provide single port or dual port Surface mount small surface mounted outlet box for IP Speaker data outlets. Provide surface mount box by Leviton QuickPort Series 41089-xxx or equal by one of the approved manufacturers. Provide Category-6A series insert, in surface box for IP Speaker data locations mounted in the backcan for the speaker as shown in the detail drawings.
- 2.63 Provide single port or dual port Surface mount small surface mounted outlet box for IP Camera data outlets in the J-Box for the camera location. Provide surface mount box by Leviton QuickPort Series 41089-xxx or equal by one of the approved manufacturers. The location shall also be furnished with a blank weather-tight faceplate to protect the data termination until the cameras are installed.
- 2.64 All faceplates and surface mount outlet boxes shall be furnished with label windows. All labeling shall be installed within the label window.
- 2.65 Confirm color of all faceplates prior to ordering. All data outlet faceplates shall have a unique sequential identification number applied to faceplate. Hand written labels are not permitted. All color schemes shall be approved by the customer prior to installation.
- 2.66 Colored inserts are required for this project. Refer to the detail drawings for the exact color scheme to be provided. Inserts submitted that do not follow the color and identification requirements will be rejected. Inserts installed that do not follow the color coding as shown in the detail drawings will be replaced at the Contractor's expense.

- 2.67 All labels will be installed under label window. Labels adhered to the surface of the faceplate will not be accepted. Contractor must provide clear laminating type of cover material over the surface mounted labels where used.
- 2.68 Reference the drawings for special outlet configurations or plate requirements.

PART 3 – IP NETWORK COMPATIBLE INTERCOM (IX SYSTEM) GENERAL

- 3.1 SECTION INCLUDES
 - 3.1.1 IP Video Intercom. (Aiphone IX Series s system)

3.2 REFERENCES

- 3.2.1 Standards Institute (ANSI/TIA/EIA) 568 Commercial Building Telecommunications Cabling Standard.
- 3.2.2 International Organization for Standards (ISO) 9001:2000 Quality Management Systems Requirements.
- 3.3 SYSTEM DESCRIPTION
 - 3.3.1 IP Network Compatible Video Intercom System: A network-based communication and security system featuring video entry security, internal communication, emergency stations, and paging. All units and app in the systems shall be able to view and assist onsite visitors from an offsite location, broadcast emergency announcements, and communicate using a PoE network.
 - 3.3.1.1 Power Source: Power over Ethernet (802.3af).
 - 3.3.1.2 Network Interface: 10 BASE-T / 100 BASE-TX Ethernet CAT 6a (RJ-45).
 - 3.3.1.3 Network Protocols: IPv4, IPv6, TCP, UDP, SIP, HTTP, HTTPS, MJPEG, RTSP, RTP, RTCP, IGMP, MLD, SMTP, DHCP, NTP, DNS.
 - 3.3.2 Bandwidth Usage:
 - 3.3.2.1 G.711: 64Kbps x 2 per video call.
 - 3.3.2.2 64Kbps per monitor.
 - 3.3.2.3 H.264: 24Kbps ~ 2,048Kbps.
 - 3.3.3 Communication: Hands-free (VOX), push-to-talk (simplex), or handset (full-duplex).
 - 3.3.4 Video Display: 7 inches color LCD.

- 3.3.5 Camera: Type:
 - 3.3.5.1 1/4 inch (6 mm) color CMOS.
 - 3.3.5.2 View Area: 2 feet 2 inches (660 mm) vertical x 3 feet 1 inch (940 mm) horizontal at 20 inches (508 mm).
 - 3.3.5.3 Resolution: VGA or higher
- 3.3.6 Video Stream: ONVIF Profile S.
- 3.3.7 Power Source for electric strike: Atop AD1048-24FS 48W/24DIN-Rail 24V DC.
- 3.3.8 Wire Type: CAT-6a. (District standard: Panduit)
- 3.3.9 Distance:
 - 3.3.9.1 Base Bid to include up to 100 l. f. of cabling
 - 3.3.9.2 Maximum allowable to any station to Network Node: not to exceed 330 feet (100 meters).
- 3.4 SUBMITTALS
 - 3.4.1 Submit under provisions of Section 01 30 00 Administrative Requirements.
 - 3.4.2 Product Data: Manufacturer's data sheets on each product to be used, including:
 - 3.4.2.1 Preparation instructions and recommendations.
 - 3.4.2.2 Storage and handling requirements and recommendations.
 - 3.4.2.3 Installation methods.
- 3.5 Shop Drawings: Submit the following:
 - 3.5.1 Wiring Diagrams: Indicate wiring for each item of equipment and interconnections between items of equipment.
 - 3.5.2 Include manufacturer's names, model numbers, ratings, power requirements, equipment layout, device arrangement, complete wiring point-to-point diagrams, and conduit layouts.
 - 3.5.3 Installation and Operation Manuals:
 - 3.5.3.1 Submit manufacturer's installation and operation manual, including operation instructions and component wiring diagrams.

San Bernardino City Unified School District Pacific HS - New Administration Building RCA Project No. 1-78-28 [©]JCE #20048

- 3.5.3.2 Provide detailed information required for Owner to properly operate equipment.
- 3.6 Warranty: Submit manufacturer's standard warranty.
- 3.7 QUALITY ASSURANCE
 - 3.7.1 Manufacturer Qualifications: ISO 9001:2008 certified company.
 - 3.7.2 Installer Qualifications: Factory trained and experienced with system installations of scope and size required for the Project.
 - 3.7.3 Delivery: Deliver materials to site in manufacturer's original, unopened containers and packaging, with labels clearly identifying product name and manufacturer.
 - 3.7.4 Storage: Store materials in clean, dry area indoors in accordance with manufacturer's instructions.
 - 3.7.5 Handling: Protect materials during handling and installation to prevent damage.

3.8 PROJECT CONDITIONS

3.8.1 Maintain environmental conditions (temperature, humidity, and ventilation) within limits recommended by manufacturer for optimum results. Do not install products under environmental conditions outside manufacturer's absolute limits.

3.9 MANUFACTURERS

- 3.9.1 IP Video Intercom System: IX Series Intercom System as manufactured by Aiphone Corporation. Web site: www.aiphone.com
- 3.9.2 Requests for substitutions will be considered in accordance with provisions of Document 00 43 25 Substitution Request Form During Procurement.

3.10 SYSTEM DESIGN

- 3.11 Master Station(s): Provide one master station at each campus.
- 3.12 Aiphone Model IX-MV7-HW Provide one per campus at designated location.
- 3.13 Audio Video Door Stations:
- 3.14 Model IX-DA Surface Mount: Provide one per campus at designated location.
 - or

- 3.15 Model IX-DF - Flush Mount: Provide one per campus at designated location.
- 3.16 Option: Model IX-DV - Surface Mount.
- 3.17 Signage:
 - 3.17.1 At each Door Station/Wall Box Contractor shall provide weatherproof signage Signage: "ASSISTANCE" (English) and "ASISTENCIA" (Spanish).
- 3.18 Functional Components: As indicated on the drawings or as required to complete system.
 - 3.18.1 Video Master Station Model IX-MV7-HW:
 - 3.18.1.1 An IP addressable video master station with a 7 inch color LCD monitor. It can be wall or desk mounted (desk stand included. This station requires a 802.3af compliant Power-over-Ethernet network.
 - 3.18.2 Audio/Video Door Station: Model IX-DA, IX-DF, or IX-DV

3.18.2.1 Station connects to a PoE network using CAT-6a cable.

- 3.19 Optional Components (Unit price items to be used at District option):
 - 3.19.1.1 RY-IP44 IP Programmable Relay Adaptor:
 - 3.19.1.2 45 Degree Mullion Mounting Bracket Model KMB-45:
 - 3.19.1.3 Stainless Steel Security Lock Box Model LB-SDVF: for IX-DF, IX-DF-HID, & IX-DF-RP10.
 - 3.19.1.4 Stainless Steel Enclosure Model SBX-ISDVF:
 - 3.19.1.5 18-Guage stainless steel enclosure designed for surface mounting the IX-DF door stations.

27 10 00 - 25

- 3.20 **EXECUTION**
 - 3.20.1 Examine areas to receive integrated security and communication system.
 - 3.20.2 Notify District of conditions that would adversely affect installation or subsequent use.
 - 3.20.3 Do not begin installation until unacceptable conditions are corrected.
- 3.21 PREPARATION

3.21.1 Verify the following compliance before starting installation.

- 3.21.2 The unit turns inoperative during power failure.
- 3.21.3 Keep the intercom wires at least 1 foot (30 cm) away from strong electrical wiring (AC 100-240 V) including, in particular, wiring for inverter electrical appliances. Noise and malfunction could result.
- 3.21.4 If a strong light shines on the main unit screen, the picture may turn white or only silhouettes will be visible.
- 3.21.5 Other manufacturer's devices (such as sensor, detectors) used with this system, comply with the manufacturer's installation requirements.
- 3.21.6 The LCD panel is manufactured with very high precision techniques, inevitably will have a very small portion of its picture elements always lit or not lit at all. This is not considered a unit malfunction. Please be aware of this in advance.

3.22 INSTALLATION

- 3.22.1 Install integrated security and communication system in accordance with manufacturer's instructions at locations indicated on the Drawings.
- 3.22.2 Mount equipment plumb, level, square, and secure. For video entrance stations and video door stations, comply with manufacturer's design requirements to provide optimum picture quality of station monitoring.

3.23 SET-UP AND ADJUSTING

3.23.1 Adjust integrated security and communication system for proper operation in accordance with manufacturer's instructions.

3.24 DEMONSTRATION AND TRAINING

- 3.24.1 Demonstration:
 - 3.24.1.1 Demonstrate that integrated security and communication system functions properly.
 - 3.24.1.2 Perform demonstration at final system inspection by qualified representative of manufacturer.
- 3.24.2 Instruction and Training:
 - 3.24.2.1 Provide instruction and training of Owner's personnel as required for operation of integrated security and communication system.

- 3.24.2.2 Provide hands-on demonstration of operation of system components and complete system, including user-level program changes and functions.
- 3.24.2.3 Provide instruction and training by qualified representative of manufacturer.
- 3.24.2.4 Provide DVD copy of video recorded training session(s)
- 3.25 PROTECTION
 - 3.25.1 Protect installed integrated security and communication system from damage during construction.

PART 4 – Video Security Systems

- 4.1 (2) Augmented Category-6 UTP cables shall be provided from the IDF closet to each camera location. All cables installed in underground conduit shall be rated for Wet Location.
- 4.2 Provide (Ornage) (Green) Category-6 patch cords with pre-molded boot, provide quantity equal to 100% of the total camera cable drops or ports provided. All patch cords to be installed by Contractor. Provide a total of 100% of the patch cords 36 inches in length. Patch cords shall be in compliance with the manufacturer's "Link" warranty requirements. Provide patch cords for both ends of the cable.

PART 5 – WIRELESS ACCESS POINTS (WAP)

- 5.1 The Contractor will provide all Cisco manufactured wireless access points that will be purchased from the network Electronics allowance; programming will be completed by the District IT Department. The Contractor shall install each Wireless access point where indicated on the floorplans and provide patch cord installation at the WAP. The Contractor shall provide a list including the room number, location, and MAC address of each device installed to the District IT Department.
- 5.2 (2) Augmented Category-6 UTP cables shall be provided from the IDF closet to each WAP location. All cables installed in underground conduit shall be rated for Wet Location.
- 5.3 Interior wall mounted Access Points shall be installed on hard surface walls. In these instances a wall mount Access Point bracket, such as manufactured by Precision Enclosure Solutions (PES) (or approved equivalent) or wall mount enclosure, such as manufactured by TerraWave (or approved equivalent) shall be utilized.
- 5.4 Refer to drawing details for installation requirements for WAP locations.

5.5 Contractor shall provide all WAPS and antennas for all Exterior WAP locations shown on the drawings. Antennas and mounting brackets such as manufactured by TerraWave (or approved equivalent) by Cisco

PART 6 – INSTALLATION

- 6.1 Upon completion of 10% of the cabling installation, the Contractor shall notify the Project Engineer for an inspection of the methods and types of materials used on the project. The Contractor shall give a minimum of 72 hours notification to the Project Engineer for the scheduling of the inspection. The Contractor will be given a written review of the findings, so if adjustments are required, they can be done before the project proceeds. The Contractor shall be responsible for adhering to the findings and a follow-up inspection will not be provided.
- 6.2 Pull strings shall be provided with all cable runs including but not limited to: conduit stub ups, conduit sleeves, cable trays, open wiring routes, innerduct and point-to-point conduits. Pull strings shall be free from cable bundles in open wiring routes. Pull strings shall not be substituted for pull ropes for the exterior site conduits.
- 6.3 Velcro cable management straps are required on all Category-6 cable bundles, the last 20 feet or upon entry into equipment closet, a maximum of 12" apart. Cable bundles shall also be routed through cable managements or "D" rings in the equipment closet.
- 6.4 Data Contractor shall supply protective bushings or slide on rings at the ends of all exposed conduits used for data system cabling. This is to include all conduits installed for any future data cabling requirements. Contractor shall submit planned protection bushings prior to installation of cabling for approval.
- 6.5 Velcro cable management straps are required on the cabling in the rear section of the vertical managers in the equipment racks. Straps shall be a maximum of 12" apart. At a minimum, Velcro straps shall be provided at each point the cables are routed to the patch panels from the main bundle.
- 6.6 Every fiber in every fiber optic cable must be terminated at both ends of a fiber patch panel in the MDF/IDF closet or cabinet location. Termination shall be accomplished using the correct style of connectors as directed by the District with a strain relief boot. All connectors shall be of the same manufacture to ensure compatibility. Polarity of fiber strands must be observed at all times.
- 6.7 Labeling
 - 6.7.1 Each cable run shall be permanently labeled at each end with a unique sequential number which corresponds to a similar number provided for each data outlet and patch panel point. A printed label shall be placed at each of the following locations:

- 6.7.1.1 On the cable at the rear of the patch panel or termination block. Requires the use of a self-laminating wrap around label. Brady Label self-laminating 1.2" by 1.5" wrap around label Part #29689 (NO ACCEPTALE EQUAL).
- 6.7.1.2 On each cable in the j-box behind the faceplate location. Requires the use of a self-laminating wrap around label. Brady Label self-laminating 1.2" by 1.5" wrap around label Part #29689 (NO ACCEPTALE EQUAL).
- 6.7.1.3 On the cable at the terminal strip prior to termination point. Requires the use of a self-laminating wrap around label. Brady Label self-laminating 1.2" by 1.5" wrap around label Part #29689 (NO ACCEPTALE EQUAL).
- 6.7.1.4 On the face of the patch panel, provide a ¾" by ¾" label with a letter or number identifying the patch panel designation. For special purpose data connections such as WAP, Audio-Visual, IP Page and IP Camera ports, the label shall be designated with colored label icon or marker.
- 6.7.1.5 On the face of the faceplate in the label holder window. The label shall be clearly defined with a minimum #10 font size.
- 6.7.2 Handwritten labels are not permitted. Where cable ID includes room number identification, the Contractor shall obtain written verification of final room numbers prior to beginning labeling (numbers on plans do not always match final room numbers). Cable pulling cross reference lists will not be accepted with final documentation.
- 6.7.3 Each patch panel port shall be identified with a unique sequential labeling scheme. Port identification labeling pattern shall be consistent throughout the project.
- 6.7.4 All faceplates shall be identified with permanent printed labels. Labels must not be subject to removal by incidental contact. Contractor shall be responsible for replacing defective labeling for a period of one year from date of final sign-off of project.
- 6.7.5 All fiber optic and UTP feed cables shall be identified with permanent, water resistant, printed labels. Labeling information shall include closet identifications, quantity of conductors (UTP) or strands (fiber) and house pair designations (UTP). Cables shall be labeled in the IDF/MDF closets at the site conduit entrance point, riser conduit entrance point and prior to entering either punch blocks or patch panels. Labels for fiber and copper feeds shall include both the name of the origination point and the destination point, house pair or house fiber strand count, cable composition (i.e., 12-Strand MM 50/125 LO; 6-Stand SM). See details for additional requirements.

- 6.7.6 Labeling will follow recommended EIA/TIA standards or as requested by the customer. Contractor will confirm labeling pattern prior to final identification or testing. All test results will be identified by the final labeling scheme. Contractor shall be required to have the labeling scheme approved in writing by the District IT Director prior to manufacture or installation of the labeling.
- 6.7.7 All fiber optic cables and/or innerduct shall be tagged with fiber optic warning tags in every manhole or pullbox. Fiber warning tags shall also be placed at each end of the cable in the termination closets in clear view. A minimum of (3) tags are required at each end, with a label tag on each cable in the service loop. Fiber warning tags shall be placed on fiber optic cable and/or innerduct routed through open ceiling environments at increments no less than 15 feet apart.
- 6.7.8 Refer to detail drawings for additional labeling requirements.
- 6.8 Where open wiring cables are run through the ceiling space (only permitted where specifically noted on the drawings), the wire shall be bundled together and supported above the ceiling.
- 6.9 All cables must be fastened to the building structure via "j-hooks" or an approved Category 6 suspension system, and not directly in contact with ceiling system. For "j-hooks" maximum fill capacity is as follows: 1-5/16" hooks 35 cables; 2" hooks 60 cables; 4" hooks 120 cables. For quantities beyond 120 cables, use a sling support system such as "Erico Cable Cat" or equal. Maximum fill capacity 200 cables. D-rings, "Caddy #WMX cable hangar", "Caddy Bridle Rings", drive rings or any other type of wire ring support is not allowed.
- 6.10 Where cables pass through a fire-resistant portion of the structure, conduit sleeves shall be provided to maintain the rating of wall penetrated. Sealing of all penetrations with an approved fire barrier is required. Conduits and sleeves must remain accessible for future use. Permanent sealants may not be used to seal sleeves and conduits.
 - 6.10.1 The 27 10 00 Contractor shall be responsible for fire-stopping all unused conduit sleeves in the ceiling or through rated walls. The Electrical Contractor shall be responsible for fire-stopping around the conduit or sleeve, unless the sleeve is installed by the 27 10 00 Contractor, in which case, the 27 10 00 Contractor shall be responsible for all fire-stopping requirements.
 - 6.10.2 Expanding foam is not an acceptable sealant for any conduit opening. Contractor shall be responsible for complete replacement of the conduit and cabling in any conduit filled with expanding foam used as a sealant.
- 6.11 Fiber optic feed cables connecting to equipment racks from the MDF Room or from an adjacent IDF location, shall be installed with not less than a 20-foot service loop between the rack and mounted on the backboard. See drawings for fiber optic service loop requirements.

- 6.12 Provide 6 inches of cable slack at computer data system outlets inside conduit box.
- 6.13 In an accessible ceiling area, provide a 10-foot (stored in a Figure-8 configuration) service loop above the all data/voice outlet locations. Service loop must be securely tied up off of ceiling tiles or ceiling surface and supported at two opposite points. Neatly coil cable without exceeding minimum bend radius limitations. Do not provide length in excess of 15 feet, as it may cause improper test results and errors.
- 6.14 Do not provide a service loop in the MDF/IDF Room on the UTP cables, unless otherwise noted. Cables shall be neatly routed around the perimeter of the room to the cable runway from the point of entrance into the room.
- 6.15 The minimum bending radius for all cables and the maximum pulling tension shall not exceed manufacturer's recommendations.
- 6.16 Cables installed in manholes and pullboxes shall be supported with Velcro ties or loosely fitted UV rated tie wraps, on wall mounted cable support racks. The cables shall be clearly labeled in the manhole or pullbox.
- 6.17 Provide a full 360-degree loop of slack cable around manhole and pullbox interiors. Cables entering handholes from the bottom, shall not be allowed to touch the bottom of the cover when closed and shall not be pinched or crushed in any way.
- 6.18 Cable pulling shall use a split mesh grip over the cable jacket. Connection directly to optical fibers and copper wire conductors shall not occur.
- 6.19 When pulled through conduits, cable pulling lubricants shall be continuously applied to all cables and be specifically approved by the manufacturer.
- 6.20 Where cables are pulled through or pulled from a center run, pull without splices or terminations, lead out the cables at all manholes, pullboxes, and conduits, taking care to feed them in again by hand for the next run.
- 6.21 For each cable pull where a cable direction change is required, flexible feed-in tubes, pullout devices, multi-segmented sheaves, etc., shall be used to ensure proper cable pulling tension and side wall pressures. Cables shall not be pulled directly around a short right-angle bend. Any device or surface the cable comes in contact with when under pull-in tension shall have a minimum radius 50% greater than the final specified minimum installed cable bending radius. The maximum possible size radius sheaves and feed-in tubes, usable in the available working space shall be provided in all situations, to ensure the minimum possible cable sidewall pulling pressure. Do not use devices with multi-segment "roller" type sheaves.
- 6.22 Cable lengths over 250 feet shall be machine pulled, not hand pulled. Cables shall be pulled in a continuous, smooth operation without jerking or stop-start motion after initiation of pull. Maximum cable pulling speed shall be less than 50 feet per minute. Minimum pulling speed shall be greater than 15 feet per minute.

- 6.23 A pull string shall be placed with all UTP and paging station cables at the time of installation. Conduit runs and surface raceway for station cabling shall be furnished with a minimum 2-Ply spiral wrap style, pull string rated for 240 ft/lbs. pulling strength, such as manufactured by Greelee #431 or approved equal. Includes all conduit stubs and cables routed through open ceiling and cable trays. Pull strings shall be tied off in the junction box and in the ceiling. Provision for the installation of the pulls string shall apply to all empty and spare conduits as well. Single ply type pull string will not be accepted as a substitute for the 2-ply pull string.
- 6.24 A measuring pull tape shall be placed with all feed cables at the time of installation. Indoor riser and outdoor conduit runs between buildings designated for feed cabling, in excess of 150 feet shall be provided with a minimum ½" polyaramid style, measuring true tape pull string annotated with footage increments rated for 2500 ft/lbs. pulling strength, such as manufactured by Greenlee #39245 or approved equal. Conduit runs less than 150 feet shall be furnished with a ¼" polyaramid style, measuring true tape pull string annotated with footage increments rated for 1250 ft/lbs. pulling strength, such as manufactured by Greenlee #39243 or approved equal. Provision for the installation of the measuring pull tape shall apply to all empty and spare conduits as well. Standard twine style pull strings and standard nylon or polypropylene style pull ropes will not be accepted as a substitute for the polyaramid measuring tape pull string.
- 6.25 When pulling cable through conduit, cables shall be pulled straight into or out of the raceway without bends at the raceway entrance or exit. Pull in cable from the end having the sharpest bend (i.e., bend shall be closest to the reel). Keep pulling tension to minimum by liberal use of lubricant, hand turning of reel, and slack feeding of cable into duct entrance. Employ not less than one man at reel and one at manhole or pullbox during this operation. Cables shall be pulled directly from cable reels.
- 6.26 All cables shall be new and extend continuous from each MDF or IDF backboard or rack to all outlet locations.
- 6.27 Where cables are not installed in a conduit or other raceway system, they shall not be routed parallel with other line voltage equipment or wiring (120 volt and above) with 36" or within 12" of line voltage equipment or wiring where crossing.
- 6.28 Where OSP-Rated UTP cables or OSP-Rated fiber optic cables are routed exposed through ceiling for more than 50'-0", Contractor shall install the cable in innerduct or EMT conduit in the ceiling. Innerduct installed in the accessible ceiling space shall be a minimum of riser rated and minimum of 1" in diameter. Innerduct shall be supported minimum of every 3-feet to the structural members.

PART 7 - TESTING

7.1 All Category-6 cables shall be point to point (link) tested after installation/termination and verified to operate at minimum 1000Mbps. Performance of installed cables shall satisfy all current addendums to the EIA/TIA 568A standard for Category-6 wiring. In addition, testing shall satisfy all proposed amendments to the existing ISO/IEC requirements. The wiring shall support all specified communication protocols. Testing shall support the Category-6 requirements by the EIA/TIA.

- 7.2 Upon completion of testing cable links for both copper and fiber optic cabling, the Contractor shall supply a copy of the original database files downloaded from the tester in original format on a USB Flash Drive. Contractor shall provide with the testing database files, an original copy of the tester's manufacturer software program (included in original cost) for record management and archiving, in a Windows format (i.e., Fluke Linkware software program).
 - 7.2.1 The manufacturer's software program will be used by the Project Engineer to review all test results, and then turned over to the District to keep as their record copy with the final approved test results. Provide (3) copies of tests on USB Flash Drives. Do not submit test results for review in Excel or PDF file formats, as the submittal will be rejected and not reviewed.
- 7.3 Contractor will repair or replace cable runs or connecting hardware that do not meet specified criteria.
- 7.4 Upon completion of submittal of original test results, and after review and approval of those results, the Contractor shall provide testing equipment and personnel to randomly re-test 10% or 20 drops minimum, whichever is greater, of all UTP cable locations on the campus in the presence of the designated District Representative and Project Engineer. The District Representative shall choose which cables are to be retested. If 10% of the re-tested cables fail to match the previously submitted original tests, the Contractor must hire an independent testing firm to re-test all UTP cable on the campus, at no cost the customer. All cables which do not meet the specifications criteria as determined by the independent test report, shall be replaced and re-tested by the Contractor at no cost the District. Final sign-off of the testing shall be approved after receipt of all other documentation.
- 7.5 Multimode fiber optic cables shall be tested bi-directionally at 850nm and 1300nm. Single mode fiber optic cable shall be tested bi-directionally at 1310nm and 1500nm. All fiber strands shall be tested with an OTDR (Optical Time Domain Reflectometer). All fiber test results shall contain final source and destination information that matches IDF or MDF labeling shown on the fiber optic patch panels and final documentation. OTDR tests results shall be included with the copper test results and submitted with the tester's software for review. Do not submit test results for review in Excel or PDF file formats, as the submittal will be rejected and not reviewed.
- 7.6 Test procedures shall comply with EIA/TIA 526-14 Method B. Test results shall meet the minimum following criteria:

- 7.6.1 Fiber optic test results shall not exceed 2db total attenuation loss in addition to inherent loss published by manufacturer tested at minimum 2000 Mhx for 805nm and 500 Mhz for 1300nm for the fiber optic cable.
- 7.7 End to end attenuation Fiber Optic feed cabling testing shall be performed with a temporary test jumper cable at each end of the installed fiber cable. The test jumper utilized shall be the same fiber core size and grade of glass as the installed cable. The measured attenuation of the test jumpers, test connectors, and test interconnection sleeve between the two test jumpers shall be less than 1dB as calibrated at the time of the test at indicated wave lengths and frequencies. Test jumpers shall be "zeroed out" before testing of fiber stands begins.
- 7.8 Final As-Built Drawing Submittals Provide (1) hard bound copy of "E-size" As-Built drawings and (3) copies on USB Flash Drive in AutoCad (2014 or newer version) format. A Hand marked-up copy of the original construction drawings will not be accepted as the final As-Built drawing submittal. Final As-Builts shall include copies of the floor plan drawings of each building, detailed elevations of each MDF or IDF locating all equipment, quantities outlets and speaker locations, locations of all sleeves and identification of all final cable routes. In addition, the drawings shall include all outlet locations with cable identification numbers.

END OF SECTION

SECTION 27 21 00

NETWORKING ELECTRONICS

PART 1 – GENERAL

- 1.1 Include all labor, equipment and materials necessary for providing a complete data networking system as described therein.
- 1.2 Quality Assurance
 - 1.2.1 Manufacturers' qualifications: All components shall be manufactured by a single manufacturer. Acceptable manufacturers shall be "Cisco."

Systems or components as manufactured by 3 Com, HP, Asante or any other manufacturer's which are not specifically listed in 1.2.1, are <u>not</u> approved for use on this project.

- 1.2.2 Installing contractor qualifications: Firms and their personnel must be regularly engaged in the installation of networking electronics equipment for systems of similar type and scope. The contractor must have a full-service office able to respond to emergency callouts during the warranty period. The contractor must provide documentation from "Cisco" indicating their qualifications for installation of this system in compliance with the manufacturers warranty requirements as a warrantied contractor. The contractor must also provide complete installation of all wiring and devices or equipment. Subcontracts with Division 26 contractors or other warranted contractors for supervised installation of any part of this system are not approved.
- 1.2.3 Equipment qualifications: It is the intent of these specifications that each bidder provide all hardware, components and installation services that are necessary to ensure a fully operational networking system. These are K-12 EDU SKUs specific for school districts, and will include SmartNet Support.
- 1.2.4 Warranty: All components, installation, shall be warranted by the contractor to the school district for a period of <u>2 years</u> after District acceptance and sign-off of the completed system.
- 1.3 In order to ensure project cohesion, a single point of contact is required to provide a "TURNKEY" solution. The work covered under this section of the specification consists of furnishing all labor; equipment; software; supplies; materials; and training. The Contractor will perform all operations necessary for the "TURNKEY" and fully completed installation in accordance with the specifications herein. As such, the successful contractor must be factory trained on all aspects of system hardware.
- 1.4 Submittal shall be made <u>within (10) working days</u> after the award of the contract by the District. This submittal shall include the following:

- 1.4.1 Complete bills of quantities, including all materials, components, devices, and equipment required for this work. The bills of quantities shall be tabulated respective of each and every system as specified, and shall contain the following information for each item listed:
 - 1.4.1.1 Description and quantity of each item.
 - 1.4.1.2 Manufacturer's Name and Model Number.
 - 1.4.1.3 Manufacturer's Specification Sheet.
- 1.4.2 Include with submittals all warranty information and a description of support and maintenance services to be provided. Also include all licenses and maintenance agreements required for continued operation of the equipment.

1.5 <u>Common submittal mistakes which will result in submittals being rejected:</u>

- 1.5.1 Not including the qualifications of the installing contractor.
- 1.5.2 Not including all items listed in the above itemized description.
- 1.5.3 Including catalog cut sheets which have several items on a page, and not clearly identifying by highlighting, underlining or clouding the items to be reviewed, or crossing out the items which are not applicable.
- 1.5.4 Not including actual manufacturer's catalog information of proposed products.
- 1.5.5 Do not include multiple manufacturers for similar products and do not indicate "or approved equal" statements, or "to be determined later" statements. The products being submitted must be the products installed.

PART 2 – PRODUCTS

2.1 All termination Wireless Access Points and Switches with Transceivers.

Intermediate Distribution Frame (IDF)

2.2 The following equipment items shall be provided complete with all management modules, connection hardware, software and all other accessories including mounting hardware to provide a complete and operational system.

APs:

- 2.3 Provide (8) Indoor AP with Mgig for School with the following for each:
 - 2.3.1 AIR-AP3802I-B-K9 802.11ac W2 AP w/CA; 4x4:3; Mod; Int Ant; mGig B Domain
 - 2.3.2 AIR-AP-T-RAIL-R- Ceiling Grid Clip for Aironet APs Recessed Mount (Default)
 - 2.3.3 AIR-AP-BRACKET-1 802.11 AP Low Profile Mounting Bracket (Default)

- 2.3.4 SW3802-CAPWAP-K9- Cisco Aironet 3800 Series CAPWAP Software Image
- 2.3.5 NETWORK-PNP-LIC Network Plug-n-Play License for zero-touch device
- 2.4 Provide (3) Outdoor AP for School with the following for each:
 - 2.4.1 AIR-AP1542D-B-K9- 802.11ac W2 Value Outdoor AP, Direct. Ant, B Reg Dom.
 - 2.4.2 SWAP1540-MESH-K9- Cisco 1540 Series Unified Mesh Mode Software
 - 2.4.3 AIR-ACC1530-PMK1- Standard Pole/Wall Mount Kit for AP1530/1560 Series

Edge Switches:

- 2.5 Provide (1) 24 port Access Switches for School Sites (10G uplink, 10G mGig) with the following for each:
 - 2.5.1 C9300-24UX-EDU- Catalyst 9300 24-port mGig and UPOE, K12
 - 2.5.2 C9300-NW-A-24-EDU- C9300 Network Advantage, 24-port license K12
 - 2.5.3 S9300UK9-168 UNIVERSAL
 - 2.5.4 PWR-C1-1100WAC 1100W AC Config 1 Power Supply
 - 2.5.5 PWR-C1-1100WAC/2 1100W AC Config 1 Secondary Power Supply
 - 2.5.6 C9300-NM-8X Catalyst 9300 8 x 10GE Network Module
 - 2.5.7 CAB-TA-NA North America AC Type A Power Cable
 - 2.5.8 STACK-T1-50CM 50CM Type 1 Stacking Cable
 - 2.5.9 CAB-SPWR-30CM Catalyst Stack Power Cable 30 CM
- 2.6 Provide (3) 48 port Access Switches for School Sites (10G uplink, 10G mGig) with the following for each:
 - 2.6.1 C9300-48UXM-EDU- Catalyst 9300 48-port(12 mGig&36 2.5Gbps), K12
 - 2.6.2 C9300-NW-A-48-EDU- C9300 Network Advantage, 48-port license K12
 - 2.6.3 S9300UK9-168- UNIVERSAL
 - 2.6.4 PWR-C1-1100WAC- 1100W AC Config 1 Power Supply

- 2.6.5 PWR-C1-1100WAC/2- 1100W AC Config 1 Secondary Power Supply
- 2.6.6 C9300-NM-8X- Catalyst 9300 8 x 10GE Network Module
- 2.6.7 CAB-TA-NA- North America AC Type A Power Cable
- 2.6.8 STACK-T1-50CM- 50CM Type 1 Stacking Cable
- 2.6.9 CAB-SPWR-30CM- Catalyst Stack Power Cable 30 CM

PART 3 – INSTALLATION


- 3.1 Each piece of electronic equipment must be securely fastened into the equipment rack, connected to all networking and power sources per manufacturer's recommendations.
- 3.2 The installation shall include all software configuration of all electronic components. The owner's representative shall be present to supervise the software installation and configuration.

PART 4 - TESTING AND TRAINING

- 4.1 All electronic equipment shall be tested to comply with the manufacturer's instructions. Upon completion, the contractor shall provide written verification that all components have been installed and are operating per the manufacturer's instructions.
- 4.2 The contractor shall provide (2) training sessions for two to four employees from School District. Contact the district Information Systems Manager to determine the attendees for this training. The training shall be for all equipment and devices furnished in this section of the specifications. The training shall be provided by the manufacturer of the equipment or authorized dealer, and shall include all instruction, tools, and equipment and devices. Provide name and verification that the individual performing the training.
- 4.3 Manuals: Three copies of an operation manual must be supplied with each piece of equipment.
- 4.4 Three (3) two-hour visits shall be conducted by the contractor, at four (4) month intervals during the warranty period or when requested by the district, in order to verify that each system component and the complete system is functioning correctly. The inspection visits shall be conducted at times which shall be during the normal school day. The contractor shall be required to reprogram any equipment or functions as requested by the district Information Systems Manager.


END OF SECTION

	R	DOM SIGN	NAGE SCI	HEDULE
ROOM NUMBER	DOOR NO.	ROOM NAME	SIGN TYPE	SIGN TEXT **
101	101B	LOBBY	ROOM ID W/ ISA	ADMINISTRATION
101	101D 103A	LOBBY	ROOM ID	FINANCE OFFICE
101	101A	LOBBY	ROOM ID W/ ISA	ADMINISTRATION
103	104A	FINANCE / SHIPPING & RECEIVING	ROOM ID	STORAGE
105	105B	HALLWAY	ROOM ID W/ ISA	ADMINISTRATION
105	105A	HALLWAY	ROOM ID	OFFICES
105	123A	HALLWAY	ROOM ID	SIDE A: COUNSELING SIDE B: ADMINISTRATION
106	106A	CONFERENCE ROOM	ROOM ID	CONFERENCE ROOM
107	107B	PRINCIPAL	ROOM ID	PRINCIPAL
107	107A	PRINCIPAL	ROOM ID	PRINCIPAL
108	108A	ASSISTANT PRINCIPAL	ROOM ID	OFFICE
109	109A	ASSISTANT PRINCIPAL	ROOM ID	OFFICE
110	110A	ASSISTANT PRINCIPAL	ROOM ID ROOM ID	OFFICE
113 115	114A 115A	COPY UNISEX RESTROOM	RESTROOM WALL	STORAGE STAFF RESTROOM
115	115A 116A	HALLWAY	ROOM ID	SIDE A: STAFF RESTROOM SIDE B: ADMINISTRATION
116	116B	HALLWAY	ROOM ID	SIDE A: STAFF RESTROOMS SIDE B: WORKROOM
117	117A	REGISTRAR STORAGE	ROOM ID	STORAGE
118	118A	MEN'S RESTROOM	RESTROOM WALL	MEN'S RESTROOM
119	119A	CUST.	ROOM ID	CUSTODIAN
120	120A	WOMEN'S RESTROOM	RESTROOM WALL	WOMEN'S RESTROOM
121	122A	STAFF WORKROOM	ROOM ID	DATA ROOM
121	121A	STAFF WORKROOM	ROOM ID W/ ISA	WORKROOM
123	123B	HALLWAY	ROOM ID W/ ISA	COUNSELING
125	125A	ASB OFFICE	ROOM ID ROOM ID	ASB OFFICE
126 127	126A 127A	ITINERANT COUNSELING	ROOM ID ROOM ID	OFFICE
127	127A 128A	DEAN OFFICE	ROOM ID ROOM ID	OFFICE
120	120A 129A	COUNSELING	ROOM ID	OFFICE
130	130A	CONFERENCE ROOM	ROOM ID	CONFERENCE ROOM A
131	131A	CONFERENCE ROOM	ROOM ID	CONFERENCE ROOM B
132	132A	COUNSELING	ROOM ID	OFFICE
133	133A	PSYCHOLOGIST	ROOM ID	OFFICE
134	134A	COUNSELING	ROOM ID	OFFICE
135	135A	COUNSELING	ROOM ID	OFFICE
136	136B	HEALTH	ROOM ID	SIDE A: SHOWER ROOM SIDE B: HEALTH AIDE
136	139A	HEALTH	RESTROOM WALL	STUDENT RESTROOM
136	138A	HEALTH	ROOM ID	EXAM ROOM
136	136A	HEALTH	ROOM ID W/ ISA	HEALTH AIDE
136	137A	HEALTH	ROOM ID	
140 140	139B 141A	ATLAS ATLAS	RESTROOM WALL ROOM ID	STUDENT RESTROOM SHOWER ROOM
140	141A 140A	ATLAS	ROOM ID ROOM ID W/ ISA	
140	140A 146A	SECURITY	ROOM ID W/ ISA	- STORAGE
142	140A 142A	SECURITY	ROOM ID W/ ISA	SECURITY OFFICE
142	147A	ELECTRICAL	ROOM ID ROOM ID	ELECTRICAL ROOM

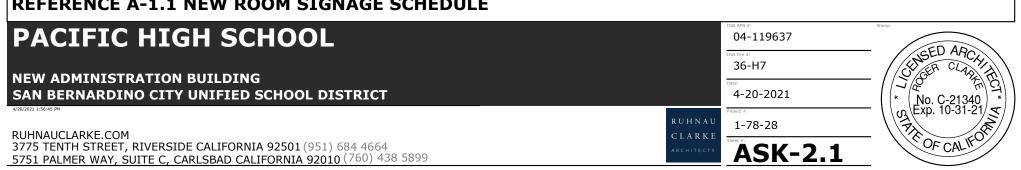


REFERENCE A-1.1 NEW ROOM SIGNAGE SCHEDULE


/2\

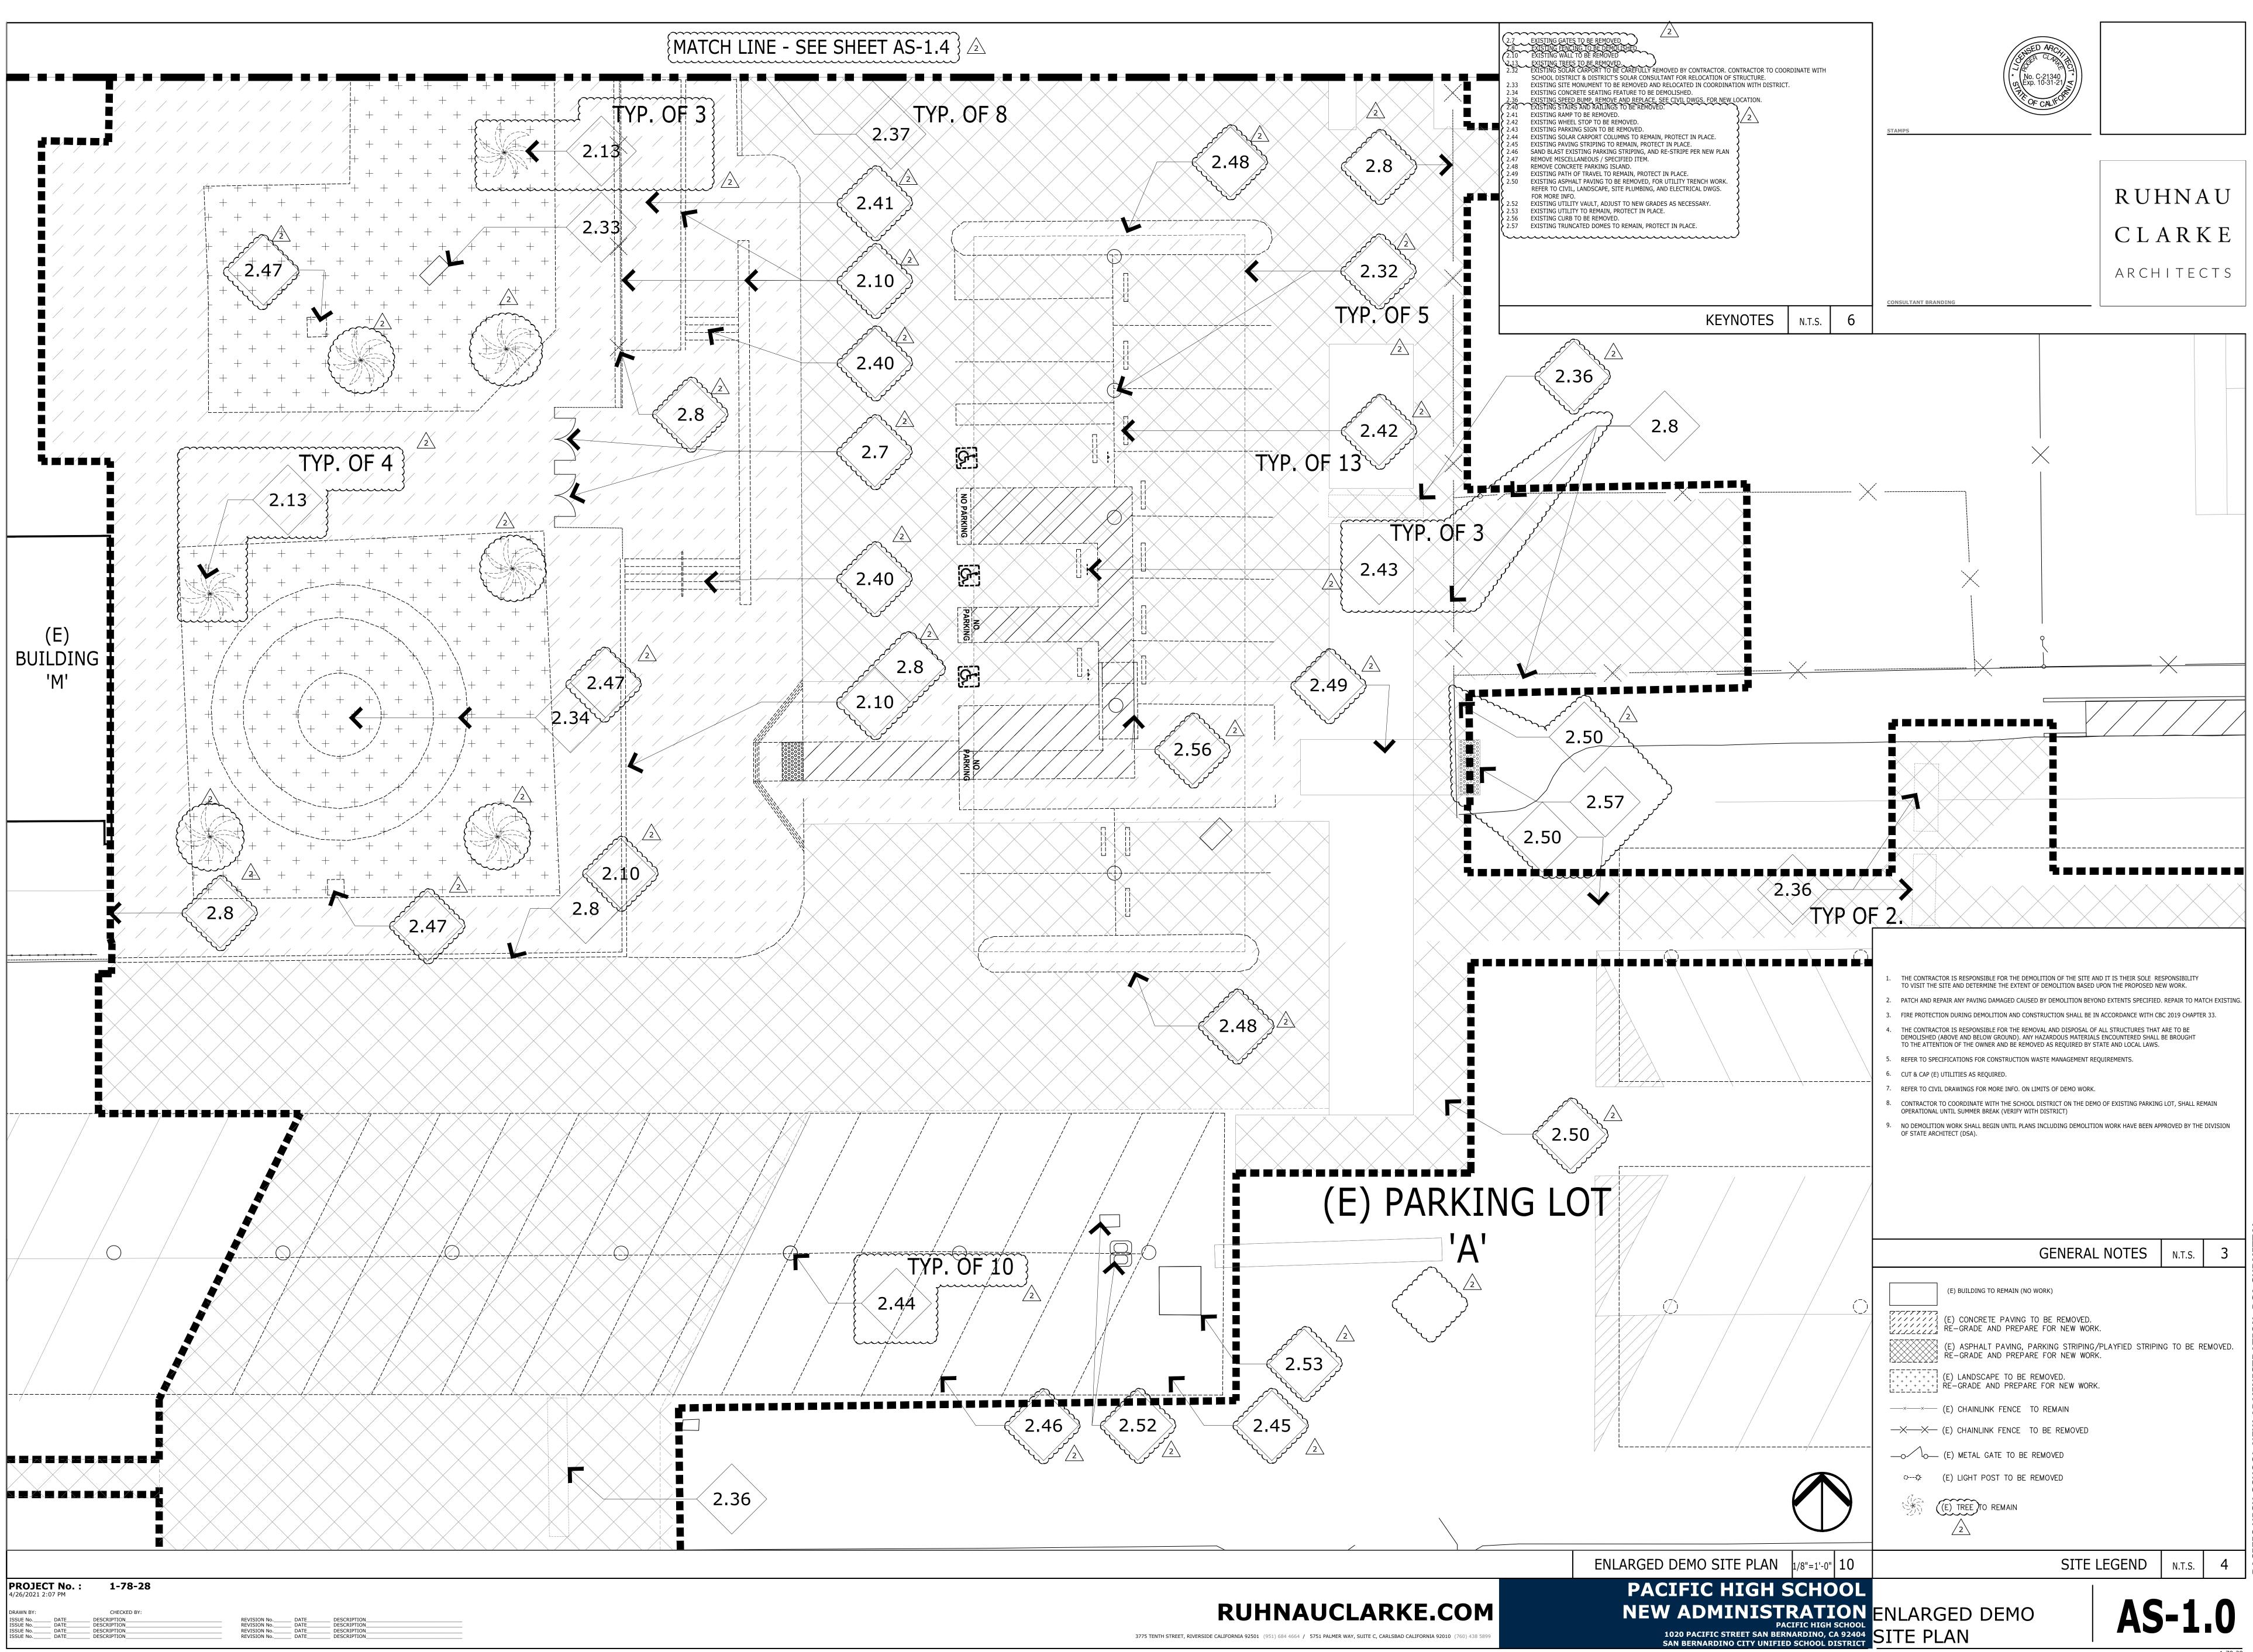





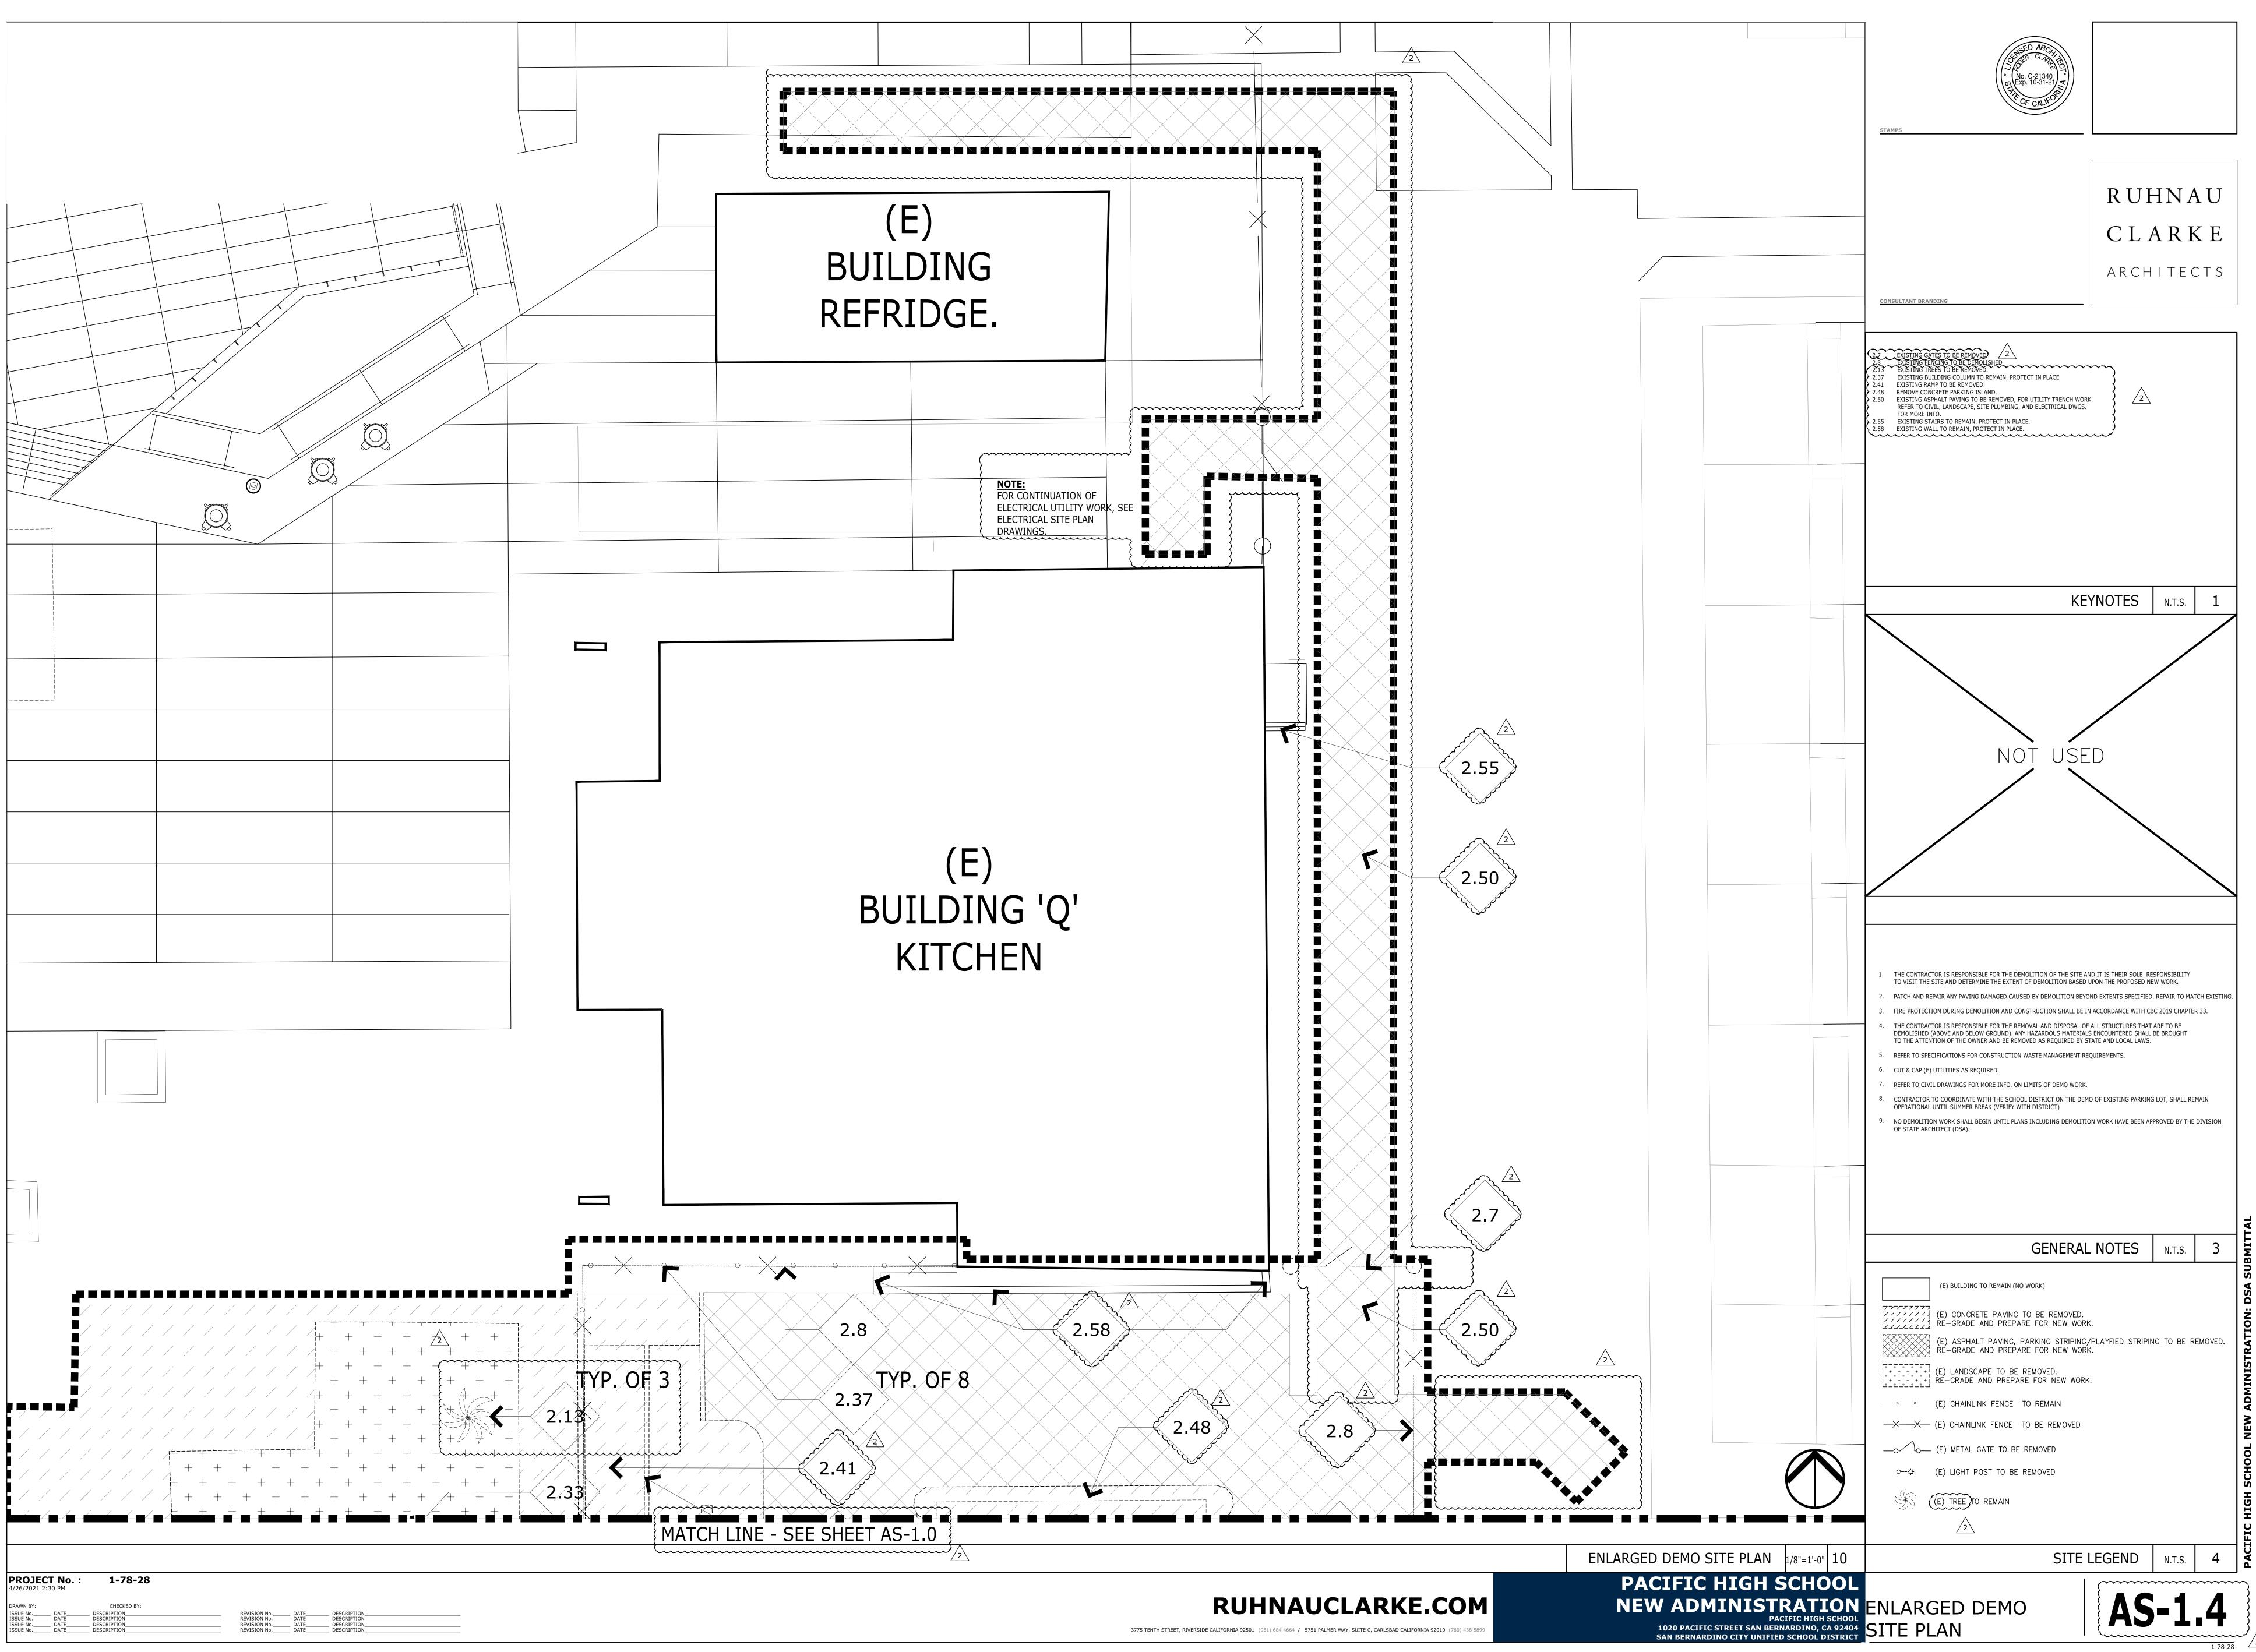



					21 AD-3.1 TYP. OF 2
					[T
PROJECT No.: 4/13/2021 4:03:58 PM DRAWN BY: ISSUE No. DATE ISSUE No. DATE ISSUE No. DATE ISSUE No. DATE ISSUE No. DATE	CHECKED BY: JC DESCRIPTION DESCRIPTION DESCRIPTION DESCRIPTION	REVISION No REVISION No REVISION No REVISION No.	DATE 4-07-2021 DESCRIPTION Revision DATE 4-16-2021 DESCRIPTION Revision DATE DESCRIPTION DATE DESCRIPTION	n 1	

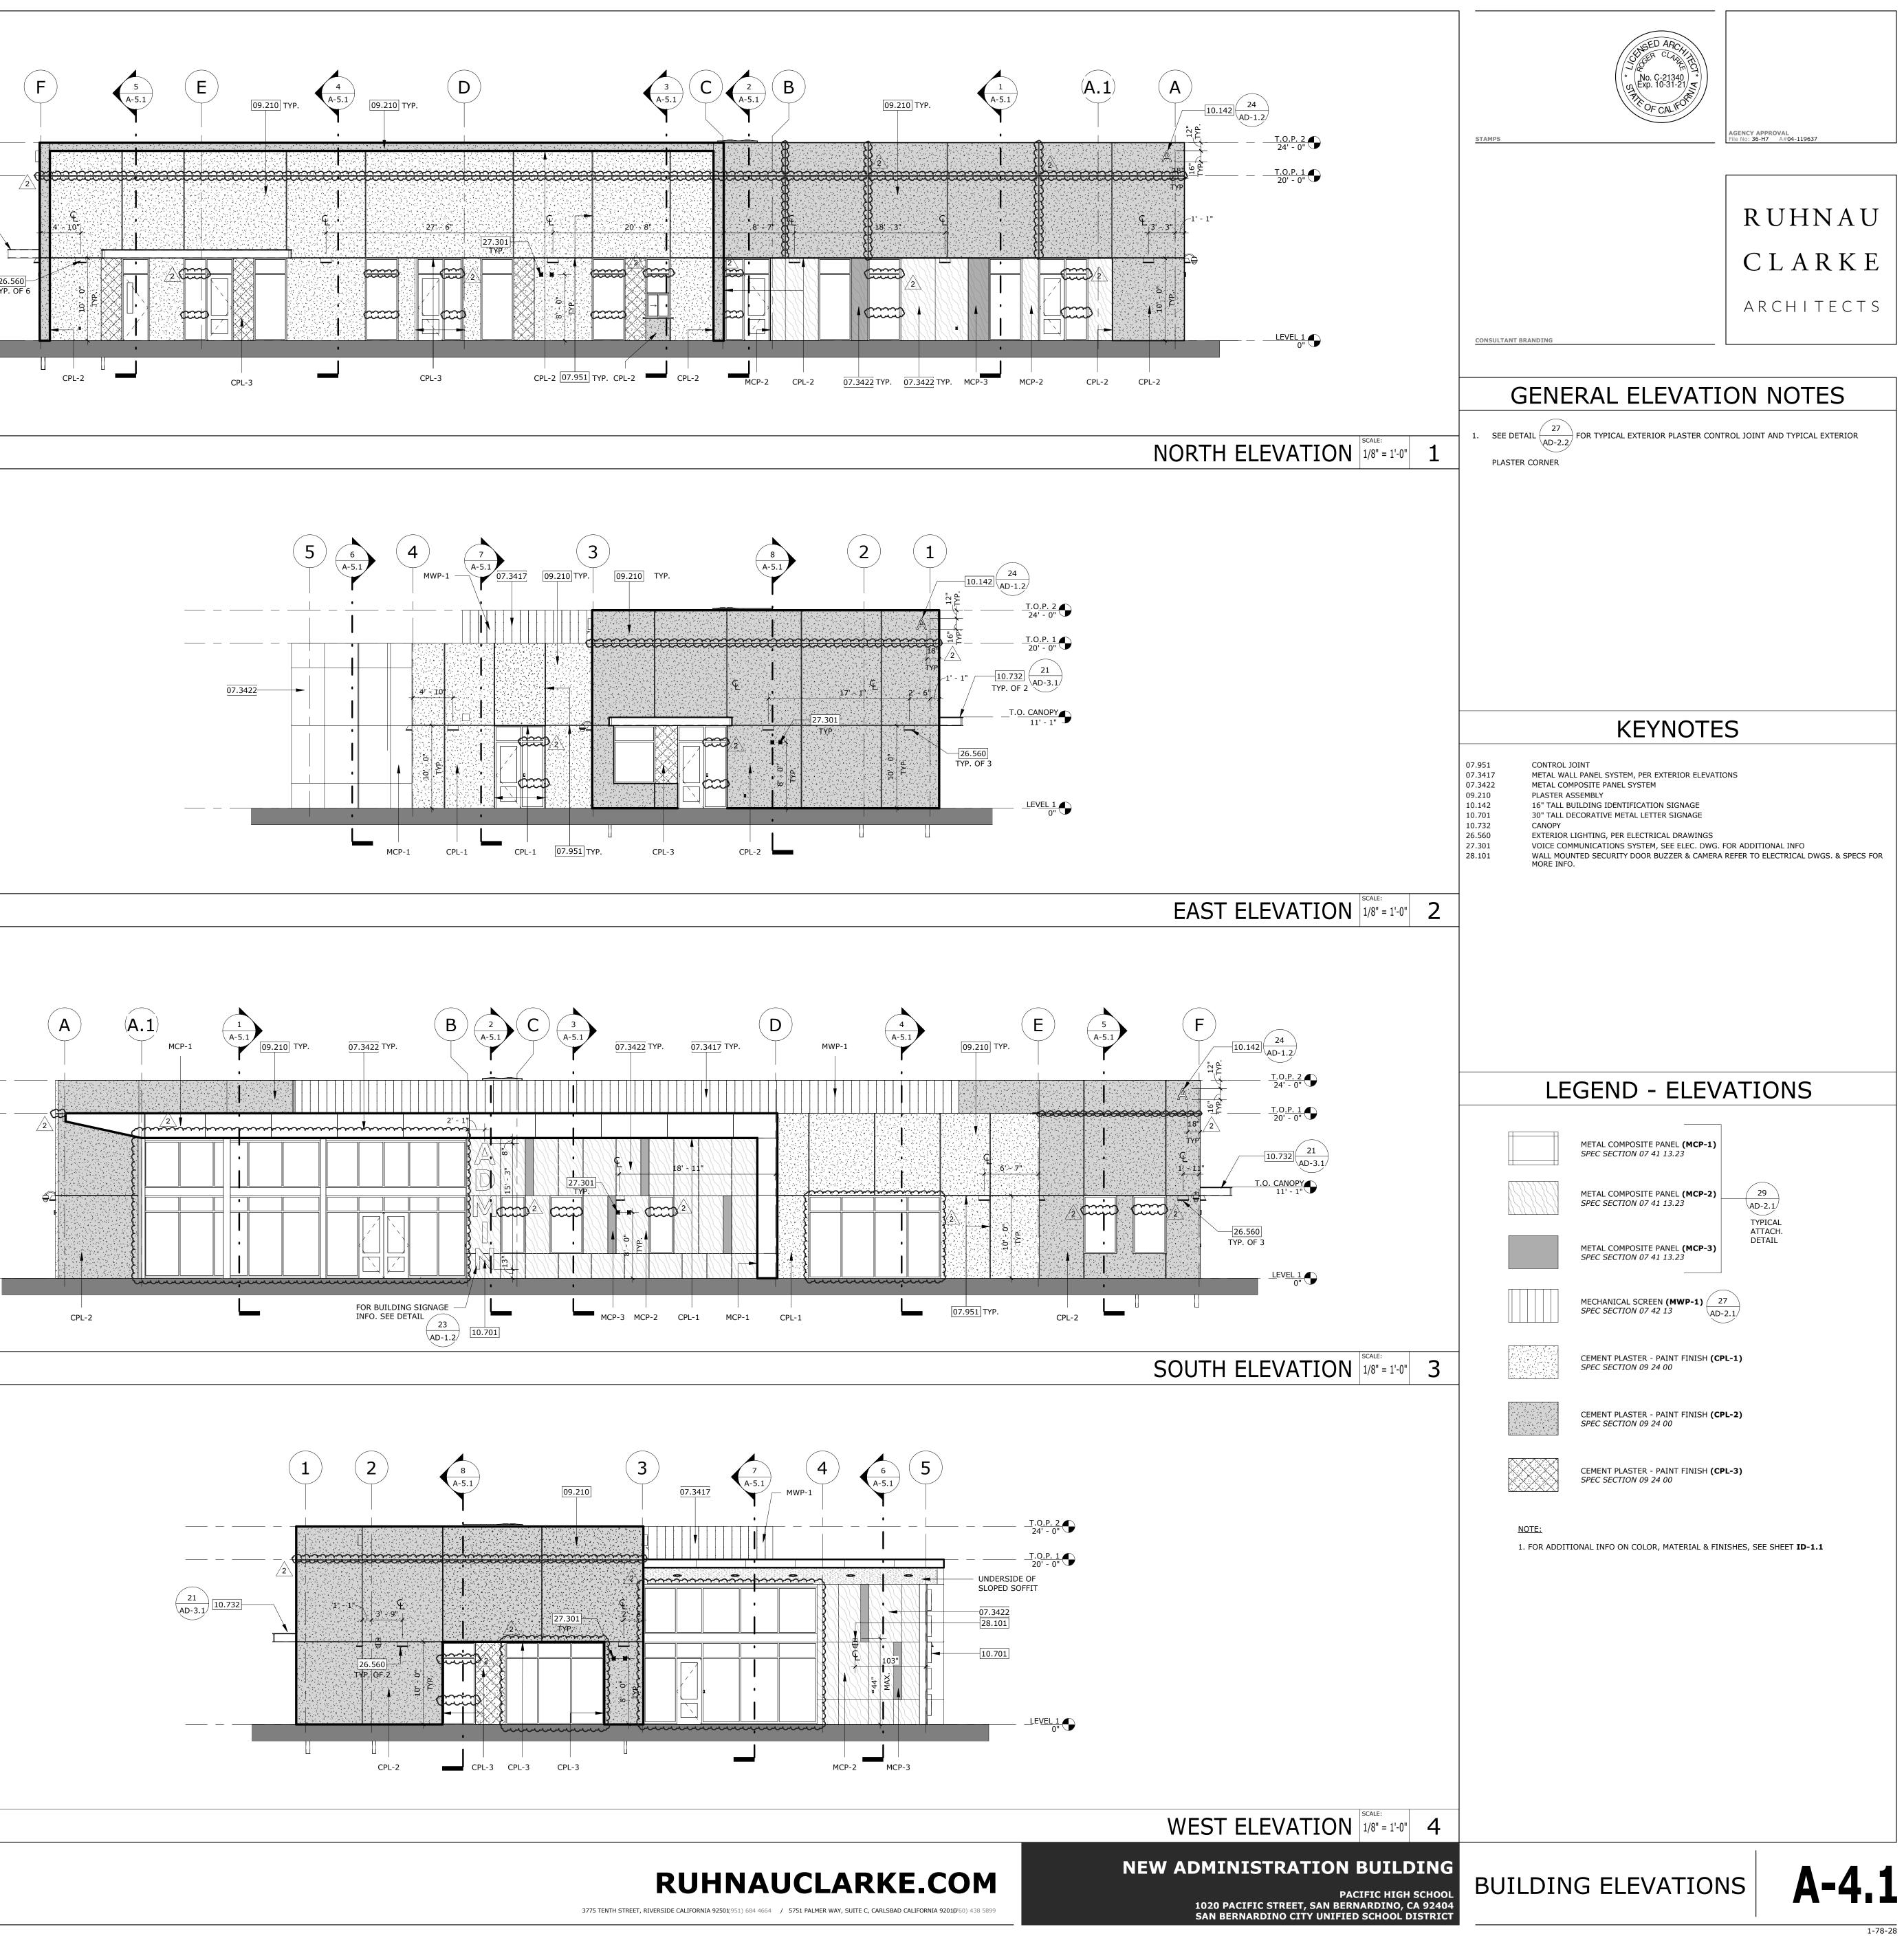

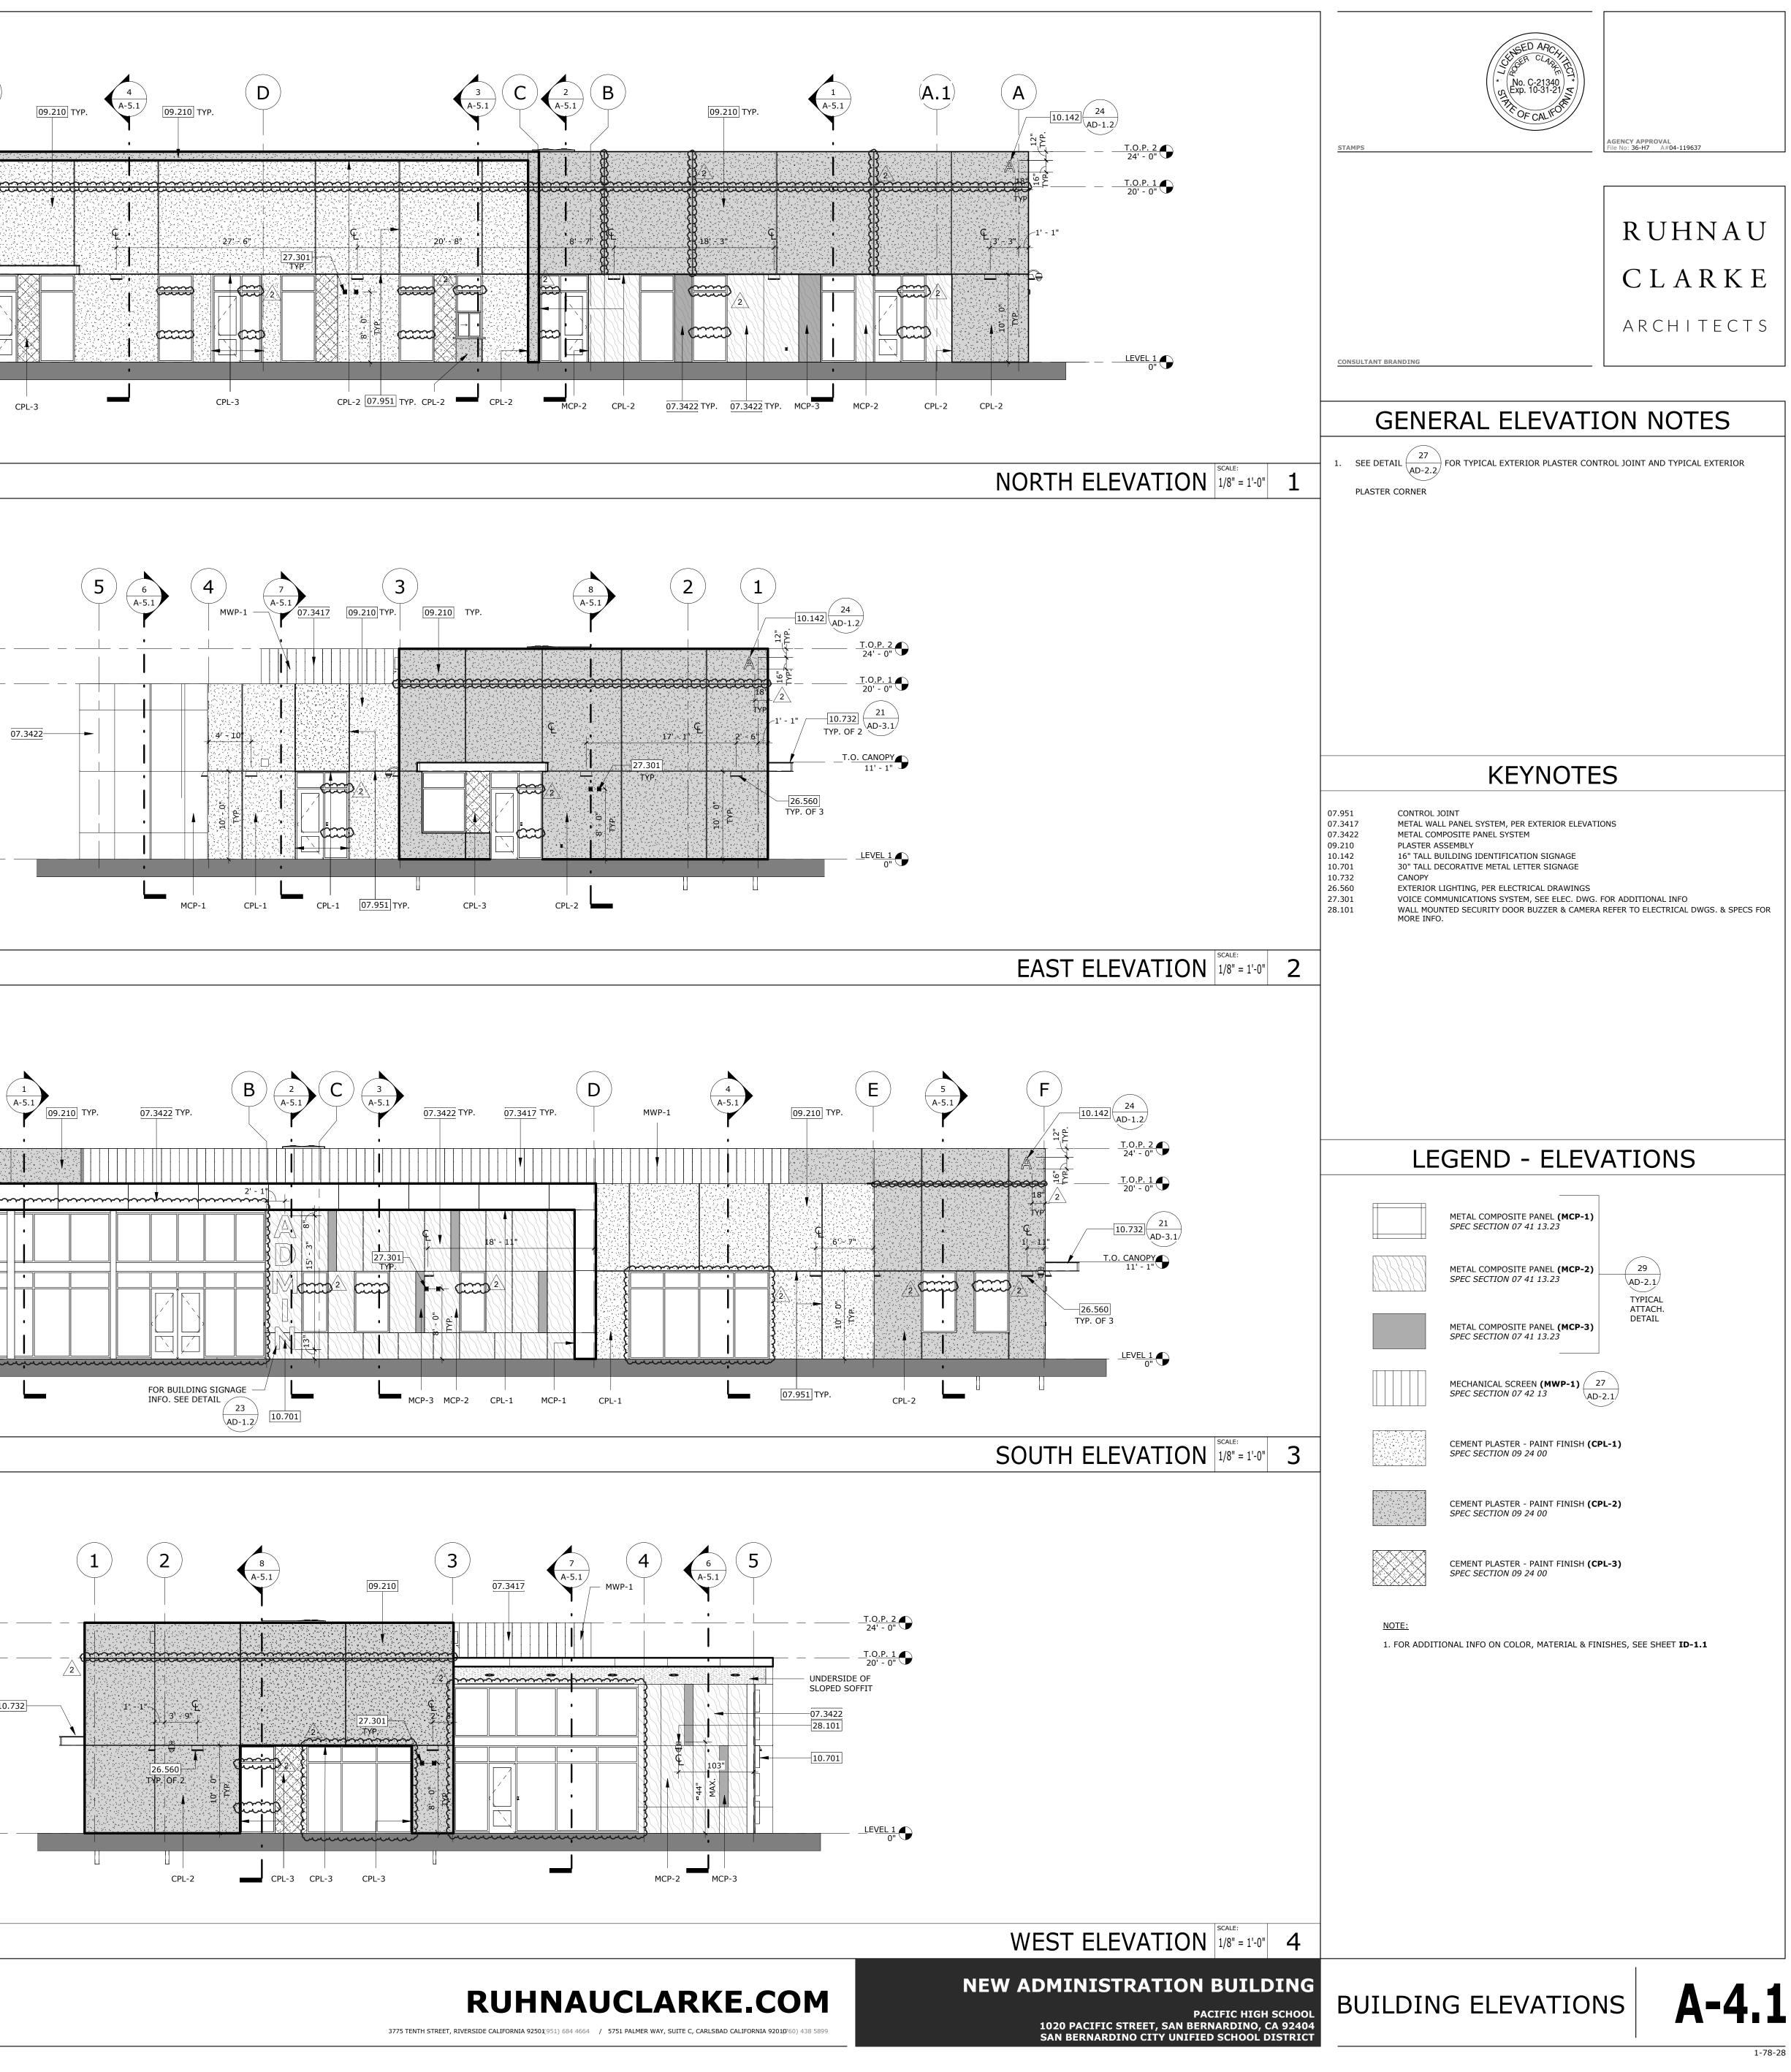

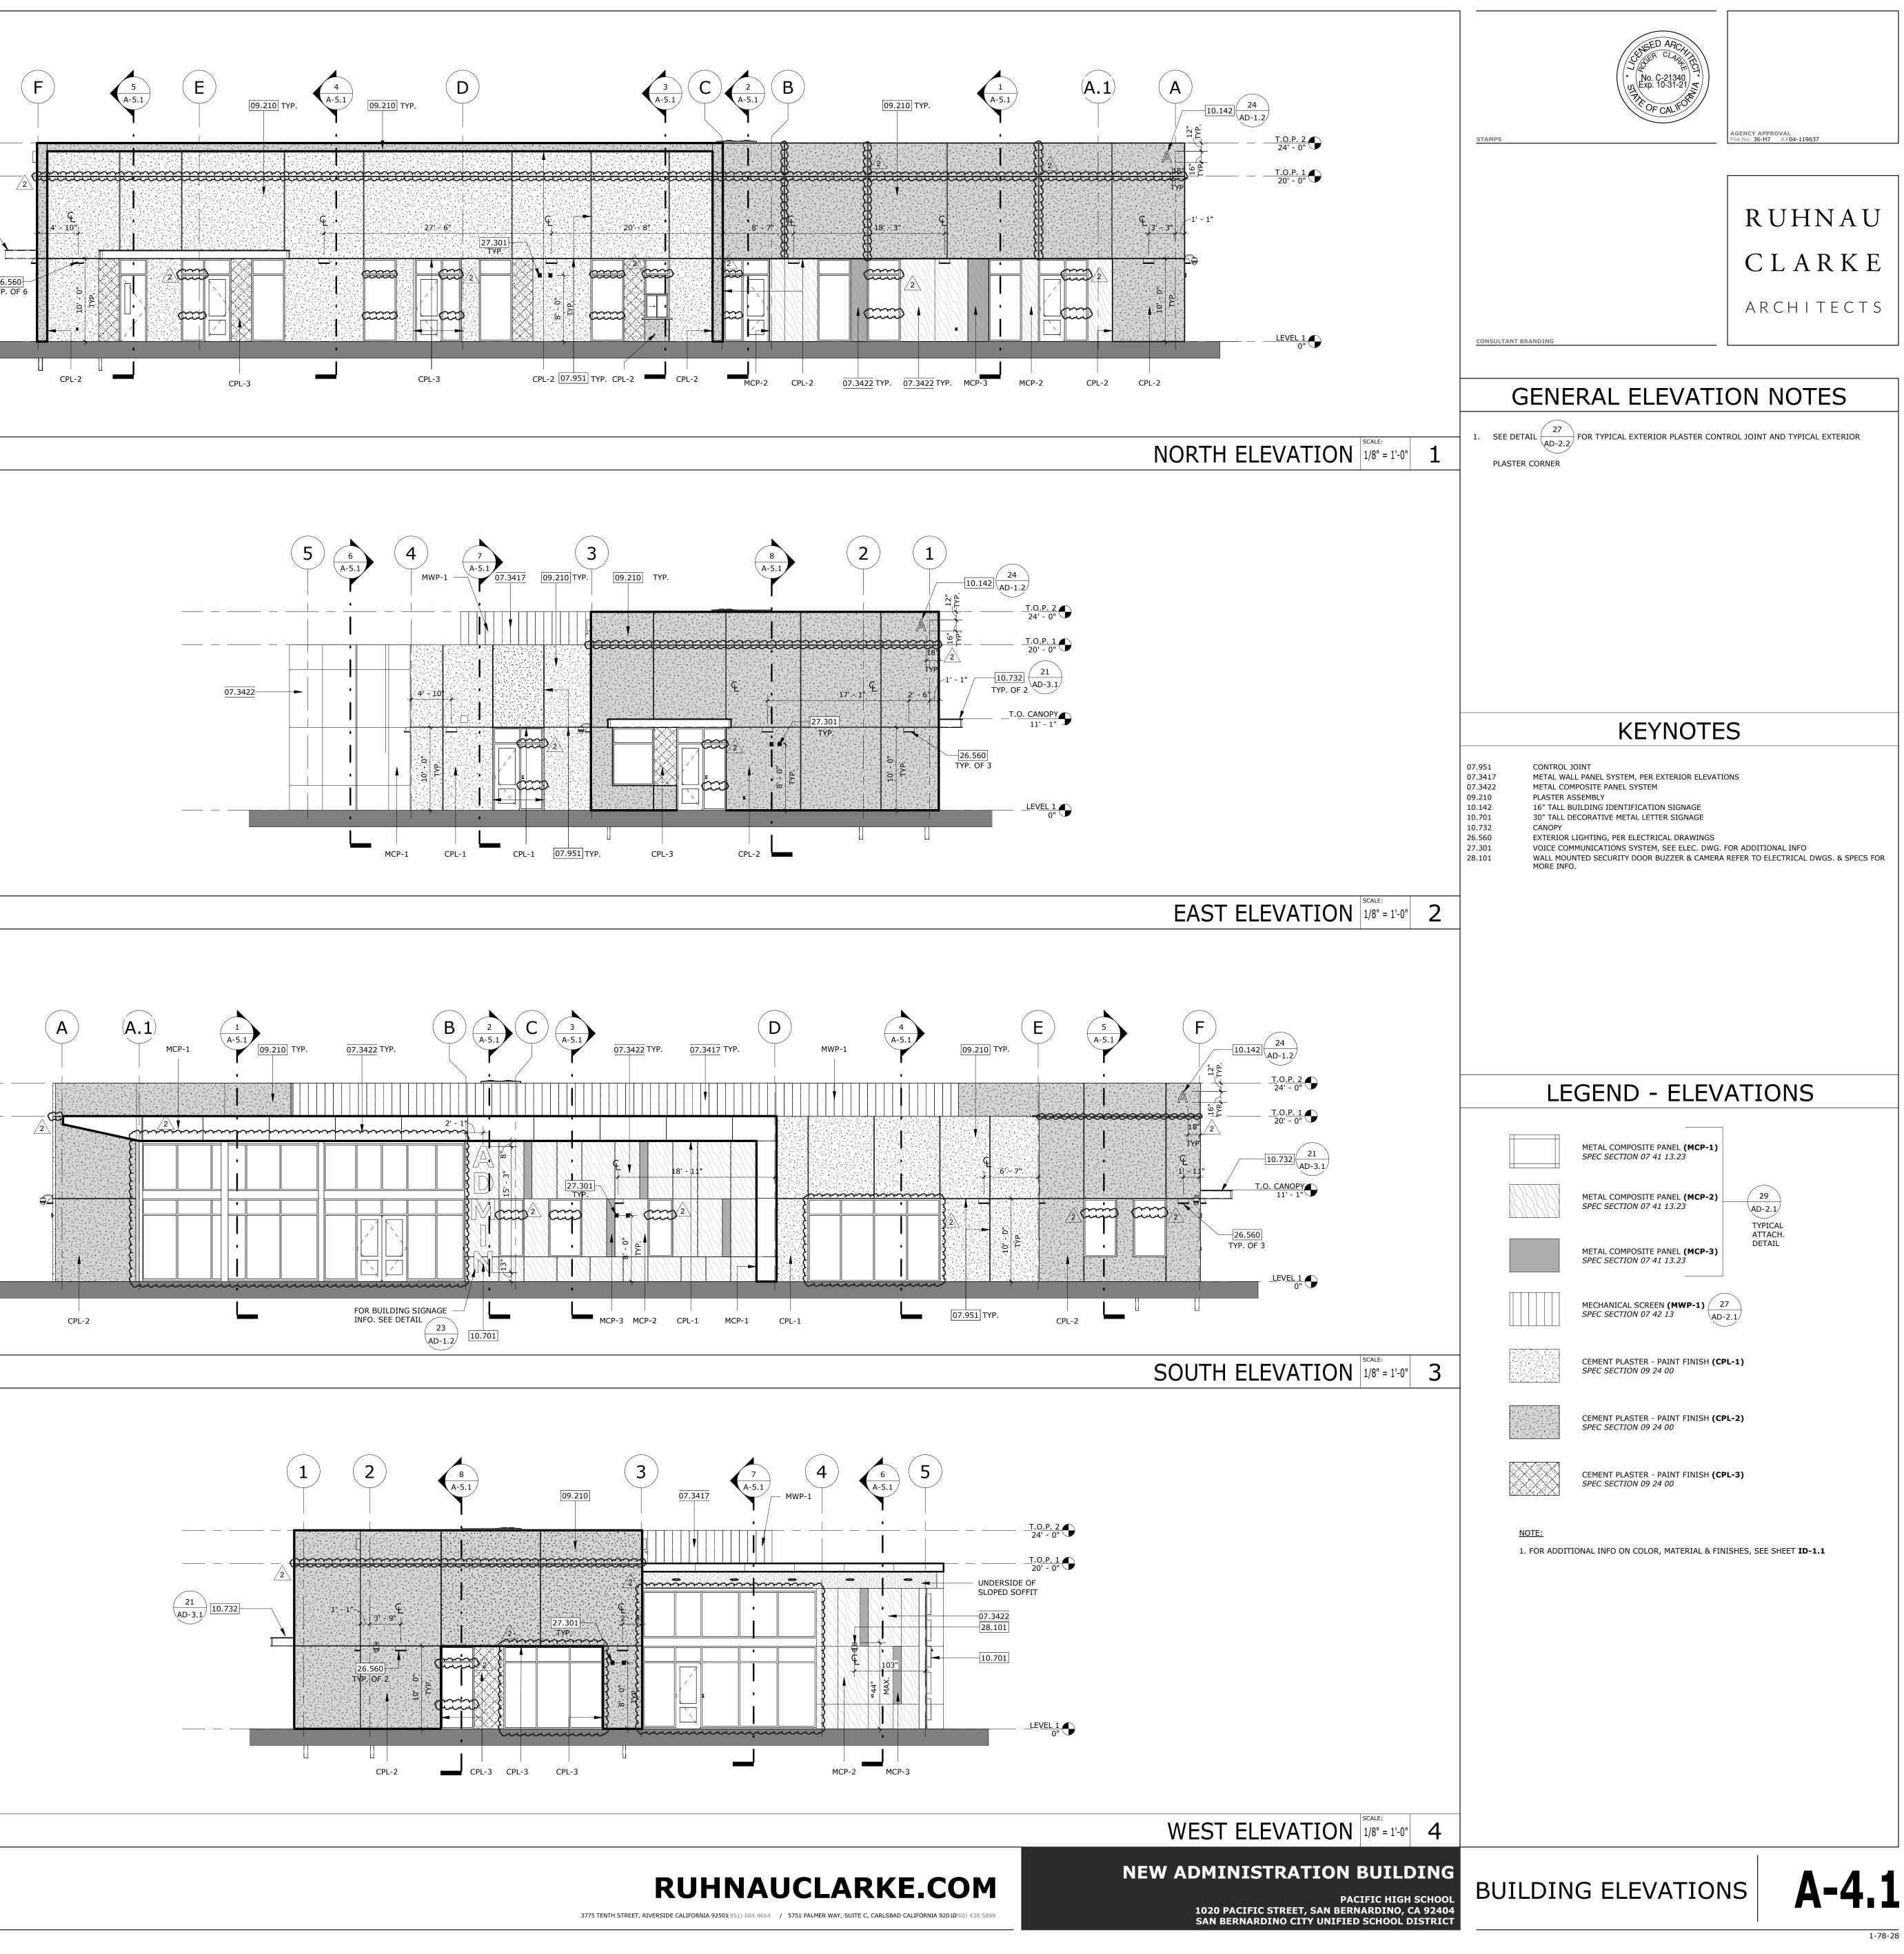

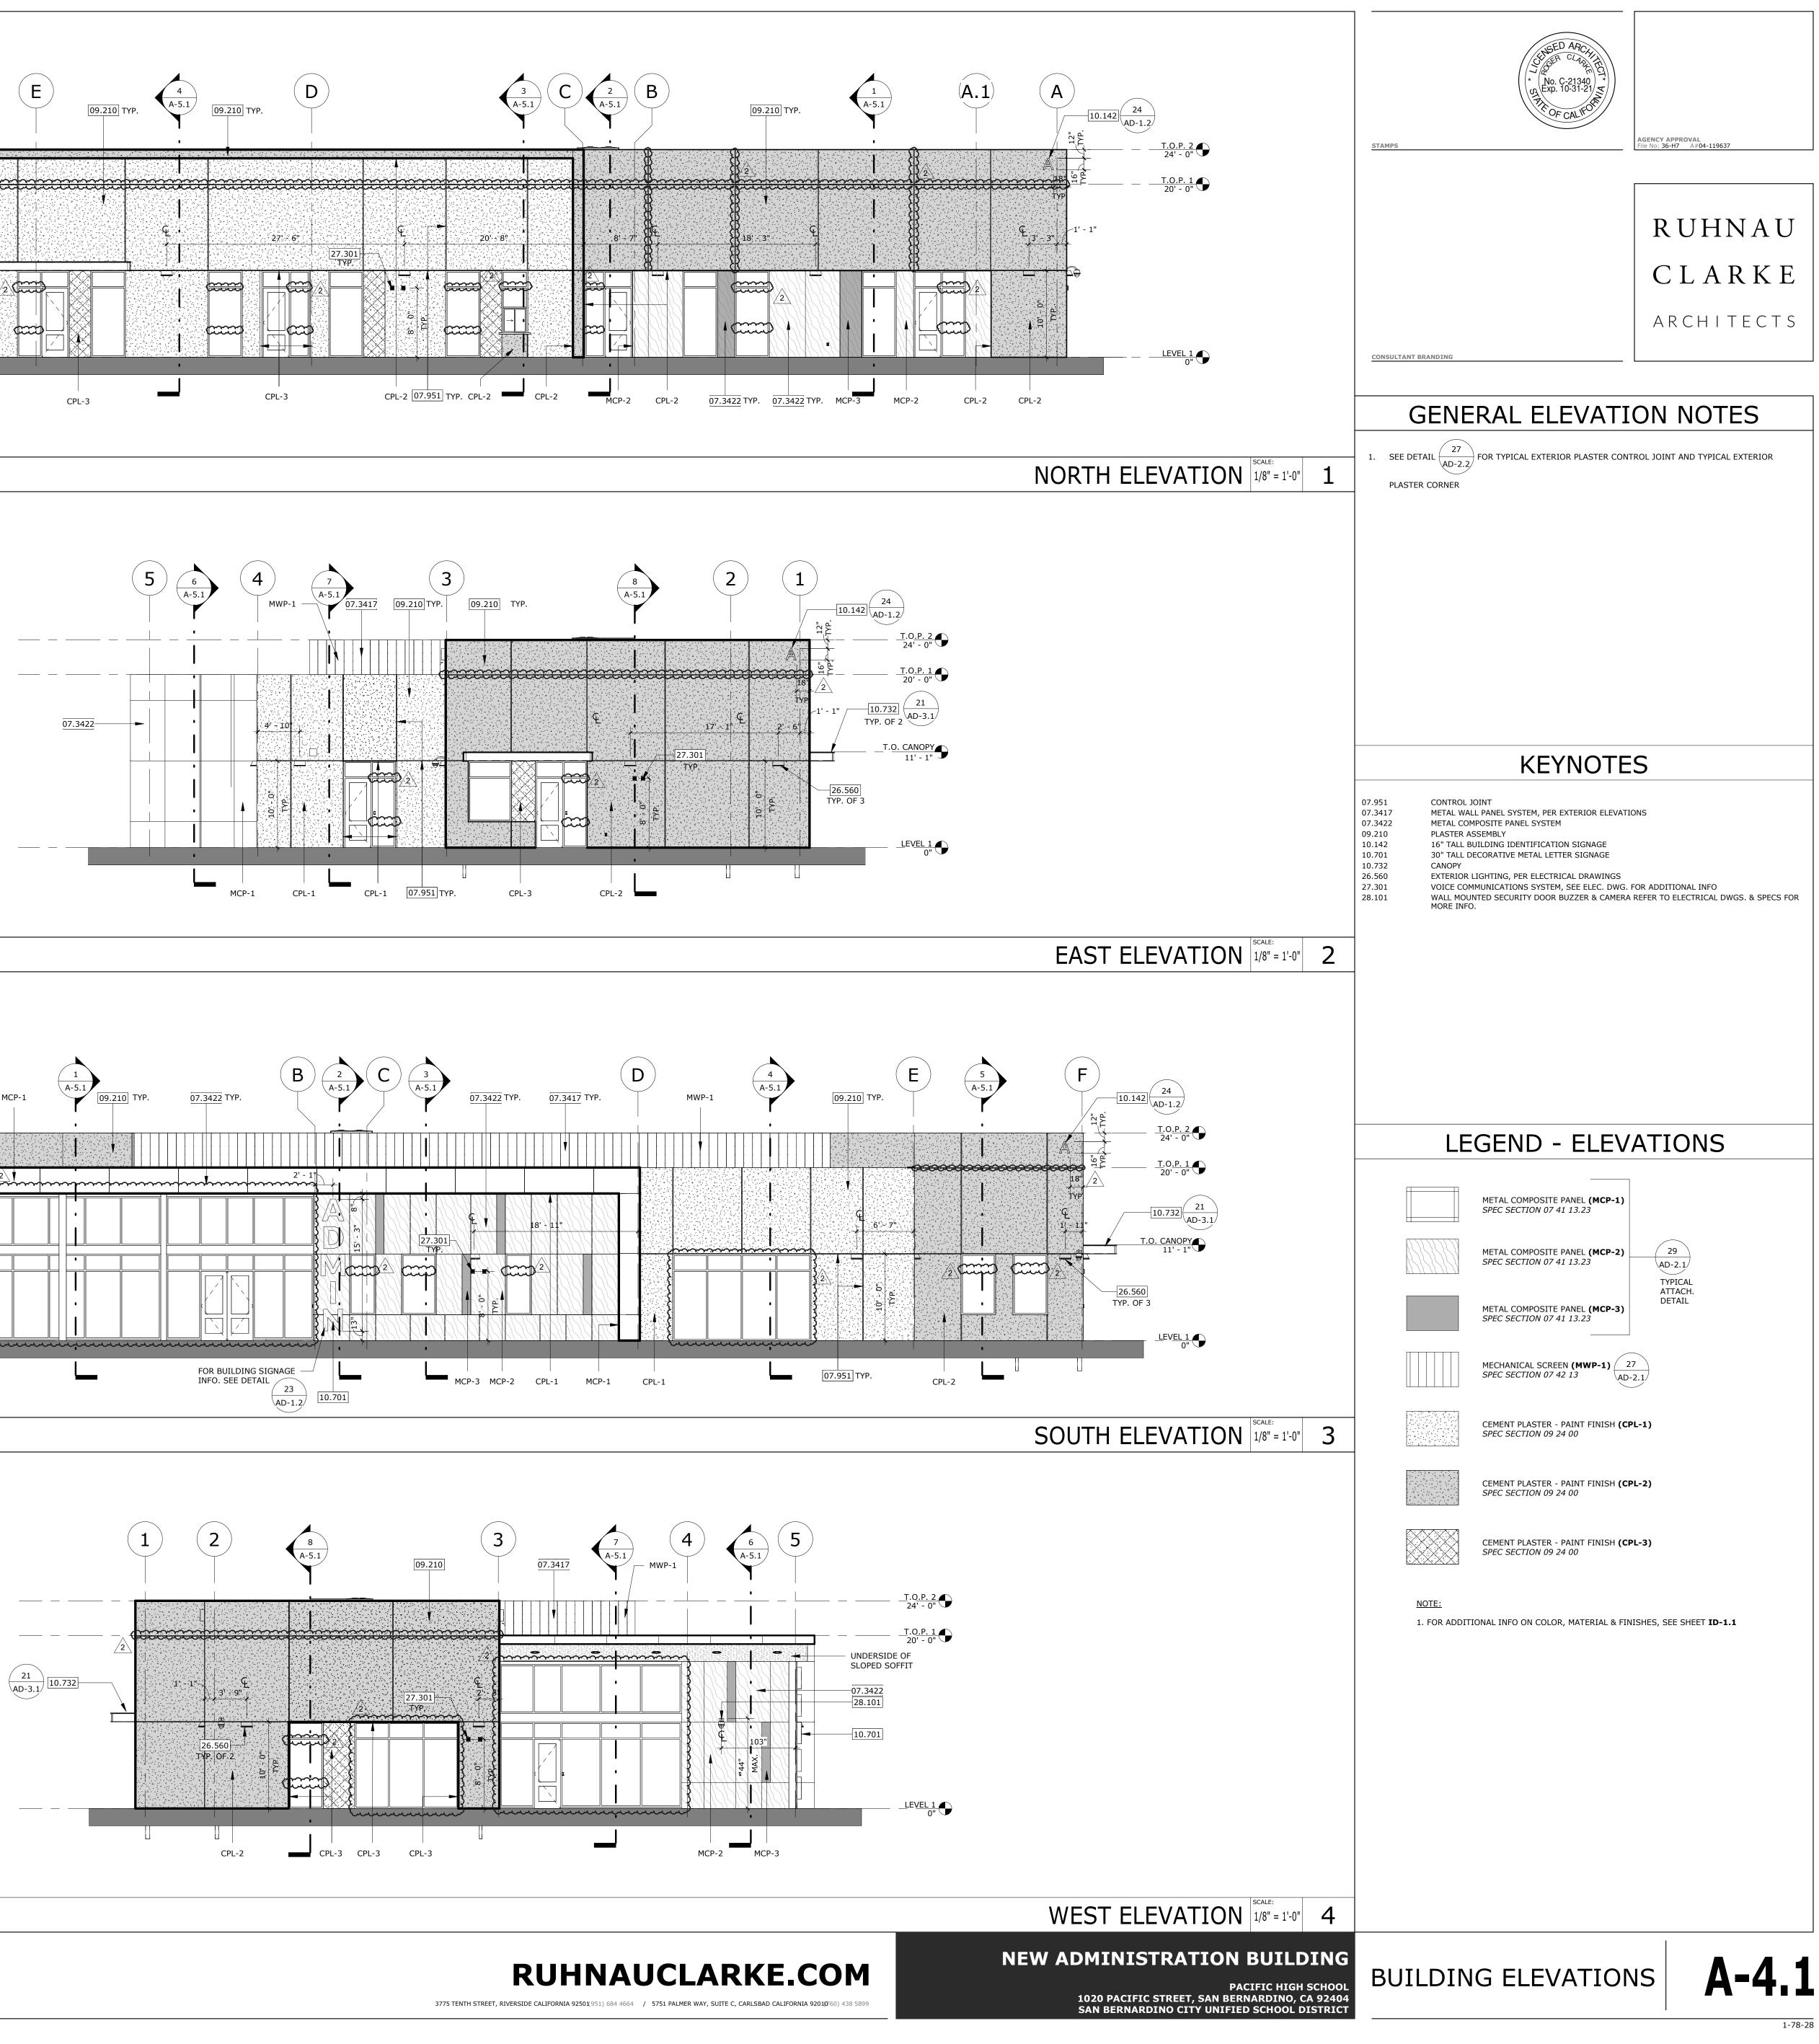

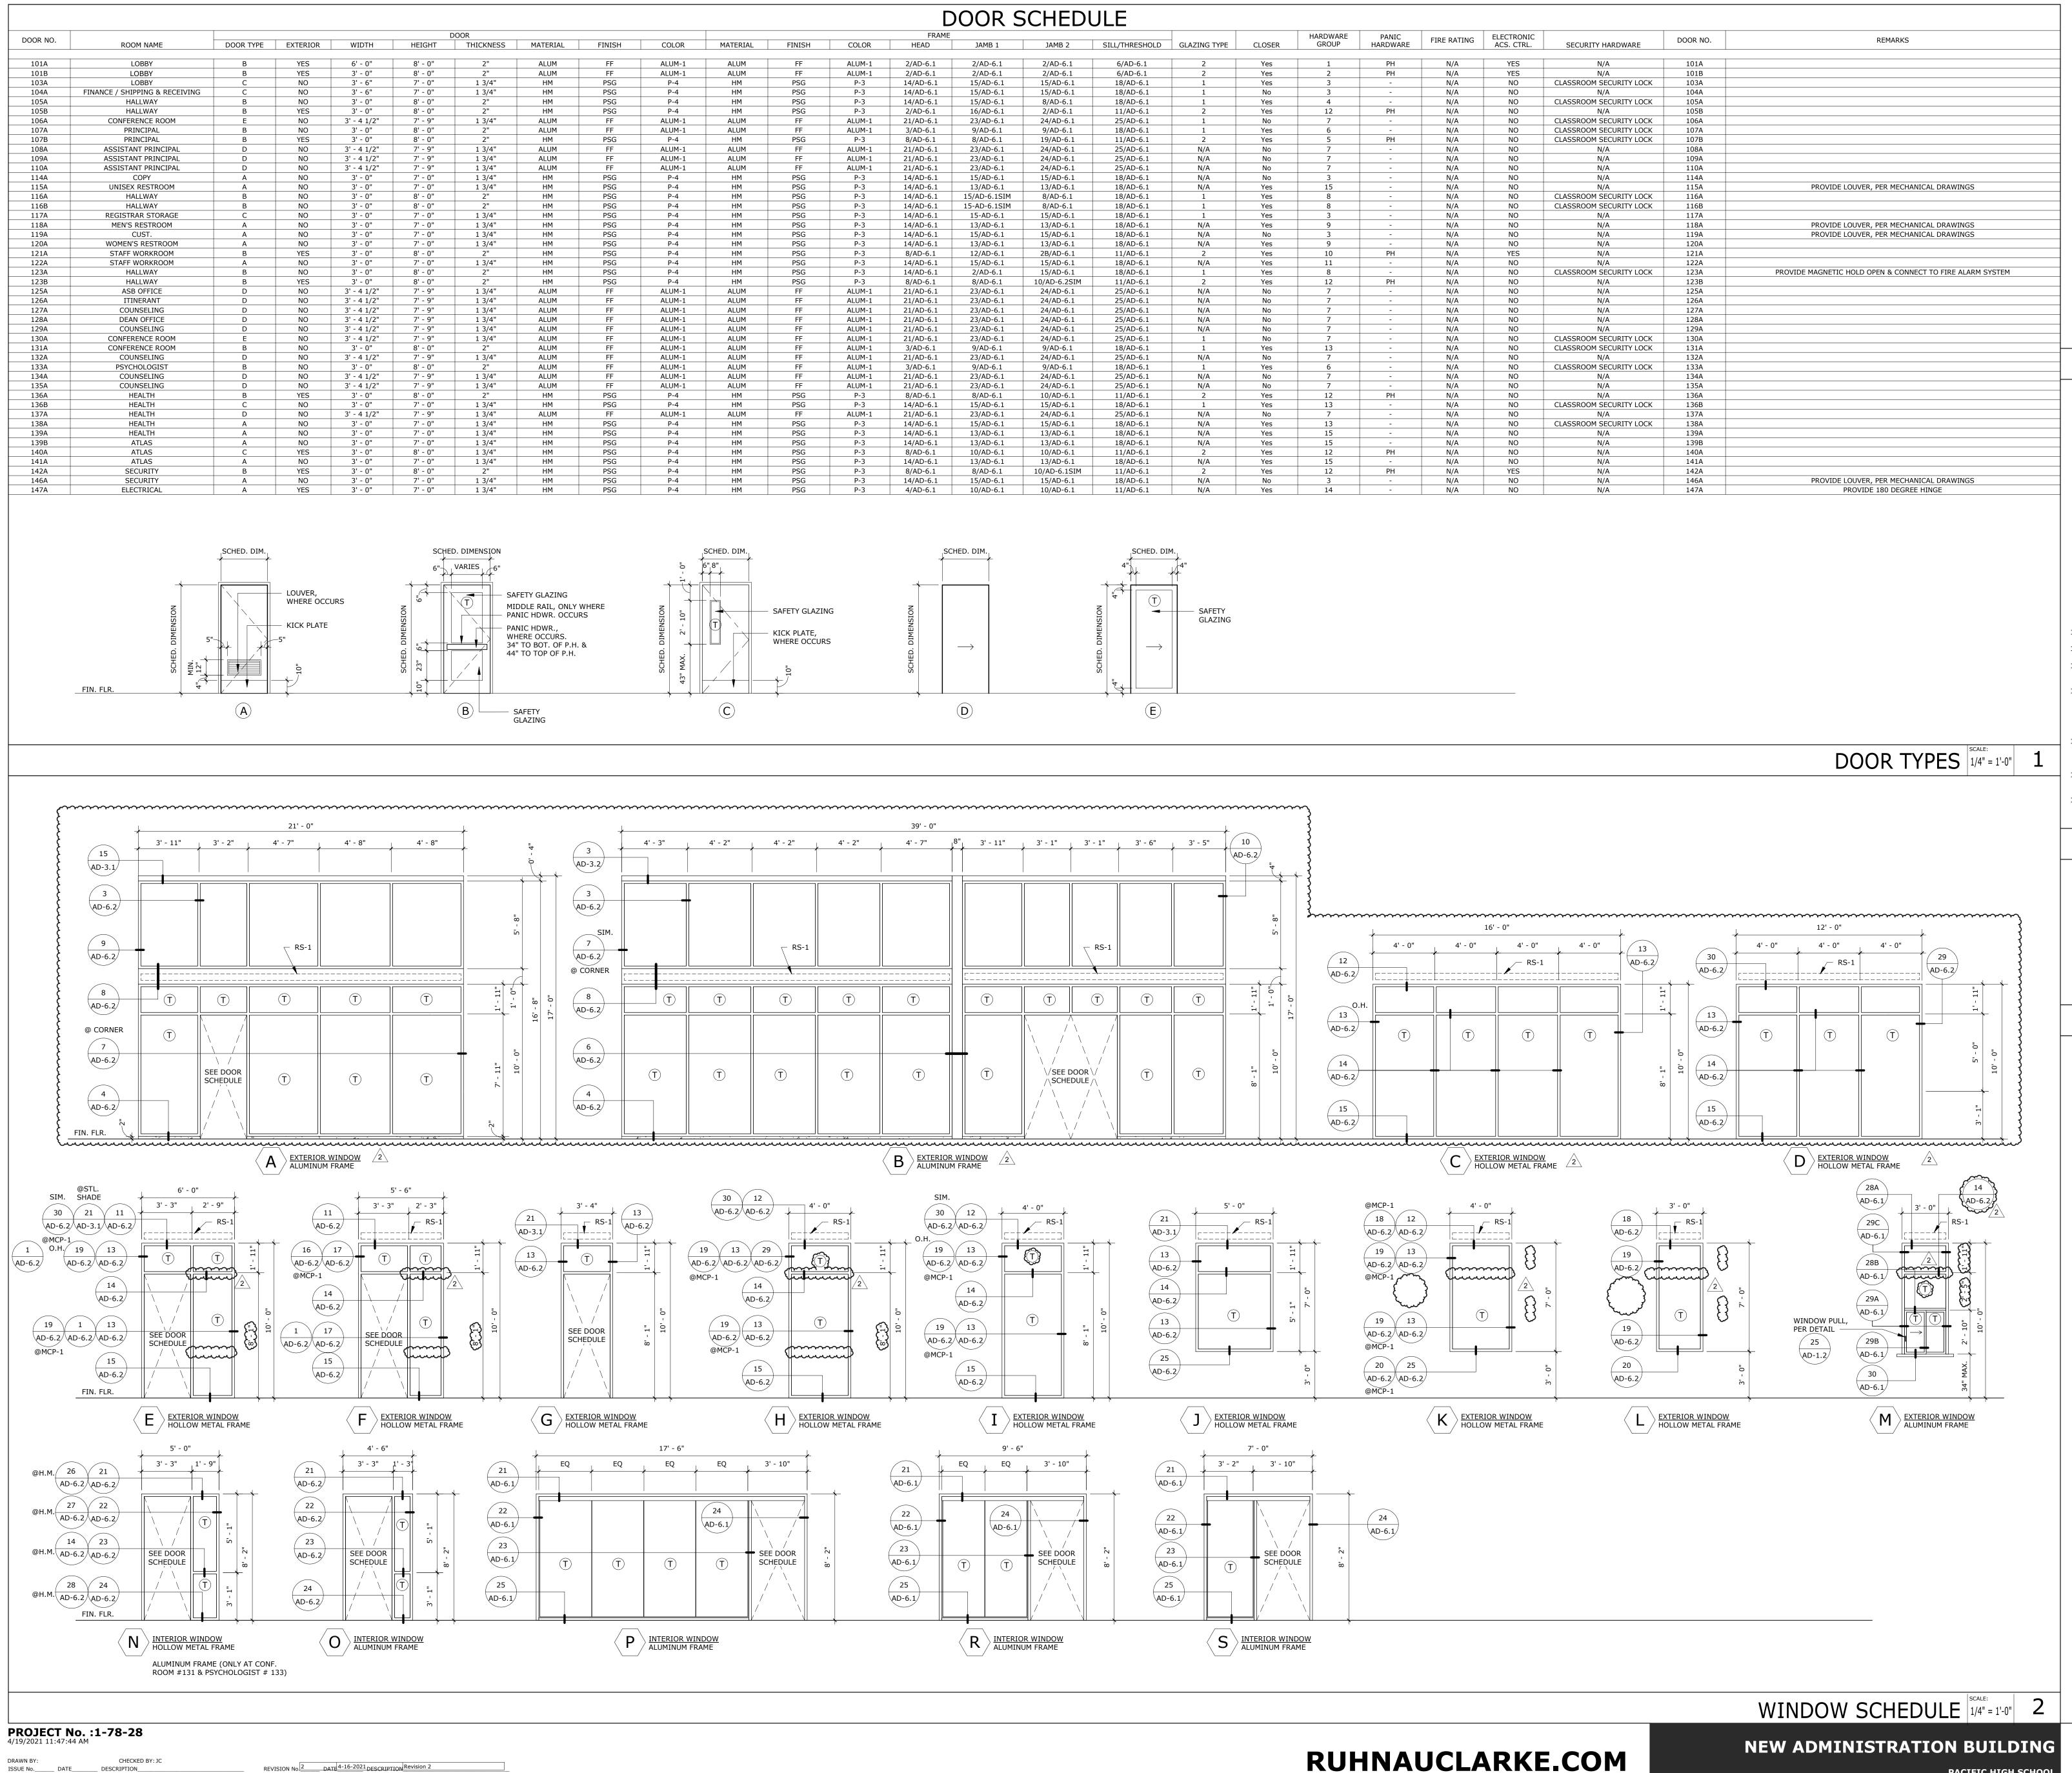

 REVISION No.
 DATE
 4-16-2021 DESCRIPTION Revision 2

 REVISION No.
 DATE
 DESCRIPTION

 REVISION No.
 DATE
 DESCRIPTION

 REVISION No.
 DATE
 DESCRIPTION

 REVISION No.
 DATE
 DESCRIPTION
 ISSUE No.___ ISSUE No.___ ISSUE No.___ DESCRIPTION DESCRIPTION DESCRIPTION DESCRIPTION __ DATE_ __ DATE_ __ DATE_ __ DATE_ ISSUE No.

				Ľ	DOOR S	SCHED	ULE											
				FRAME						HARDWARE	PANIC	FIRE RATING	ELECTRONIC		DOOR NO.	REMARKS	SED ARC	
DR	MATERIAL	FINISH	COLOR	HEAD	JAMB 1	JAMB 2	SILL/THRESHOLD	GLAZING TYPE	CLOSER	GROUP	HARDWARE	FIRE RATING	ACS. CTRL.	SECURITY HARDWARE	DOOR NO.	REMARKS	ER CLANTIN	
												N (A		21/2	1010			
-1	ALUM	FF	ALUM-1	2/AD-6.1	2/AD-6.1	2/AD-6.1	6/AD-6.1	2	Yes	1	PH	N/A	YES	N/A	101A		$\left(\begin{pmatrix} * & No. C-21340 \\ C & Exp. 10-31-21 \\ \checkmark \end{pmatrix} \right)$	
-1	ALUM	FF	ALUM-1	2/AD-6.1	2/AD-6.1	2/AD-6.1	6/AD-6.1	2	Yes	2	PH	N/A	YES		101B			
	HM HM	PSG	P-3	14/AD-6.1	15/AD-6.1	15/AD-6.1	18/AD-6.1	1	Yes	3	-	N/A	NO NO	CLASSROOM SECURITY LOCK	103A			
		PSG	P-3	14/AD-6.1	15/AD-6.1	15/AD-6.1	18/AD-6.1	1	No	3	-	N/A	NO	N/A CLASSROOM SECURITY LOCK	104A		E OF CALIFU	
	HM HM	PSG PSG	P-3 P-3	14/AD-6.1 2/AD-6.1	15/AD-6.1	8/AD-6.1	18/AD-6.1	1	Yes Yes	4	- PH	N/A N/A	NO	N/A	105A 105B			
I_1	ALUM	F3G	ALUM-1	21/AD-6.1	16/AD-6.1 23/AD-6.1	2/AD-6.1 24/AD-6.1	11/AD-6.1 25/AD-6.1	2	No	7		N/A N/A	NO	CLASSROOM SECURITY LOCK	105B		-	AGENCY APPROVAL
-1	ALUM	FF	ALUM-1	3/AD-6.1	9/AD-6.1	9/AD-6.1	18/AD-6.1	1	Yes	6	-	N/A N/A	NO	CLASSROOM SECURITY LOCK	100A 107A		STAMPS	File No: 36-H7 A#04-119637
-1	HM	PSG	P-3	8/AD-6.1	8/AD-6.1	19/AD-6.1	11/AD-6.1	2	Yes	5	PH	N/A N/A	NO	CLASSROOM SECURITY LOCK	107A		-	
-1	ALUM	FF	ALUM-1	21/AD-6.1	23/AD-6.1	24/AD-6.1	25/AD-6.1	N/A	No	7	-	N/A N/A	NO	N/A	108A		-	
I_1	ALUM	FF	ALUM-1	21/AD-6.1	23/AD-6.1	24/AD-6.1	25/AD-6.1	N/A	No	7	-	N/A N/A	NO	N/A	100A 109A		-	
-1	ALUM	FF	ALUM-1	21/AD-6.1	23/AD-6.1	24/AD-6.1	25/AD-6.1	N/A	No	7	-	N/A	NO	N/A	110A		-	
-	HM	PSG	P-3	14/AD-6.1	15/AD-6.1	15/AD-6.1	18/AD-6.1	N/A	No	3	-	N/A	NO	N/A	110A		-	
	НМ	PSG	P-3	14/AD-6.1	13/AD-6.1	13/AD-6.1	18/AD-6.1	N/A	Yes	15	-	N/A	NO	N/A	115A	PROVIDE LOUVER, PER MECHANICAL DRAWINGS	-	
	НМ	PSG	P-3	14/AD-6.1	15/AD-6.1SIM	8/AD-6.1	18/AD-6.1	1	Yes	8	_	N/A	NO	CLASSROOM SECURITY LOCK	116A		—	RUHNAU
	НМ	PSG	P-3	14/AD-6.1	15-AD-6.1SIM	8/AD-6.1	18/AD-6.1	1	Yes	8	_	N/A	NO	CLASSROOM SECURITY LOCK	116B		-	NUNNAU
	НМ	PSG	P-3	14/AD-6.1	15-AD-6.1	15/AD-6.1	18/AD-6.1	1	Yes	3	-	N/A	NO	N/A	117A		-	
	НМ	PSG	P-3	14/AD-6.1	13/AD-6.1	13/AD-6.1	18/AD-6.1	N/A	Yes	9	_	N/A	NO	N/A	118A	PROVIDE LOUVER, PER MECHANICAL DRAWINGS	-	
	НМ	PSG	P-3	14/AD-6.1	15/AD-6.1	15/AD-6.1	18/AD-6.1	N/A	No	3	_	N/A	NO	N/A	119A	PROVIDE LOUVER, PER MECHANICAL DRAWINGS	-	
	HM	PSG	P-3	14/AD-6.1	13/AD-6.1	13/AD-6.1	18/AD-6.1	N/A	Yes	9	-	N/A	NO	N/A	120A			C L A R K E
	HM	PSG	P-3	8/AD-6.1	12/AD-6.1	2B/AD-6.1	11/AD-6.1	2	Yes	10	PH	N/A	YES	N/A	121A		-	
-	HM	PSG	P-3	14/AD-6.1	15/AD-6.1	15/AD-6.1	18/AD-6.1	N/A	Yes	11	-	N/A	NO	N/A	122A			
	НМ	PSG	P-3	14/AD-6.1	2/AD-6.1	15/AD-6.1	18/AD-6.1	1	Yes	8	-	N/A	NO	CLASSROOM SECURITY LOCK	123A	PROVIDE MAGNETIC HOLD OPEN & CONNECT TO FIRE ALARM SYSTEM		
	НМ	PSG	P-3	8/AD-6.1	8/AD-6.1	10/AD-6.2SIM	11/AD-6.1	2	Yes	12	PH	N/A	NO	N/A	123B			ARCHITECTS
1-1	ALUM	FF	ALUM-1	21/AD-6.1	23/AD-6.1	24/AD-6.1	25/AD-6.1	N/A	No	7	-	N/A	NO	N/A	125A			
I-1	ALUM	FF	ALUM-1	21/AD-6.1	23/AD-6.1	24/AD-6.1	25/AD-6.1	N/A	No	7	-	N/A	NO	N/A	126A			
I-1	ALUM	FF	ALUM-1	21/AD-6.1	23/AD-6.1	24/AD-6.1	25/AD-6.1	N/A	No	7	-	N/A	NO	N/A	127A		CONSULTANT BRANDING	
I-1	ALUM	FF	ALUM-1	21/AD-6.1	23/AD-6.1	24/AD-6.1	25/AD-6.1	N/A	No	7	-	N/A	NO	N/A	128A		CONSULIANT BRANDING	
I-1	ALUM	FF	ALUM-1	21/AD-6.1	23/AD-6.1	24/AD-6.1	25/AD-6.1	N/A	No	7	-	N/A	NO	N/A	129A			
I-1	ALUM	FF	ALUM-1	21/AD-6.1	23/AD-6.1	24/AD-6.1	25/AD-6.1	1	No	7	-	N/A	NO	CLASSROOM SECURITY LOCK	130A			
I-1	ALUM	FF	ALUM-1	3/AD-6.1	9/AD-6.1	9/AD-6.1	18/AD-6.1	1	Yes	13	-	N/A	NO	CLASSROOM SECURITY LOCK	131A			
1-1	ALUM	FF	ALUM-1	21/AD-6.1	23/AD-6.1	24/AD-6.1	25/AD-6.1	N/A	No	7	-	N/A	NO	N/A	132A			
1-1	ALUM	FF	ALUM-1	3/AD-6.1	9/AD-6.1	9/AD-6.1	18/AD-6.1	1	Yes	6	-	N/A	NO	CLASSROOM SECURITY LOCK	133A		GENERAL NO	
l-1	ALUM	FF	ALUM-1	21/AD-6.1	23/AD-6.1	24/AD-6.1	25/AD-6.1	N/A	No	7	-	N/A	NO	N/A	134A			5120
I-1	ALUM	FF	ALUM-1	21/AD-6.1	23/AD-6.1	24/AD-6.1	25/AD-6.1	N/A	No	7	-	N/A	NO	N/A	135A			
	HM	PSG	P-3	8/AD-6.1	8/AD-6.1	10/AD-6.1	11/AD-6.1	2	Yes	12	PH	N/A	NO	N/A	136A		1. SEE SHEETS AD-6.1 & AD-6.2 FOR ALUMINUM & HOLLOW M	ETAL FRAME DETAILS
	HM	PSG	P-3	14/AD-6.1	15/AD-6.1	15/AD-6.1	18/AD-6.1	1	Yes	13	-	N/A	NO	CLASSROOM SECURITY LOCK	136B			
I-1	ALUM	FF	ALUM-1	21/AD-6.1	23/AD-6.1	24/AD-6.1	25/AD-6.1	N/A	No	7	-	N/A	NO	N/A	137A			
-	НМ	PSG	P-3	14/AD-6.1	15/AD-6.1	15/AD-6.1	18/AD-6.1	N/A	Yes	13	-	N/A	NO	CLASSROOM SECURITY LOCK	138A		2. SET DOORS ADJACENT TO WALLS A MIN. OF 4" AWAY FROM V	WALL U.N.O.
	НМ	PSG	P-3	14/AD-6.1	13/AD-6.1	13/AD-6.1	18/AD-6.1	N/A	Yes	15	-	N/A	NO	N/A	139A		3. ALL GLAZING IN DOORS, AND WINDOWS BELOW 8'-0" A.F.F.,	
	НМ	PSG	P-3	14/AD-6.1	13/AD-6.1	13/AD-6.1	18/AD-6.1	N/A	Yes	15	-	N/A	NO	N/A	139B		SECTION 2406 OF THE 2019 CBC	, AND ILIVIFENED ON AS REQUIRED DI
	НМ	PSG	P-3	8/AD-6.1	10/AD-6.1	10/AD-6.1	11/AD-6.1	2	Yes	12	PH	N/A	NO	N/A	140A			
	HM	PSG	P-3	14/AD-6.1	13/AD-6.1	13/AD-6.1	18/AD-6.1	N/A	Yes	15	-	N/A	NO	N/A	141A		4. PROVIDE DOOR STOPS AT ALL INTERIOR DOORS. PROVIDE M	1ETAL STUD BACKING PER DETAIL (
	HM	PSG	P-3	8/AD-6.1	8/AD-6.1	10/AD-6.1SIM	11/AD-6.1	2	Yes	12	PH	N/A	YES	N/A	142A			S0-2.6
	HM	PSG	P-3	14/AD-6.1	15/AD-6.1	15/AD-6.1	18/AD-6.1	N/A	No	3	-	N/A	NO	N/A	146A	PROVIDE LOUVER, PER MECHANICAL DRAWINGS		
	HM	PSG	P-3	4/AD-6.1	10/AD-6.1	10/AD-6.1	11/AD-6.1	N/A	Yes	14	-	N/A	NO	N/A	147A	PROVIDE 180 DEGREE HINGE	5. ALL EXTERIOR DOORS ARE TO SWING OUT AND OPEN TO A M	IN. OF 110 DEGREES FROM ITS CLOSED

3775 TENTH STREET, RIVERSIDE CALIFORNIA 92501(951) 684 4664 / 5751 PALMER WAY, SUITE C, CARLSBAD CALIFORNIA 9201(960) 438 5899

PACIFIC HIGH SCHOOL 1020 PACIFIC STREET, SAN BERNARDINO, CA 92404 SAN BERNARDINO CITY UNIFIED SCHOOL DISTRICT

DOOR & WINDOW SCHEDULE





IERAL NOTES

POSITION WHERE POSSIBLE, U.N.O.

OCCURS, TYP.

ALUM ALUMINUM

GALV GALVANIZED

GLAZING TYPES

GENERAL GLAZING NOTES

ALL GLAZING IN DOORS

•

•

ALL DOOR TRANSOMS

ANODOZIED

HOLLOW METAL

HOLLOW CORE

STL STEEL PSG PAINT: SEMI-GLOS<u>S</u>

AN

HM

HC

- EXCEPTION: WHERE TACTILE SIGNAGE IS LOCATED ON HINGE SIDE OF DOOR, DOORS TO HAVE A 90 DEGREE SWING LIMIT

6. ALL EXTERIOR DOORS SHALL HAVE A POLYSTYRENE CORE (THERMAL RESISTANCE) 7. PROVIDE AIR SEALS/WEATHER STRIPPING AT ALL EXTERIOR DOORS TO CONDITIONED SPACES. 8. ALL FLOOR MATERIAL CHANGE SHALL BE LOCATED UNDER THE CENTERLINE OF DOOR WHERE

9. ALL EXTERIOR DOORS SHALL BE OPERABLE FROM THE INTERIOR WITHOUT THE USE OF A KEY OR ANY SPECIAL KNOWLEDGE OR EFFORT. DEAD BOLTS ARE ONLY PERMITTED WHEN OPERABLE WITH A SINGLE EFFORT LEVER TYPE HARDWARE.

10. HAND ACTIVATED DOOR OPENING HARDWARE SHALL BE MOUNTED 34"-44" A.F.F. 11. ALL DOORS SHALL BE LOCKABLE FROM THE INTERIOR SIDE

12. PER SECTION 1008.1.10 IN THE CBC 2019, DOOR SERVING ROOMS OR SPACES WITH AN OCCUPANT LOAD OF 50 OR MORE ARE REQUIRED TO HAVE PANIC HARDWARE OR FIRE EXIT HARDWARE. 13. PER CBC 2019 11B-404.2.5, THRESHOLDS SHALL BE 1/2" HIGH MAX., SEE DETAILS 6 $\sqrt{11}$ $\sqrt{18}$

AD-6.1 AD-6.1 AD-6.1

14. THE BOTTOM 10" OF ALL DOORS EXTENDING THE FULL WIDTH SHALL HAVE A SMOOTH UNINTERRUPTED SURFACE TO ALLOW THE DOOR TO BE OPENED BY A WHEELCHAIR FOOTRES WITHOUT CREATING A TRAP OR HAZARDOUS CONDITION. CBC 2019 11B-404.2.10 MAXIMUM EFFORT TO OPERATE ALL DOORS SHALL NOT EXCEED 5 LBS FOR BOTH EXTERIOR AND INTERIOR DOORS. FIRE DOORS SHALL NOT EXCEED 15 LBS. CBC 2019 11B-404.2.9 .6. REFER TO SPECIFICATION SECTION 08 71 00 FOR DOOR HARDWARE INFORMATION

ABBREVIATIONS

RS-1 ROLLER WINDOW SHADES - SPEC. SECTION - 12 24 00

GLAZING NOTES

(1) TYPE S-1: SINGLE VISION GLAZING, COLOR PER CMF LEGEND (2) TYPE IG: SEALED INSULATED GLASS UNIT, COLOR PER CMF LEGEND

L. VERIFY ALL DIMENSIONS IN FIELD PRIOR TO FABRICATION

2. All exterior glazed doors and windows to receive type (2) glazing, U.N.O. 3. GLAZING TO BE TEMPERED (T) SHALL INCLUDE:

ALL DOOR SIDELIGHTS WITHIN 24" OF DOOR FRAME

ALL WINDOW GLAZING WITHIN A DISTANCE OF 36" HORIZONTALLY FROM A WALKING PATH AND UP TO 60" FROM GRADE

ALL GLAZING WITHIN THE SWING OF A DOOR


4. ALL INTERIOR DOORS AND WINDOWS TO RECEIVE TYPE (1) GLAZING, U.N.O.

5. ALL GLAZING SHALL MEET THE MIN. GLAZING REQUIREMENTS LISTED IN 2019 CBC TABLE 2403.2.1 TABLE 2406.2(1)






1-78-28

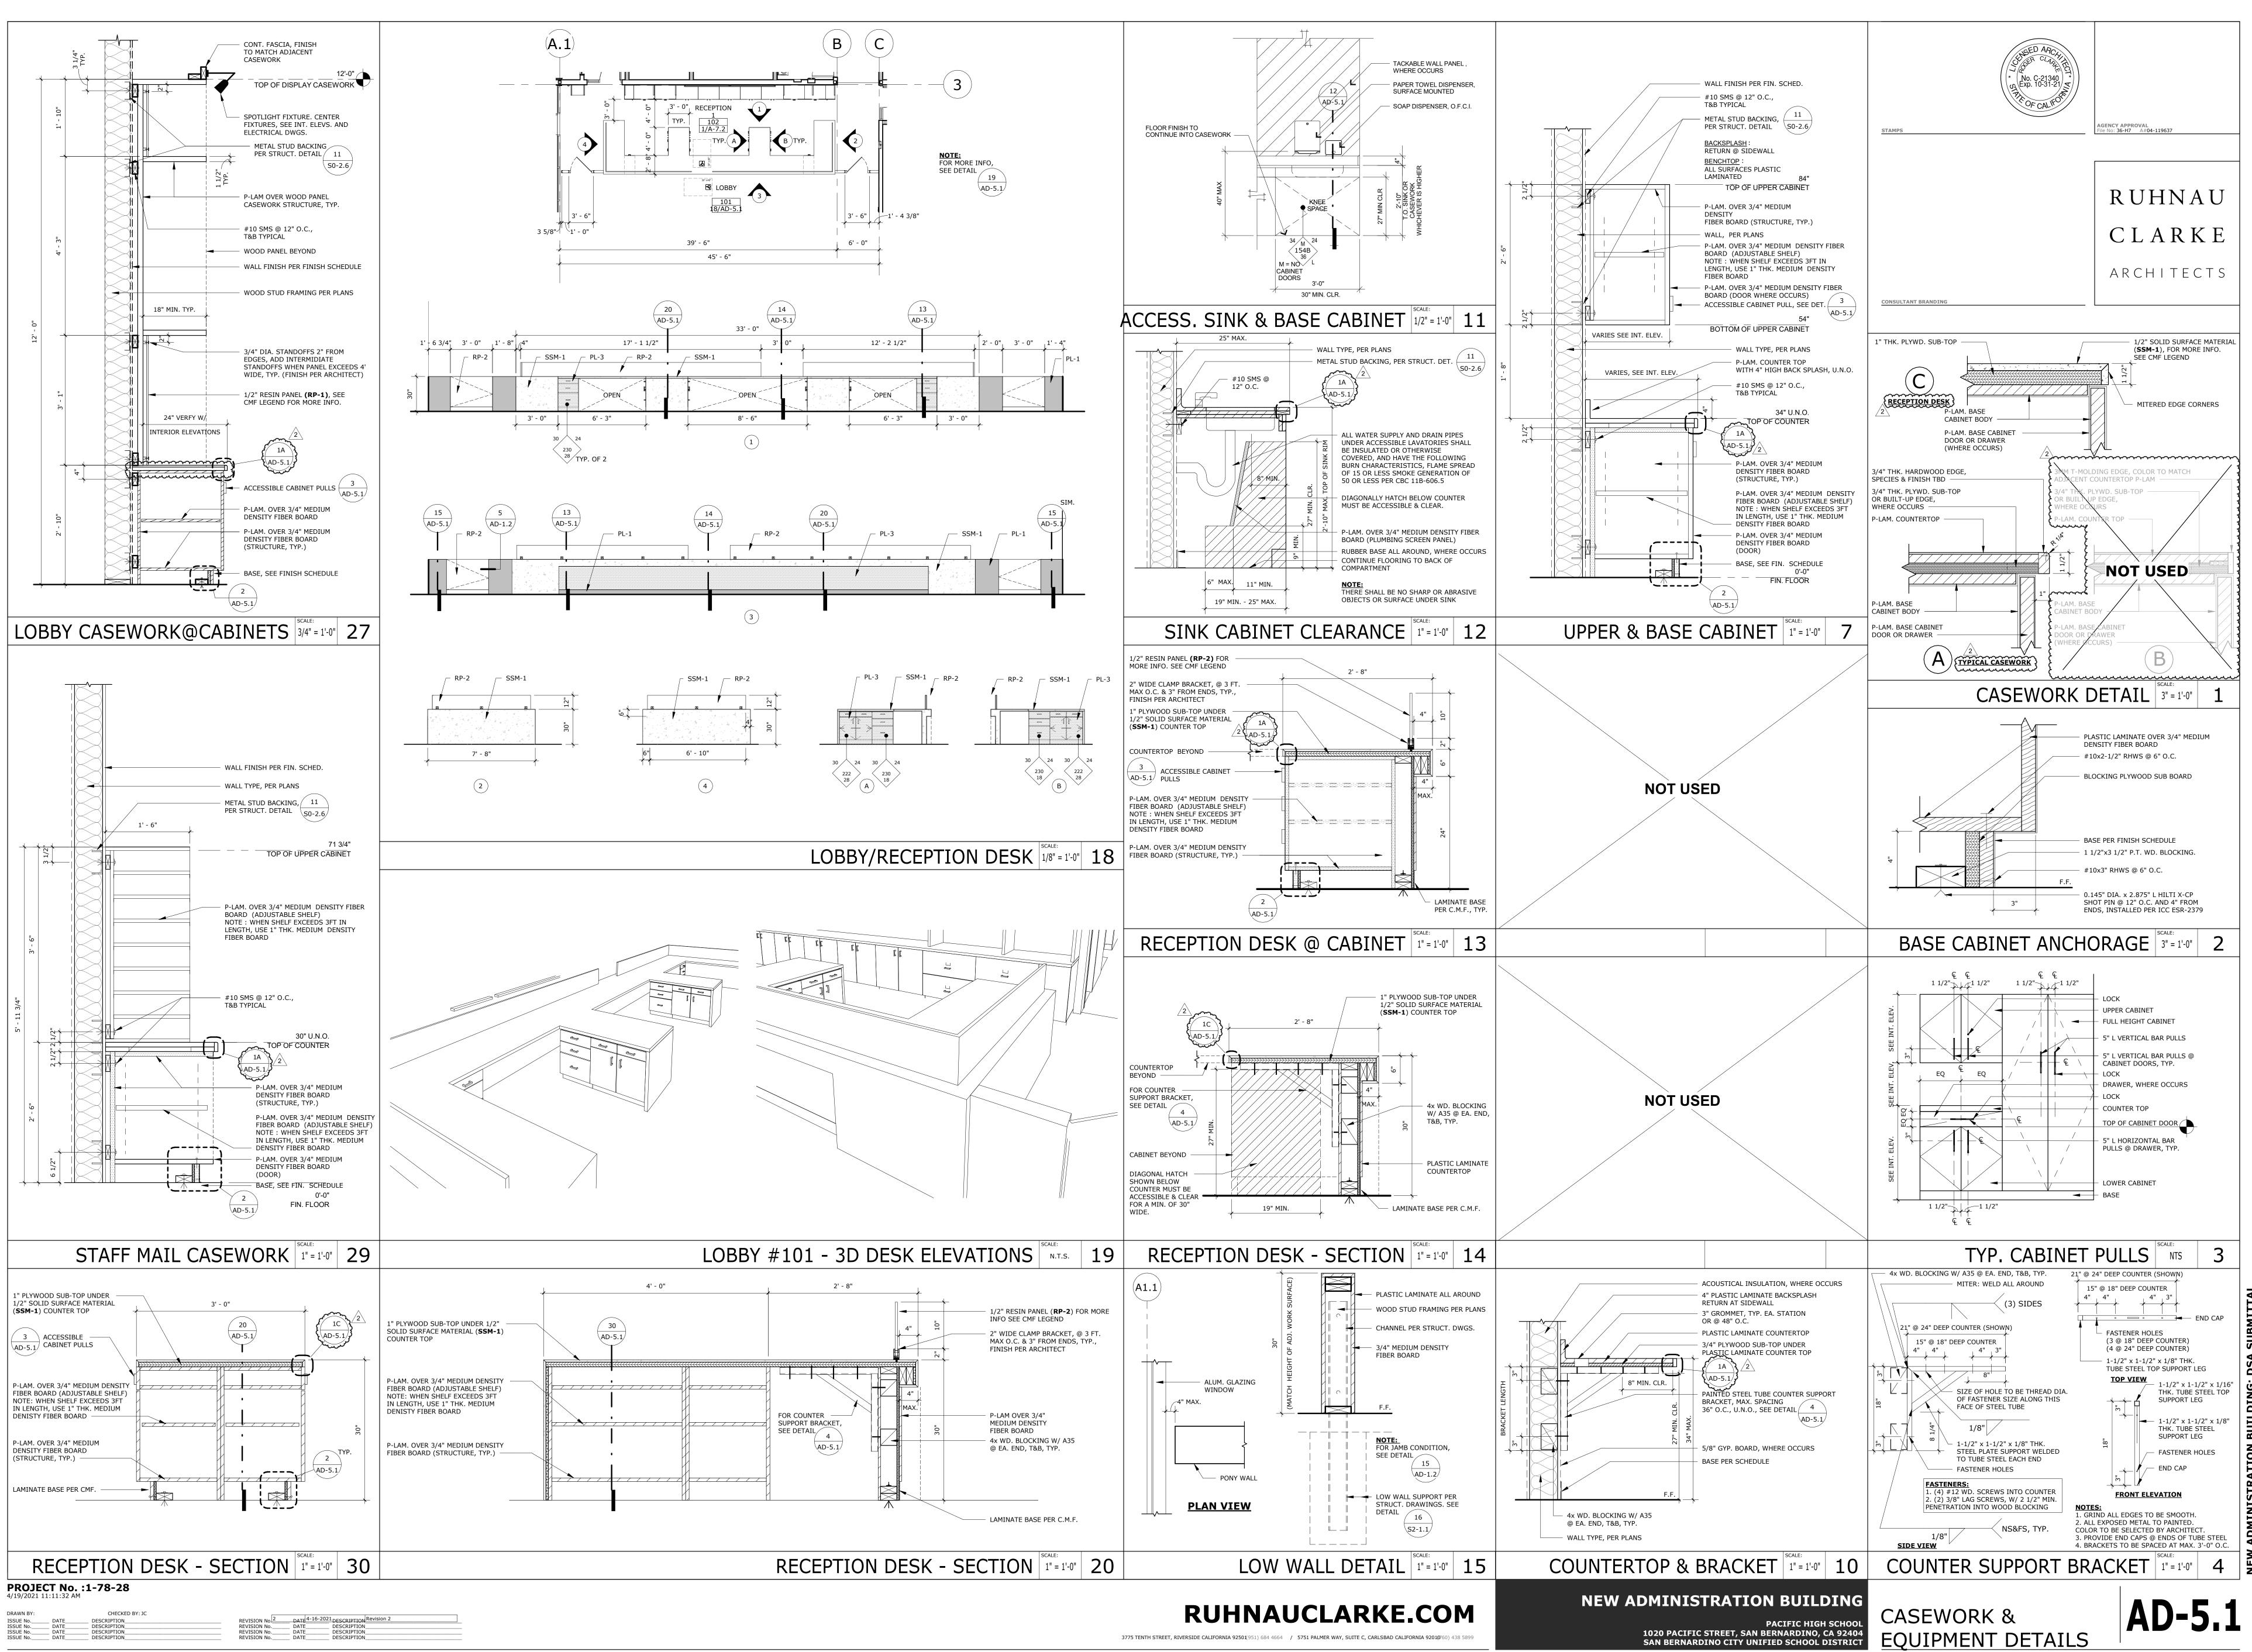

												PAC	KAGE G	AS-EL	ECT	RIC A	VC UNI	T SCH	HEDL	JLE													
Ν	IANUFACTURER &	AREA			FAN S	YSTE	M		1	ESIGN COC	LING CONDI	TION		HE	ATING C	CAPACITY	(MBH)	UNIT ELEC	TRICAL	POWER	EXHAUST	ELECT	RICAL 3		T ELECTRICAL	AREA SMOKE				REFRIG	ANCHORAGE	CURB	REMARKS
TAG "	MODEL NO.	SERVED	CFM	ESP	RPM C	RIVE	BHP OSA	AMBIEN DB/WE		G LEAVIN DB/WE				AMB. TEMP.°F	INPUT	OUTPUT	EFFICIENCY	V-PH-HZ	AMPS	V-PH-HZ	AMPS	HP	CFM	V-PH-HZ	FLA	DETECTOR FO SHUTDOWN	R WEIGH	T (LBS.)	FILTER	TYPE	DETAIL REFERENCE	DETAIL REFERENCE	(SEE EQUIPMENT NOTES BELOW)
AC 1	CARRIER 48GCGM06A2M6-3A2D0	105, 106, 107, 108, 109, 110, 111, 112, 113, 114 & 115	2,200	1.0"	2,368	DIRECT	1.42 370	106.0	80.0	57.7	48.74	52.96	12.5 EER 16.00 SEER	27.0	60.0	49.0	81.0%	460-3-60	15.0 MCA 20.0 MOCP	460-3-60	3.5 MCA 6.3 MOCP	1.0	2,200	120-1-60	2.2	YES		ECONO/ PWR EXH: 17 1,184	78 MERV 13	R-410a	(1) (MD-1.1)	9 MD-1.1	1 2 4 5 6 7 8 11 12 13 16 2
AC 2	CARRIER 48LCD007A2M6-4A2D0	101 & 102	2,620	1.0"	817	BELT	1.32 155	106.0	77.0	55.3 48.	3 57.64	62.77	13.0 EER 20.5 IEER	27.0	72.0	59.0	82.0%	460-3-60	22.0 MCA 25.0 MOCP	460-3-60	3.5 MCA 6.3 MOCP	1.0	2,620	120-1-60	2.2	YES	UNIT: 1,120 CURB: 446 TOTAL:	PWR EXH: 28	35 MERV 13	R-410a	(1) (MD-1.1)	5 MD-2.1	1 2 4 5 6 7 8 12 13 14 15 17 2
AC 3	CARRIER 48GCGM04A2M6-3A2D0	125, 126, 127, 135, 136, 137 & 138	945	1.0"	1,824	DIRECT	0.44 140	106.0	79.0	56.8 53.	0 21.40	26.15	12.5 EER 16.00 SEER	27.0	60.0	49.0	81.0%	460-3-60	12.0 MCA 15.0 MOCP	460-3-60	1.9 MCA 3.4 MOCP	0.5	945	120-1-60	2.2	NO		ECONO/ PWR EXH: 17 1,093	78 MERV 13	R-410a	(1) (MD-1.1)	9 MD-1.1	1 2 4 5 6 7 8 11 12 13 16 2
AC 4	CARRIER 48GCGM05A2M6-3A2D0	123, 124, 128, 129, 130, 131, 132, 133 & 134	1,540	1.0"	2,078	DIRECT	0.97 365	106.0	83.0	58.3	6 38.22	41.26	12.0 EER 16.00 SEER	27.0	60.0	49.0	81.0%	460-3-60	13.0 MCA 15.0 MOCP	460-3-60	1.9 MCA 3.4 MOCP	0.5	1,540	120-1-60	2.2	NO	CURB: 347	ECONO/ PWR EXH: 17 1,135	78 MERV 13	R-410a	(1) (MD-1.1)	9 MD-1.1	1 2 4 5 6 7 8 11 12 13 16 2
AC 5	CARRIER 48GCGM04A2M6-3A2D0	103, 104, 116, 117, 118 & 119	900	1.0"	1,802	DIRECT	0.43 325	106.0	87.0	59.5	4 25.47	28.01	12.5 EER 16.00 SEER	27.0	60.0	49.0	81.0%	460-3-60	12.0 MCA 15.0 MOCP	460-3-60	1.9 MCA 3.4 MOCP	0.5	505	120-1-60	2.2	NO	CURB: 347	ECONO/ PWR EXH: 17 1,093	78 MERV 13	R-410a	(1) (MD-1.1)	9 MD-1.1	1 2 4 5 6 7 8 12 13 15 17 2
AC 6	CARRIER 48GCGM04A2M6-3A2D0	139, 140, 141, 142, 143, 144, 145 & 146	855	1.0"	1,783	DIRECT	0.41 150	106.0	79.0	56.0	20.06	25.53	12.5 EER 16.00 SEER	27.0	60.0	49.0	81.0%	460-3-60	12.0 MCA 15.0 MOCP	460-3-60	1.9 MCA 3.4 MOCP	0.5	855	120-1-60	2.2	NO	CURB: 347	ECONO/ PWR EXH: 17 1,093	78 MERV 13	R-410a	1 MD-1.1	9 MD-1.1	1 2 4 5 6 7 8 11 12 13 16 2
AC 7	CARRIER 48GCGM04A2M6-3A2D0	120 &121	965	1.0"	1,834	DIRECT	0.45 360	106.0	85.0	58.4	0 27.76	28.30	12.5 EER 16.10 SEER	27.0	60.0	49.0	81.0%	460-3-60	12.0 MCA 15.0 MOCP	460-3-60	1.9 MCA 3.4 MOCP	0.5	605	120-1-60	2.2	NO	UNIT: 568 CURB: 347 TOTAL:	PWR EXH: 17	78 MERV 13	R-410a	1 MD-1.1	9 MD-1.1	1 2 4 5 6 7 8 12 13 15 17 2
AC 8	CARRIER 48GCGM04A2M6-3A2D0	122 & 147	1,170	1.0"	1,938	DIRECT	0.53 N/A	106.0	75.0	57.9	5 20.04	27.24	12.5 EER 16.00 SEER	27.0	60.0	49.0	81.0%	460-3-60	12.0 MCA 15.0 MOCP	460-3-60	1.9 MCA 3.4 MOCP	0.5	1,170	120-1-60	2.2	NO		ECONO/ PWR EXH: 17 1,093	78 MERV 13	R-410a	(1) (MD-1.1)	9 MD-1.1	1 2 4 5 6 7 8 12 13 15 17 2
	METL MODULATING ECONOMIZ	ER AND MODULATING POW	VER EXHAUST.				DE AIR TEMPERA	TURE SENSOR	TO BE LOCATED AWA	Y FROM	9 DIRECT DRIVE-	ECOBLUE- MEDIL	IM STATIC MOTOR.	(1	3 RTU OPEN	N CONTROLS.					{ 17 FOR EM	IS DETAIL,	SEE MECHANIC	ICAL DRAWING 1/MD-3.2.									
2 VERTIC	AL DISCHARGE.			\frown			NECTIONS.			(10 2-SPEED FAN M	OTOR.		(1		STATIC BELT DRI		OLLER.	\sim	$\sqrt{2}$	·····	····	uu										
3 POWER	REXHAUST TO RECEIVE SEPAR	ATE POWER.					IPLIANT UNITS.				11 COMPLETE WIT	H VVT CONTROLI	ERS.	<i>(</i>)			BE TEMPERATURE SE	• • •		·													
4 MICRO	METL 21" TALL VIBRATION ISOL/	ATION CURB					TORY-INSTALLE				12 COMPLETE WIT	H LOUVERED HAI	L GUARDS.	<u>}</u> (1	6)FOR EMS	DETAIL, SEE ME	CHANICAL DRAWING	2/MD-3.1.		\mathbf{z}													

	MANUFACTURER	AREA					FAN	N SYSTEM	Л			OPER. WT. W/	ANCHORAGE	REMARKS
TAG	& MODEL NO.	SERVED	TYPE	CFM	ESP	RPM	HP	WATTS	TIP SPEED	V-PH-HZ	SONES	ACCESSORIES (LBS)	DETAIL REFERENCE	(SEE EQUIPMENT NOTES BELOW)
EF 1	COOK 80 ACEB	MEN RESTROOM 118 CUST. 119	ROOF MOUNTED DOWN BLAST	395	0.400	1,322	.167	-	3,460	120-1-60	3.3	42	6 MD-1.1	12358
EF 3	COOK 101C10D	WOMEN RESTROOM 120	ROOF MOUNTED DOWN BLAST	360	0.250	996	0.40	-	2,607	120-1-60	3.7	52	6 MD-1.1	123 8
EF 4	COOK GC-168	UNISEX RESTROOM 115	CEILING MOUNTED	135	0.125	940	0.013	46	1,877	120-1-60	2.0	14	3 MD-1.1	1345678
EF 5	COOK GC-186	UNISEX RESTROOM 139	CEILING MOUNTED	150	0.125	760	0.013	63	1,518	120-1-60	2.5	15	3 MD-1.1	1345678
EF 6	COOK 70C15DH	STORAGE 146	ROOF MOUNTED DOWN BLAST	100	0.250	1,550			2,580			48	6 MD-1.1	12358
2 COMI 3 COMI	PLETE WITH BACKDRAFT DAMPER PLETE WITH SLOPED-TYPE ROOF PLETE WITH BIRD SCREEN. PLETE WITH FAN SPEED CONTROI	CURB. 6 COMPLETE WITH CEILIN ROOF VENTILATOR SCH) Hours. Ig cap by fan Manl Iedule.						., SEE MECHANICAL		2.}2			

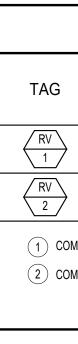

PROJECT	No.	:1-78-28
4/23/2021 11:15	5:28 AM	1

DRAWN BY: CHECKED BY: ISSUE No. DATE DESCRIPTION ISSUE No. DATE DESCRIPTION ISSUE No. DATE DESCRIPTION ISSUE No. DATE DESCRIPTION ISSUE No. DATE DESCRIPTION

 REVISION No.2
 DATE 04-23-202 ESCRIPTION ADDENDUM 2

 REVISION No.
 DATE
 DESCRIPTION

 REVISION No.
 DATE
 DESCRIPTION

 REVISION No.
 DATE
 DESCRIPTION

EXHAUST FAN SCHEDULE

F	RELIE	F ROOI	= VENT	TILATOR SC	CHEDULE	
MANUFACTURER & MODEL NO.	UNIT SERVED	CFM	ESP. (INCHES)	OPER. WT. W/ ACCESSORIES (LBS)	ANCHORAGE DETAIL REFERENCE	REMARKS (SEE EQUIPMENT NOTES BELOW)
COOK 8 PR	EF 4	135	0.05"	34	2 MD-1.1	(1)(2)
COOK 8 PR	EF 5	150	0.05"	34	2 MD-1.1	(1)2)

(1) COMPLETE WITH SLOPED-TYPE ROOF CURB.

2 COMPLETE WITH BIRD SCREEN.

				DAMPER DA	ГА	REMARKS		
TAG	UNIT SERVED	MAX. CFM	MAKE	MODEL	INLET SIZE	(SEE EQUIPMENT NOTES BELOW)		
BD 1-1	AC 1	1,830	CARRIER	35JN14	14"	$\left\{ \begin{array}{c} 1 \end{array} \right\}$		
BD 3-1	AC 3	805	CARRIER	35JN10	10"	$\left\{ \begin{array}{c} 1 \end{array} \right\}$		
BD 4-1	AC 4	1,175	CARRIER	35JN10	10"	{ 1 }		
BD 6-1	AC 6	705	CARRIER	35JN10	10"			


			AMPER S		DAMPER DATA						
TAG	AREA SERVED	MIN. CFM	MAX. CFM	MAKE	MODEL	INLET SIZE	REMARKS (SEE EQUIPME NOTES BELO				
\C-1			1	1	1	1	1				
ZD 1-1	PRINCIPAL 107	95	315	CARRIER	35JN08	8"	$\left \begin{array}{c} \\ \\ \\ \\ \\ \\ \\ \\ \\ \\ \\ \\ \\ \\ \\ \\ \\ \\ \\$				
ZD 1-2	ASSISTANT PRINCIPAL 110	55	180	CARRIER	35JN06	6"	$\left\{ 23 \right\}$				
ZD 1-3	ASSISTANT PRINCIPAL 108	50	165	CARRIER	35JN06	6"	{23}				
ZD 1-4	ASSISTANT PRINCIPAL 109	50	170	CARRIER	35JN06	6"	{23}				
ZD 1-5	CONFERENCE ROOM 106	185	610	CARRIER	35JN10	10"					
ZD 1-6	HALLWAY 105, PRINCIPAL SECRETARY 111 & SECRETARY 112	170	565	CARRIER	35JN10	10"	£3¥				
ZD 1-7	COPY 113, OFFICE STORAGE 114 & UNISEX RESTROOM 115	60	195	CARRIER	35JN06	6"	23}				
<u>C-3</u>						1					
ZD 3-1	ASB OFFICE 125	45	150	CARRIER	35JN06	6"	$\left\{ 23\right\}$				
ZD 3-2	ITINERANT 126	45	140	CARRIER	35JN06	6"	$\left\{ 23 \right\}$				
ZD 3-3	COUNSELING 127	45	140	CARRIER	35JN06	6"	$\left\{ 23 \right\}$				
ZD 3-4	NURSE 137	45	150	CARRIER	35JN06	6"	$\left\{ 23\right\}$				
ZD 3-5	HEALTH 136 & SECURE STORAGE/EXAM 138	70	235	CARRIER	35JN06	6"	{23}				
ZD 3-6	COUNSELING 135	45	140	CARRIER	35JN06	6"	$\left\{ 23 \right\}$				
<u>C-4</u>				1	1	1					
ZD 4-1	DEAN OFFICE 128	50	170	CARRIER	35JN06	6"	$\left\{ 23\right\}$				
ZD 4-2	COUNSELING 129	40	135	CARRIER	35JN06	6"	23				
ZD 4-3	COUNSELING 134	40	135	CARRIER	35JN06	6"	23				
ZD 4-4	COUNSELING 132	40	135	CARRIER	35JN06	6"					
ZD 4-5	PSYCHOLOGIST 133	65	210	CARRIER	35JN06	6"					
ZD 4-6	WAITING AREA 124 & HALLWAY 123	99	325	CARRIER	35JN08	8"					
ZD 4-7	CONFERENCE ROOM 131	90	300	CARRIER	35JN08	8"	13				
ZD 4-8	CONFERENCE ROOM 130	90	300	CARRIER	35JN08	8"					
C -6			1	1	1	1					
ZD 6-1	HOLDING 2 145 & RESOURCE OFFICER 143	75	245	CARRIER	35JN08	8"	23				
ZD 6-2	ATLAS 140 & CHANGING ROOM/SHOWER 141	60	195	CARRIER	35JN06	6"	$\left\{ 23 \right\}$				
ZD 6-3	SECURITY 142	60	200	CARRIER	35JN06	6"					
ZD 6-4	HOLDING 1 144 & UNISEX RESTROOM 139	65	215	CARRIER	35JN06	6"					
		RATURE/CO2 SENSOR. SEE				1					

STOPROFESSION STOPROFESSION STOPP	SF EN ON NEW O
STAMPS	



CONSULTANT BRANDING



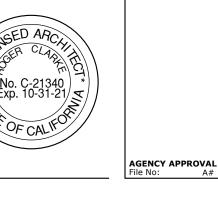





U




1-78-28

20-178 __

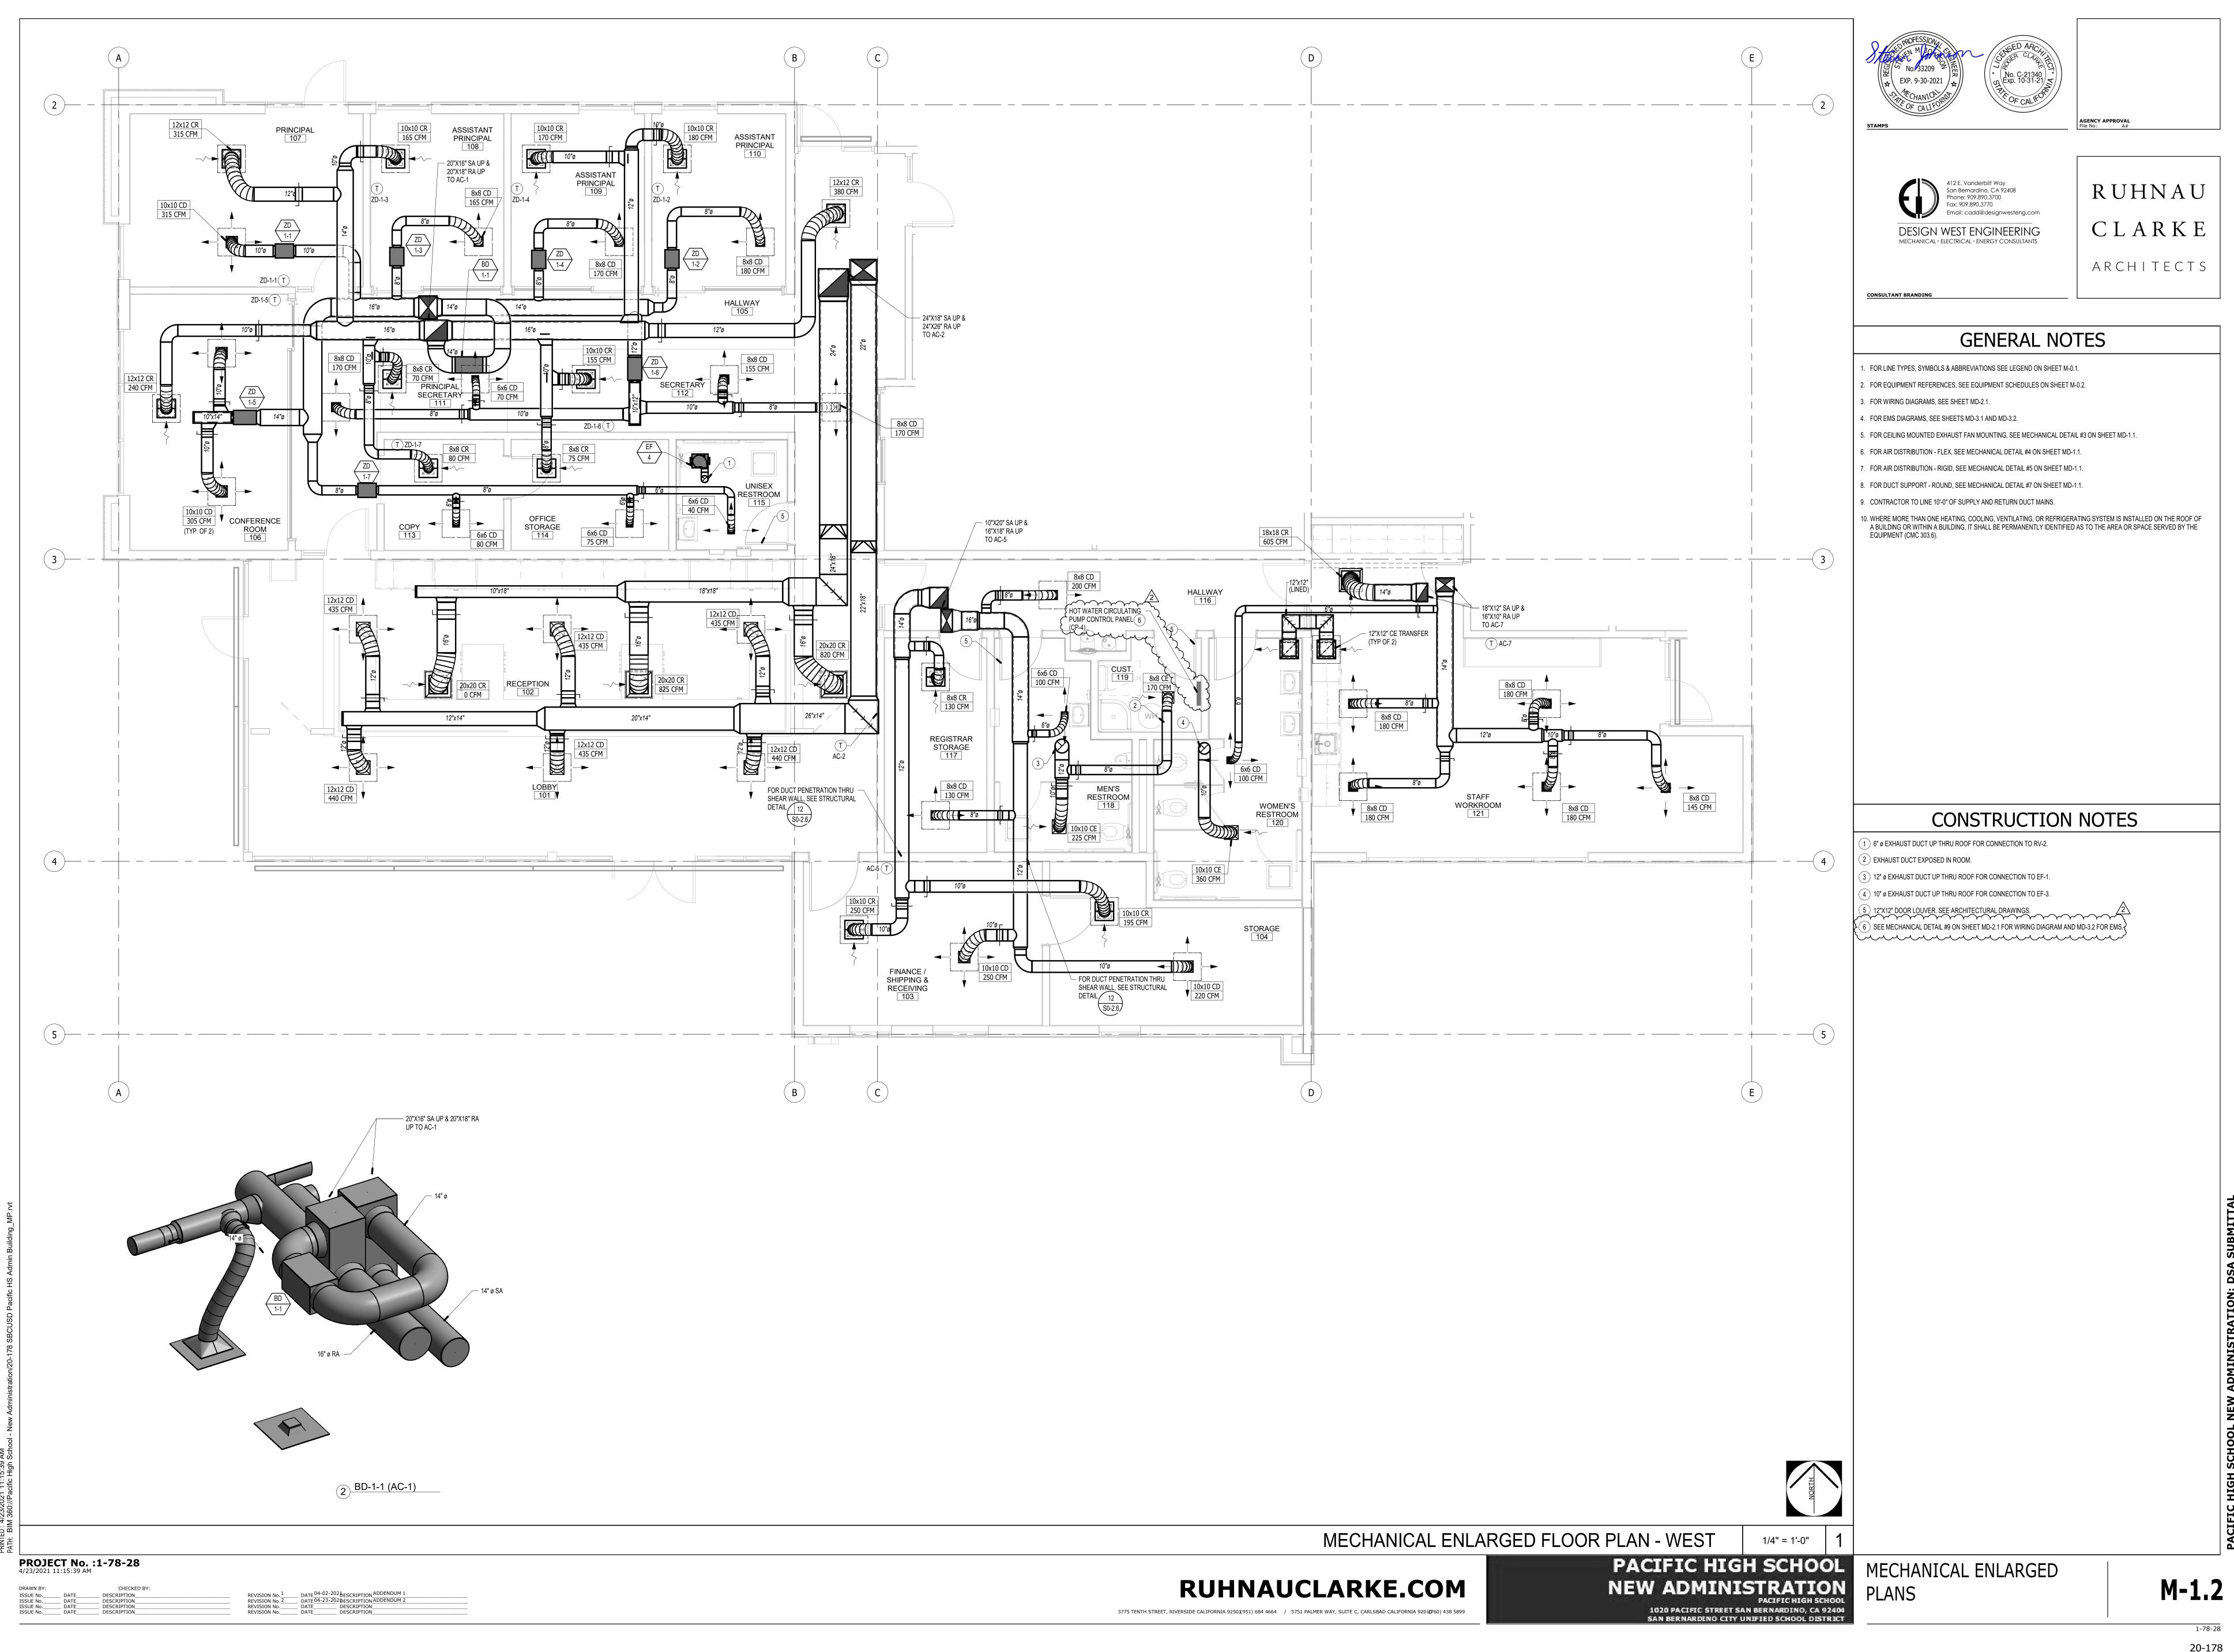


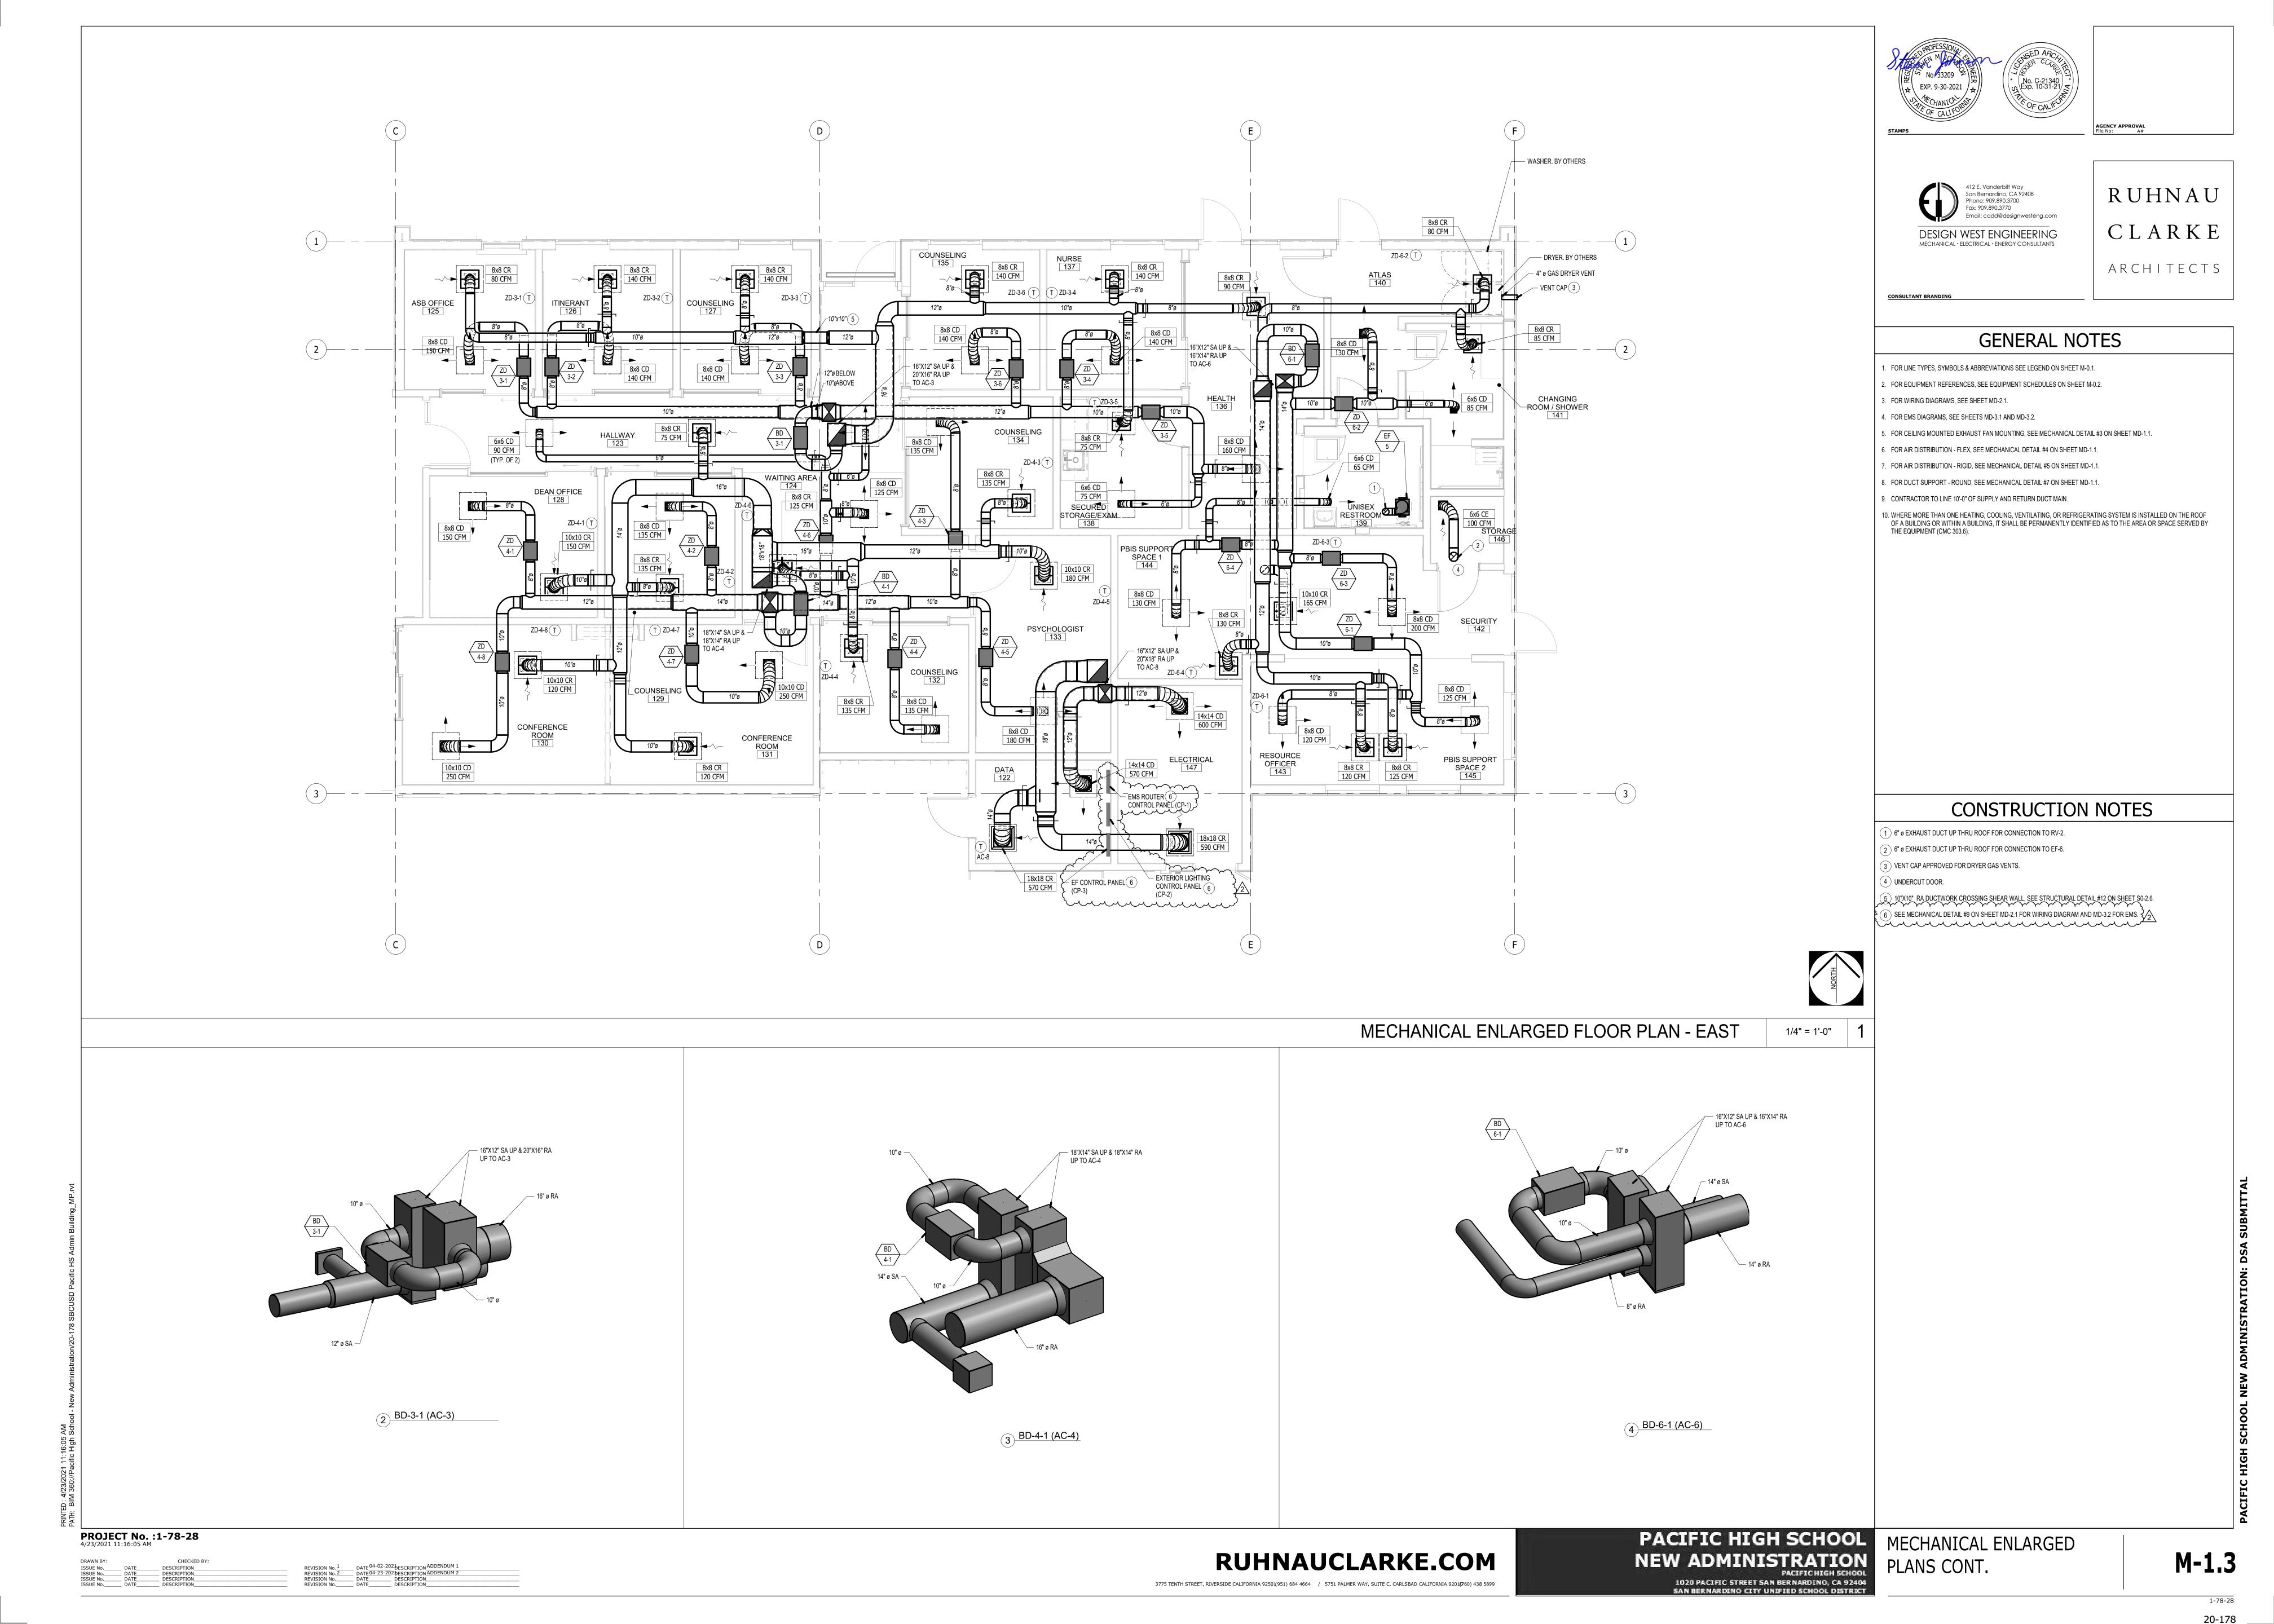

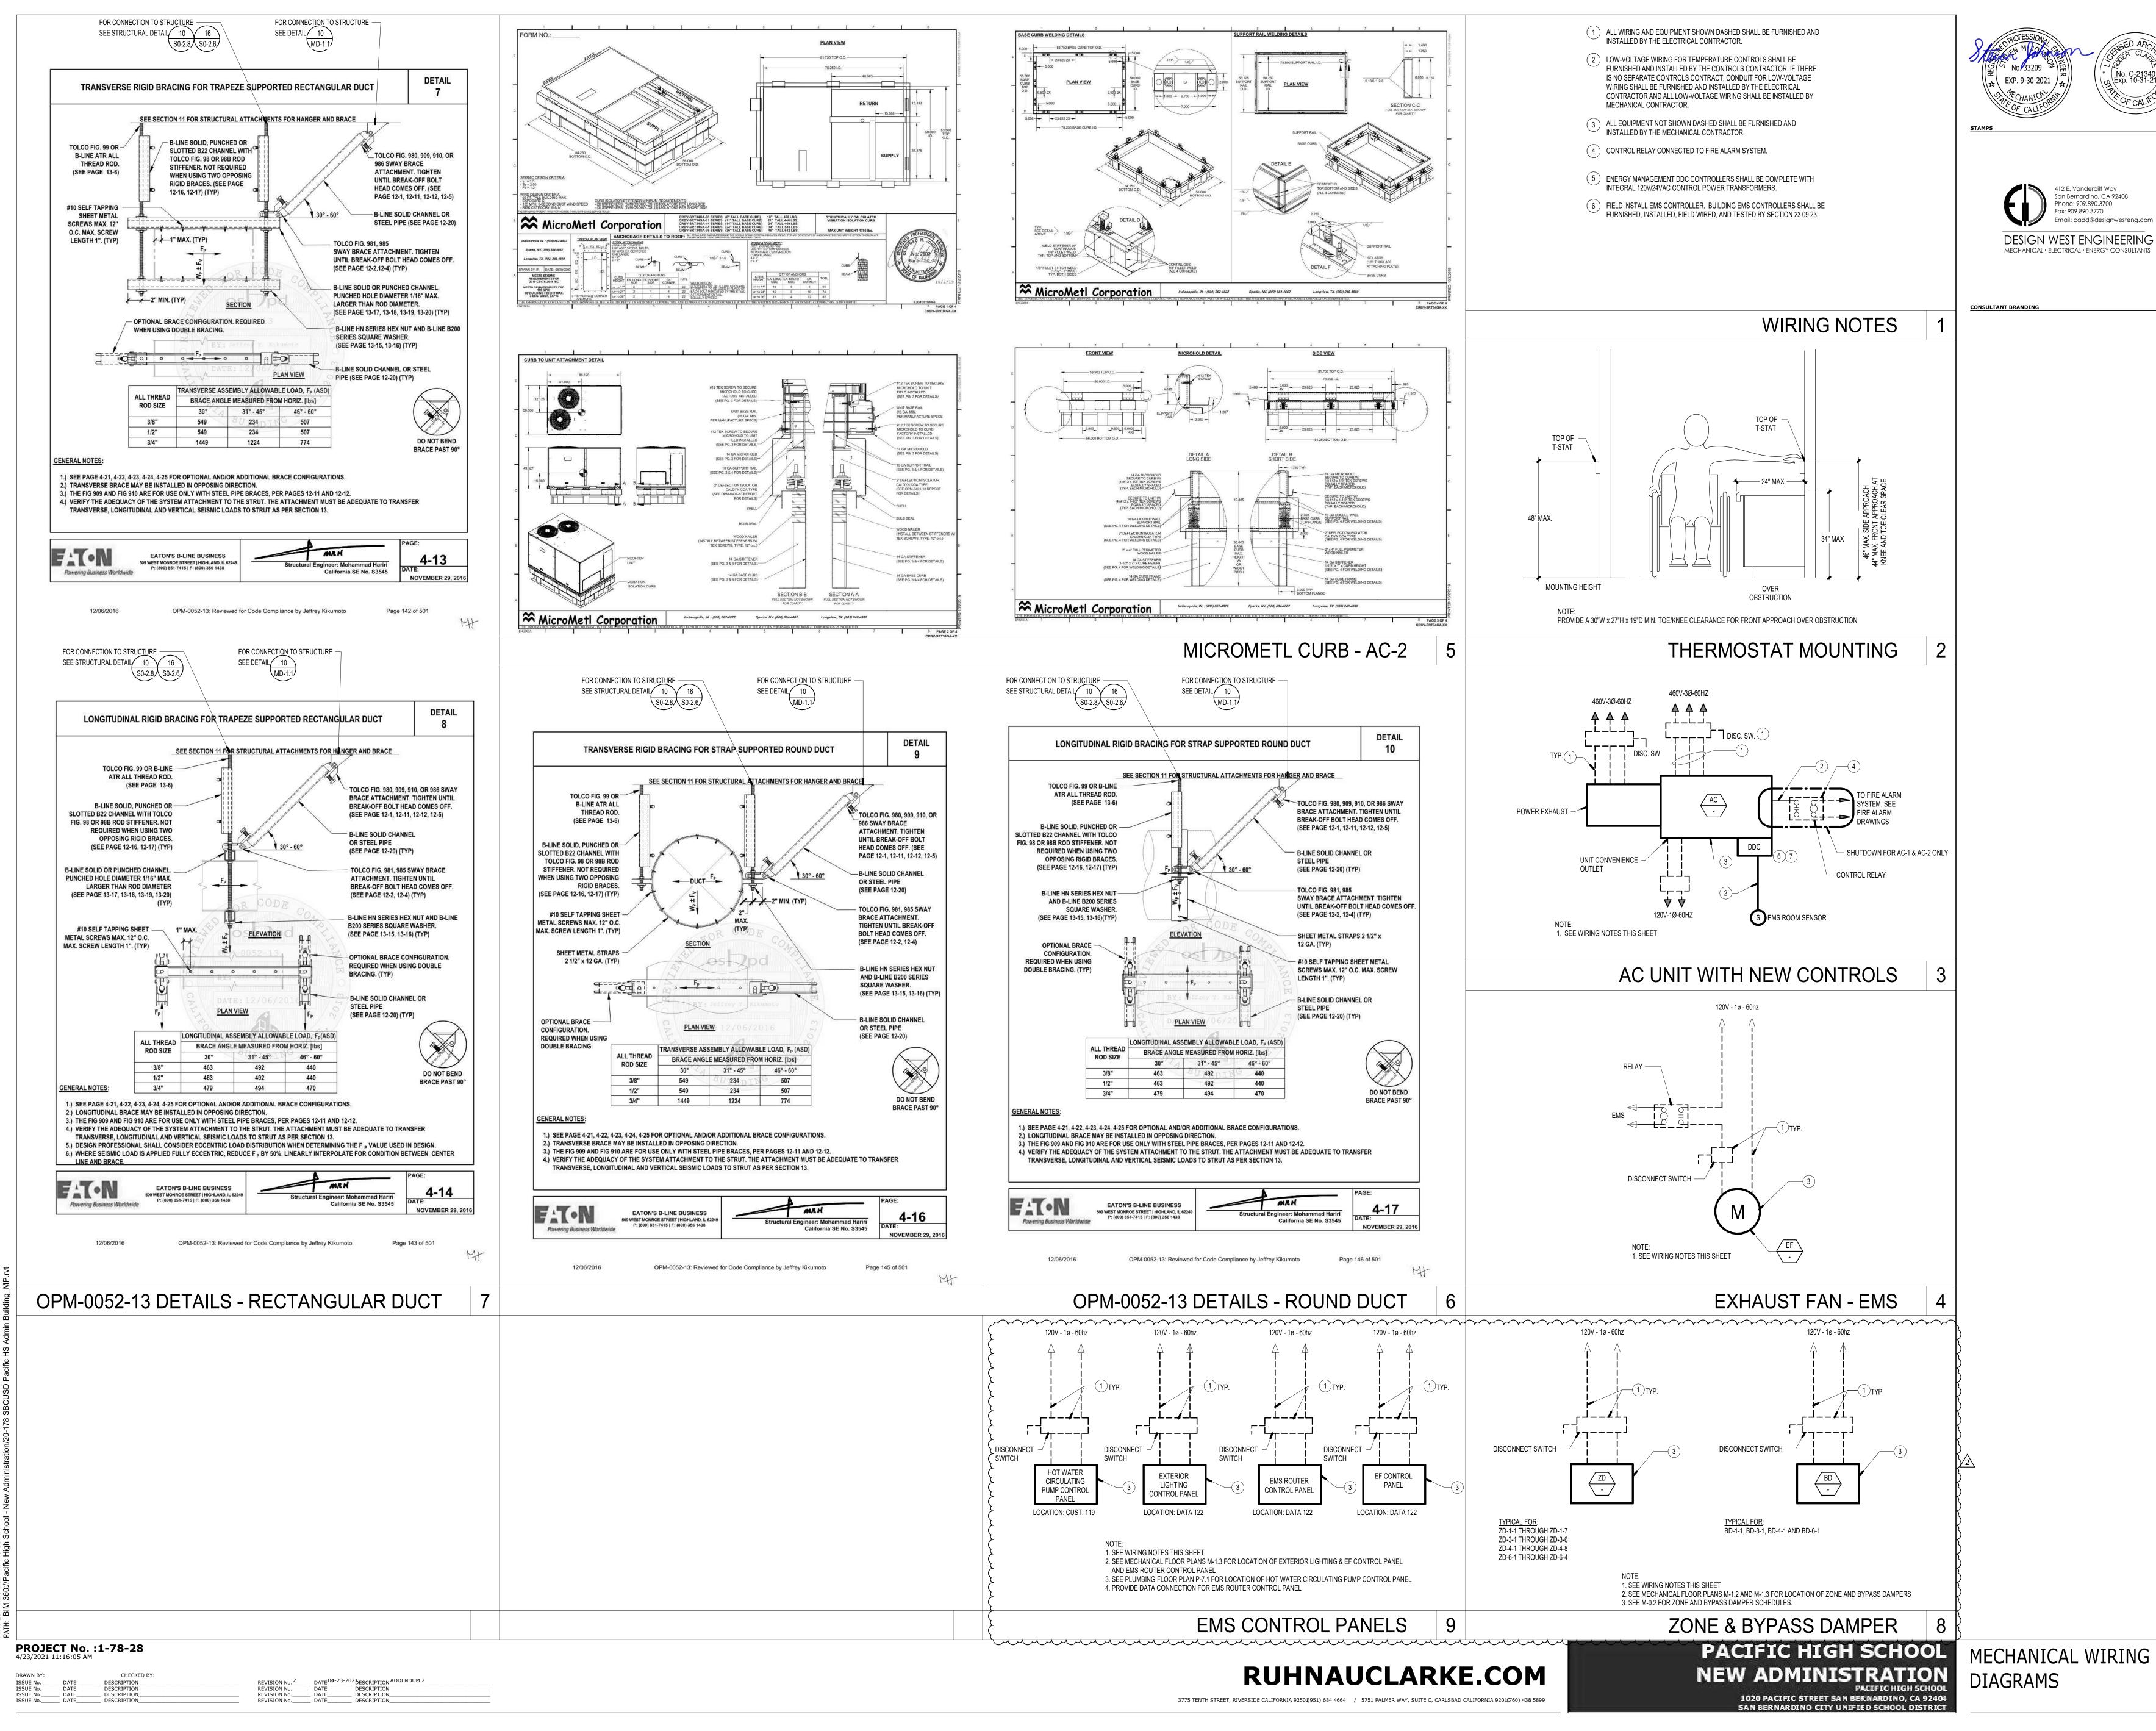




GENCY APPRO

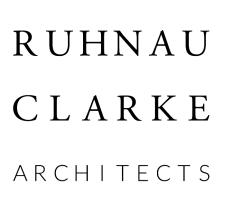






	SEQUENCES OF OPERATION:
	UNOCCUPIED MODE THE UNIT WILL MAINTAIN AN UNOCCUPIED COOLING SETPONT OF 95°F AND AN UNOCCUPIED HEATING SETPOINT OF 45°F. DURING THE UNOCCUPIED TIME, EACH PRESS OF THE OVERRIDE BUTTON LOCATED (
	OCCUPIED MODE THE UNIT WILL MAINTAIN AN OCCUPIED COOLING SETPONT OF 74°F AND AN OCCUPIED HEATING SETPOINT OF 68°F.
	INDOOR FAN DURING OCCUPIED PERIODS, THE FAN SHALL OPERATE CONTINUOUSLY. DURING UNOCCUPIED PERIODS, THE FAN SHALL OPERATE WHEN THE SPACE TEMPERATURE EXCEEDS THE UNOCCUPIED HEATING OI SETPOINTS. THE FAN OPERATES AT A VARIABLE SPEED TO MEET THE LOAD CONDITIONS AND SAT SAFETY REQUIREMENTS TO PROVIDE MAXIMUM ENERGY SAVINGS BY MINIMIZING FAN HORSEPOWER CONSU FAN SPEED IS NOT CONTROLLED TO MAINTAIN DUCT STATIC PRESSURE.
	HEATING MODE WHEN SPACE TEMPERATURE IS BELOW THE OCCUPIED HEATING SETPOINT OF 68°F, UNIT SHALL OPERATE IN THE HEATING MODE. UNIT SHALL STAGE AVAILABLE HEAT STAGES TO SATISFY DEMAND IN THE O SPACE. EACH STAGE OF HEATING HAS A FIXED 1 MINUTE MINIMUM ON-TIME, AND 1 MINUTE OFF TIME.
	COOLING MODE WHEN SPACE TEMPERATURE IS ABOVE OCCUPIED COOLING SETPOINT OF 74°F, UNIT SHALL OPERATE IN THE COOLING MODE. UNIT SHALL ENABLE AVAILABLE MECHANICAL COOLING STAGES TO SATISFY DEI THE OCCUPIED SPACE. EACH COMPRESSOR OUTPUT HAS A FIXED 3 MINUTE MANIMUM ON-TIME, AND 5 MINUTE OFF TIME.
	ECONOMIZER ECONOMIZER SHALL CLOSE WHEN FAN IS OFF OR DURING A LOSS OF POWER. DURING OCCUPIED HOURS WHEN FAN IS ENERGIZED IN LOW SPEED THE ECONOMIZER SHALL OPEN TO ITS LOW FAN MINIMUM OF 33% (ADJ.). WHEN THE FAN IS RUNNING IN HIGH SPEED THE ECONOMIZER SHALL RESET TO ITS HIGH SPEED MINIMUM POSITION OF 20% (ADJ.). DAMPER MINIMUM POSITIONS TO BE DETERMINED BY AIR BA
	WHEN OUTSIDE AIR TEMPERATURE IS BELOW THE HIGH LIMIT OF 75°F (ADJ.), BELOW SPACE TEMPERATURE, AND OCCUPIED SPACE REQUIRES COOLING, ECONOMIZER SHALL OPEN. IF ECONOMIZER AIR IS NO SUFFICIENT TO MEET THE DEMAND IN THE OCCUPIED SPACE, UNIT SHALL ENABLE AVAILABLE COOLING STAGES TO SATISFY DEMAND IN THE OCCUPIED SPACE. IF ENTHALPY STATUS IS HIGH, THE ECONOMIZ DISABLED AND THE OUTSIDE AIR DAMPER GOES TO ITS MINIMUM POSITION. AN ENTHALPY STATUS THAT IS LOW ENABLES THE ECONOMIZER IF THERE IS A CALL FOR COOLING. THE FOLLOWING FAULT DETECTION AND DIAGNOSTIC (FDD) ALARMS SHALL BE SENT THROUGH THE I-VU SERVER. A. AIR TEMPERATURE SENSOR FAILURE B. FAILS TO CLOSE C. FAILS TO CLOSE C. FAILS TO OPEN D. STUCK FULLY OPEN E. FAILS TO FULLY OPEN
	POWER EXHAUST THE EXHAUST FAN SHALL BE ENABLED ANYTIME THE SUPPLY FAN IS RUNNING. THE POWER EXHAUST VFD WILL MODULATE BASED ON ITS OWN CONTROLS TO MAINTAIN THE ROOM PRESSURE SETPOINT (AS DETERMINED BY AIR BALANCER). PRESSURE SETPOINT AND VFD SPEED NOT CONTROLLED THROUGH EMS.
	CONTROLS PROVIDED AND INSTALLED BY RUSSEL SIGLER INC CONTROLS GROUP
	VVT ROOFTOP UNIT DETAIL (AC-1, AC-3, AC-4 & AC-6)
ROJECT No	. :1-78-28
23/2021 11:16:06 / AWN BY: SUE No DATE SUE No DATE	CHECKED BY: DESCRIPTION

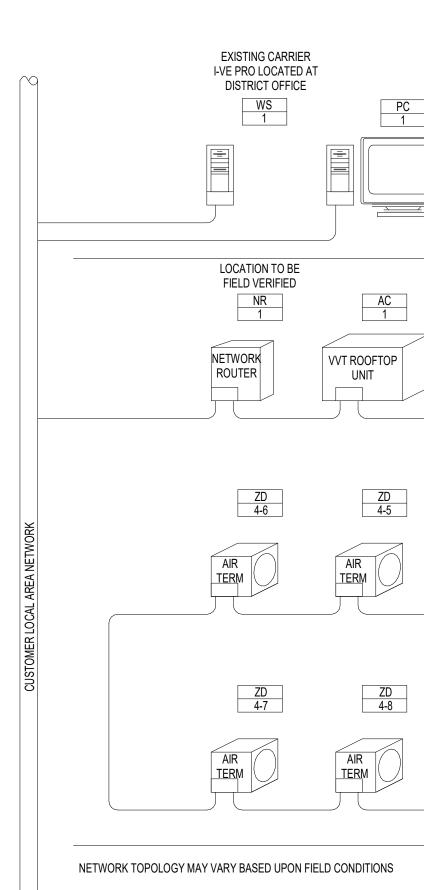

RUHNAUCLARKE.COM

VVT BYPASS DAMPER DETAIL (BD-1, BD-3, BD-4 & BD-6)

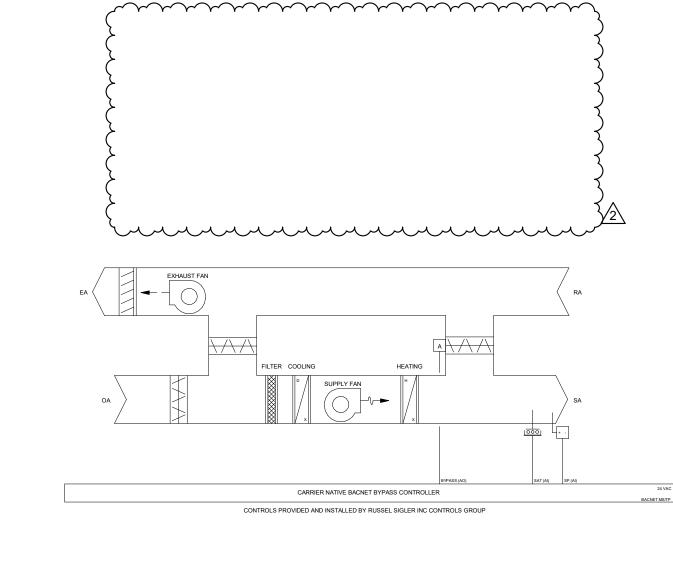

VVT BYPASS DAMPER WHILE THE INDOOR FAN RUNS, THE BYPASS SHALL MODULATE TO MAINTAIN DUCT PRESSURE AT A CONFIGURABLE SETPOINT. IF THE STATIC PRESSURE IS BELOW THE STATIC PRESSURE SETPOINT THE BYPASS DAMPER WILL MODULATE CLOSE TO BUILD DUCT STATIC PRESSURE UNTIL THE STATIC PRESSURE IS AT SETPOINT. IF THE STATIC PRESSURE IS ABOVE

THE STATIC PRESSURE SETPOINT THE BYPASS DAMPER WILL MODULATE OPEN TO RELIEVE DUCT STATIC PRESSURE UNTIL

SEQUENCES OF OPERATION:

THE STATIC PRESSURE IS AT SETPOINT.

EACH 2000 FOOT SEGMENT SHALL BE JOINED TO THE NEXT SEGMENT USING A BACNET LOCAL AREA NETWORK REPEATER WITH APPROPRIATE TERMINATION. NO MORE THAN 4 REPEATERS CAN BE ANY PC OR INTERNET DEVICE WITH USED ON A SINGLE BACNET MSTP NETWORK. EACH SEGMEN WILL HAVE TERMINATION STANDARD WEB BROWSER - - - - - - - -AT THE BEGINNING AND END OF THE SEGMENT. SOFTWARE AND LAN ACCESS, SUPPLED BY OTHERS ZD 1-5 ZD 1-6 ZD 1-7 ZD 1-1 ZD 1-2 ZD 1-3 AC 2 BD 1-1 ZD 1-4 AIR TERM SAV ROOFTOP UNIT AIR TERM BYPASS DAMPER AIR TERM AIR TERM AIR / AIR AIR TERM TERM RP 1 AC 4 ZD 3-6 ZD 3-5 ZD 4-4 ZD 4-3 ZD 4-2 ZD 4-1 BD 4-1 AIR TERM REPEATER PANEL BYPASS DAMPER VVT ROOFTOP UNIT AIR TERM AIR TERM AIR AIR / AIR / TERM TERM TERM 485 485 vvv AC 8 ZD 6-4 ZD 6-2 ZD 6-3 AC 7 BD 6-1 AC 5 AC 6 SAV ROOFTOP VVT ROOFTOP SAV ROOFTOP SAV ROOFTOP AIR BYPASS DAMPER AIR TERM AIR AIR / UNIT UNIT UNIT UNIT TERM TERM

BACNET MSTP NETWORK GUIDELINES:

A MSTP NETWORK SHALL NOT EXCEED 10,000 FEET OVERALL LENGTH, CONSISTION OF


UP TO FIVE 2000 FOOT SEGMENTS WITH NO GREATER THAN 30 DEVICES PER SEGMENT

WIRE LEGEND

PART NUMBER | DESCRIPTION

WIRE TYPE

LINE STYLE

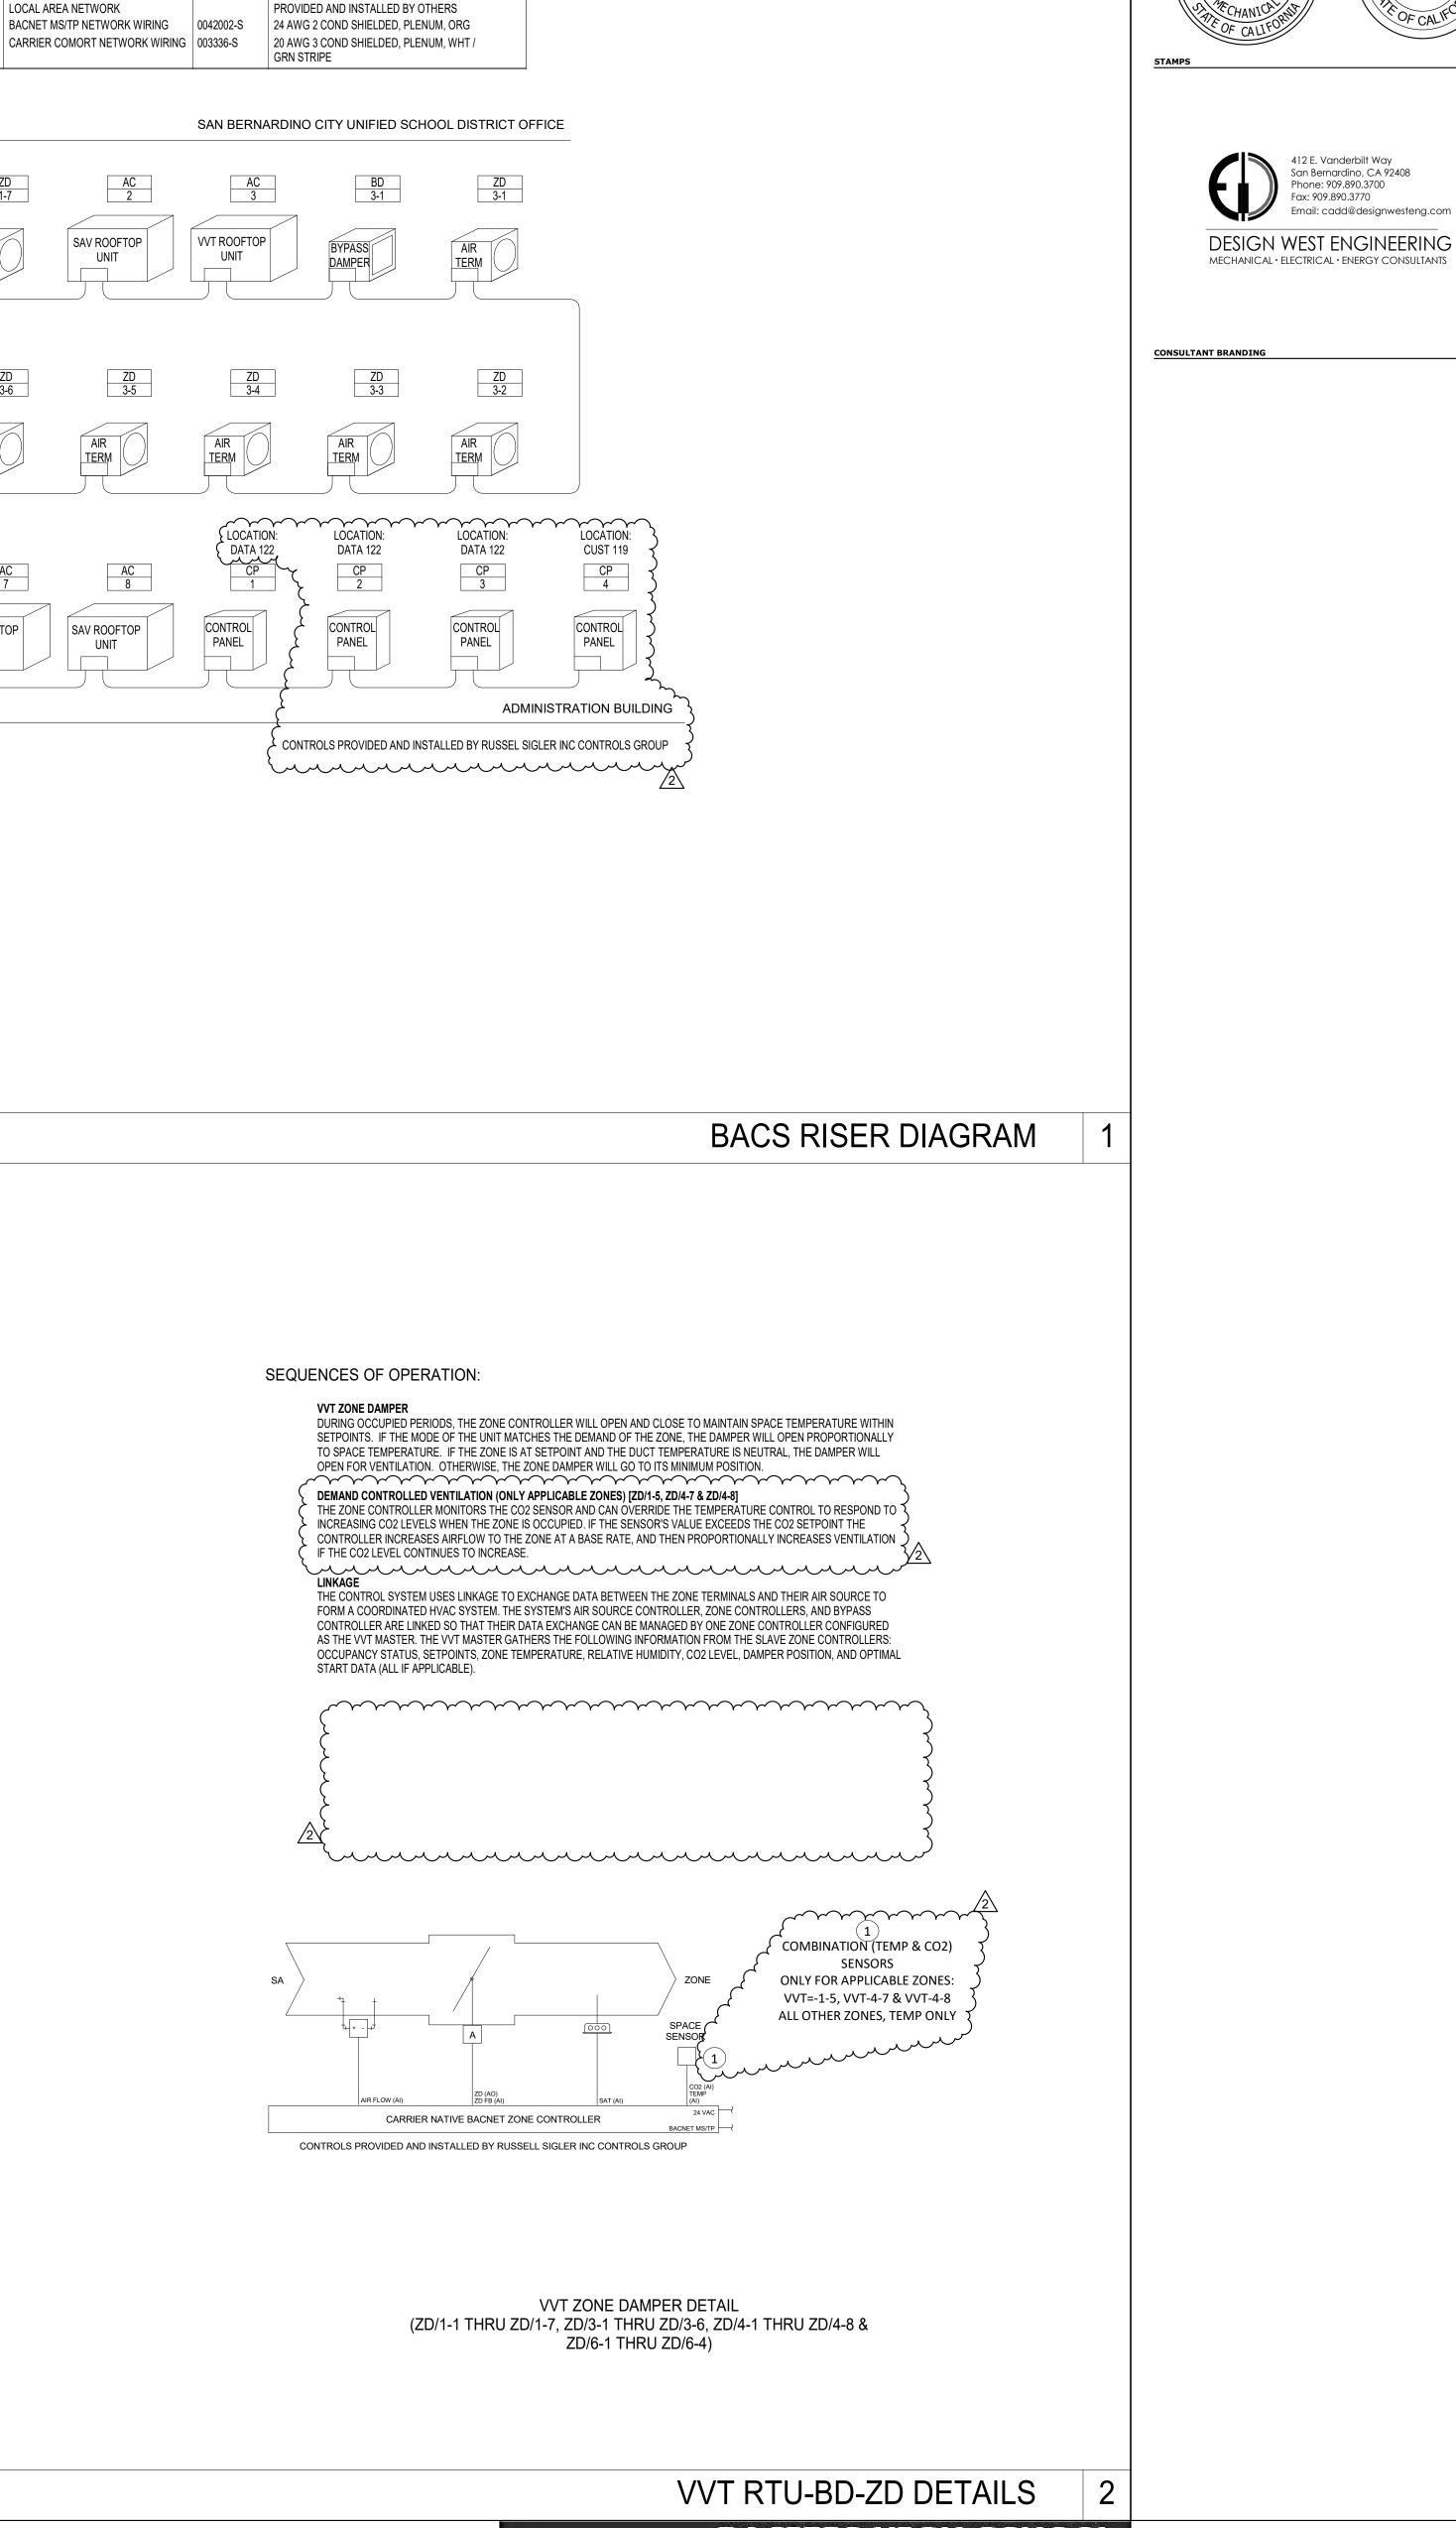

3775 TENTH STREET, RIVERSIDE CALIFORNIA 92501(951) 684 4664 / 5751 PALMER WAY, SUITE C, CARLSBAD CALIFORNIA 9201(0/60) 438 5899

PACIFIC HIGH SCHOOL EMS DRAWINGS NEW ADMINISTRATION

1020 PACIFIC STREET SAN BERNARDINO, CA 92404

SAN BERNARDING CITY UNIFIED SCHOOL DISTRICT


PACIFIC HIGH SCHOOL



EXP. 9-30-2021


Email: cadd@designwesteng.com

GENCY APPROVA

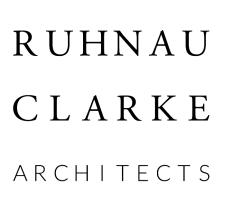

MD-3.1

1-78-28

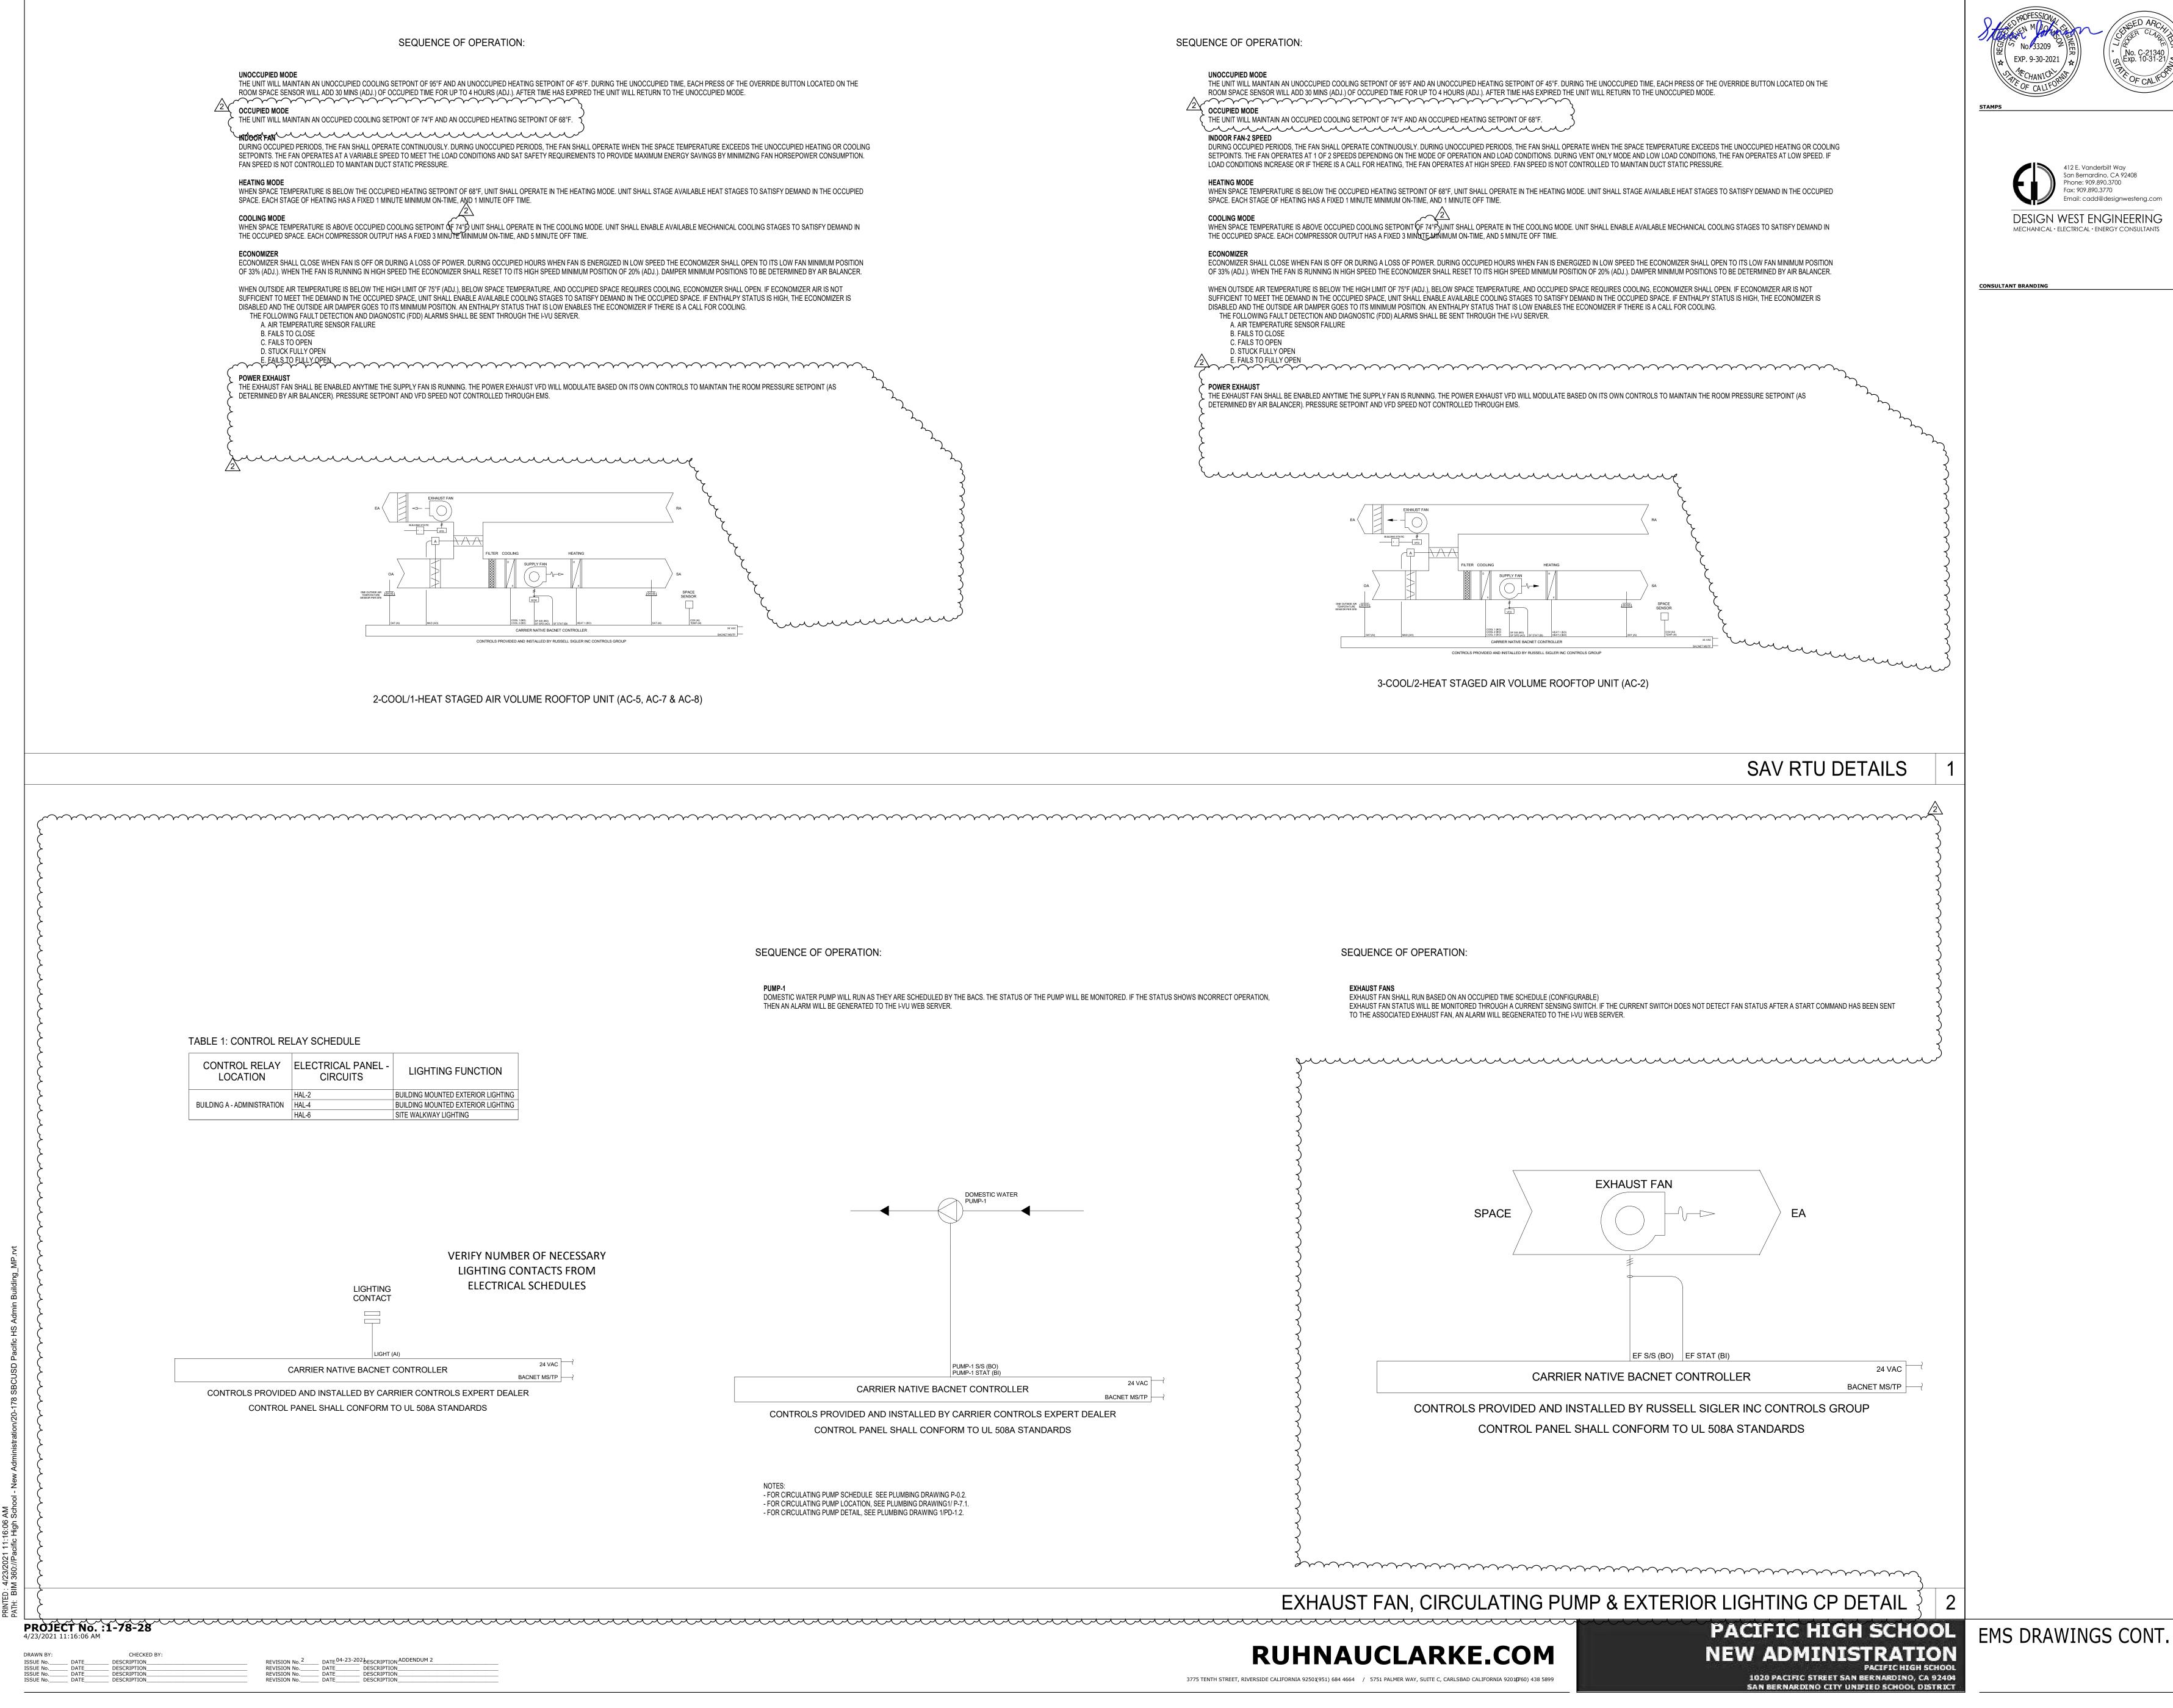



SENCY APPROV







1-78-28

PROJECT	No.	:1-78-28
4/23/2021 11:11		

DRAWN BY:		CHECKED BY:	
ISSUE No	DATE	DESCRIPTION	
ISSUE No.	DATE	DESCRIPTION	
ISSUE No.	DATE	DESCRIPTION	
ISSUE No.	DATE	DESCRIPTION	

 REVISION No.2
 DATE
 Description

 REVISION No.
 DATE
 DESCRIPTION

 REVISION No.
 DATE
 DESCRIPTION


 REVISION No.
 DATE
 DESCRIPTION

 REVISION No.
 DATE
 DESCRIPTION

				ELECTRI		\TE Ι	R HE/	ATEF	R SC	HEDU	JLE					PLUMBING FIXT	JRE S	CHE	DULE			
TAG	MANUF.		N GAL	RECOVERY		EL	ECTRICAL	-		OPERATIN WEIGHT	G ANCHO		DEM	ARKS	TAG	SPECIFICATION		CON	NECTION	SIZE:		
IAG	& MODEL NO	O.	GAL	RECOVERT	FLA	WATTS	VOLTAGE	PHASE	HZ	(LBS)	REFERI			AINO			WASTE	TRAP	VENT	CW RISER	HW RISER	ELEC.
	AO SMITH DSE-30A	CUST. 119		41 GPH @ 60° TEMP RISE	28.8	6,000	208	1	60	468	PD-1	1.2	(1)	WC 1	WATERCLOSET: (ADA) AMERICAN STANDARD "MADERA" 3043.001, 16-1/2" HIGH RIM, (1.28 GPF), FLOOR MOUNTED, ELONGATED BOWL, SIPHON JET, 1-1/2" TOP SPUD, WHITE VITREOUS CHINA. SLOAN WES 111-1.6/1.1, (1.6/1.1 GPF), MANUAL REDUCE AND DUAL FLUSH, POLISHED CHROME FINISH, INCLUDES ANGLE STOP WITH BACK-FLOW PROTECTION. BEMIS PLASTIC SEAT MODEL 2L2155T, ELONGATED, OPEN FRONT, STAIN & CHEMICAL RESISTANT.	3"	INT.	2"	1"	-	-
					PANSI	ON	TANK	(SCł	HED	ULE					WC 2	WATERCLOSET: (STANDARD) AMERICAN STANDARD "MADERA" 3451.001, 1 HIGH RIM, (1.28 GPF), FLOOR MOUNTED, ELONGATED BOWL, SIPHON JET, 1-1/2" TOP SPUD, WHITE VITREOUS CHINA. SLOAN WES 111-1.6/1.1, (1.6/1.1 GPF), MANUAL REDUCE AND DUAL FLUSH, POLISHED CHROME FINISH, INCLUDES ANGLE STOP WITH BACK-FLOW PROTECTION. BEMIS PLASTIC SEAT MODEL 2L2155T, ELONGATED, OPEN FRONT, STAIN & CHEMICAL RESISTANT.	5" 3"	INT.	2"	1"	-	-
TAG	SYSTE		ACTURER DEL NO.		PACITY M GAL)	IAX PRE (PSI)	ESS. MAX) ((TEMP °F)	OPERA WEIC (LB	GHT	ICHORAGE DETAIL EFERENCE		REMAR	KS		URINAL: (ADA) AMERICAN STANDARD "WASHBROOK" 6590.001, 17" HIGH RIM, VITREOUS CHINA, WALL HUNG, WALL BRACKET WITH ANCHORS INCLUDED, 3/4" TOP SPUD. SLOAN ROYAL 186-0.125-DBP, (0.125 GPF), MANUAL SINGLE FLUSH, POLISHED CHROME FINISH, DUAL-FILTERED BYPASS.	2"	INT.	1-1/2"	1"	-	-
			MTROL ST-5C ENT AND WATER (2.1	250		200	25	5	1 PD-1.2		(1)			LAVATORY: AMERICAN STANDARD "LUCERNE" 0355.012, WALL MOUNTED, WHITE VITREOUS CHINA, 4" CENTERS, FRONT OVERFLOW, SELF-DRAINING DECK, CONCEALED ARM SUPPORT. CHICAGO FAUCETS MODEL 802- VE66ABCP, DECK MOUNTED MANUAL FAUCET, 4" CENTERS, ECONO-FLO NON-AERATING 0.5 GPM. <u>PROVIDE ASSE 1070 APPROVED TMV SET TO 115</u> ON ADA COMPLIANT PROVIDE TRUEBRO LAV GUARD PER ADA CODE 4.19 1/4 TURN 1/2" LOOSE KEY ANGLE STOPS W/ 1/2" O.D. BRASS FLEXIBLE SUPPLIES AND BRASS WALL SCUTCHEONS.	2"	1-1/2"	1-1/2"	1/2"	1/2"	-
TA			IUFACTURE MODEL NO		ULAT CAPAC		CONSTRI		MOT (HF	•••	.ECTRICAL PS V-P-HZ	WEIGH (LBS		REMARKS	S 1	SINK: (KITCHEN) ELKAY LUSTERTONE MODEL LRAD191865PD, STAINLESS STEEL, DROP-IN MOUNT, 6-1/2" DEPTH, SINGLE COMPARTMENT, SINGLE HOLE, PERFECT DRAIN AT REAR CENTER. CHICAGO FAUCET MODEL 50- TE35ABCP WITH 1.5 GPM PRESSURE COMPENDATING AERATOR, SINGLE HOLE, 5-1/4" RIGID SWING NECK. <u>PROVIDE ASSE 1070 APPROVED TMV SET</u> <u>TO 115°.</u> ON ADA COMPLIANT PROVIDE TRUEBRO LAV GUARD PER ADA CODE 4.19.4. 1/4 TURN 1/2" LOOSE KEY ANGLE STOPS W/ 1/2" O.D. BRASS FLEXIBLE SUPPLIES AND BRASS WALL SCUTCHEONS.	2"	1-1/2"	1-1/2"	1/2"	1/2"	-
	$\overline{\overline{}}$	MH 1 MS DETAIL, SEE MECH			5 GPM @ 10	' TDH	ALL BRO	NZE	1/25	5 0.84	4 120V-1ø-60⊦	Hz 8	(1) PD-1.2)		S 2	SINK: (HEALTH) ELKAY LUSTERTONE MODEL LRAD191865PD, STAINLESS STEEL, DROP-IN MOUNT, 6-1/2" DEPTH, SINGLE COMPARTMENT, SINGLE HOLE, PERFECT DRAIN AT REAR CENTER. CHICAGO FAUCET MODEL 50- E2805-5ABCP WITH 0.5 GPM AERATOR, SINGLE HOLE, 5-1/4" RIGID SWING NECK. <u>PROVIDE ASSE 1070 APPROVED TMV SET TO 120°.</u> ON ADA COMPLIANT PROVIDE TRUEBRO LAV GUARD PER ADA CODE 4.19.4. 1/4 TURN 1/2" LOOSE KEY ANGLE STOPS W/ 1/2" O.D. BRASS FLEXIBLE	2"	1-1/2"	1-1/2"	1/2"	1/2"	-
															DF 1	SUPPLIES AND BRASS WALL SCUTCHEONS. DRINKING FOUNTAIN: ELKAY "EZH20" LZWS-EDFP217K, BOTTLE FILLING W/INTEGRAL SOFT SIDES FOUNTAIN, FILTERED, NON-REFRIGERATED, LAMINAR FLOW, ANTIMICROBIAL. FLEXI-GUARD SAFETY BUBBLER. WALL MOUNTED WITH INWALL FRAME/PLATE. INSTALL WITH WATERSENTRY PLU FILTER SYSTEM. CONTRACTOR TO PROVIDE FILTER.	2"	-	1-1/2"	1/2"	-	120V-1ø-60HZ 4.2 FLA 370 W
															FD 1	FLOOR DRAIN: JAY R SMITH MODEL 2010 FLOOR DRAIN , CAST IRON BODY W/ FLASHING COLLAR AND ADJUSTABLE STRAINER HEAD. PROVIDE WITH TRAP PRIMER CONNECTION FOR TP-1.	2"	2"	1-1/2"	1/2" TP		-
																TRAP PRIMER: (PRESSURE) MIFAB M-500 PRESSURE ACTIVATED TRAP PRIMER, 1/2" INLET AND 1/2" OUTLET WITH OPTIONAL DISTRIBUTION UNIT, MAY BE LOCATED AS INDICATED ON DRAWINGS OR AS REQUIRED BY COE UPC LISTED. PROVIDED WITH 12" X 12" ACCESS PANEL OR LARGER DEPENDING ON THE REQUIRED ACCESS TO THE EQUIPMENT AND SHUT-O VALVE.		-	-	1/2"	-	-
															WHA 1	WATER HAMMER ARRESTOR: MIFAB MWH-A INSTALLED ON ALL QUICK CLOSING VALVES AND ALL VALVES WHICH CLOSE WITH THE FLOW OF FLUID, OR ON HEADERS SERVING MORE THAN ONE FIXTURE, PROVIDED WITH 12" X 12" ACCESS PANEL.	-	-	-	-	-	-
															RD 1	ROOF DRAIN: JAY R SMITH MODEL 1310 COATED CAST IRON ROOF DRAIN WITH COMBINED FLASHING CLAMP AND GRAVEL STOPS WITH POLYETHYLENE DOME, BOTTOM OUTLET. SEE PLANS FOR SIZE.	-	-	-	-	-	-
															OD 1	OVERFLOW DRAIN: JAY R SMITH MODEL 1310-E COATED CAST IRON ROOF DRAIN WITH COMBINED FLASHING CLAMP AND GRAVEL STOPS WITH POLYETHYLENE DOME, 4" HIGH SOLID OVERFLOW CLAMP COLLAR, BOTTO OUTLET. SEE PLANS FOR SIZE.		-	-	-	-	-
															HB 1	HOSE BIBB: (RECESSED WALL) WOODFORD B24 RECESSED NARROW WAI HYDRANT BOX W/ LOCKING DOOR, CHROME FINISH WITH VACUUM BREAK METAL WHEEL HANDLE AND LOOSE TEE KEY OPERATED CONTROL VALVE	ER,	-	-	3/4"	-	-
															HB 2	HOSE BIBB: (ROOF) WOODFORD RHMC-MS WITH MOUNTING, HOSE CONNECTION BACKFLOW PREVENTER, WHEEL HANDLE, 1" NPT MALE INLE CONNECTION, 1" GALVANIZED PIPE. MAX. WORKING PRESSURE: 125 PSI. MAX. JANITOR SINK: AMERICAN STANDARD "FLORWELL" MODEL 7741.00,	т	-	-	1"	-	-
																ENAMELED CAST IRON, CORNER MOP SINK. CHICAGO FAUCETS 897-RCF WALL MOUNTED 8" BODY, SERVICE SINK FAUCET W/ VACUUM BREAKER, HOSE THREADED OUTLET, PAIL HOOK, INTEGRAL STOPS AND WALL BRAC SHOWER: CHICAGO FAUCETS MODEL SH-PB1-13-031 WALL MOUNTED		3"	1-1/2"	1/2"	1/2"	-
															SH 1	PRESSURE BALANCING SHOWER VALVE WITH SHOWER HEAD. 1.5 GPM @ PSI SHOWER HEAD AND HAND SPRAY, WITH SHOWER HEAD ARM AND WA FLANGE. <u>PROVIDE ASSE 1070 APPROVED TMV SET TO 115°.</u> COMPLETE WITH FD-1. <u>WASHING MACHINE BOX</u> : OATEY MODEL 38913 OFFSET DRAIN, SUPPLY CO		-	-	1/2"	1/2"	-
															(WMB)	AND HOT WATER VALVES WITH WATER HAMMER ARRESTOR. RIGHT SIDE		1-1/2"	1-1/2"	1	1/2"	1

				ELECTR	IC WA	TER	HEA	TER	SCH	HED	ULE						PLUMBING FIXTU	RE S		DULE			
тао	MANUF.					ELEC	TRICAL		C				GE			TAG	SPECIFICATION		CON		SIZE:		
TAG & I	10DEL NO.	OCATION	GAL	RECOVERY	FLA	WATTS V	/OLTAGE	PHASE	HZ	WEIGH (LBS)		DETAIL EFEREN	CE	REM	ARKS		SF LOI TOATION	WASTE	TRAP	VENT	CW RISER	HW RISER	ELEC.
WH 1 NOTES:	AO SMITH DSE-30A	CUST. 119 ES EQUIPMENT AN	30 ND WATER CAF	41 GPH @ 60° TEMP RISE PACITY.	28.8	6,000	208	1	60	468		1 PD-1.2		(1)	WC 1	WATERCLOSET: (ADA) AMERICAN STANDARD "MADERA" 3043.001, 16-1/2" HIGH RIM, (1.28 GPF), FLOOR MOUNTED, ELONGATED BOWL, SIPHON JET, 1-1/2" TOP SPUD, WHITE VITREOUS CHINA. SLOAN WES 111-1.6/1.1, (1.6/1.1 GPF), MANUAL REDUCE AND DUAL FLUSH, POLISHED CHROME FINISH, INCLUDES ANGLE STOP WITH BACK-FLOW PROTECTION. BEMIS PLASTIC SEAT MODEL 2L2155T, ELONGATED, OPEN FRONT, STAIN & CHEMICAL RESISTANT.	3"	INT.	2"	1"	-	-
				EXP	PANSIC	DN T	ANK	SCH	IEDU	JLE						WC 2	WATERCLOSET: (STANDARD) AMERICAN STANDARD "MADERA" 3451.001, 15" HIGH RIM, (1.28 GPF), FLOOR MOUNTED, ELONGATED BOWL, SIPHON JET, 1-1/2" TOP SPUD, WHITE VITREOUS CHINA. SLOAN WES 111-1.6/1.1, (1.6/1.1 GPF), MANUAL REDUCE AND DUAL FLUSH, POLISHED CHROME FINISH, INCLUDES ANGLE STOP WITH BACK-FLOW PROTECTION. BEMIS PLASTIC SEAT MODEL 2L2155T, ELONGATED, OPEN FRONT, STAIN & CHEMICAL RESISTANT.	3"	INT.	2"	1"	-	
TAG	SYSTEM	MANUFAC & MODEL			PACITY MA (GAL)	X PRESS (PSI)	6. MAX T (°F		OPERAT WEIGH (LBS)	IT	ANCHOR DETAI REFEREI	L		REMARI	٢S		URINAL: (ADA) AMERICAN STANDARD "WASHBROOK" 6590.001, 17" HIGH RIM, VITREOUS CHINA, WALL HUNG, WALL BRACKET WITH ANCHORS INCLUDED, 3/4" TOP SPUD. SLOAN ROYAL 186-0.125-DBP, (0.125 GPF), MANUAL SINGLE FLUSH, POLISHED CHROME FINISH, DUAL-FILTERED BYPASS.	2"	INT.	1-1/2"	1"	-	
NOTES:	(1) WEIGHT INCLUE	AMTRO ST-5C DES EQUIPMENT A	;		2.1	250	200)	25		1 PD-1.2			1			LAVATORY: AMERICAN STANDARD "LUCERNE" 0355.012, WALL MOUNTED, WHITE VITREOUS CHINA, 4" CENTERS, FRONT OVERFLOW, SELF-DRAINING DECK, CONCEALED ARM SUPPORT. CHICAGO FAUCETS MODEL 802- VE66ABCP, DECK MOUNTED MANUAL FAUCET, 4" CENTERS, ECONO-FLO NON-AERATING 0.5 GPM. <u>PROVIDE ASSE 1070 APPROVED TMV SET TO 115°.</u> ON ADA COMPLIANT PROVIDE TRUEBRO LAV GUARD PER ADA CODE 4.19.4. 1/4 TURN 1/2" LOOSE KEY ANGLE STOPS W/ 1/2" O.D. BRASS FLEXIBLE SUPPLIES AND BRASS WALL SCUTCHEONS.	2"	1-1/2"	1-1/2"	1/2"	1/2"	-
TAG	SYSTEM		ACTUREF DEL NO.						MOTOF (HP)	R I	ELECTRI	CAL \ /-P-HZ	WEIGHT (LBS)	DETAIL	REMARKS	S 1	SINK: (KITCHEN) ELKAY LUSTERTONE MODEL LRAD191865PD, STAINLESS STEEL, DROP-IN MOUNT, 6-1/2" DEPTH, SINGLE COMPARTMENT, SINGLE HOLE, PERFECT DRAIN AT REAR CENTER. CHICAGO FAUCET MODEL 50- TE35ABCP WITH 1.5 GPM PRESSURE COMPENDATING AERATOR, SINGLE HOLE, 5-1/4" RIGID SWING NECK. <u>PROVIDE ASSE 1070 APPROVED TMV SET</u> <u>TO 115°</u> . ON ADA COMPLIANT PROVIDE TRUEBRO LAV GUARD PER ADA CODE 4.19.4. 1/4 TURN 1/2" LOOSE KEY ANGLE STOPS W/ 1/2" O.D. BRASS FLEXIBLE SUPPLIES AND BRASS WALL SCUTCHEONS.	2"	1-1/2"	1-1/2"	1/2"	1/2"	-
NOTES:	1 1 FOR EMS DETAI			$) \land$	5 GPM @ 10' T	DH	ALL BRONZ	ZE	1/25		0.84 120	0V-1ø-60Hz	8	(1) PD-1.2		S 2	SINK: (HEALTH) ELKAY LUSTERTONE MODEL LRAD191865PD, STAINLESS STEEL, DROP-IN MOUNT, 6-1/2" DEPTH, SINGLE COMPARTMENT, SINGLE HOLE, PERFECT DRAIN AT REAR CENTER. CHICAGO FAUCET MODEL 50- E2805-5ABCP WITH 0.5 GPM AERATOR, SINGLE HOLE, 5-1/4" RIGID SWING NECK. <u>PROVIDE ASSE 1070 APPROVED TMV SET TO 120°.</u> ON ADA COMPLIANT PROVIDE TRUEBRO LAV GUARD PER ADA CODE 4.19.4. 1/4 TURN 1/2" LOOSE KEY ANGLE STOPS W/ 1/2" O.D. BRASS FLEXIBLE SUPPLIES AND BRASS WALL SCUTCHEONS.	2"	1-1/2"	1-1/2"	1/2"	1/2"	-
																DF 1	DRINKING FOUNTAIN: ELKAY "EZH20" LZWS-EDFP217K, BOTTLE FILLING W/INTEGRAL SOFT SIDES FOUNTAIN, FILTERED, NON-REFRIGERATED, LAMINAR FLOW, ANTIMICROBIAL. FLEXI-GUARD SAFETY BUBBLER. WALL MOUNTED WITH INWALL FRAME/PLATE. INSTALL WITH WATERSENTRY PLUS FILTER SYSTEM. CONTRACTOR TO PROVIDE FILTER.	2"	_	1-1/2"	1/2"	-	120V-1ø-60HZ 4.2 FLA 370 W
																FD 1	$\frac{\rm FLOOR\ DRAIN}{\rm EM}: {\rm JAY\ R\ SMITH\ MODEL\ 2010\ FLOOR\ DRAIN\ ,\ CAST\ IRON\ BODY\ W/\ FLASHING\ COLLAR\ AND\ ADJUSTABLE\ STRAINER\ HEAD.\ PROVIDE\ WITH\ TRAP\ PRIMER\ CONNECTION\ FOR\ TP-1.$	2"	2"	1-1/2"	1/2" TP	-	-
																	TRAP PRIMER: (PRESSURE) MIFAB M-500 PRESSURE ACTIVATED TRAP PRIMER, 1/2" INLET AND 1/2" OUTLET WITH OPTIONAL DISTRIBUTION UNIT, MAY BE LOCATED AS INDICATED ON DRAWINGS OR AS REQUIRED BY CODE. UPC LISTED. PROVIDED WITH 12" X 12" ACCESS PANEL OR LARGER DEPENDING ON THE REQUIRED ACCESS TO THE EQUIPMENT AND SHUT-OFF VALVE.	-	-	-	1/2"	-	-
																WHA 1	WATER HAMMER ARRESTOR: MIFAB MWH-A INSTALLED ON ALL QUICK CLOSING VALVES AND ALL VALVES WHICH CLOSE WITH THE FLOW OF FLUID, OR ON HEADERS SERVING MORE THAN ONE FIXTURE, PROVIDED WITH 12" X 12" ACCESS PANEL.	-	-	-	-	-	-
																RD 1	ROOF DRAIN: JAY R SMITH MODEL 1310 COATED CAST IRON ROOF DRAIN WITH COMBINED FLASHING CLAMP AND GRAVEL STOPS WITH POLYETHYLENE DOME, BOTTOM OUTLET. SEE PLANS FOR SIZE.	-	-	-	-	-	-
																	OVERFLOW DRAIN: JAY R SMITH MODEL 1310-E COATED CAST IRON ROOF DRAIN WITH COMBINED FLASHING CLAMP AND GRAVEL STOPS WITH POLYETHYLENE DOME, 4" HIGH SOLID OVERFLOW CLAMP COLLAR, BOTTOM OUTLET. SEE PLANS FOR SIZE.	-	-	-	-	-	-
																HB 1	HOSE BIBB: (RECESSED WALL) WOODFORD B24 RECESSED NARROW WALL HYDRANT BOX W/ LOCKING DOOR, CHROME FINISH WITH VACUUM BREAKER METAL WHEEL HANDLE AND LOOSE TEE KEY OPERATED CONTROL VALVE.	, _	-	-	3/4"	-	-
																HB 2	HOSE BIBB: (ROOF) WOODFORD RHMC-MS WITH MOUNTING, HOSE CONNECTION BACKFLOW PREVENTER, WHEEL HANDLE, 1" NPT MALE INLET CONNECTION, 1" GALVANIZED PIPE. MAX. WORKING PRESSURE: 125 PSI. MAX.	-	-	-	1"	-	-
																JS 1	JANITOR SINK: AMERICAN STANDARD "FLORWELL" MODEL 7741.00, ENAMELED CAST IRON, CORNER MOP SINK. CHICAGO FAUCETS 897-RCF WALL MOUNTED 8" BODY, SERVICE SINK FAUCET W/ VACUUM BREAKER, HOSE THREADED OUTLET, PAIL HOOK, INTEGRAL STOPS AND WALL BRACE.	3"	3"	1-1/2"	1/2"	1/2"	-
																SH 1	SHOWER: CHICAGO FAUCETS MODEL SH-PB1-13-031 WALL MOUNTED PRESSURE BALANCING SHOWER VALVE WITH SHOWER HEAD. 1.5 GPM @ 80 PSI SHOWER HEAD AND HAND SPRAY, WITH SHOWER HEAD ARM AND WALL FLANGE. <u>PROVIDE ASSE 1070 APPROVED TMV SET TO 115°.</u> COMPLETE WITH FD-1.	-	-	-	1/2"	1/2"	
																WMB 1	WASHING MACHINE BOX: OATEY MODEL 38913 OFFSET DRAIN, SUPPLY COLE AND HOT WATER VALVES WITH WATER HAMMER ARRESTOR. RIGHT SIDE DRAIN CONNECTION	2"	1-1/2"	1-1/2"	1/2"	1/2"	-



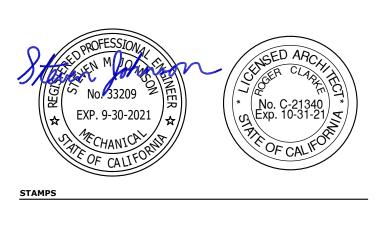



CONSULTANT BRANDING

RUHNAUCLARKE.COM 3775 TENTH STREET, RIVERSIDE CALIFORNIA 92501(951) 684 4664 / 5751 PALMER WAY, SUITE C, CARLSBAD CALIFORNIA 9201(0760) 438 5899




AGENCY APPROVAL File No: A#




AD 2 Ζ T U



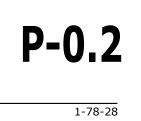


20-178 __

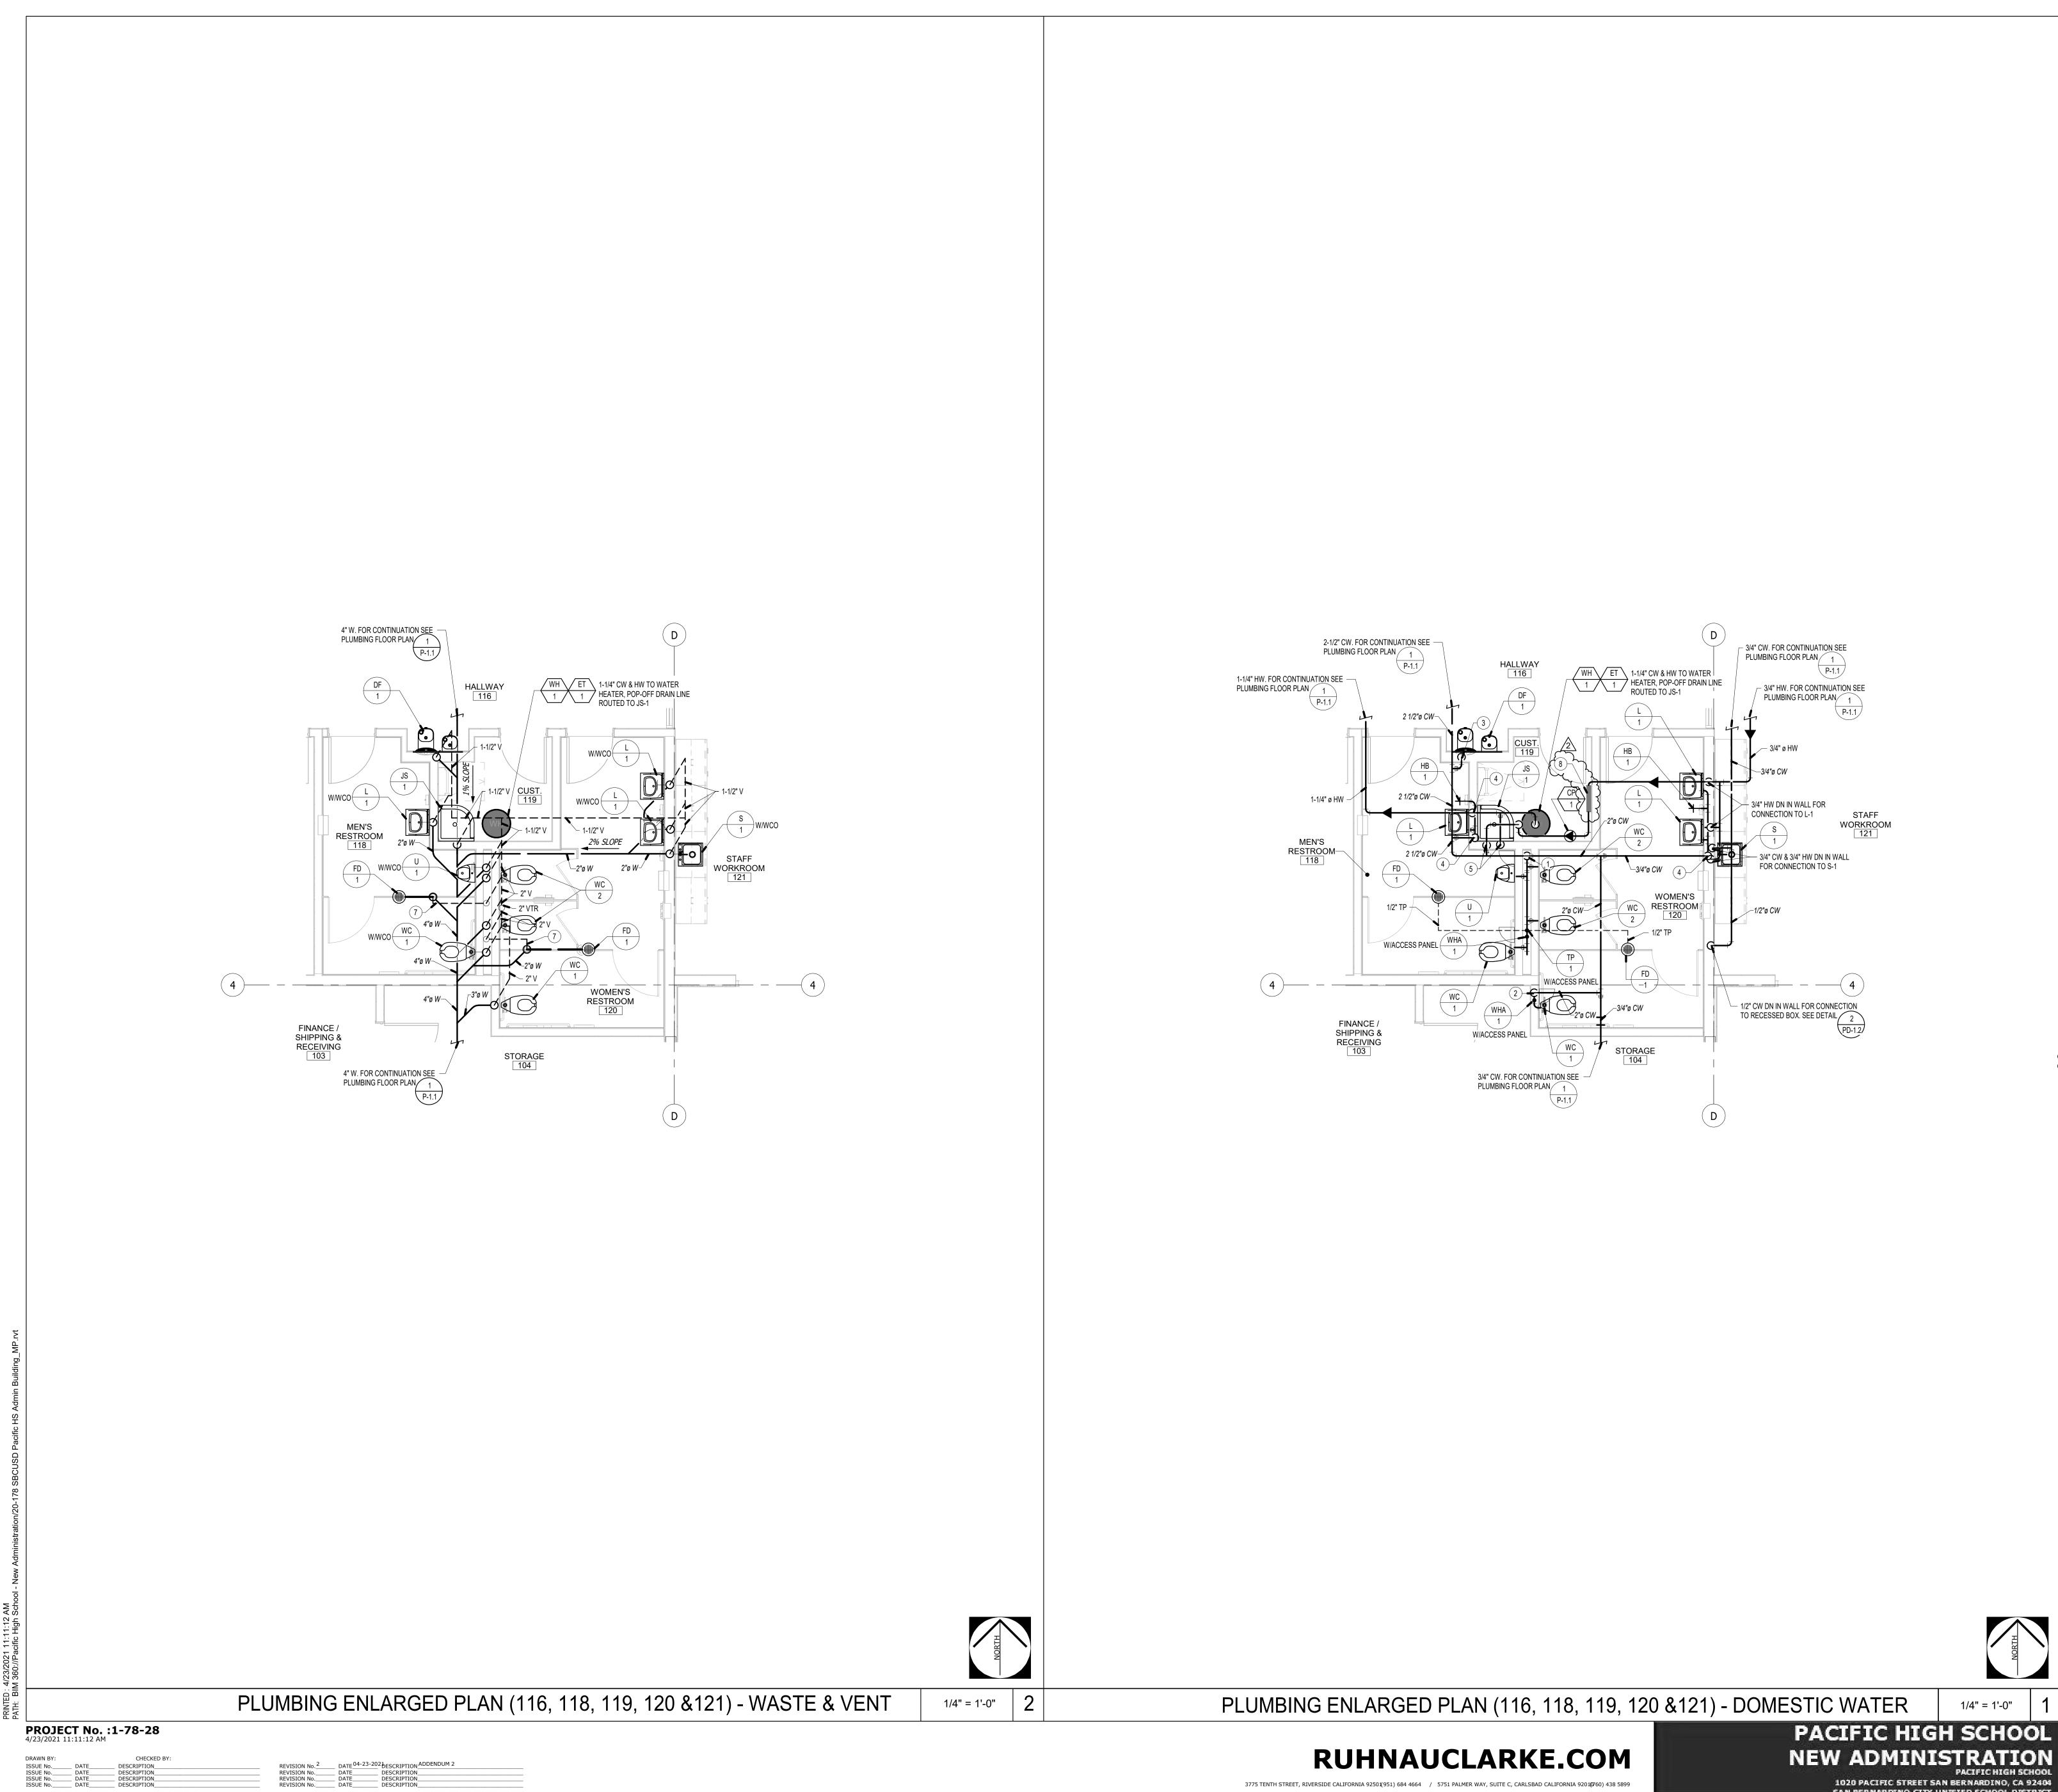



- IN SECTION G09.9 OF THE CPC.
- 4. FOR PIPE SUPPORT, SEE PLUMBING DETAIL #1 ON SHEET PD-1.1.
- 6. FOR VENT THRU ROOF, SEE PLUMBING DETAIL #3 ON SHEET PD-1.1. 7. FOR CLEAN OUT, SEE PLUMBING DETAIL #6 ON SHEET PD-1.1.
- 8. FOR WATER HAMMER ARRESTOR, SEE PLUMBING DETAIL #7 ON SHEET PD-1.1.
- 9. FOR INTERIOR HOSEBIBB, SEE PLUMBING DETAIL #13 ON SHEET PD-1.1.
- 10. FOR WATER HEATER SUPPORT, SEE PLUMBING DETAIL #1 ON SHEET PD-1.2.
- 11. FOR RECESSED BOX, SEE PLUMBING DETAIL #2 ON SHEET PD-1.2.

- 2) 2" CW DOWN IN WALL WITH SOV ON RISER BEHIND ACCESS PANEL. 3) 1/2" CW DOWN IN WALL FOR CONNECTION TO DF-1.
- (4) 3/4" CW DOWN IN WALL FOR CONNECTION TO L-1 AND HB-3.
- (6) 1/2" HW DN IN WALL FOR CONNECTION TO L-1.
- 7) 1-1/2" VENT BELOW GRADE. (8) HOT WATER CIRCULATING PUMP CONTROL PANEL (CP-4). SEE MECHANICAL DRAWING

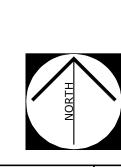

1/4" = 1'-0"

PACIFIC HIGH SCHOOL

PLUMBING ENLARGED PLANS

1020 PACIFIC STREET SAN BERNARDINO, CA 92404 SAN BERNARDINO CITY UNIFIED SCHOOL DISTRICT


5ED ARC, 11 ER CL 12 0. C-21340 p. 10-31-21 OF CALIFOR	AGENCY APPROVAL File No: A#
08 Isteng.com ERING NSULTANTS	RUHNAU CLARKE architects
RAL NO	ΓES
E PLUMBING LEGEND OF TO PROVIDE AS-BUILTS IALL BE DISINFECTED PR	

CONSTRUCTION NOTES

1) 2-1/2" CW DOWN IN CHASE TO FULL SIZE HEADER WITH SOV ON RISER BEHIND ACCESS PANEL.

5) 3/4" CW & 3/4" HW DOWN IN WALL FOR CONNECTION TO JS-1 AND 3/4" CW EXPOSED IN ROOM FOR CONNECTION TO WH-1.



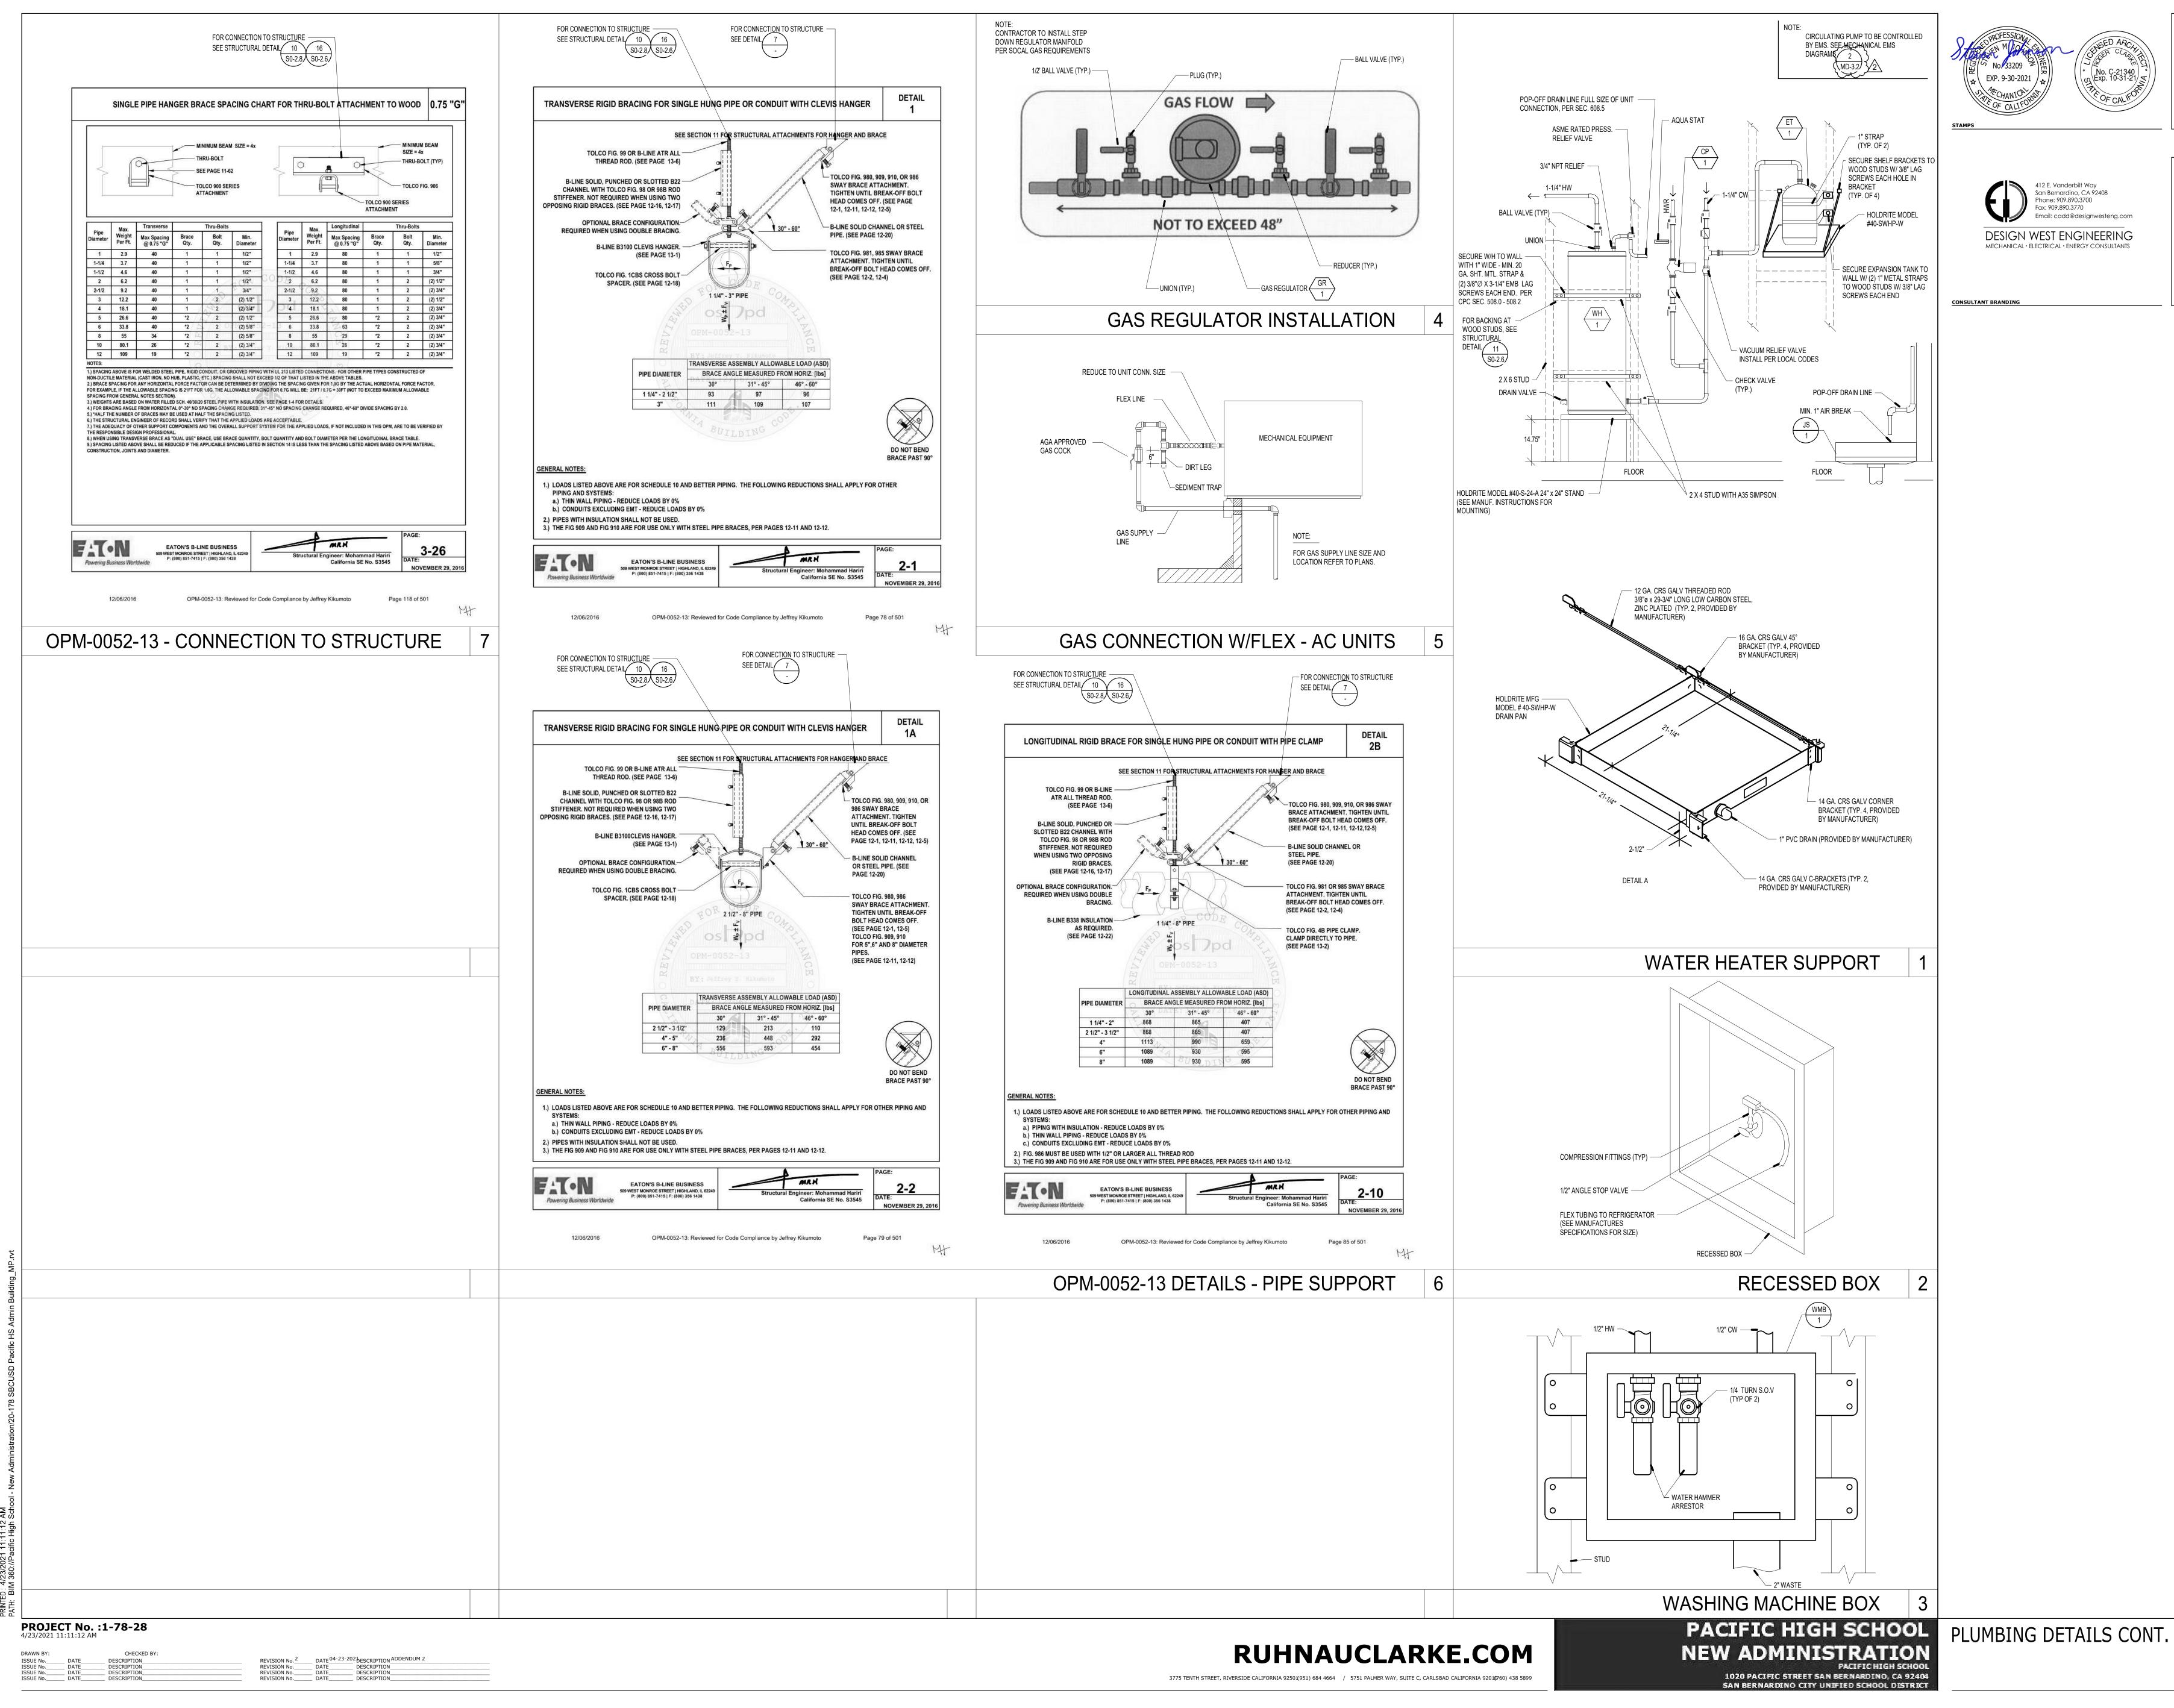




GENCY APPROV







1-78-28

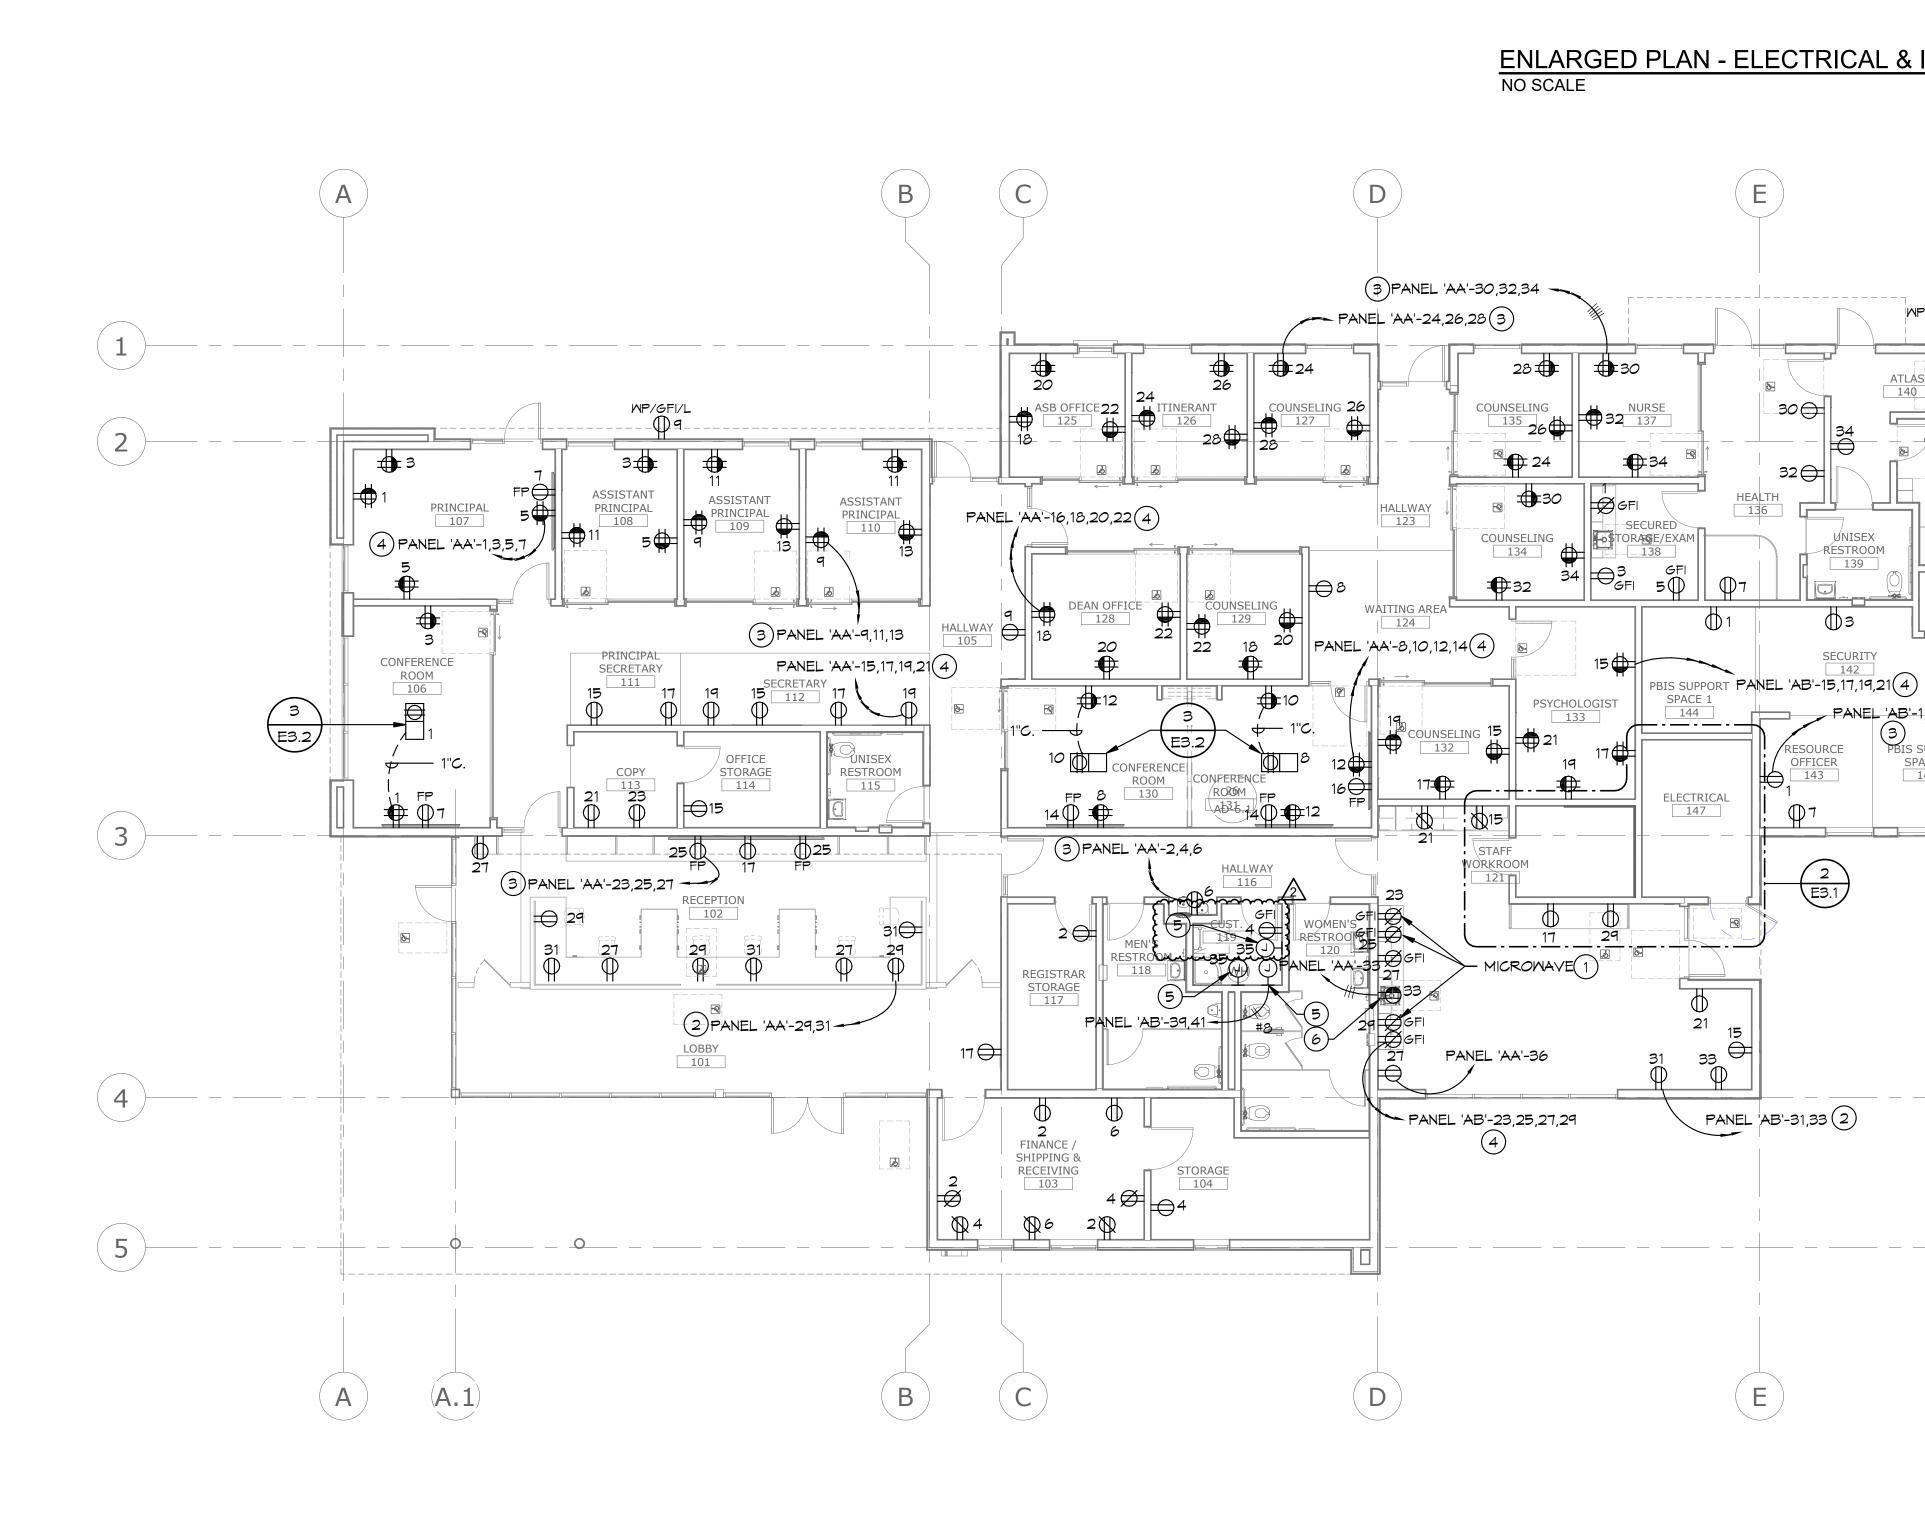

PROJECT No. :Project Number 4/23/2021 11:11:32 AM

CHECKED BY: ___ DESCRIPTION____ ___ DESCRIPTION___ ___ DESCRIPTION___ DESCRIPTION___ DRAWN BY: ISSUE No.___ ISSUE No.___ ISSUE No.___ ___ DATE___ __ DATE___ __ DATE___ __ DATE___


 REVISION No
 1
 DATE
 04/02/202
 DESCRIPTION
 Addendum 1

 REVISION No
 2
 DATE
 04/23/202
 DESCRIPTION
 Addendum 2

 REVISION No
 2
 DATE
 DESCRIPTION
 Addendum 2

 REVISION No
 DATE
 DESCRIPTION
 DESCRIPTION

 REVISION No
 DATE
 DESCRIPTION

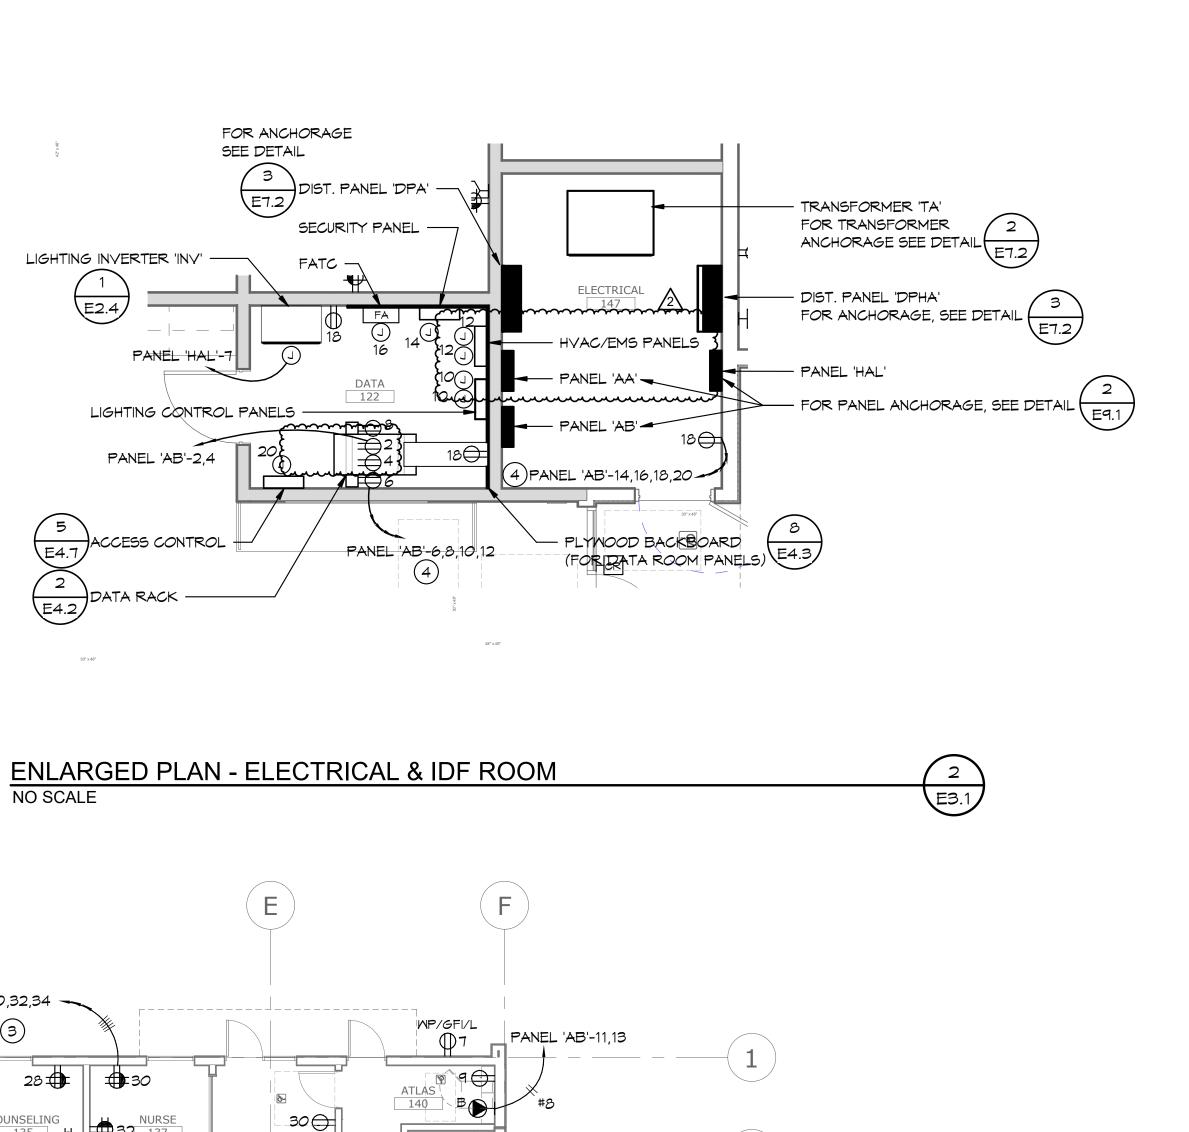

E3.2

PANEL 'AB'-5,7(2)

2

 \smallsetminus \checkmark

4

5

34

WNISEX

RESTROOM

139

₫з

SECURIT

PANEL 'AB'-1,3,5

PBIS SUPPOR

SPACE 2 145

ROOM /

SHOWER

3θ

50



Exp. <u>6-30-2021</u>

GENERAL NOTES:

- SCHEDULE.
- BACKBOX INSTALLATION DETAILS.
- NUMBER OF CIRCUITS TO BE GROUPED TOGETHER.
- CIRCUIT (U.O.N.).
- AND RECEPTACLES PRIOR TO ROUGH-IN.

<u>KEY NOTES:</u>

- (1) FIELD VERIFY EXACT LOCATION PRIOR TO ROUGH-IN.
- 2 #12 (HOT), 1 #10 (NEUTRAL), 1 #12 (GND), 3/4"C.
- 3 #12 (HOT), 1 #10 (NEUTRAL), 1 #12 (GND), 3/4"С.
- (4) 4 #12 (HOT), 2 #10 (NEUTRAL), 1 #12 (GND), 3/4"C.
- SMITCH.





NEW ADMINISTRATION BUILDING

POWER FLOOR PLAN

1020 PACIFIC STREET, SAN BERNARDINO, CA 92404 SAN BERNARDINO CITY UNIFIED SCHOOL DISTRICT



www.jce-inc.com

GENCY APPROVAL



REFERENCE ARCHITECTURAL INTERIOR ELEVATIONS FOR EXACT LOCATION OF ALL WALL MOUNTED POWER DEVICES WHERE INDICATED AT MOUNTING HEIGHTS OTHER THAN +18".

2. REFERENCE SHEET E6 SERIES SHEETS FOR MECHANICAL EQUIPMENT

3. REFERENCE E3 AND E8 SERIES SHEETS FOR TYPICAL CONDUIT AND

4. NUMBERS ADJACENT TO EACH POWER DEVICE INDICATES THE CIRCUIT NUMBER TO WHICH THE DEVICE IS TO BE CONNECTED.

CIRCUIT HOMERUNS ARE INDICATED TO SHOW THE LOCATION AND

6. PROVIDE MINIMUM 3/4" CONDUIT AND #12 CIRCUIT CONDUCTORS AS REQUIRED TO CONNECT EACH POWER DEVICE TO THEIR INDICATED


7. FIELD VERIFY EXACT ROUTING LOCATION FOR CONCEALED CONDUITS

5 VERIFY EXACT LOCATION OF CIRC. PUMP CONTROL PANEL, AND WATER HEATER WITH PLUMBING PRIOR TO ROUGH-IN.

6 PROVIDE CONTROLLED DUPLEX RECEPTACLE BELOW SINK FOR FUTURE GARBAGE DISPOSAL. PROVIDE 3/4"C. FROM RECEPTACLE TO BOX WITH EMPTY FACE PLATE TO THE RIGHT OF THE SINK FOR FUTURE





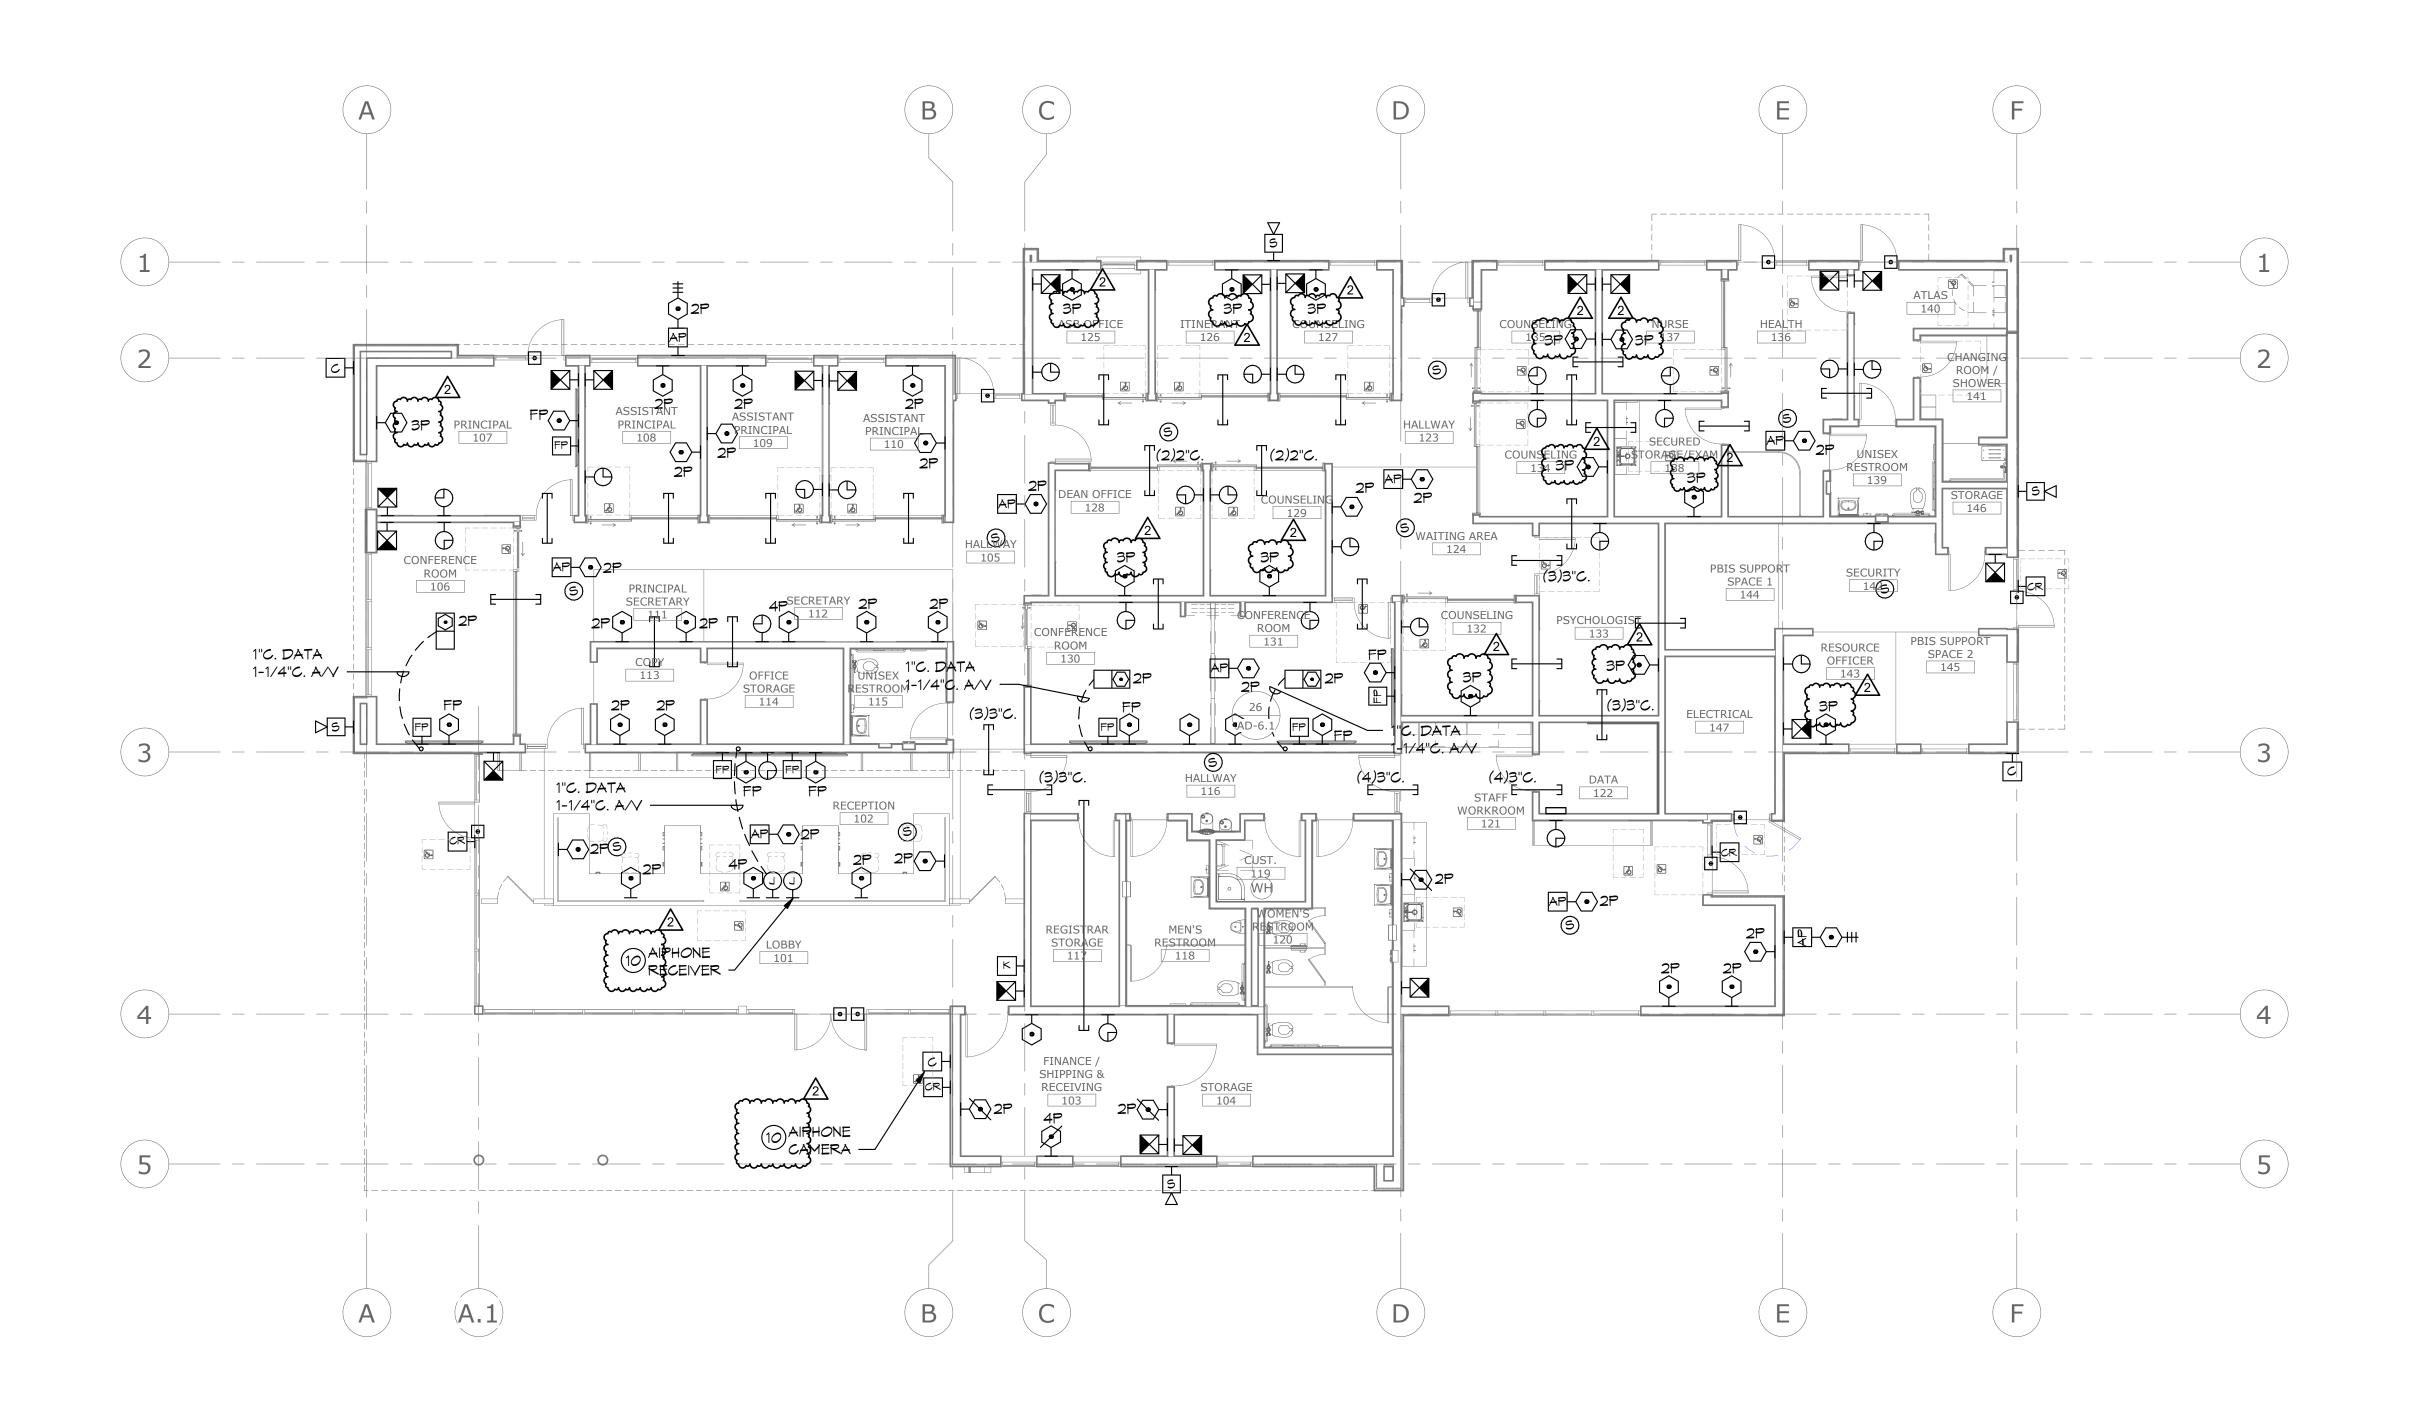

PROJECT No. :Project Number 4/23/2021 11:11:36 AM

CHECKED BY: ____ DESCRIPTION____ ___ DESCRIPTION___ ____ DESCRIPTION___ DRAWN BY: ISSUE No._____ ISSUE No._____ ISSUE No._____ ISSUE No._____ DATE____ DATE____ DATE____ DATE____

 REVISION No.
 DATE
 04/23/202
 Description
 Addendum 2

 REVISION No.
 DATE
 DESCRIPTION

 REVISION No.
 DATE
 DESCRIPTION

 REVISION No.
 DATE
 DESCRIPTION

 REVISION No.
 DATE
 DESCRIPTION

#20048 STAMPS	ROFESSION SUB NO.E 14781 Exp. 6-30-202 STATE OF CALLE	± / ★ //	STRIKOF
		er Ligh	nting M
	Communica		
	P 858.67	Po	oway, C
CONSULT	ANT BRANDING		/ww.jce
<u>GE</u> 1.	ENERAL NOTE REFERENCE	E ARCH	
2.	LOCATION	CE E4 AN	ID E8 SE
З.	BACKBOX	CE E4 SE	RIES SHI
4.	SYSTEMS	CE RISER	
5.	ROUTINGS LOCATION	I OF PRO	
	DIAGRAM VERIFIED PROJECTO SCREEN.	PRIOR T	O INSTA
6.	REFER TO REQUIREM		
<u>NE</u> (1	<u>EY NOTES:</u> 1) 3/4"C. TO	BUILDIN	G COMM
(3	з) 11/4"С. Та	O BUILDII	NG COMI
	а́) з∕4"с. то	BUILDIN	G 'IDF' Lo
	5) 1"C. TO BL	JILDING '	IDF' LOC
e	5) 1 1/4"C. To	O BUILDII	NG 'IDF' I
	а) 3/4"С. ТО	SOUND	SYSTEM
(8			
	$\frac{1}{2} = \frac{1}{2} \frac{1}{4} \frac{1}{4} \frac{1}{4} = \frac{1}{2} \frac{1}{4} $		
	9) PROVIDE	JAIACO	JNNECH

LEVEL 1 FLOOR PLAN - COMMUNICATIONS $\begin{bmatrix} SCALE: \\ 1/8" = 1'-0" \end{bmatrix}$



1020 PACIFIC STREET, SAN BERNARDINO, CA 92404 SAN BERNARDINO CITY UNIFIED SCHOOL DISTRICT

NEW ADMINISTRATION BUILDING

COMMUNICATIONS FLOOR PLAN



SON GINEERS, INC.

Multimedia Vetworking

, Suite 300 CA 92064 58.513.0559 ce-inc.com





JRAL INTERIOR ELEVATIONS FOR EXACT . MOUNTED DEVICES.

SERIES SHEETS FOR TYPICAL CONDUIT AND DETAILS.

CHEETS FOR TYPICAL COMMUNICATION

RAMS FOR TYPICAL CONDUIT SIZES AND

OR AND OTHER AUDIO-VISUAL EQUIPMENT IS CT LOCATION OF EQUIPMENT TO BE FIELD FALLATION. LOCATION OF PROJECTOR AND BE COORDINATED WITH LOCATION OF

SYSTEM DIAGRAMS FOR ADDITIONAL NCTION BOX LOCATIONS, TYPES AND SIZES.

IMUNICATIONS CABINET.

NICATIONS CABINET.

MMUNICATIONS CABINET.

LOCATION.

CATION.

=' LOCATION.

M EQUIPMENT RACK.


EQUIPMENT RACK.

EM EQUIPMENT RACK.

TION AT AIPHONE EQUIPMENT. mannanananana





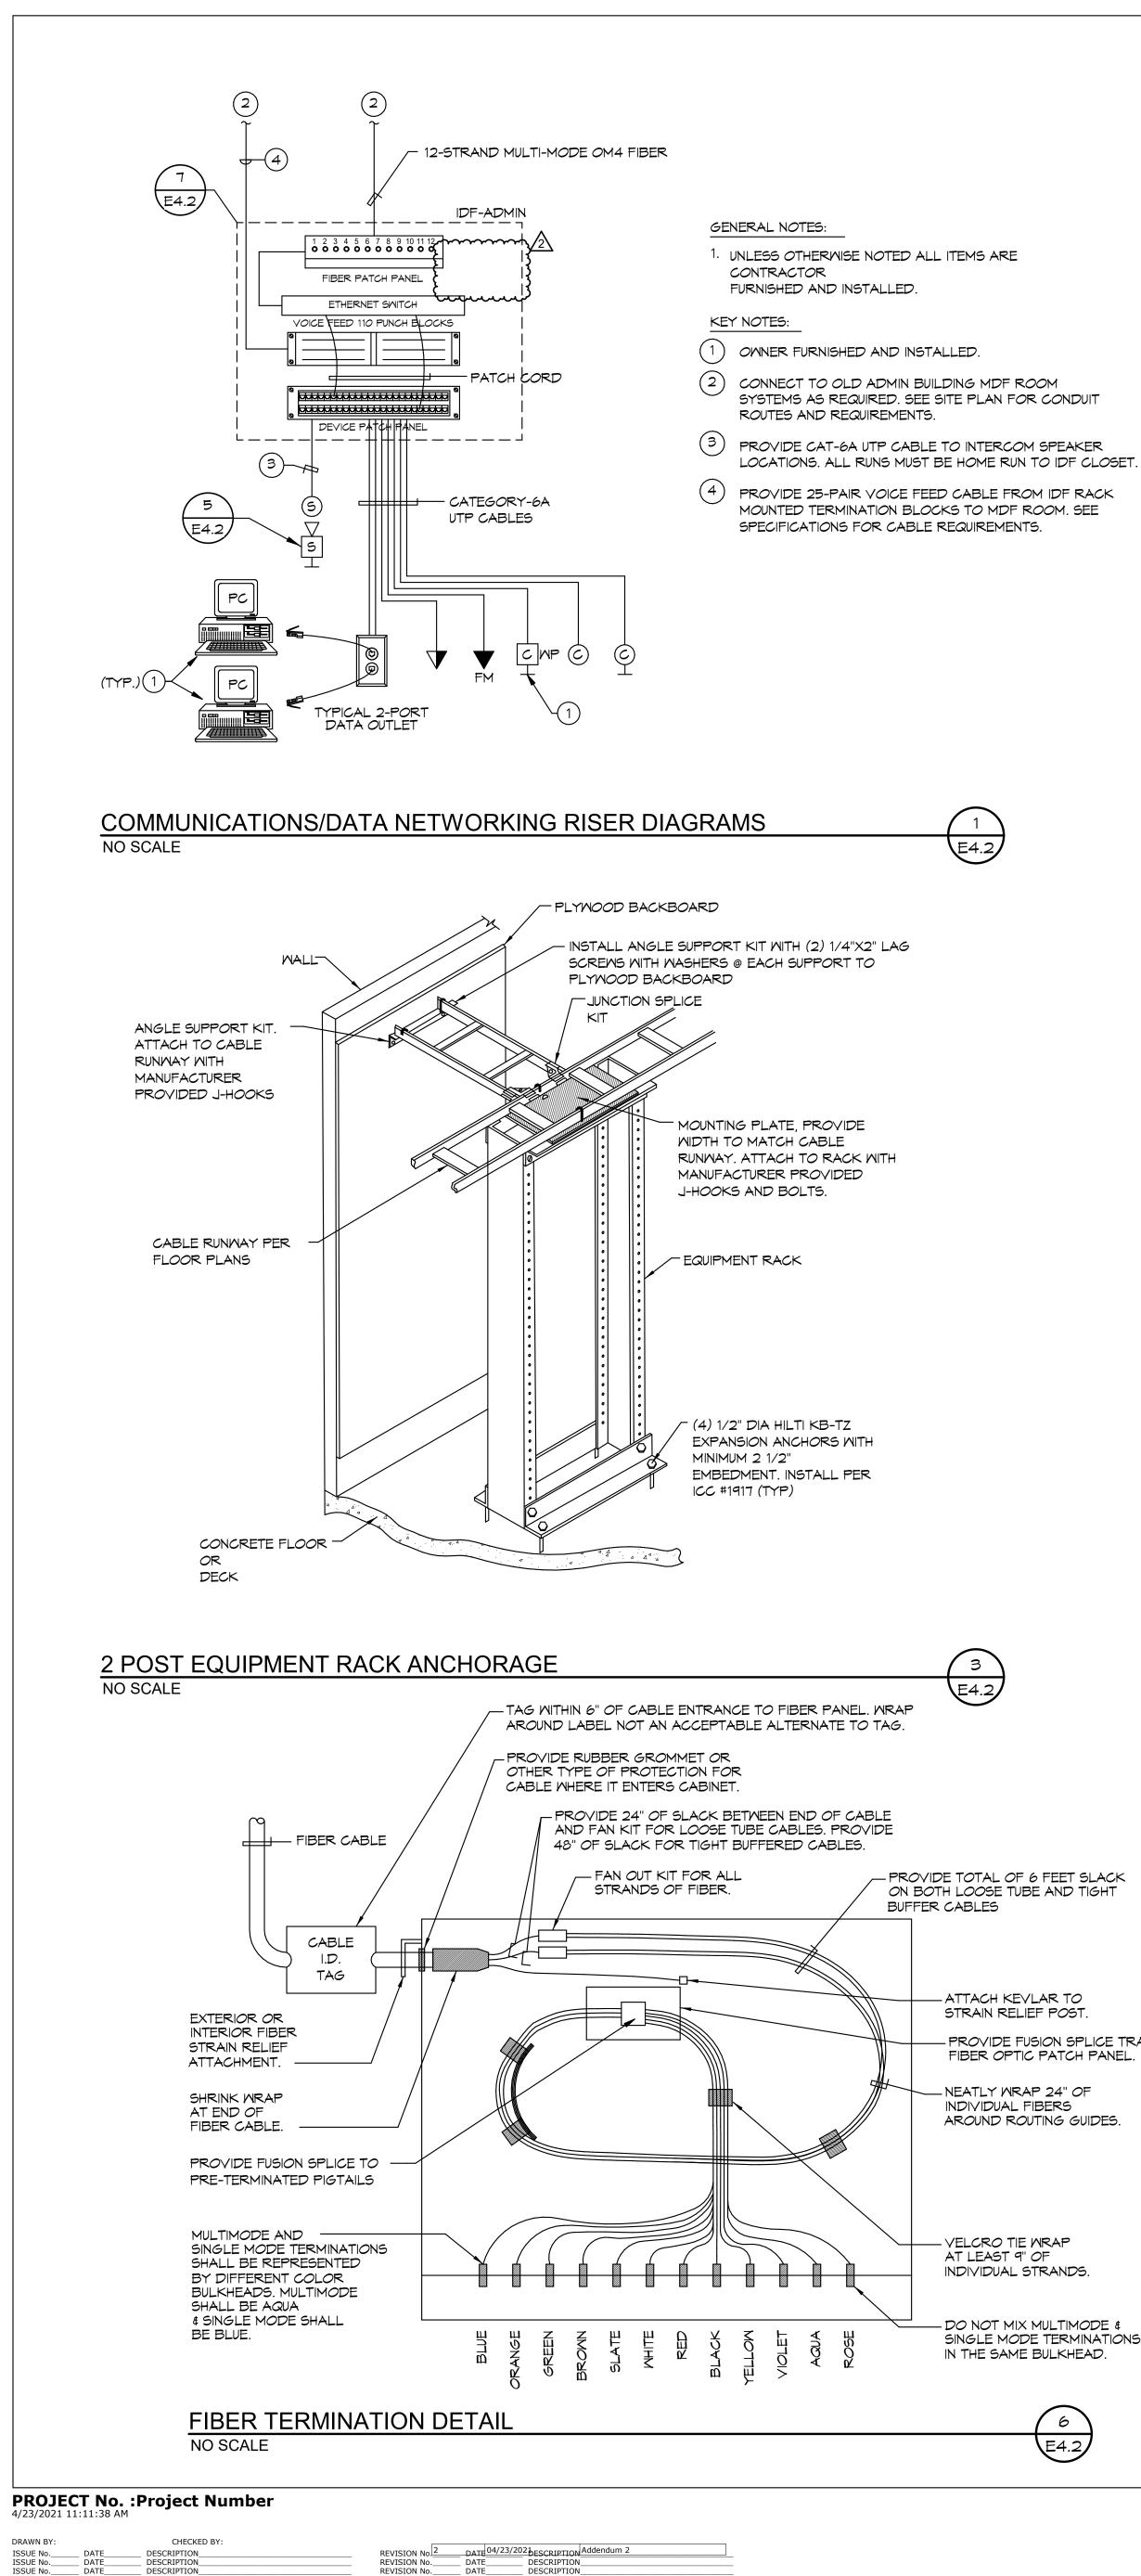

DESCRIPTION DESCRIPTION DESCRIPTION _ DATE_ _ DATE_ _ DATE_ _ DATE_ _ DATE_ DESCRIPTIO

ISSUE No.


 REVISION No.
 DATE
 DATE
 DESCRIPTION
 Addendum 2

 REVISION No.
 DATE
 DESCRIPTION

 REVISION No.
 DATE
 DESCRIPTION

 REVISION No.
 DATE
 DESCRIPTION

 REVISION No.
 DATE
 DESCRIPTION

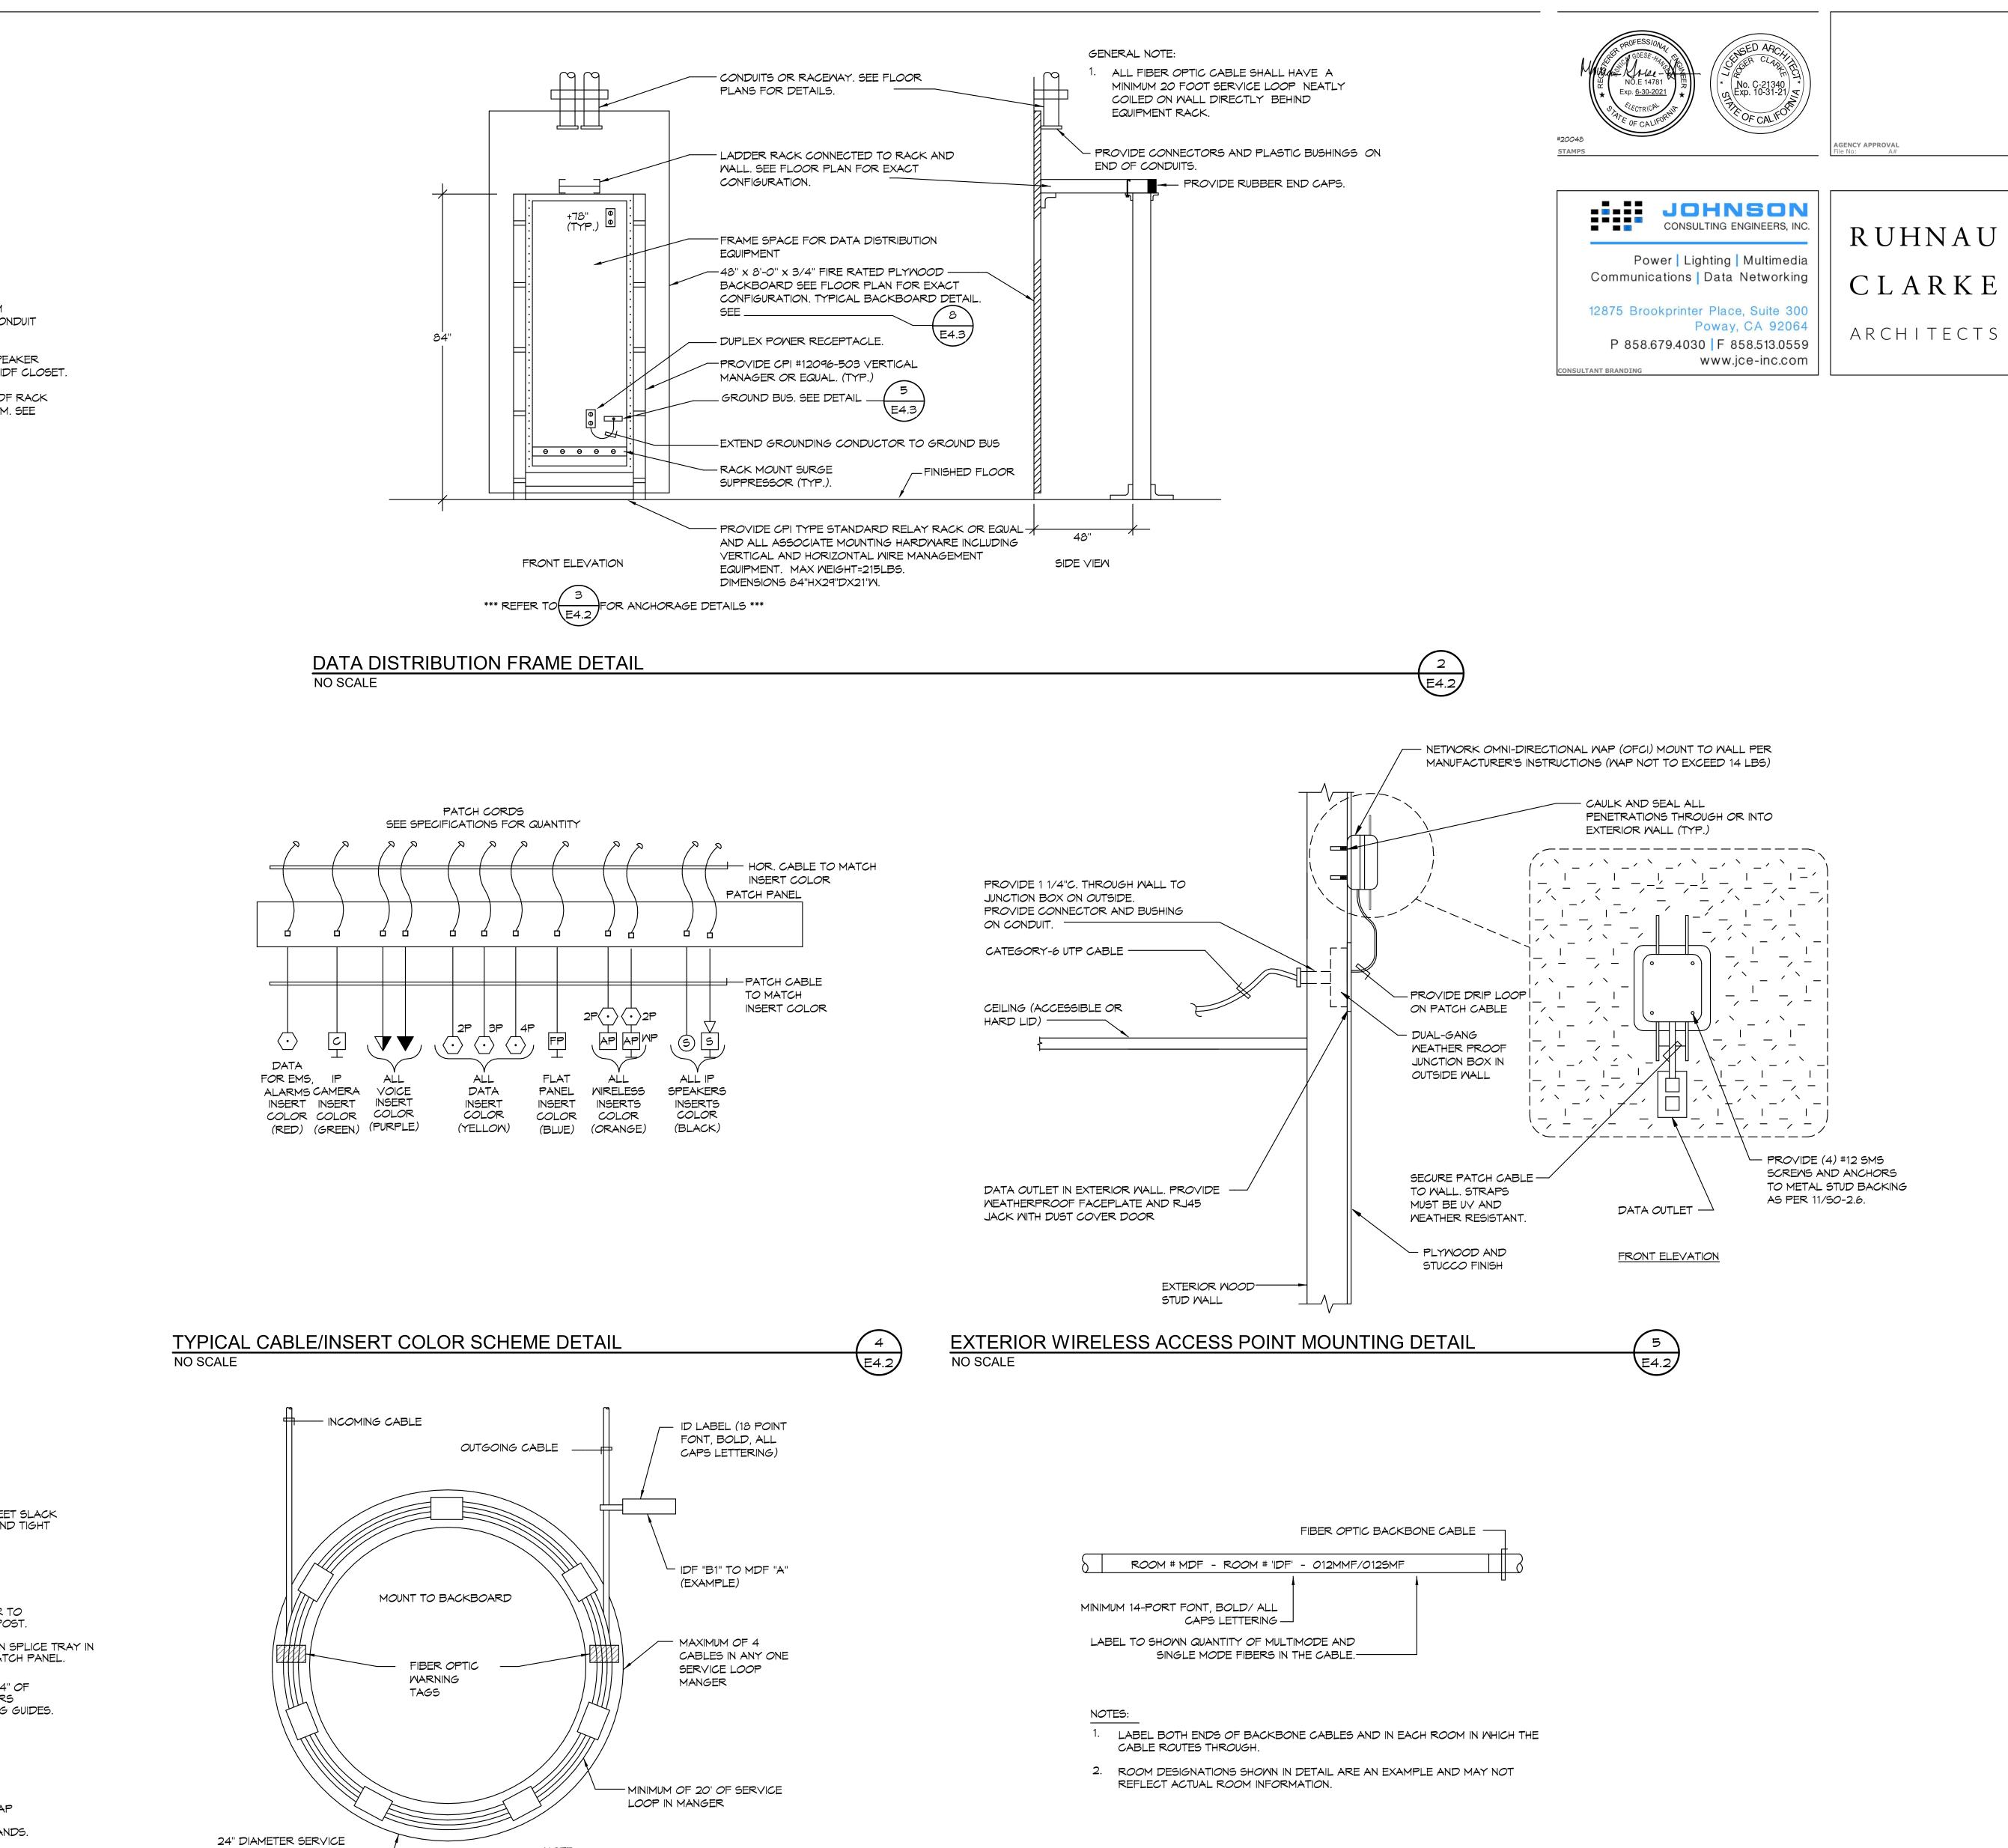


- ATTACH KEVLAR TO STRAIN RELIEF POST. PROVIDE FUSION SPLICE TRAY IN FIBER OPTIC PATCH PANEL. NEATLY WRAP 24" OF INDIVIDUAL FIBERS AROUND ROUTING GUIDES.

VELCRO TIE WRAP INDIVIDUAL STRANDS.

- DO NOT MIX MULTIMODE & SINGLE MODE TERMINATIONS IN THE SAME BULKHEAD.



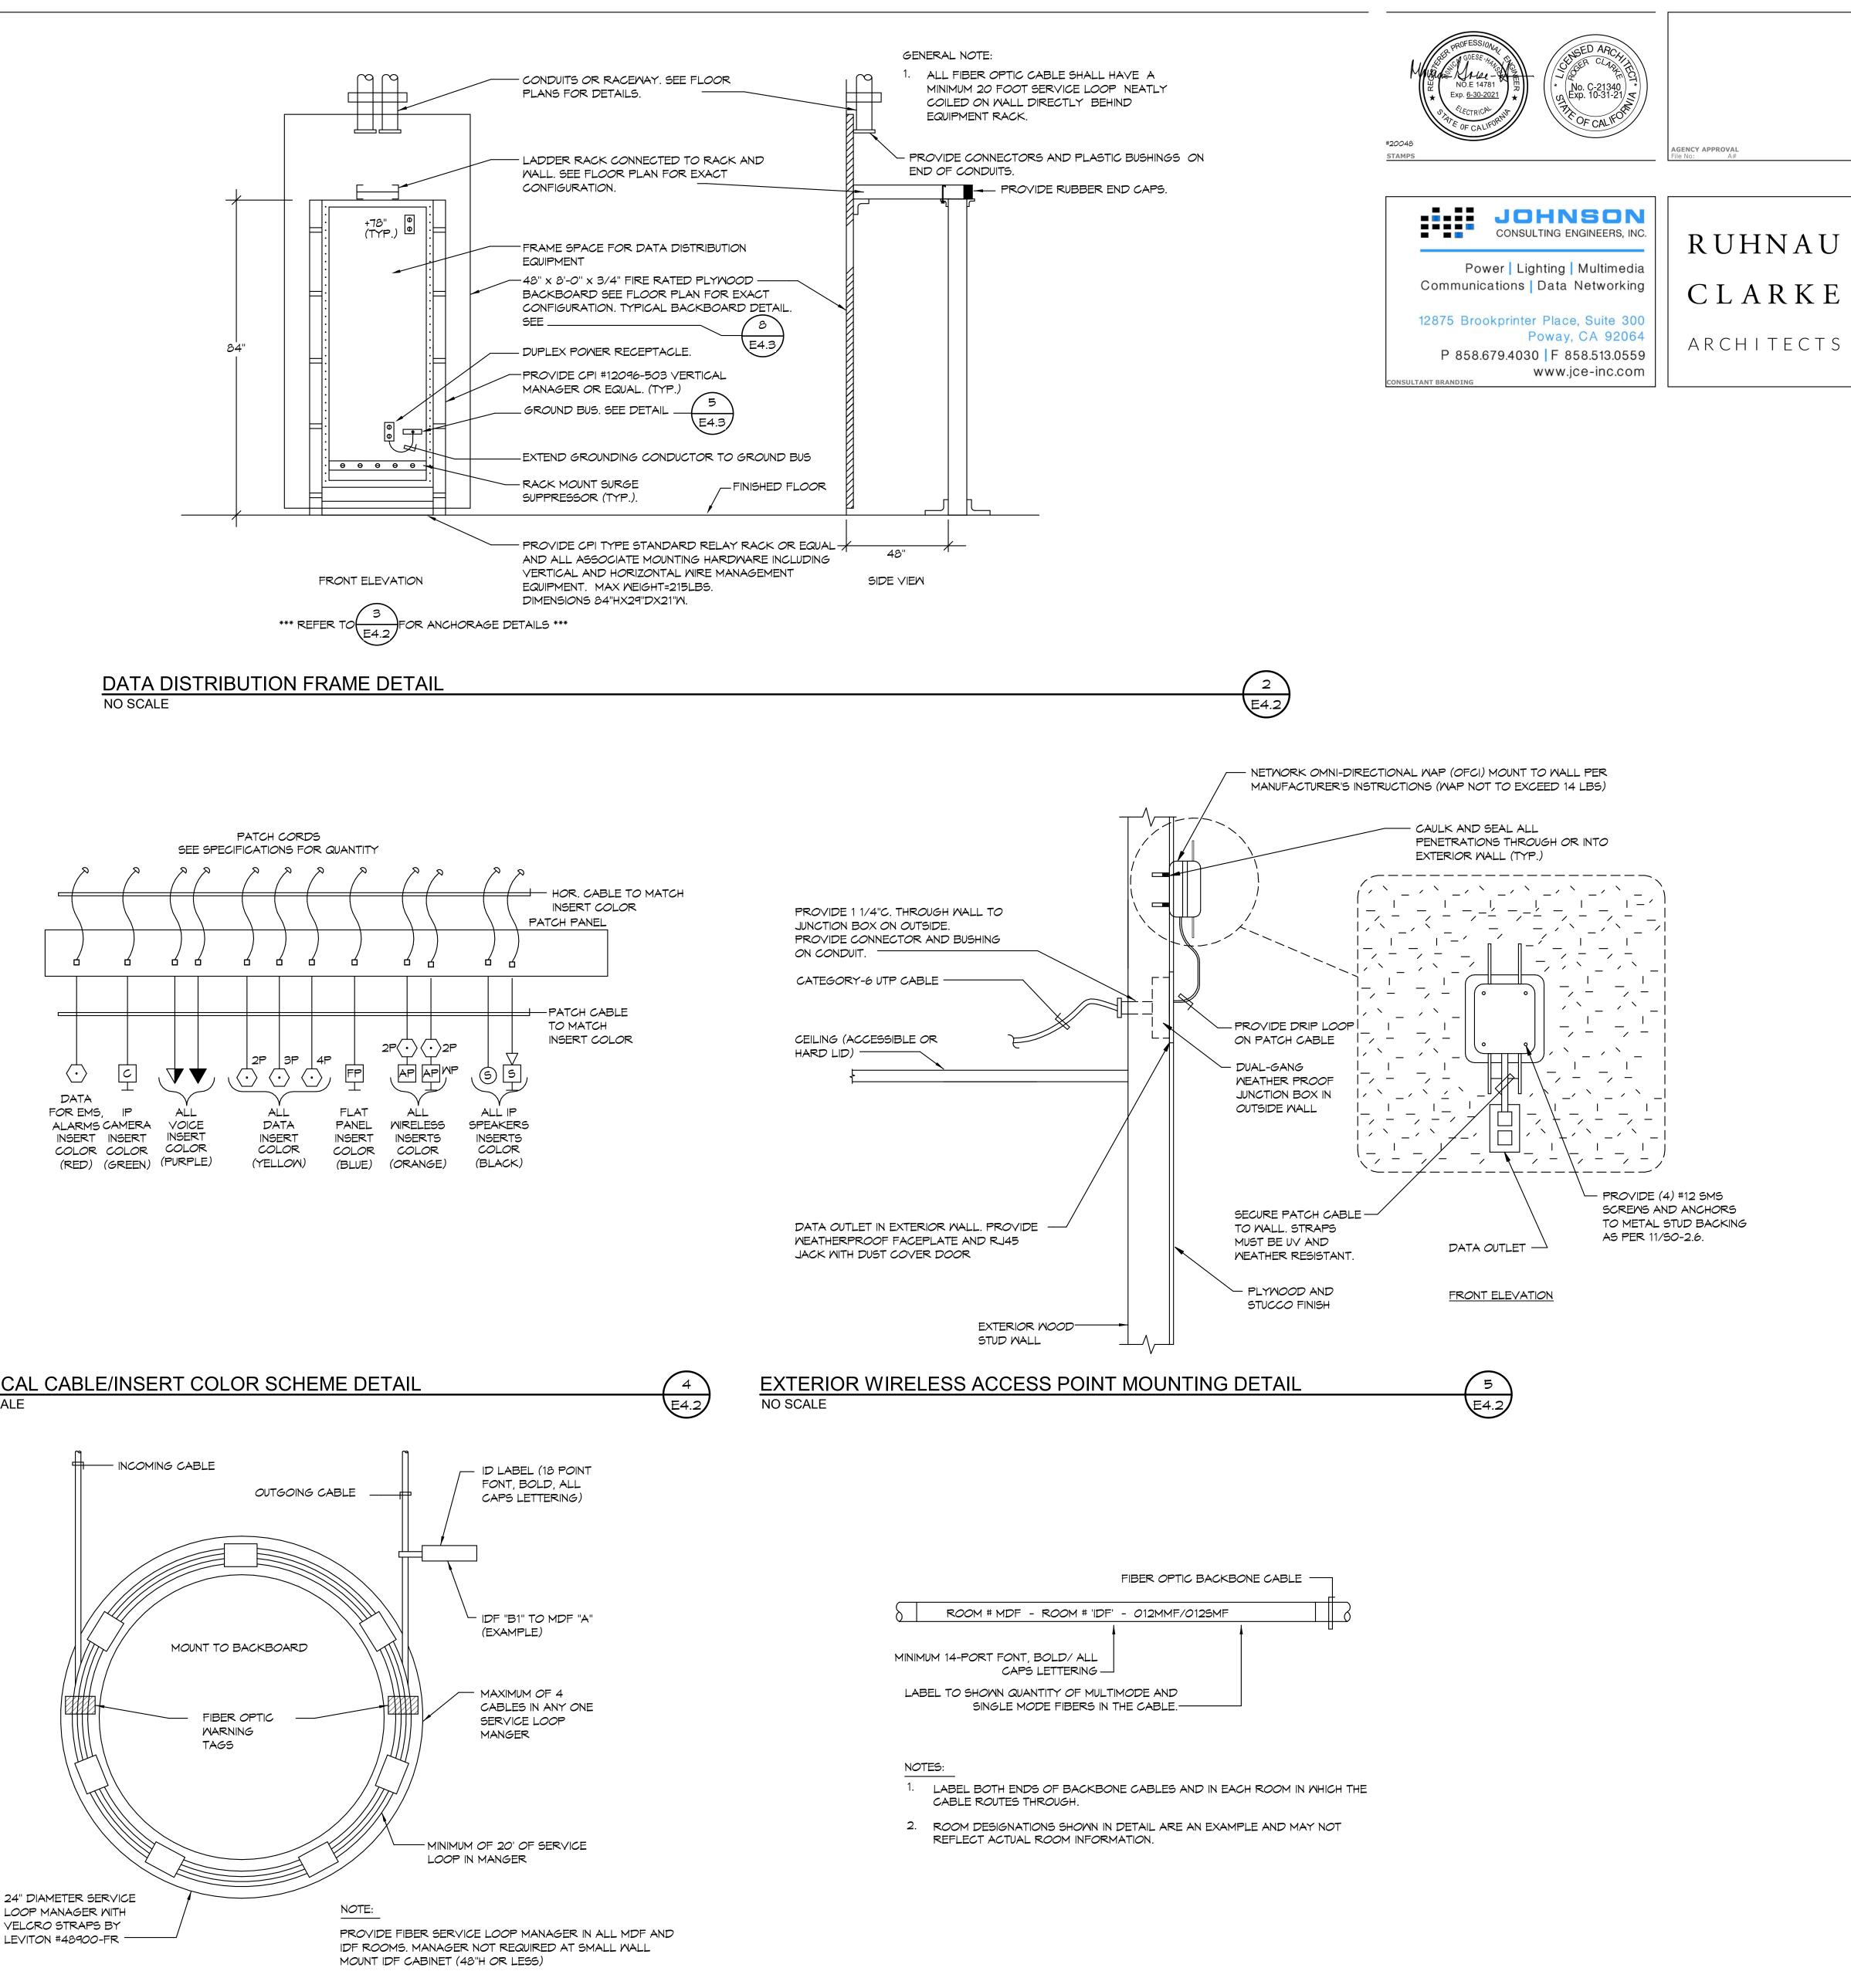

TYPICAL FIBER OPTIC FEED SERVICE LOOP DETAIL NO SCALE

RUHNAUCLARKE.COM

E4.2

TYPICAL BACKBONE LABELING DETAIL NO SCALE

> COMMUNICATION DETAILS

8


E4.2

3775 TENTH STREET, RIVERSIDE CALIFORNIA 92501(951) 684 4664 / 5751 PALMER WAY, SUITE C, CARLSBAD CALIFORNIA 9201(0⁶0) 438 5899


NEW ADMINISTRATION BUILDING

1020 PACIFIC STREET, SAN BERNARDINO, CA 92404 SAN BERNARDINO CITY UNIFIED SCHOOL DISTRICT



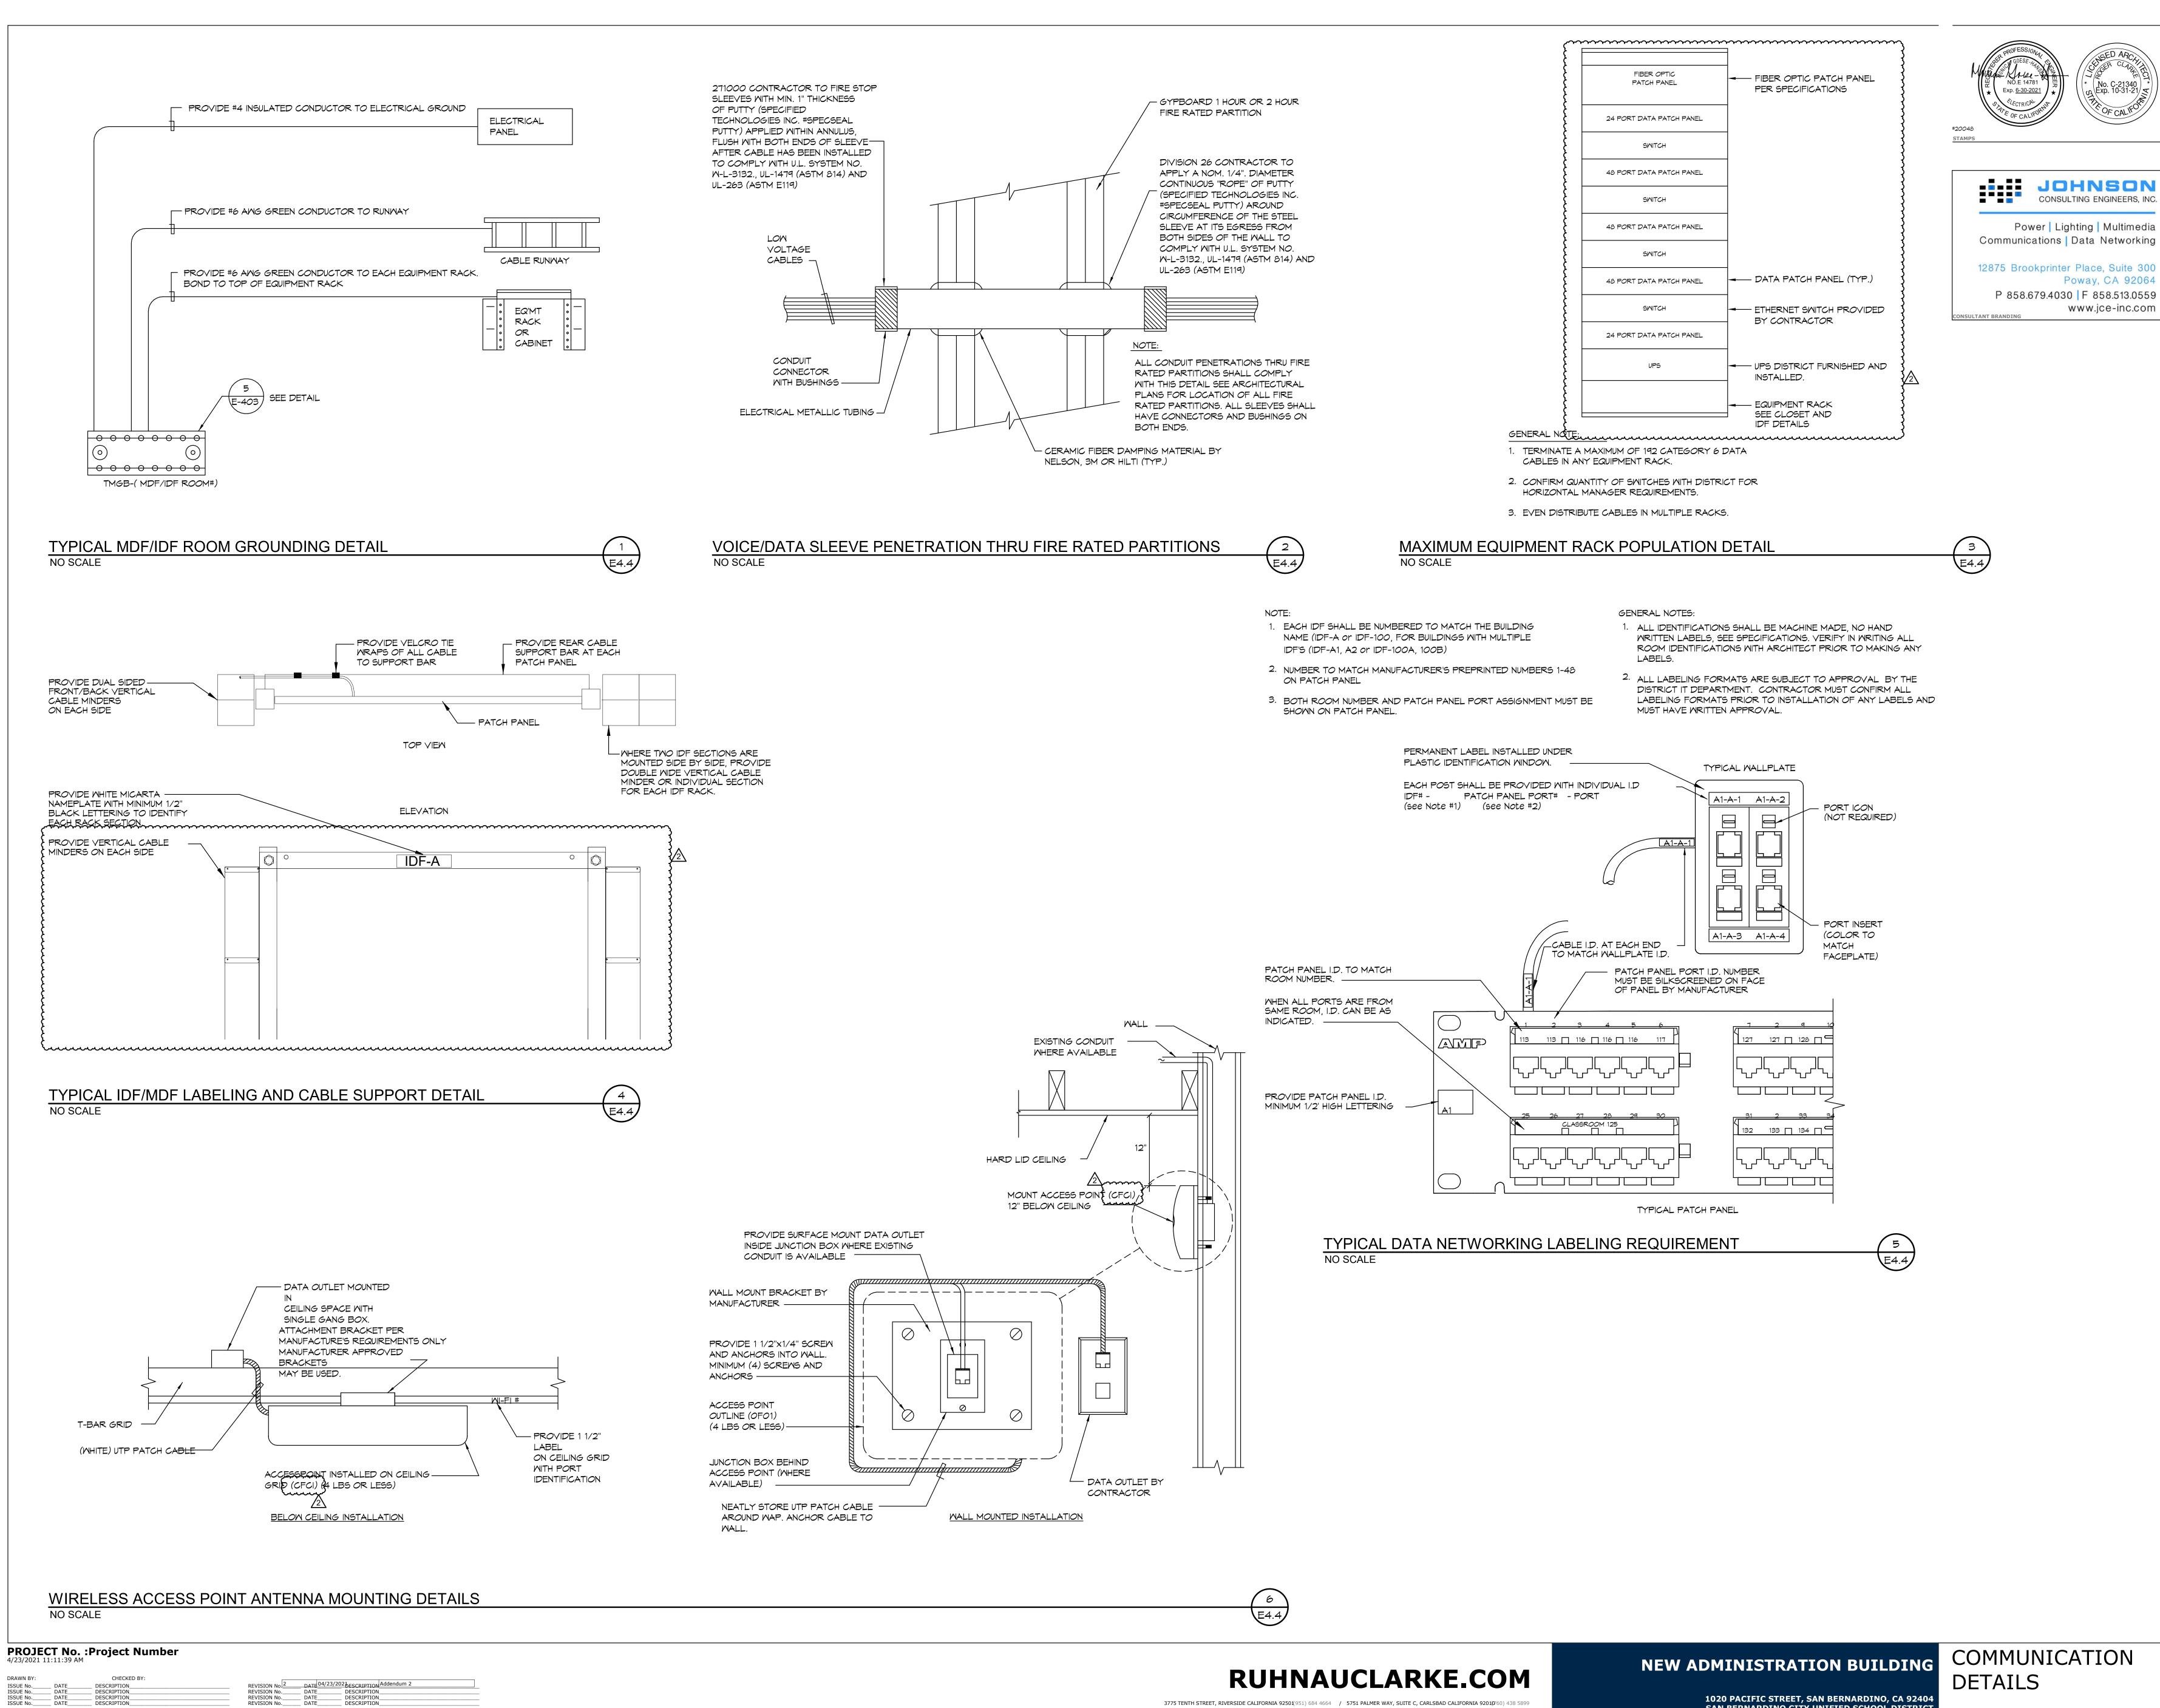


SAN BERNARDINO CITY UNIFIED SCHOOL DISTRICT

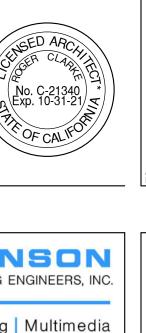



GENCY APPROVAL



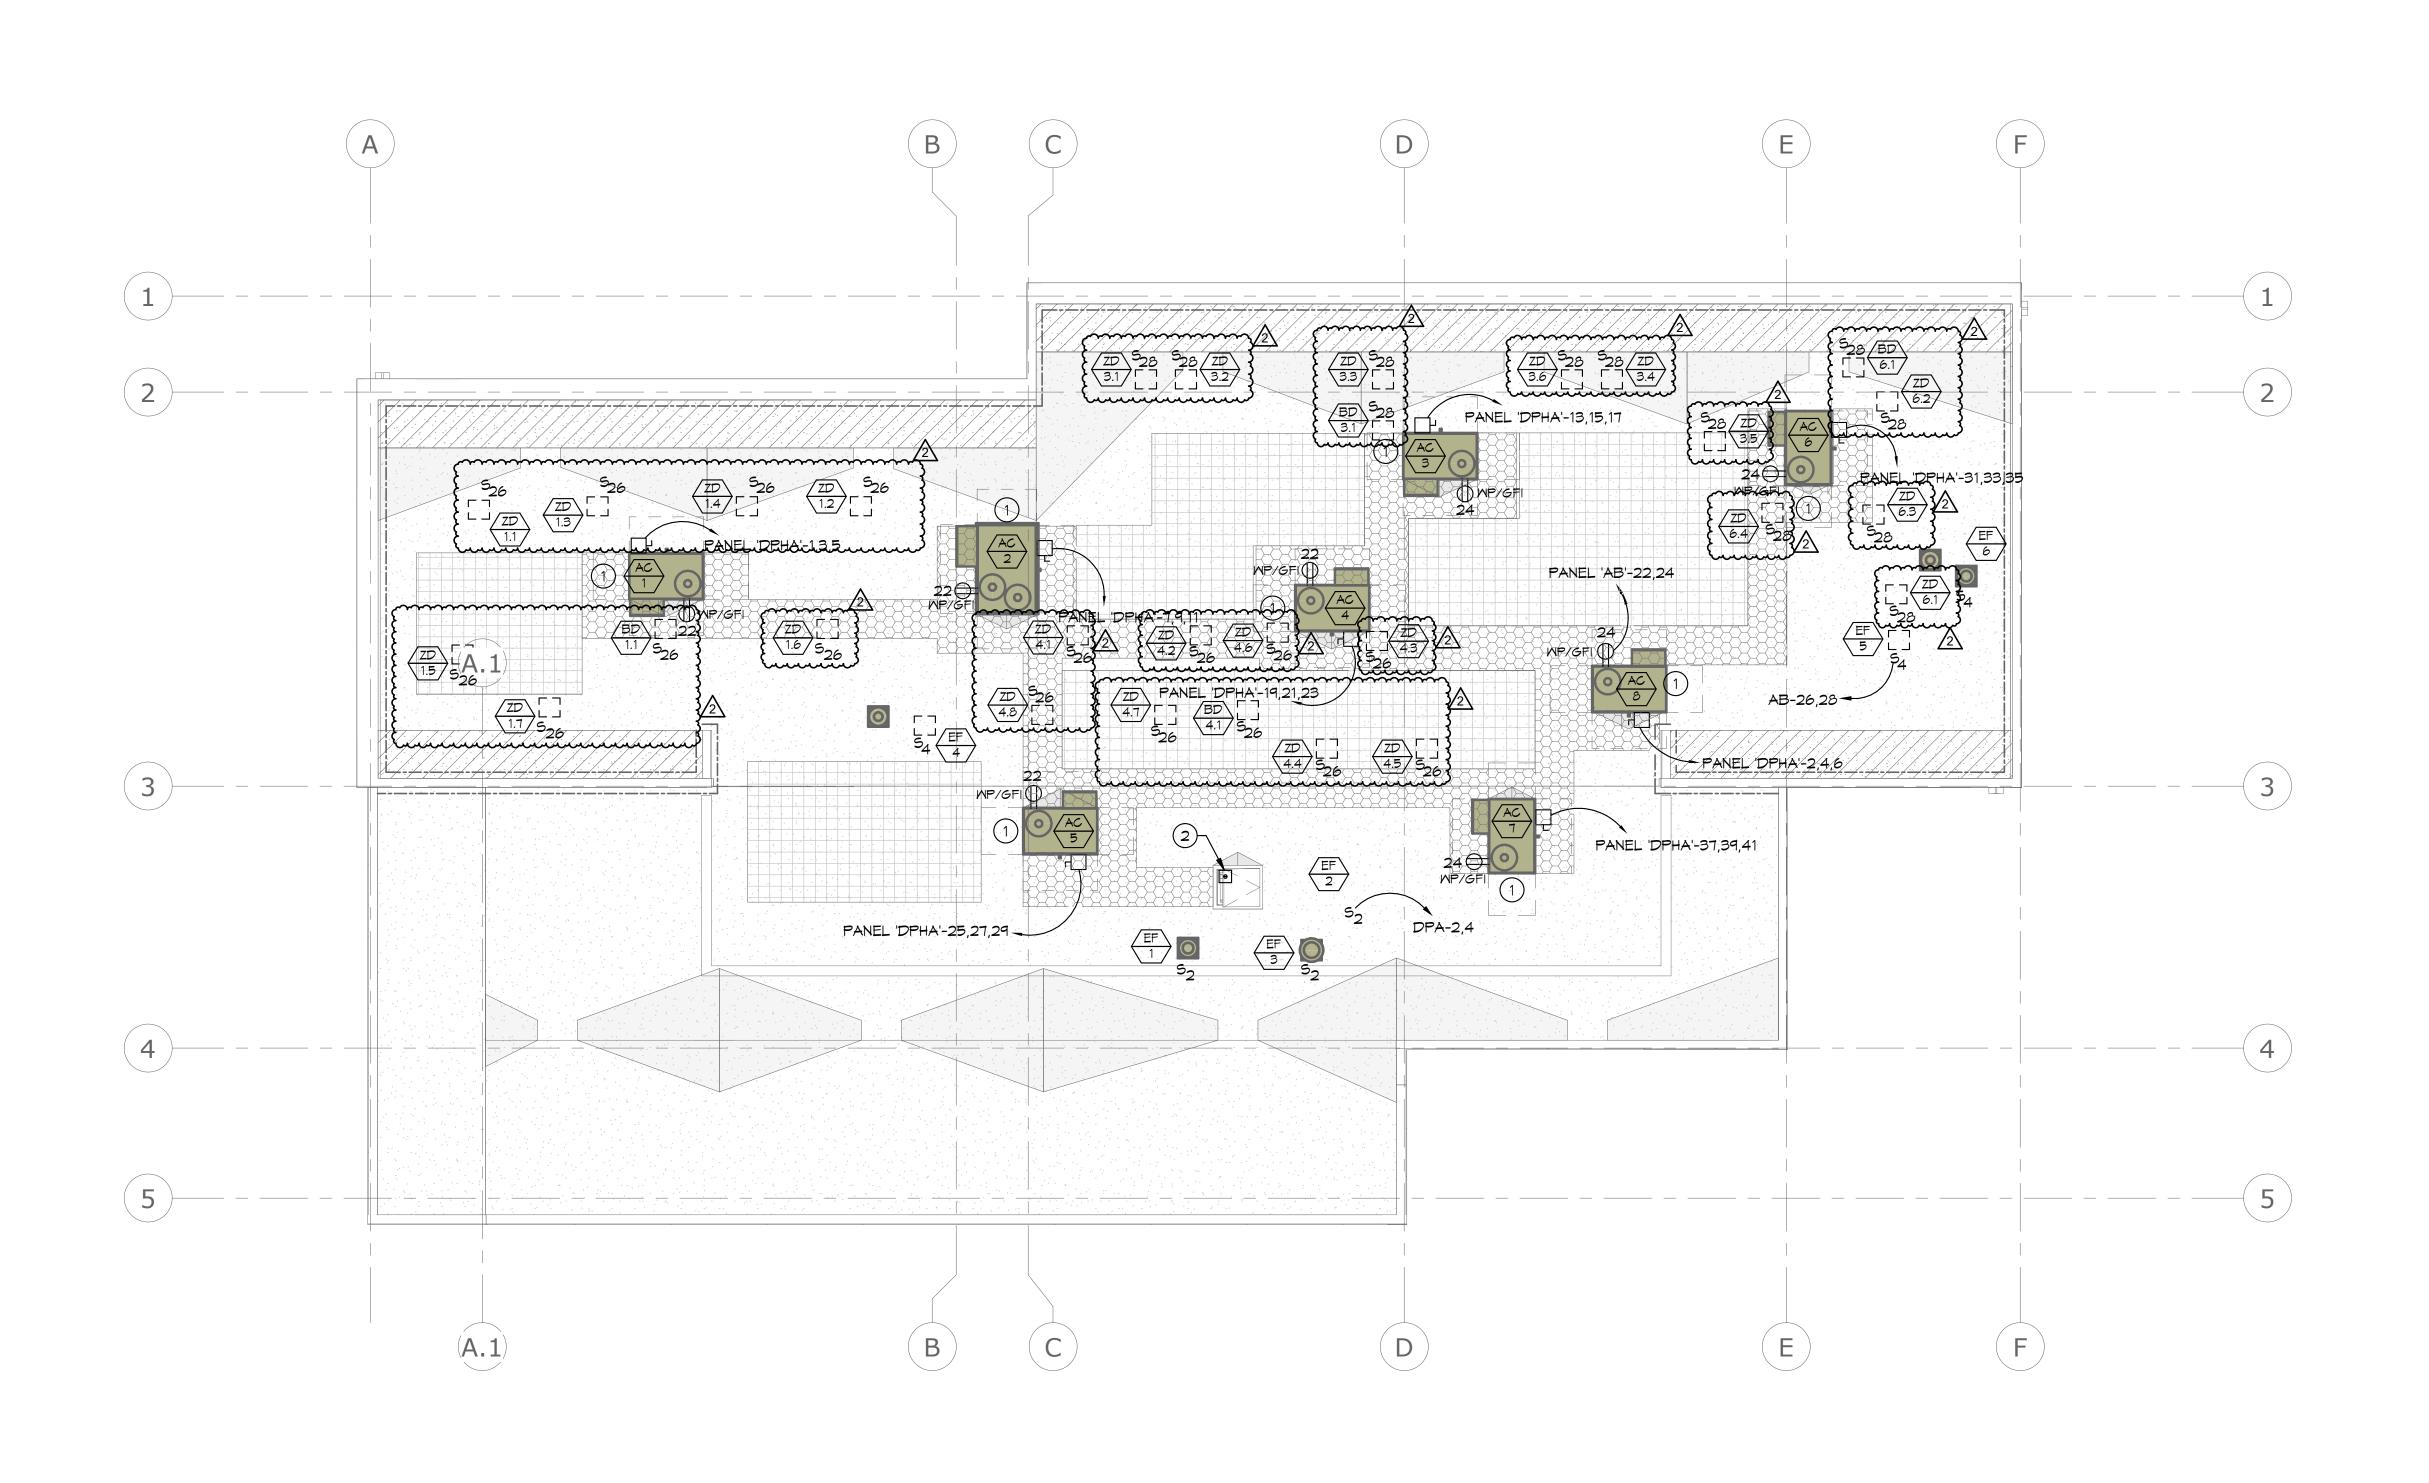

PROJECT No. :Project Number 4/23/2021 11:11:42 AM

CHECKED BY: ____ DESCRIPTION____ ___ DESCRIPTION___ ____ DESCRIPTION___ DRAWN BY: ISSUE No.____ ISSUE No.____ ISSUE No.____ ISSUE No.____ DATE____ DATE____ DATE____ DATE____


 REVISION No.
 DATE
 04/23/202
 Description
 Addendum 2

 REVISION No.
 DATE
 DESCRIPTION

 REVISION No.
 DATE
 DESCRIPTION

 REVISION No.
 DATE
 DESCRIPTION

 REVISION No.
 DATE
 DESCRIPTION

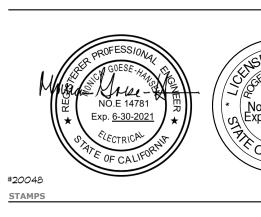

JOHNSON CONSULTING ENGINEERS, INC.

Power | Lighting | Multimedia Communications | Data Networking

12875 Brookprinter Place, Suite 300

P 858.679.4030 | F 858.513.0559

GENERAL NOTES:

CONSULTANT BRANDING

- LOCATIONS PRIOR TO ROUGH-IN. (U.O.N.).
- DISCONNECT.

KEY NOTES:

ROOF PLAN | SCALE: 1/8" = 1'-0" 1



1020 PACIFIC STREET, SAN BERNARDINO, CA 92404 SAN BERNARDINO CITY UNIFIED SCHOOL DISTRICT

NEW ADMINISTRATION BUILDING ROOF PLAN



Poway, CA 92064 www.jce-inc.com

RUHNAU C L A R K E ARCHITECTS

1. REFERENCE MECHANICAL PLANS FOR EXACT EQUIPMENT

2. DASHED EQUIPMENT INDICATES THAT EQUIPMENT IS LOCATED WITHIN CEILING SPACE. ALL OTHER EQUIPMENT IS ROOF MOUNTED

GENCY APPROVAL

3. ALL CONDUIT FEEDERS TO ROOF MOUNTED EQUIPMENT SHALL BE RUN CONCEALED IN CEILING SPACE WHERE EQUIPMENT CURBS ARE PROVIDED. ROUTE FEEDER UP THROUGH CURB TO EQUIPMENT

4. REFERENCE SHEET E6 SERIES MECHANICAL EQUIPMENT SCHEDULE FOR CONDUIT, WIRE AND DISCONNECT REQUIREMENTS.

5. REFERENCE E5. SERIES SHEETS FOR UNITS WHICH REQUIRE DUCT TYPE SMOKE DETECTOR CONNECTIONS.

1 MECHANICAL TO PROVIDE RECEPTACLE WITH UNIT. PROVIDE 120V POWER TO RECEPTACLE.





		MECHANIC	CAL EQUIP	MENT SCHED	ULE					MECHANIC	CAL EQUIF	MENT SCHEE	DULE		
IARK	VOLTAGE/	CONDUIT/ WIRE	m	~~DISC~SWITCH~~	RANEL	~~~~	······································	A MARK	VOLTAGE/ PHASE	CONDUIT/ WIRE	FUSE	DISC. SWITCH	PANEL		REMARKS
ZD	120V / 1PH	3/4"C. 3#12, 1#12GND	N/A	MAN. MTR STARTER	SEE PLANS	14	WATTS (3)	$\left\{ \begin{array}{c} AC \\ 1 \end{array} \right\}$	480V / 3PH	1"C. 3#10, 1#10GND	20	30A / 3P / 3R	SEE PLANS	15	MCA 2
BD	120V / 1PH	3/4"C. 3#12, 1#12GND	N/A	MAN. MTR STARTER	SEE PLANS	14	WATTS 3	AC 2	480V / 3PH	1"C. 3#10, 1#10GND	25	30A / 3P / 3R	SEE PLANS	22	MCA 2
uuuu	·····	······	m	·······································	h	mu	······	3 AC 3	480V / 3PH	1"C. 3#10, 1#10GND	15	30A / 3P / 3R	SEE PLANS	12	MCA 1
								AC 4	480V / 3PH	1"C. 3#10, 1#10GND	15	30A / 3P / 3R	SEE PLANS	13	MCA 1
								AC 5	480V / 3PH	1"C. 3#10, 1#10GND	15	30A / 3P / 3R	SEE PLANS	12	MCA 1
								AC 6	480V / 3PH	1"C. 3#10, 1#10GND	15	30A / 3P / 3R	SEE PLANS	12	MCA 1
EF 1	120V / 1PH	1"C. 3#10, 1#10GND	N/A	MAN. MTR STARTER	SEE PLANS	60	WATTS	AC 7	480V / 3PH	1"C. 3#10, 1#10GND	15	30A / 3P / 3R	SEE PLANS	12	MCA 1
EF 2	120V / 1PH	1"C. 3#10, 1#10GND	N/A	MAN. MTR STARTER	SEE PLANS	74	WATTS	AC 8	480V / 3PH	1"C. 3#10, 1#10GND	15	30A / 3P / 3R	SEE PLANS	12	MCA 1
EF 3	120V / 1PH	1"C. 3#10, 1#10GND	N/A	MAN. MTR STARTER	SEE PLANS	0.4	HP (8.6 FLA)								
$\left\langle \frac{EF}{4} \right\rangle$	120V / 1PH	1"C. 2#10, 1#10GND	N/A	MAN. MTR STARTER	SEE PLANS	46	WATTS								
EF 5	120V / 1PH	1"C. 2#10, 1#10GND	N/A	MAN. MTR STARTER	SEE PLANS	63	WATTS								
EF 6	120V / 1PH	1"C. 2#10, 1#10GND	N/A	MAN. MTR STARTER	SEE PLANS	65	WATTS								

PROJECT No. :Project Number 4/23/2021 11:11:43 AM


CHECKED BY: ____ DESCRIPTION____ ___ DESCRIPTION___ ____ DESCRIPTION___ DRAWN BY: ISSUE No._____ ISSUE No._____ ISSUE No._____ ISSUE No._____ ____ DATE____ ___ DATE____ ___ DATE____ __ DATE____



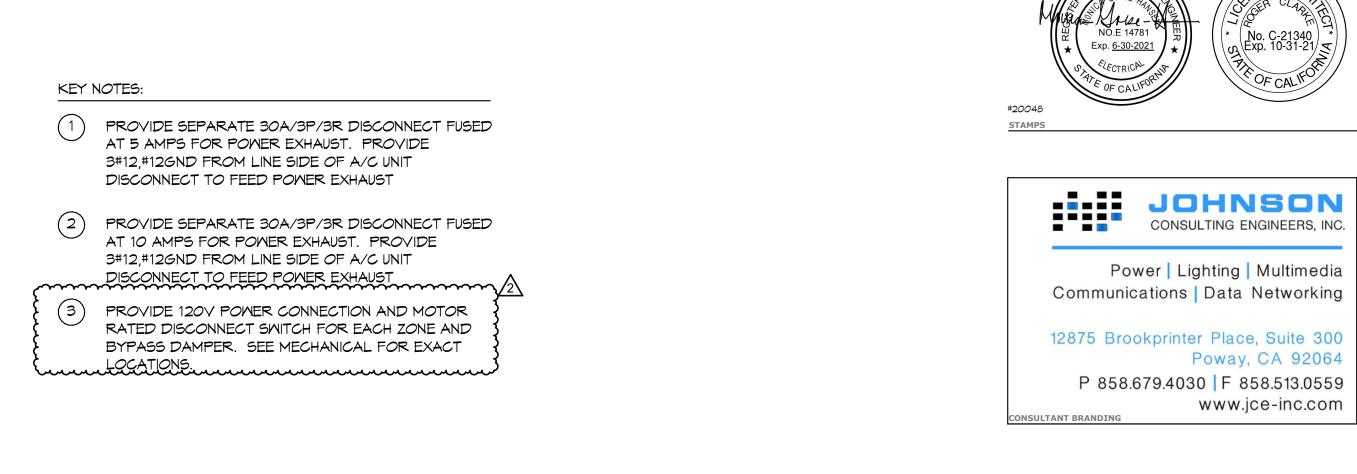

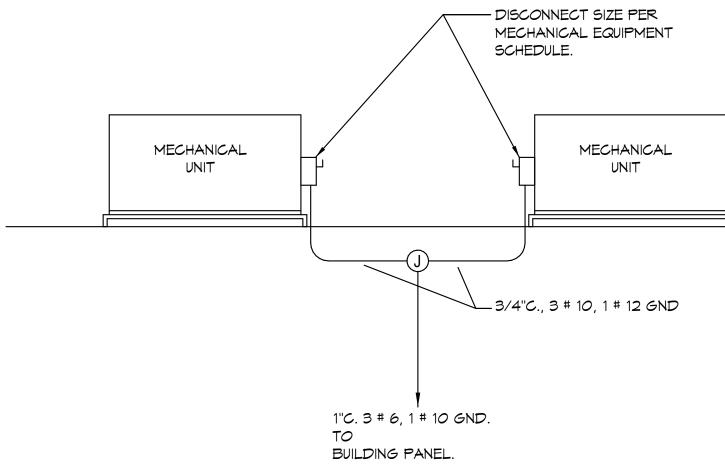


TYPICAL MECHANICAL UNIT COMBINATION FEEDER DETAIL NO SCALE

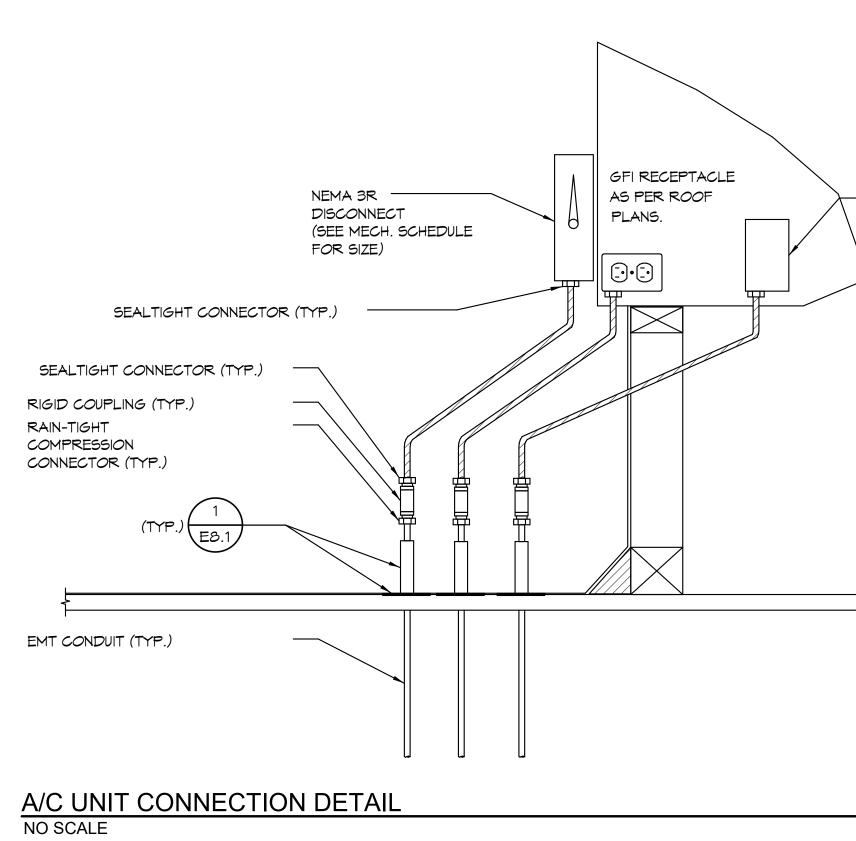



MECHANICAL SCHEDULE

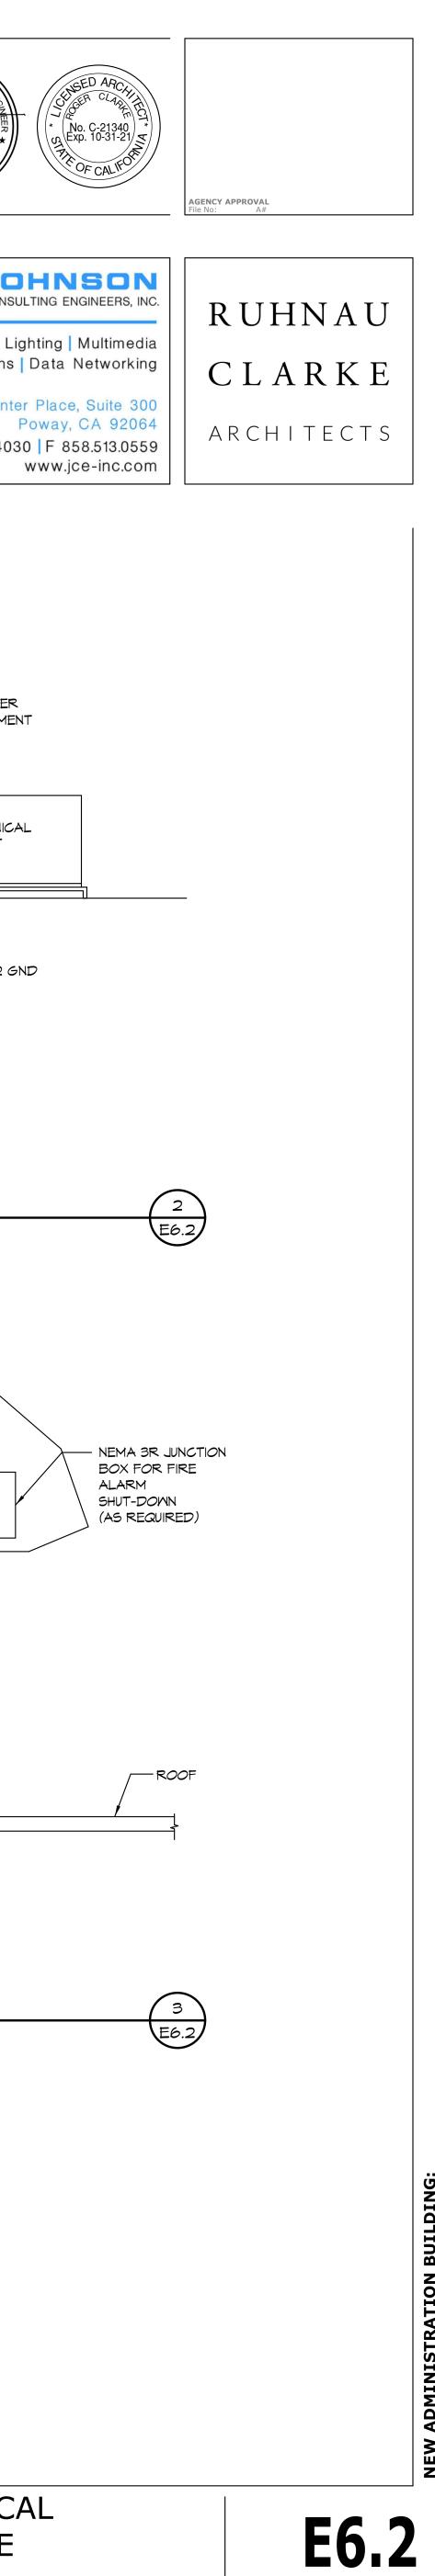



120/208	•	120/208 3PH, 4WIRE					Main	Breaker			ENCLO	SURE TYPE	ENCL
120/200	•	200% Neutral Bus		20	0	AMP	Main	Lug	Х		х	NEMA TYPE 1	
		(INTEGRAL)TVSS Protection	Х] 20	U	AIVIE	Enclosure	Recessed				NEMA TYPE 3R]
AA		(REMOTE)TVSS Protection	_					Surface	Х			NEMA TYPE 4X	
~~		Service Entrance Rated				RIBUTION						L EMERGENCY LI	
		Load Side Feed thru Lugs				UIREMENTS :						D FROM THIS PAI	
LCL	NHL	CIRCUIT DESCRIPTION	AMP 20	POLE	NO	PHASE A 600	PHASE B	PHASE C	NO	AMP	POLE	CIRCUIT DESC	RIPTIC
	X	RECEPTACLES		'	-	800		_	2	20	1	RECEPTACLES	
	Х	RECEPTACLES	20	1	3		600 800		4	20	1	RECEPTACLES	
	Х	RECEPTACLES	20	1	5			600 800	6	20	1	RECEPTACLES	
	Х	FLAT PANEL TV	20	1	7	1000 600			8	20	1	RECEPTACLES	
	Х	RECEPTACLES	20	1	9		600 600		10	20	1	RECEPTACLES	
	Х	RECEPTACLES	20	1	11			600 600	12	20	1	RECEPTACLES	
	Х	RECEPTACLES	20	1	13	600 600]		14	20	1	RECEPTACLES	
	Х	RECEPTACLES	20	1	15		600 600		16	20	1	RECEPTACLES	
	Х	RECEPTACLES	20	1	17			600 600	18	20	1	RECEPTACLES	
	Х	RECEPTACLES	20	1	19	600 600			20	20	1	RECEPTACLES	
	Х	COPY MACHINE	20	1	21		800 600		22	20	1	RECEPTACLES	
	Х	COPY MACHINE	20	1	23			800 600	24	20	1	RECEPTACLES	
	Х	FLAT PANEL TV	20	1	25	1000 600			26	20	1	RECEPTACLES	
	Х	RECEPTACLES	20	1	27		600 600		28	20	1	RECEPTACLES	
	Х	RECEPTACLES	20	1	29			600 600	30	20	1	RECEPTACLES	
	Х	RECEPTACLES	20	1	31	600 600			32	20	1	RECEPTACLES	
		SPARE	20	1	33		600		34	20	1	RECEPTACLES	
		SPARE	20	1	35				36	20	1	SPARI	E
		SPARE	20	1	37				38	20	1		SP
		SPARE	20	1	39				40	20	1		SP
		SPARE	20	1	41				42	20	1		SP
SPECIAL	PANEL	PROVIDE 54 CIRCUIT PANEL							NOTE				
NOTE									NOTE	#2			
	n Harmon			DAD PER P			7000	6400			0000	10 0 cf = 1/4 C	\
LCL= Loi	ng Continu	ious Load 25% LONG	CONT	INUOUS L	OADS	0	0	0		PHASE HASES	8200 21600		
		SUB P	ANEL						ALLP	MOED	21000	1 . o.opi – 177 (d	, 2001
Max. Neu		SUB P							DEMAN	ID PER		<u> </u>	_
0	AMPS	ΤΟΤΑ	L CO	NNECTED	LOAD	8200	7000	6400		CE	C 220-86		1

M:\Panel Schedule\2020\20048 Pacific HS Admin\AA.xls

120/208	T	120/208 3PH, 4WIRE					Main	Breaker	Х		ENCLO	SURE TYPE	ENCL
120/200	•	200% Neutral Bus		40	0	AMP	Main	Lug			х	NEMA TYPE 1	
		(INTEGRAL)TVSS Protection	Х	1 40	U	AIVIE	Enclosure	Recessed				NEMA TYPE 3R]
DPA	۱	(REMOTE)TVSS Protection						Surface				NEMA TYPE 4X	
		Service Entrance Rated				RIBUTION						L EMERGENCY LI	
		Load Side Feed thru Lugs								1		D FROM THIS PAI	
LCL	NHL	CIRCUIT DESCRIPTION	AMP	POLE	NO	PHASE A	PHASE B	PHASE C	NO	AMP	POLE	CIRCUIT DESC	RIPTIC
		EF-1,2,3	20	1	1	500			2	20	1	SPARI	Ξ
		EF-4,5,6	20	1	3		500		4	20	1	SPAR	Ξ
		SPARE	20	1	5		_		6	20	1	SPARI	E
		SPARE	20	1	7				8	20	1	SPARI	E
		SPARE	20	1	9				10	20	1	SPAR	E
		SPARE	20	1	11		_		12	20	1	SPAR	E
		SPARE	20	1	13				14	20	1	SPAR	E
		SPARE	20	1	15				16	20	1	SPAR	=
		SPARE	20	1	17		_		18	20	1	SPAR	=
		SPARE	20	1	19				20	20	1	SPAR	E
		SPARE	20	1	21				22	20	1	SPAR	E
		SPARE	20	1	23		_		24	20	1	SPAR	E
		SPARE	20	1	25			_	26	20	1	SPAR	E
		SPARE	20	1	27				28	20	1	SPAR	E
		SPARE	20	1	29		_		30	20	1	SPAR	E
		SPACE	20	1	31				32	20	1		SP
		SPACE	20	1	33				34	20	1		SP
		SPACE	20	1	35		_		36	20	1		SP
	х	PANEL 'AA'	200	3	37	8200 10100			38	200	3	PANEL 'AB'	
	х		-	-	39		7000 11500		40	-	-		
	х		-	-	41			6400 13800	42	-	-	"	
SPECIAL	. PANEL								NOTE				
NOTE									NOTE	#2			
	n Harmon ng Continu			DAD PER I INUOUS I		18800 0	19000 0	20200 0		PHASE	20200 58000		
Max. Neu	it Load	SUB PA							DEMAN				
7	AMPS			NNECTED		18800	19000	20200	DEMAN		C 220-86		٦
'	Am 3	TOTA	- 00	NINEGIED	LOAD	10000	19000	20200			.0 220-00		


M:\Panel Schedule\2020\20048 Pacific HS Admin\DPA.xls

ATT/TWO 200% Neural Bus (INTEGRATUYSS Protection) AMP Man Luc X Enclosure X X NEMA TYPE I NEMA TYPE 3 Surface HAL (REMOTE TYSS Protection) GENERAL DISTRIBUTION Provide 10x 0x0 m86.Xer Develops 0 Surface NEMA TYPE 3 NEMA TYPE 3 Surface NEMA TYPE 3 NEMAGENER ULL Surface NEMA TYPE 3 NEMAGENER ULL Surface NEMA TYPE 3 NEMAGENER ULL Surface NEMA TYPE 3 Surface NEMA TYPE 3 NEMAGENER ULL Surface NEMA TYPE 3 Surface NEMA TYPE 3 NEMAGENER ULL Surface NEMA TYPE 3 Surface NEMA TYPE 3 Surface <td< th=""><th>277/480</th><th>•</th><th>277/480 3PH, 4WIRE</th><th></th><th></th><th></th><th></th><th>Main</th><th>Breaker</th><th></th><th></th><th>ENCLO</th><th>SURE TYPE</th><th>EN</th></td<>	277/480	•	277/480 3PH, 4WIRE					Main	Breaker			ENCLO	SURE TYPE	EN
INTEGRAL/TYSS Protection IUU ANIT Enclosure Researd NEMA TYPE 3R HAL (REMOTIVSS Protection Service Entrance Rated GENERAL DISTRIBUTION PROVIDE LOCK ON BREAKER DEVICES FOR ALL EMERGENCY LIGHT Load Side Feed thru Lugy BREAKER REOUREMENTS: MOTORS, AND FIRE ALAMR COUNTENENT SERVED FOR THIS PAREL CICUIT DESCRIPTION AMP POLE CICUIT DESCRIPTION LICK NHL CIRCUIT DESCRIPTION AMP POLE NOTORS AND FIRE ALAMR COUNTENENT SERVED FOR THIS PAREL LICK NHL CIRCUIT DESCRIPTION AMP POLE CIRCUIT DESCRIPTION LIGHTING 20 1 2 0 1 Extension LIGHTING LIGHTING 20 1 7 1000 300 6 20 1 SPARE LIGHTING INVERTER 20 1 11 11 12 20 1 SPARE LIGHTING INVERTER 20 1 13 14 20 1 SPARE LIGHTING INVERTER 20 1 15 16 20	211/400	-			10	Δ		Main	Lug	Х		х	NEMA TYPE 1	
HAL (REMOTE JTVSS Protection Service Entrance Rando Generation Rando Service For AL Lead Side Feed thru Lugs Service Service For AL LemeRecive CV Light BREAKER REQUIREMENTS : MOTORS, AND FIRE ALARM EQUIPMENT SERVEJ FROM THIS PANEL LCC NHL CIRCUIT DESCRIPTION AMP POLE 0 AMP POLE CIRCUIT DESCRIPTION AMP POLE 0 AMP POLE CIRCUIT DESCRIPTION AMP POLE CIRCUIT DESCRIPTION <t< td=""><td></td><td></td><td>(INTEGRAL)TVSS Protection</td><td></td><td>טו ן</td><td>U</td><td>AIVIP</td><td>England</td><td>Recessed</td><td></td><td></td><td></td><td></td><td></td></t<>			(INTEGRAL)TVSS Protection		טו ן	U	AIVIP	England	Recessed					
Usame Data of an end of the part of t			(REMOTE)TVSS Protection					Enclosure	Surface	Х			NEMA TYPE 4X	1
LCL NHL CIRCUIT DESCRIPTION AMP POLE NO PHASE A PHASE B PHASE C NO AMP POLE CIRCUIT DESCRIPT I LIGHTING 20 1 1 1200	ΠAL	•	Service Entrance Rated		GENERA	L DIST	RIBUTION	PROVIDE LO	CK ON BREAK	ER DE	VICE	S FOR AL	L EMERGENCY L	IGHTI
LIGHTING 20 1 3 1200 22 20 1 EXTERIOR LIGHTING LIGHTING 20 1 3 500 1000 4 20 1 EXTERIOR LIGHTING LIGHTING 20 1 5 500 1000 6 20 1 STERIOR LIGHTING LIGHTING 20 1 7 1000 6000 6 20 1 STERIOR LIGHTING LIGHTING 20 1 7 1000 8 20 1 STERIGRIC LIGHTING LIGHTING 20 1 7 1000 8 20 1 STERIGRIC LIGHTING LIGHTING 20 1 13 11 12 20 1 STERIGRIC LIGHTING LIGHTING SPARE 20 1 13 11 12 20 1 STERIGRIC LIGHTING LIGHTING SPARE 20 1 13 12 12 12 13 1			Load Side Feed thru Lugs		BREAKE	R REQI	JIREMENTS :	MOTORS, AN	D FIRE ALARM	I EQUI	PMEN	IT SERVE	D FROM THIS PA	NEL
LIGHTING 20 1 300 1000 4 20 1 EXTERIOR LIGHTING I.IGHTING 20 1 500 1300 6 20 1 EXTERIOR LIGHTING I.IGHTING 20 1 7 1000 6 20 1 STE LIGHTING I.IGHTING INVERTER 20 1 7 1000 6 20 1 STE LIGHTING I.IGHTING INVERTER 20 1 7 1000 6 20 1 SPARE I.IGHTING INVERTER 20 1 11 7 1000 6 20 1 SPARE I.IGHTING INVERTER 20 1 11 7 1000 16 20 1 SPARE I.IGHTING INVERTER 20 1 15 16 20 1 SPARE I.IGHTING INVERTER 20 1 15 16 20 1 SPARE I.IGHTING INVERTER 20 1 15 16 20 1 SPARE I.IGHTING INVERTER 20<	LCL	NHL	CIRCUIT DESCRIPTION	AMP	POLE	NO	PHASE A	PHASE B	PHASE C	NO	AMP	POLE	CIRCUIT DES	CRIPT
Lighting 20 1 Extremon Lighting 1 Lighting inverter 20 1 7 1000 6 20 1 STE Lighting 1 Lighting inverter 20 1 9 100 6 20 1 STE Lighting 1 Spare 20 1 9 12 12 12 12 12 13 12 12 12 13 12 12 13 12 12 13 12 14 20 1 Spare 13 14 20 1 Spare 13 12 14 20 1 Spare 13 14 14 20 1 15 14 14 14 20 1 14 14 14 <td></td> <td></td> <td>LIGHTING</td> <td>20</td> <td>1</td> <td>1</td> <td></td> <td></td> <td>_</td> <td>2</td> <td>20</td> <td>1</td> <td>EXTERIOR LIGH</td> <td>TING</td>			LIGHTING	20	1	1			_	2	20	1	EXTERIOR LIGH	TING
LIGHTING LOGATING Control of the sector of the secto			LIGHTING	20	1	3				4	20	1	EXTERIOR LIGH	TING
LIGHTING INVERTER I			LIGHTING		-	5		_		6	20	1	SITE LIGHTING	
SPARE Control Contro Control Control			LIGHTING INVERTER		1	7	1000			8	20	1	SPAR	E
SPARE Control SPARE			SPARE		-					10	20	1	SPAR	E
Image: spakeImage: spake<			SPARE		-					12	20	1	SPAR	E
Image: space			SPARE							14	20	1	SPAR	E
SPARE C Image: Space s			SPARE		-					16	20	1	SPAR	E
SPARE Control Contro Control Control			SPARE		-			-		18	20	1	SPAR	E
Image: Sepace of the sepace			SPARE		-					20	20	1	SPAR	E
SPACESPACESPACESPACE20125262012620126SPACE201272820128201282012820128201302013130201313020131 </td <td></td> <td></td> <td>SPACE</td> <td></td> <td>-</td> <td></td> <td></td> <td></td> <td></td> <td>22</td> <td>20</td> <td>1</td> <td></td> <td>5</td>			SPACE		-					22	20	1		5
Image: Normal synce interval in			SPACE		-			-		24	20	1		5
SPACE 20 1 29 30 20 1 34 20 1 34 20 1 30 36 20 1 36 20 1 36 20 1 38 20 1 38 20 1 38 20 1 36 20 1 36 20 1 36 20 1 36 20 1 36 20 1 38 20 1 36 20 1 36 20 1 36 <			SPACE		-					26	20	1		ę
$ \begin{array}{ c c c c c c c c c c c c c c c c c c c$			SPACE		-					28	20	1		5
SPACE 20 1 33 34 20 1 34 20 1 34 20 1 34 20 1 34 20 1 34 20 1 34 20 1 34 20 1 34 20 1 34 20 1 34 20 1 34 20 1 34 20 1 34 20 1 34 20 1 34 20 1 35 36 20 1 36 20 </td <td></td> <td></td> <td>SPACE</td> <td></td> <td>-</td> <td></td> <td></td> <td></td> <td></td> <td>30</td> <td>20</td> <td>1</td> <td></td> <td>5</td>			SPACE		-					30	20	1		5
Image: SPACE I			SPACE		-					32	20	1		5
Image: Space of the space o			SPACE		-					34	20	1		5
Image: SPACE I			SPACE		-					36	20	1		5
SPACE 20 1 41 SPACE 20 1 41 SPECIAL PANEL NOTE 20 1 NOTE 42 20 1 NOTE 42 20 1 NOTE 42 20 1 NOTE 1 1 NOTAL LOAD PER PHASE 2700 1500 1900 ICL= 1 1 1 SUB PANEL 1 1 Max. Neut. Load 1 1 Max. Neut. Load 1 1 Note 1 1 Note 1 1 Note 1 1 1 <			SPACE		-			<u> </u>		38	20	1		5
SPACE 42 20 1 SPECIAL PANEL NOTE			SPACE		-					40	20	1		5
NOTE NOTE #2 NHL= Non Harmonic Load TOTAL LOAD PER PHASE 2700 1500 1900 LCL= Long Continuous Load 25% LONG CONTINUOUS LOADS 0 0 0 HIGH PHASE 2700 / 0.9pf = VA @ Max. Neut. Load SUB PANEL Image: Period Panel <td></td> <td></td> <td>SPACE</td> <td>20</td> <td>1</td> <td>41</td> <td></td> <td></td> <td></td> <td></td> <td></td> <td>1</td> <td></td> <td>5</td>			SPACE	20	1	41						1		5
NHL= Non Harmonic Load TOTAL LOAD PER PHASE 2700 1500 1900 LCL= Long Continuous Load 25% LONG CONTINUOUS LOADS 0 0 0 1900 SUB PANEL		PANEL												
LCL= Long Continuous Load 25% LONG CONTINUOUS LOADS 0 0 0 HIGH PHASE 2700 / 0.9pf = VA @ 480 SUB PANEL	NOTE									NOTE	#2			
SUB PANEL Image: Sub panel Max. Neut. Load SUB PANEL														
	Max. Neut	t. Load]	5 .00
						LOAD	2700	1500	1900					٦


M:\Panel Schedule\2020\20048 Pacific HS Admin\HAL.xls

PROJECT No. :Project Number 4/23/2021 11:11:43 AM


DRAWN BY:		CHECKED BY:				
	ATE	DESCRIPTION	REVISION No.2	DATE 04/23/20	² DESCRIPTION	Addendum 2
ISSUE No. DA	ATE	DESCRIPTION	REVISION No.	DATE	DESCRIPTION	
ISSUE No. DA	ATE	DESCRIPTION	REVISION No.	DATE	DESCRIPTION	
ISSUE No. DA	ATE	DESCRIPTION	REVISION No.	DATE	DESCRIPTION	

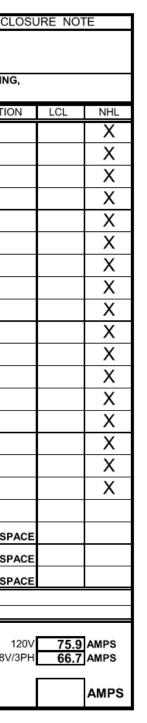

12:02 PM11/17/2020

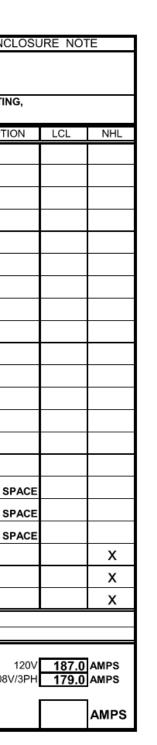

12:03 PM11/17/2020

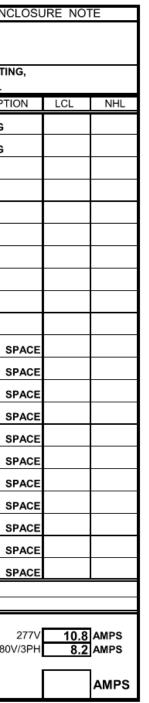


12:03 PM11/17/2020


120/208	•	120/208 3PH, 4WIRE					Main	Breaker			ENCLO	SURE TYPE ENCLOS	SURE
120/200		200% Neutral Bus		20	0	AMP	Main	Lug	Х		Х	NEMA TYPE 1	
		(INTEGRAL)TVSS Protection	Х	20	0	AWIF	Enclosure	Recessed				NEMA TYPE 3R	
AB		(REMOTE)TVSS Protection			- DIOT	DIDUTION		Surface	X	105		NEMA TYPE 4X	
		Service Entrance Rated Load Side Feed thru Lugs										L EMERGENCY LIGHTING, D FROM THIS PANEL	
LCL	NHL	CIRCUIT DESCRIPTION	AMP		NO	PHASE A	PHASE B	PHASE C	_	AMP		CIRCUIT DESCRIPTION	L
	X		20	1	1	600							
	X		20	1	3	1000	600		2	20	1		+
	X	RECEPTACLES	20	1	5		1000	600	4	20	1	DATA RACK RECEPT.	-
		RECEPTACLES	20	1	7	600	1	1000	6	20	1	DATA RACK RECEPT.	+
	X	RECEPTACLES	20	1	9	1000	1200		8	20	1	DATA RACK RECEPT.	_
	Х	WASHER					600	0500	10	20	1	LTG CONTROL	
	Х	DRYER	50	2	11		_	3500 600	12	20	1	HVAC EMS PANEL	
	Х		-	-	13	3500 600	-		14	20	1	SECURITY PANEL	
	Х	RECEPTACLES	20	1	15		600 600		16	20	1	FATC (NOTE1)	
	Х	RECEPTACLES	20	1	17			600 600	18	20	1	RECEPTACLES	
	Х	RECEPTACLES	20	1	19	600 600	1	000	20	20	1	ACCESS CONTROL	+
	X		20	1	21	000	800					ROOF RECEPTACLES	+
	X		20	1	23		200	1200	22	20	1		+
	X	MICROWAVE	20	1	25	1200	1	200	24	20	1		-
	X		20	1	27	144	800		26	20	1	ZONE/BYPASS DAMPERS	+
	X	RECEPTACLES	20	1	29		144	1200	28	20	1	ZONE/BYPASS DAMPERS	+
		MICROWAVE	20	1	31	1000	1		30	20	1	SPARE	-
	X	COPY MACHINE	20	1	33		1000		32	20	1	SPARE	_
	Х	COPY MACHINE	20	1			1000	200	34	20	1	SPARE	_
		CIRC. PUMP/CONTROL PNL			35		-	200	36	20	1	SPARE	
		FLAG POLE	20	1	37				38	20	1	SPARE	
		WH-1	60	2	39		4500		40	20	1	SPARE	
			-	-	41			4500	42	20	1	SPARE	
SPECIAL	PANEL	PROVIDE 54 CIRCUIT PANEL							NOTE			E RED LOCK-ON BREAKER	DEVIC
NOTE									NOTE	#2			
	n Harmoni			DAD PER			12044	14200					
_CL= Lon	g Continu	ous Load 25% LONG	CONT	INUOUS	LOADS	0	0	0		PHASE			
		SUB P			1 I				ALL P	HASES	37088	70.9pr = VA @ 208V/3Pr	H1
Max. Neu	t. Load	SUB P			1				DEMAN	ID PER	Х	1	
67	AMPS	τοτα		NNECTED		10844	12044	14200	I	0	C 220-86		


277/480 🔻		277/480 3PH, 4WIRI				Main	Breaker	X		ENCLOSURE TYPE		ENCLOSURE NO		
		200% Neutral Bu	s	1	100	AMP	Main	Lug	(х	NEMA TYPE 1		
DPHA		(INTEGRAL)TVSS Protection			+00		Enclosure	Recessed				NEMA TYPE 3R		
		(REMOTE)TVSS Protectio	-					Surface				NEMA TYPE 4X		
		Service Entrance Rate		-		RIBUTION	PROVIDE LOCK ON BREAKER DEVICES FOR ALL EMERGENCY LIGHTING, MOTORS, AND FIRE ALARM EQUIPMENT SERVED FROM THIS PANEL							
	NHL	Load Side Feed thru Lug CIRCUIT DESCRIPTION	AMF		NO	PHASE A	PHASE B	PHASE C		I	POLE			LCL
LCL		CIRCUIT DESCRIPTION	30	POLE 3	1	5124.5	PHASE B	PHASEC	NU	AMP	POLE	CIRCUIT DESCI	RIPTION	LOL
	Х	AC-1		-		3850.3	5104.5		2	30	3	AC-8		
	Х		-	-	3		5124.5 3850.3		4	-	-			
	Х		-	-	5			5124.5 3850.3	6	-				
	Х	AC-2	40	3	7	7063.5	1	0000.0	8	20	1	SPARE		
	Х		-	-	9		7063.5	}	10	20	1	SPARE		
	Х		-	-	11			7063.5	12	20	1	SPARE		
	Х	AC-3	30	3	13	3850.3	1		14	20	1	SPARE		
	Х		-	-	15		3850.3		16	20	1	SPARE		
	Х		-	-	17			3850.3	18	20	1	SPARE		
	Х	AC-4	30	3	19	4127.3	}		20	20	1	SPARE		
	Х		-	-	21		4127.3		22	20	1	SPARE		
	Х		-	-	23			4127.3	24	20	1	SPARE		
	Х	AC-5	30	3	25	3850.3	1		26	20	1	SPARE		
	Х		-	-	27		3850.3		28	20	1	SPARE		
	Х		-	-	29			3850.3	30	20	1	SPARE		
	Х	AC-6	30	3	31	3850.3			32	20	1		SPACE	
	Х		-	-	33		3850.3		34	20	1		SPACE	
	Х		-	-	35		_	3850.3	36	20	1		SPACE	
	Х	AC-7	30	3	37	3850.3			38	20	1		SPACE	
	Х		-	-	39		3850.3		40	20	1		SPACE	
	Х		-	-	41		_	3850.3	42	20	1		SPACE	
		SPARE	30	3	43				44	20	1		SPACE	
		"	-	-	45				46	20	1		SPACE	
		"	-	•	47		-		48	20	1		SPACE	
		TRANSFORMER 'TA'	175	3	49				50	100	3	PANEL 'HAL'		
		"	-	-	51				52	-	-	•		
		"	-	-	53				54	_	-			
XX NOTE						NOTE NOTE								
NHL= Non Harmonic Load TOTAL LOAD PER PHASE			35567	35567	35567		1 T MA T Res 17 Res							
LCL= Long Continuous Load 25% LONG CONTINUOUS LOAI SUB PANEL					0	0	0		HIGH PHASE 35566.8 / 0.9pf = KVA @ 277V 14 ALL PHASES 106700 / 0.9pf = KVA @ 480V/3PH 14					
Max. Neut. Load SUB PANEL				1 1				DEMA	DEMAND PER					
195 AMPS TOTAL CONN			NNECTED	D LOAD	35567	35566.8	35567		CE	C 220-86	0 sq. ft.			

M:\Panel Schedule\2020\20048 Pacific HS Admin\DPHA.xls


12:05 PM11/17/2020

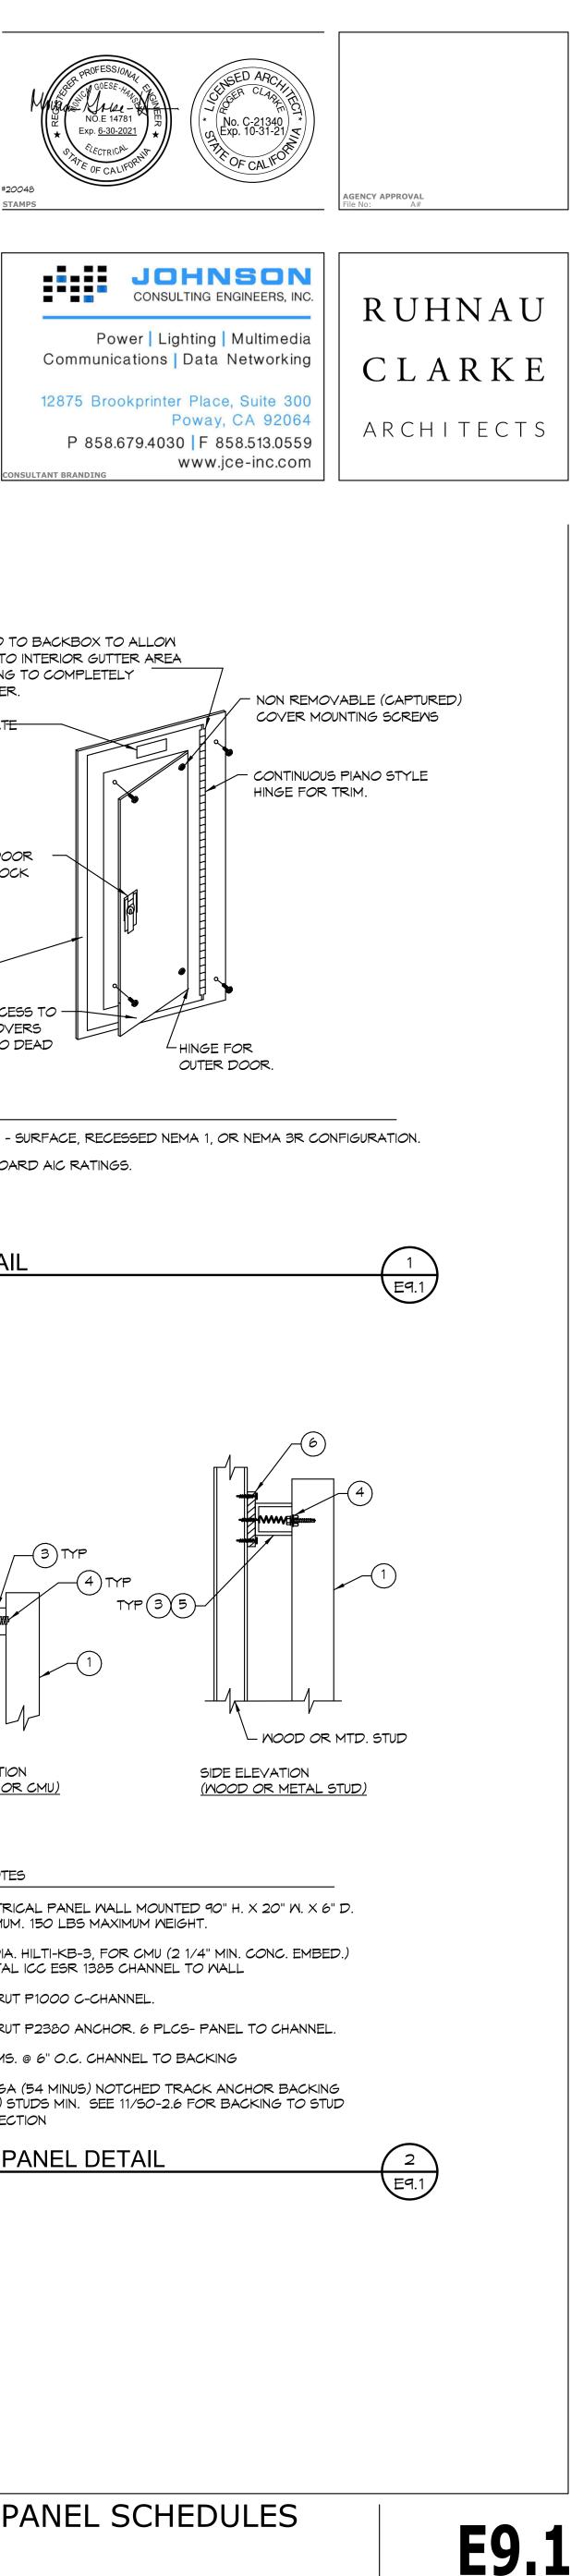

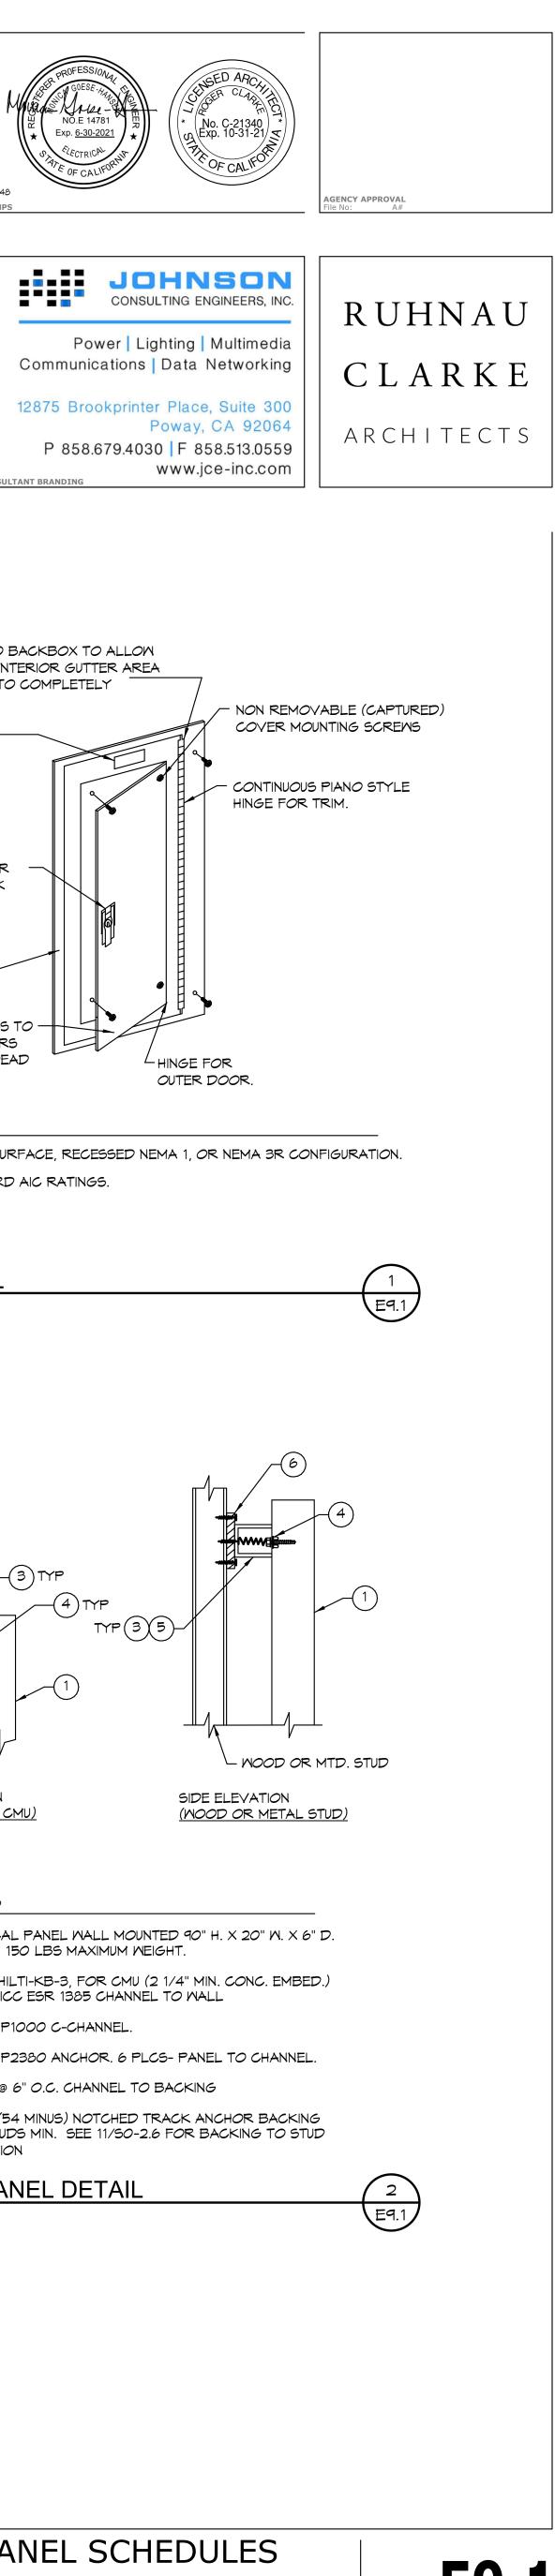

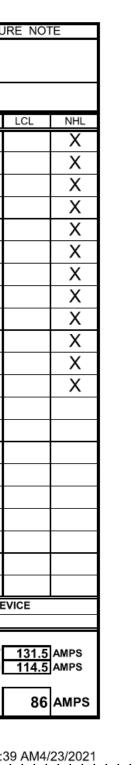




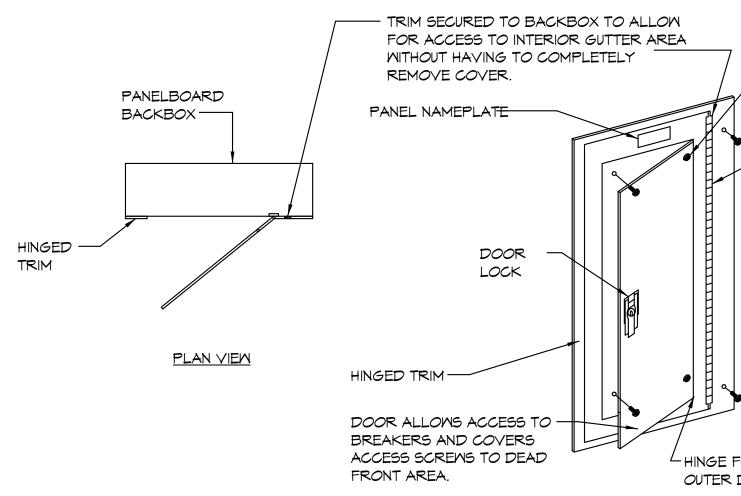


DETAIL GENERAL NOTES

1. PROVIDE FOR ALL PANELBOARDS FOR THIS PROJECT - SURFACE, RECESSED NEMA 1, OR NEMA 3R CONFIGURATION.

TYPICAL PANELBOARD DOOR/TRIM DETAIL NO SCALE

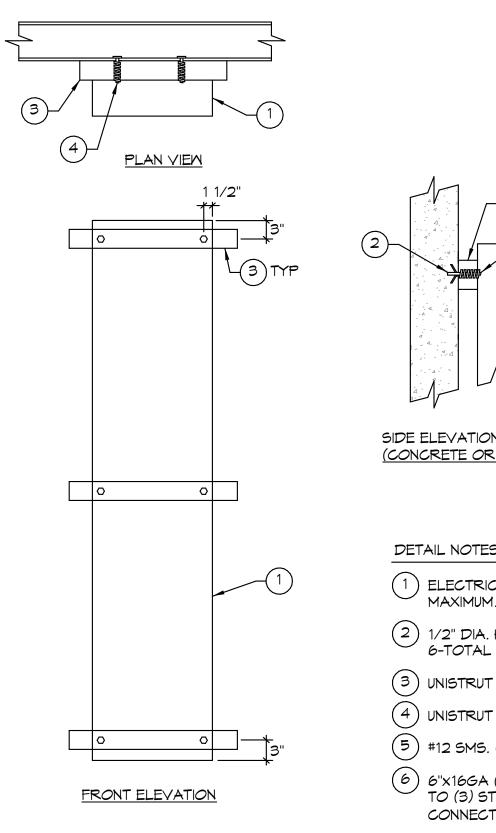

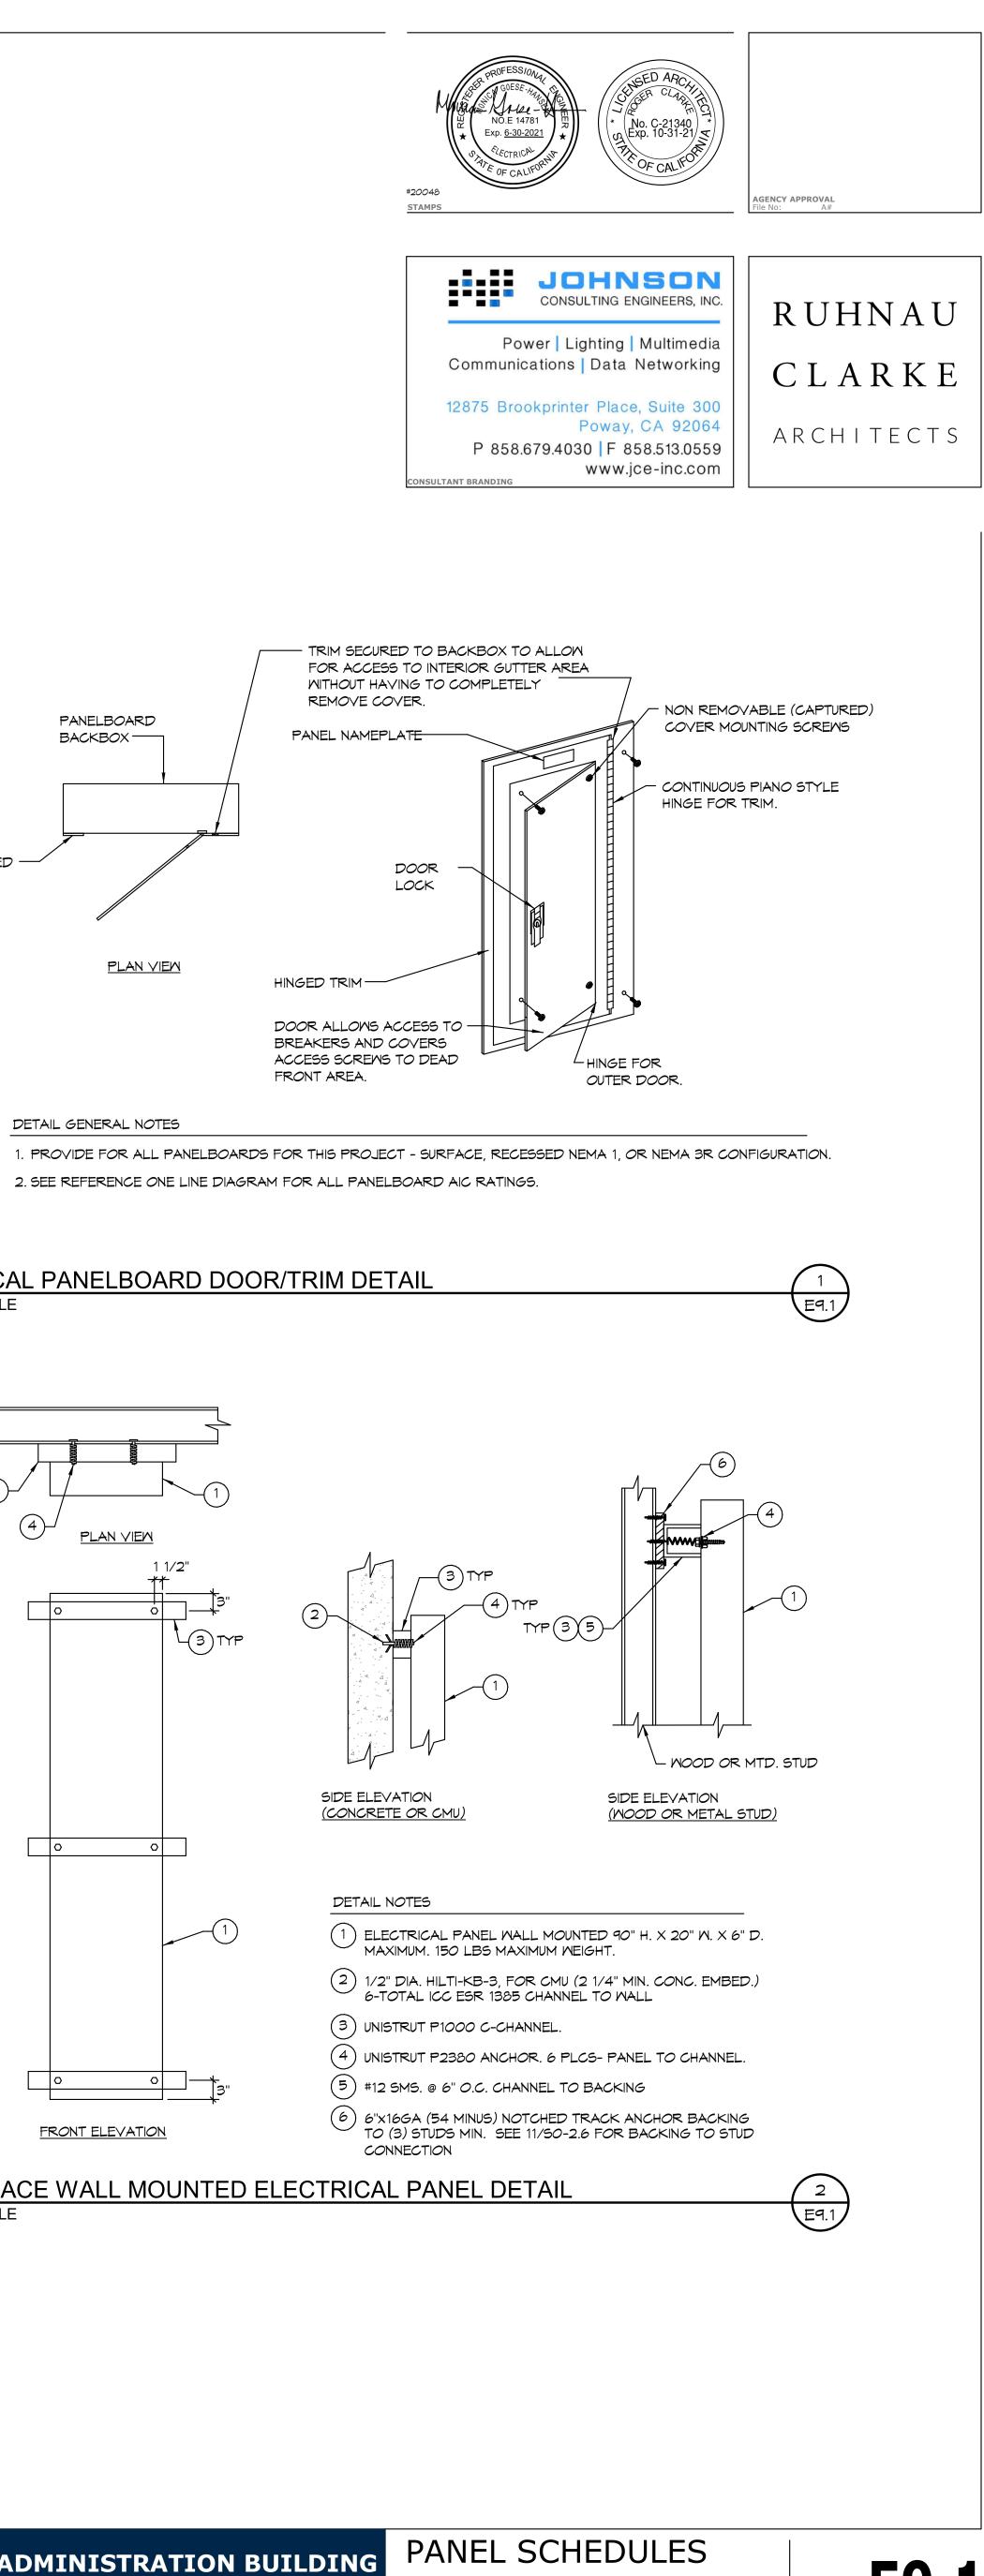

SURFACE WALL MOUNTED ELECTRICAL PANEL DETAIL NO SCALE



1020 PACIFIC STREET, SAN BERNARDINO, CA 92404 SAN BERNARDINO CITY UNIFIED SCHOOL DISTRICT