

**Addendum No:** 02

**Issue Date:** 03/21/2024

**Project:** SBCUSD Jefferson Hunt Elementary School  
San Bernardino City Unified School District

**To Drawings + Specifications dated** 04/11/2024

**Prepared By:** PBK Architects, Inc.  
8163 Rochester Ave  
#100  
Rancho Cucamonga, CA 91730

**PBK Project No:** 230432

## NOTICE TO BIDDERS

- A.** Receipt of this Addendum shall be acknowledged on the Proposal Form.
- B.** This Addendum forms part of the Contract documents for the above referenced project and shall be incorporated integrally therewith.
- C.** Each bidder shall make necessary adjustments and submit his proposal with full knowledge of all modifications, clarifications, and supplemental data included therein. Where provisions of the following supplemental data differ from those of the original Contract Documents, this Addendum shall govern.

## SPECIFICATIONS

**Item No. 02.01:** Not applicable.

## DRAWINGS

**Item No. 02.02:** Sheet PD1.1: See clouded areas.

**Item No. 02.03:** Sheet P1.1: See clouded areas.

**Item No. 02.04:** Sheet P2.2: See clouded areas.

**Item No. 02.05:** Sheet P2.4: See clouded areas.

**Item No. 02.06:** Sheet P2.5: See clouded areas.


**Item No. 02.07:** Sheet P2.6: See clouded areas.

**Item No. 02.08:** Sheet L1.00: New Sheet – additive bid alternate.

**Item No. 02.09:**            **Sheet L1.01:** New Sheet – additive bid alternate.

**Item No. 02.10:**            **Sheet L1.02:** New Sheet – additive bid alternate.

**End of Addendum No. 02**

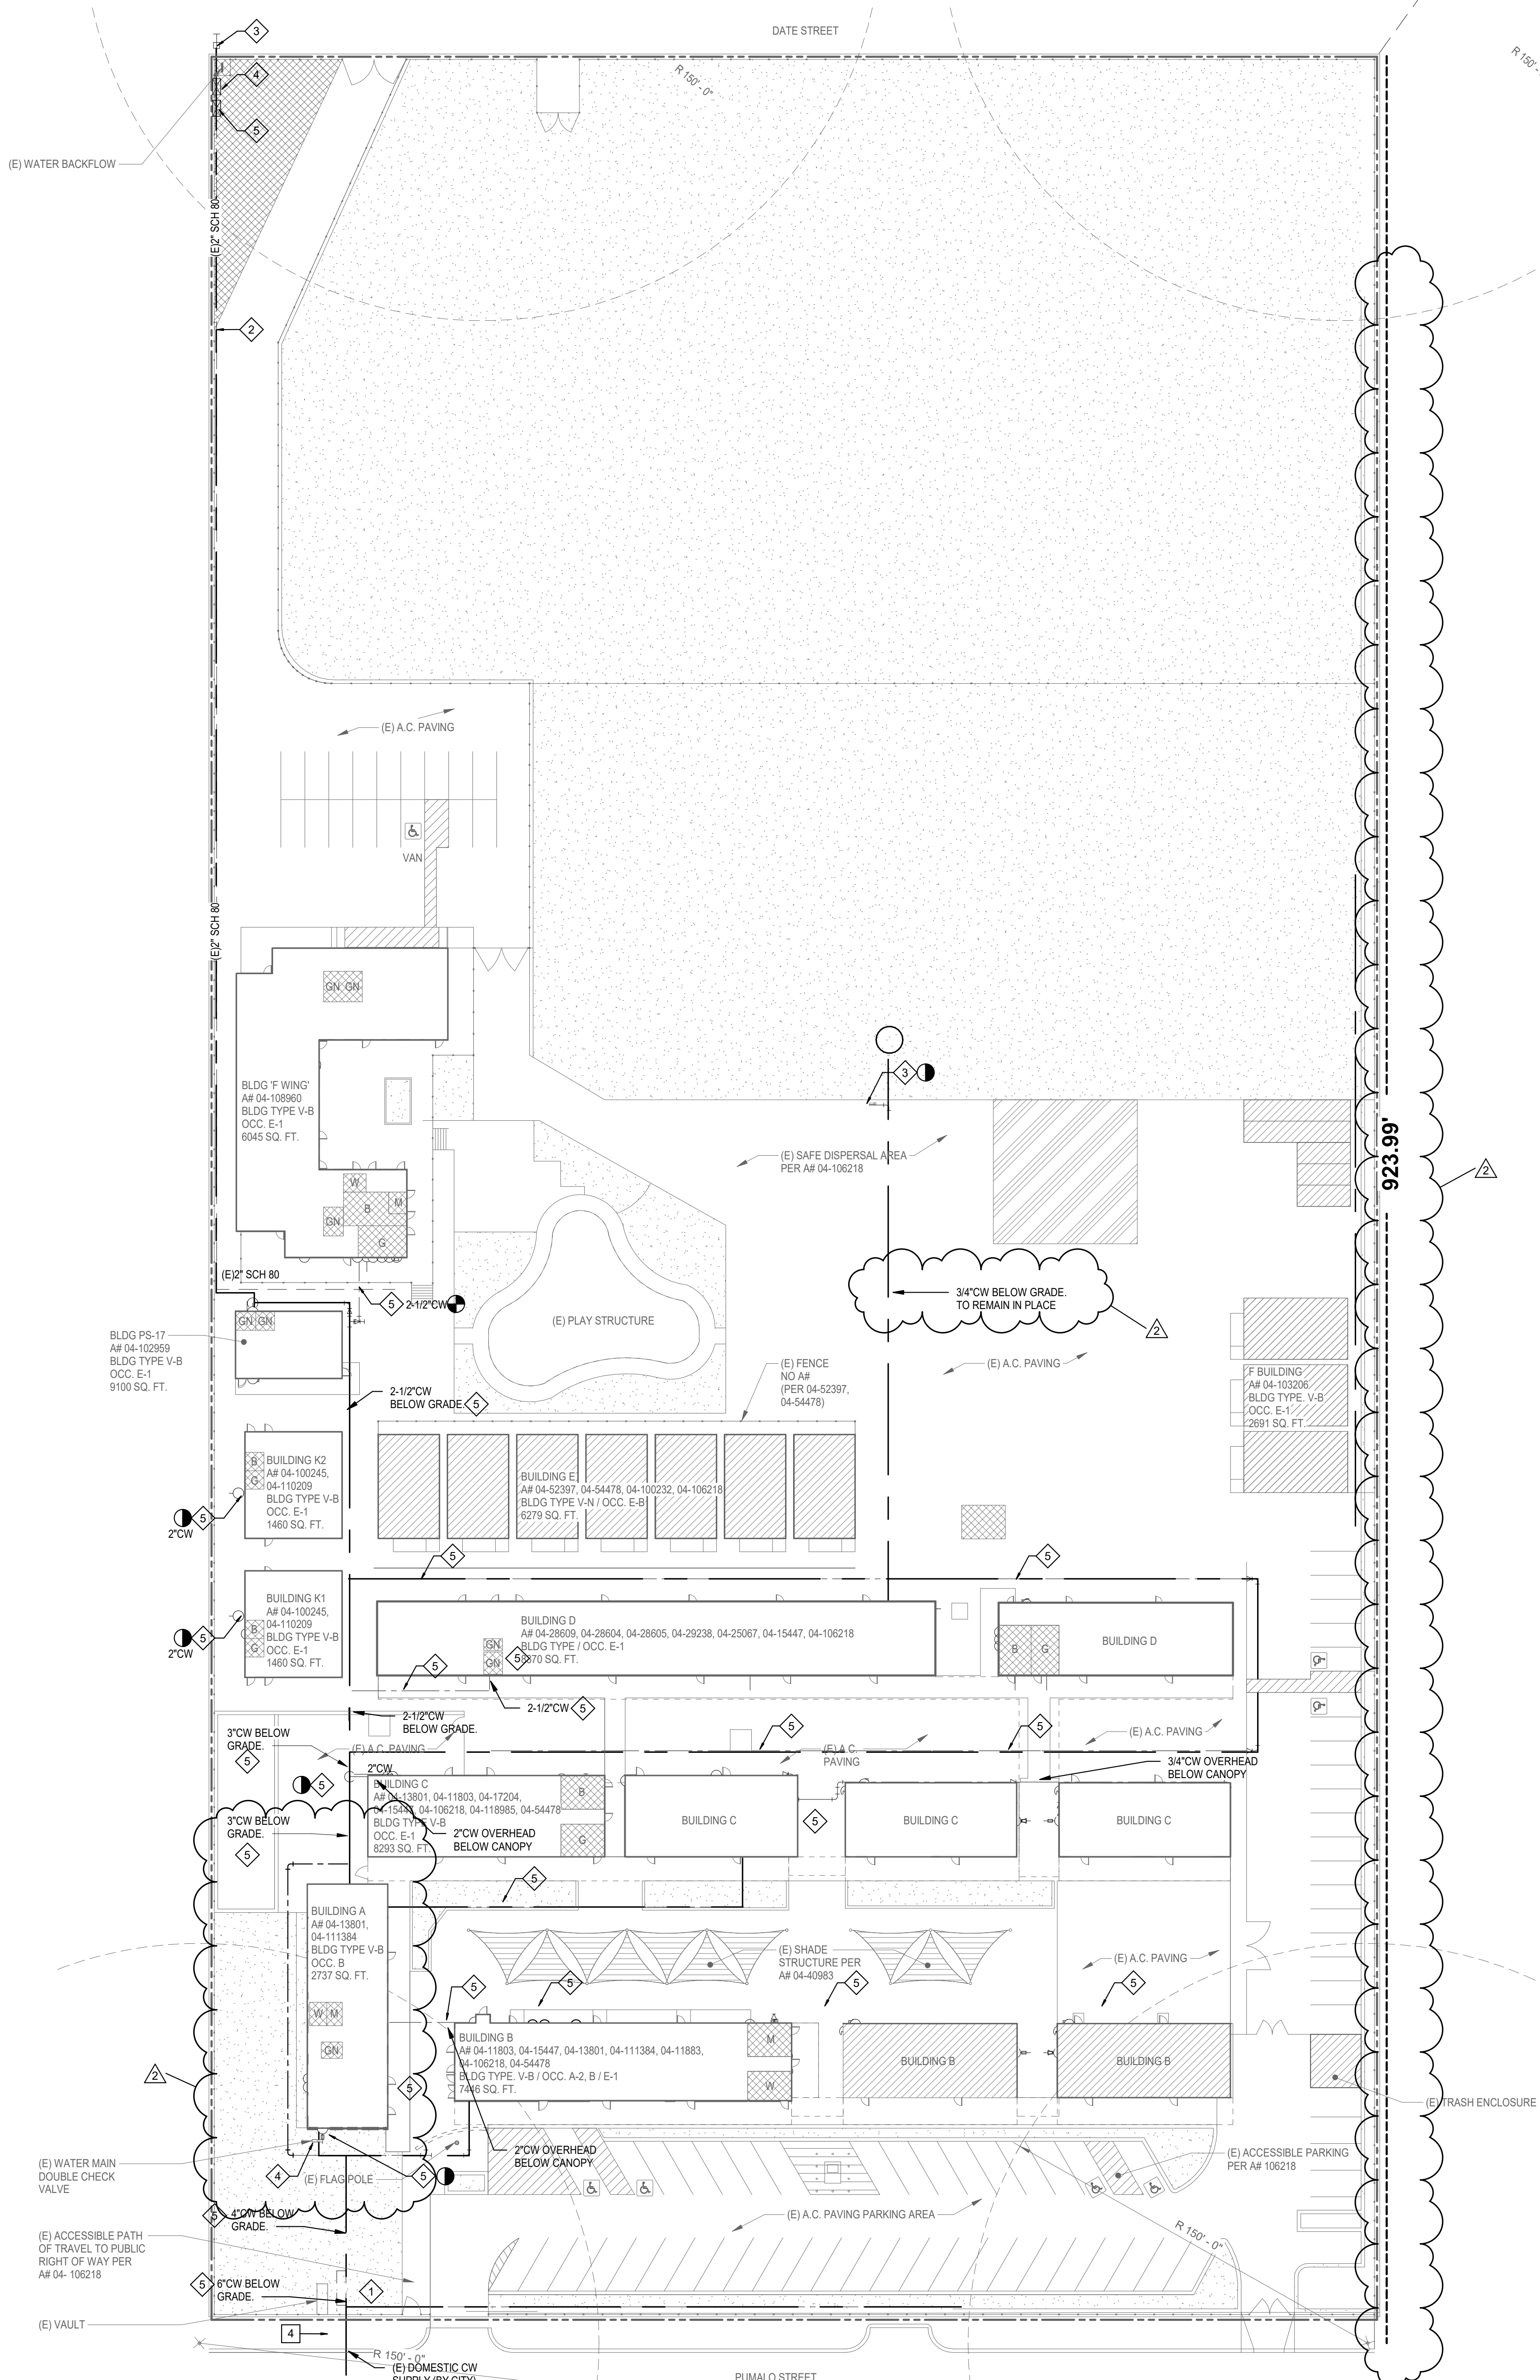

GENERAL NOTES

- SCOPE OF WORK INCLUDES SITE WATER LINE, SUPPLY LATERAL TO THE BUILDING AND OVERHEAD PIPING REPLACEMENT.
- FIELD VERIFY EXACT LOCATION OF EXISTING WATER PIPING, FIXTURES, WATER LATERAL, VALVES & YARD BOXES.
- REMOVE EXISTING DOMESTIC WATER PIPING BELOW GRADE ON SITE AND REPLACE WITH UNDERGROUND PIPE MATERIAL IN ACCORDANCE WITH 2022 CALIFORNIA PLUMBING CODE.
- REMOVE AND REPLACE EXISTING PIPING OVERHEAD AT BUILDING STRUCTURE, WHERE NOTED, SEE FLOOR PLAN FOR EXTENT OF REPLACEMENT.
- NO IN WALL PIPING IS REPLACED, EXTEND AND CONNECT NEW PIPING OVERHEAD TO THE EXISTING LATERAL IN WALL TURN.
- PROVIDE MUELLER VALVE WITH QUARTER TURN.
- PROVIDE ISOLATION TO EACH BUILDING STRUCTURE LATERAL AND AT EACH GROUP OF FIXTURES AND FOR EACH CLASSROOM WITHIN THE STRUCTURE.

DEMOLITION KEY NOTES

- 1 EXISTING BACKFLOW PREVENTER TO REMAIN.
- 2 EXISTING 2" COLD WATER SCHEDULE 80 PIPING TO REMAIN.
- 3 EXISTING DRINKING FOUNTAIN TO REMAIN.
- 4 EXISTING DOUBLE CHECK VALVE TO REMAIN.
- 5 ABANDON IN PLACE



ARCHITECT **PBK Architects, Inc.**  
 RANCHO CUCAMONGA  
 8163 Rochester Avenue, Suite 100  
 Rancho Cucamonga  
 California 91730  
 P: 909-987-0909



CONSULTANT **LEAF ENGINEERS**

**LEAF ENGINEERS**  
 8163 Rochester Avenue, Suite 100  
 Rancho Cucamonga, CA 91730  
 909.987-0909  
 leafengineers.com

JEFFERSON HUNT ES - WATER LINE REPLACEMENT

PROJECT ADDRESS:  
 1342 E. Pinaldo St.  
 San Bernardino, CA 92404


CONSTRUCTION DOCUMENT

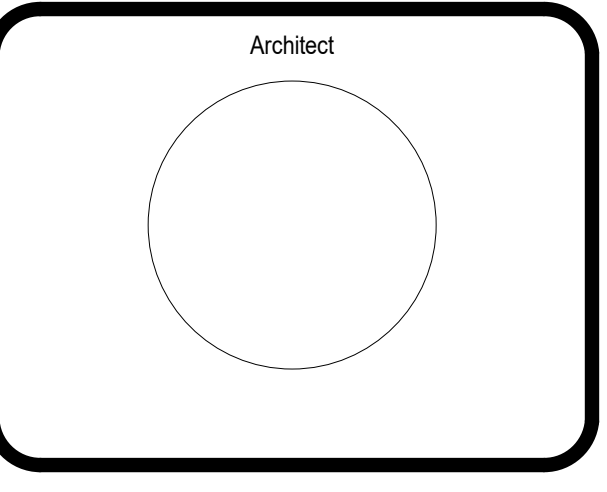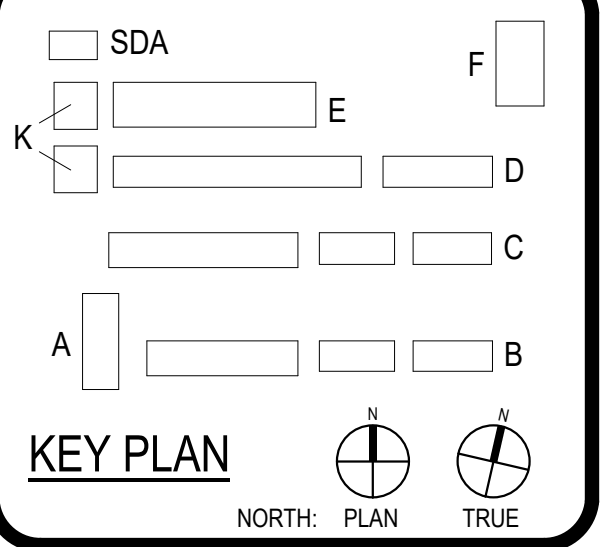

REVISIONS		
No.	Description	Date
2	Revision 2	4-11-2024

CONSTRUCTION DOCUMENT  
**PLUMBING SITE PLAN DEMO**




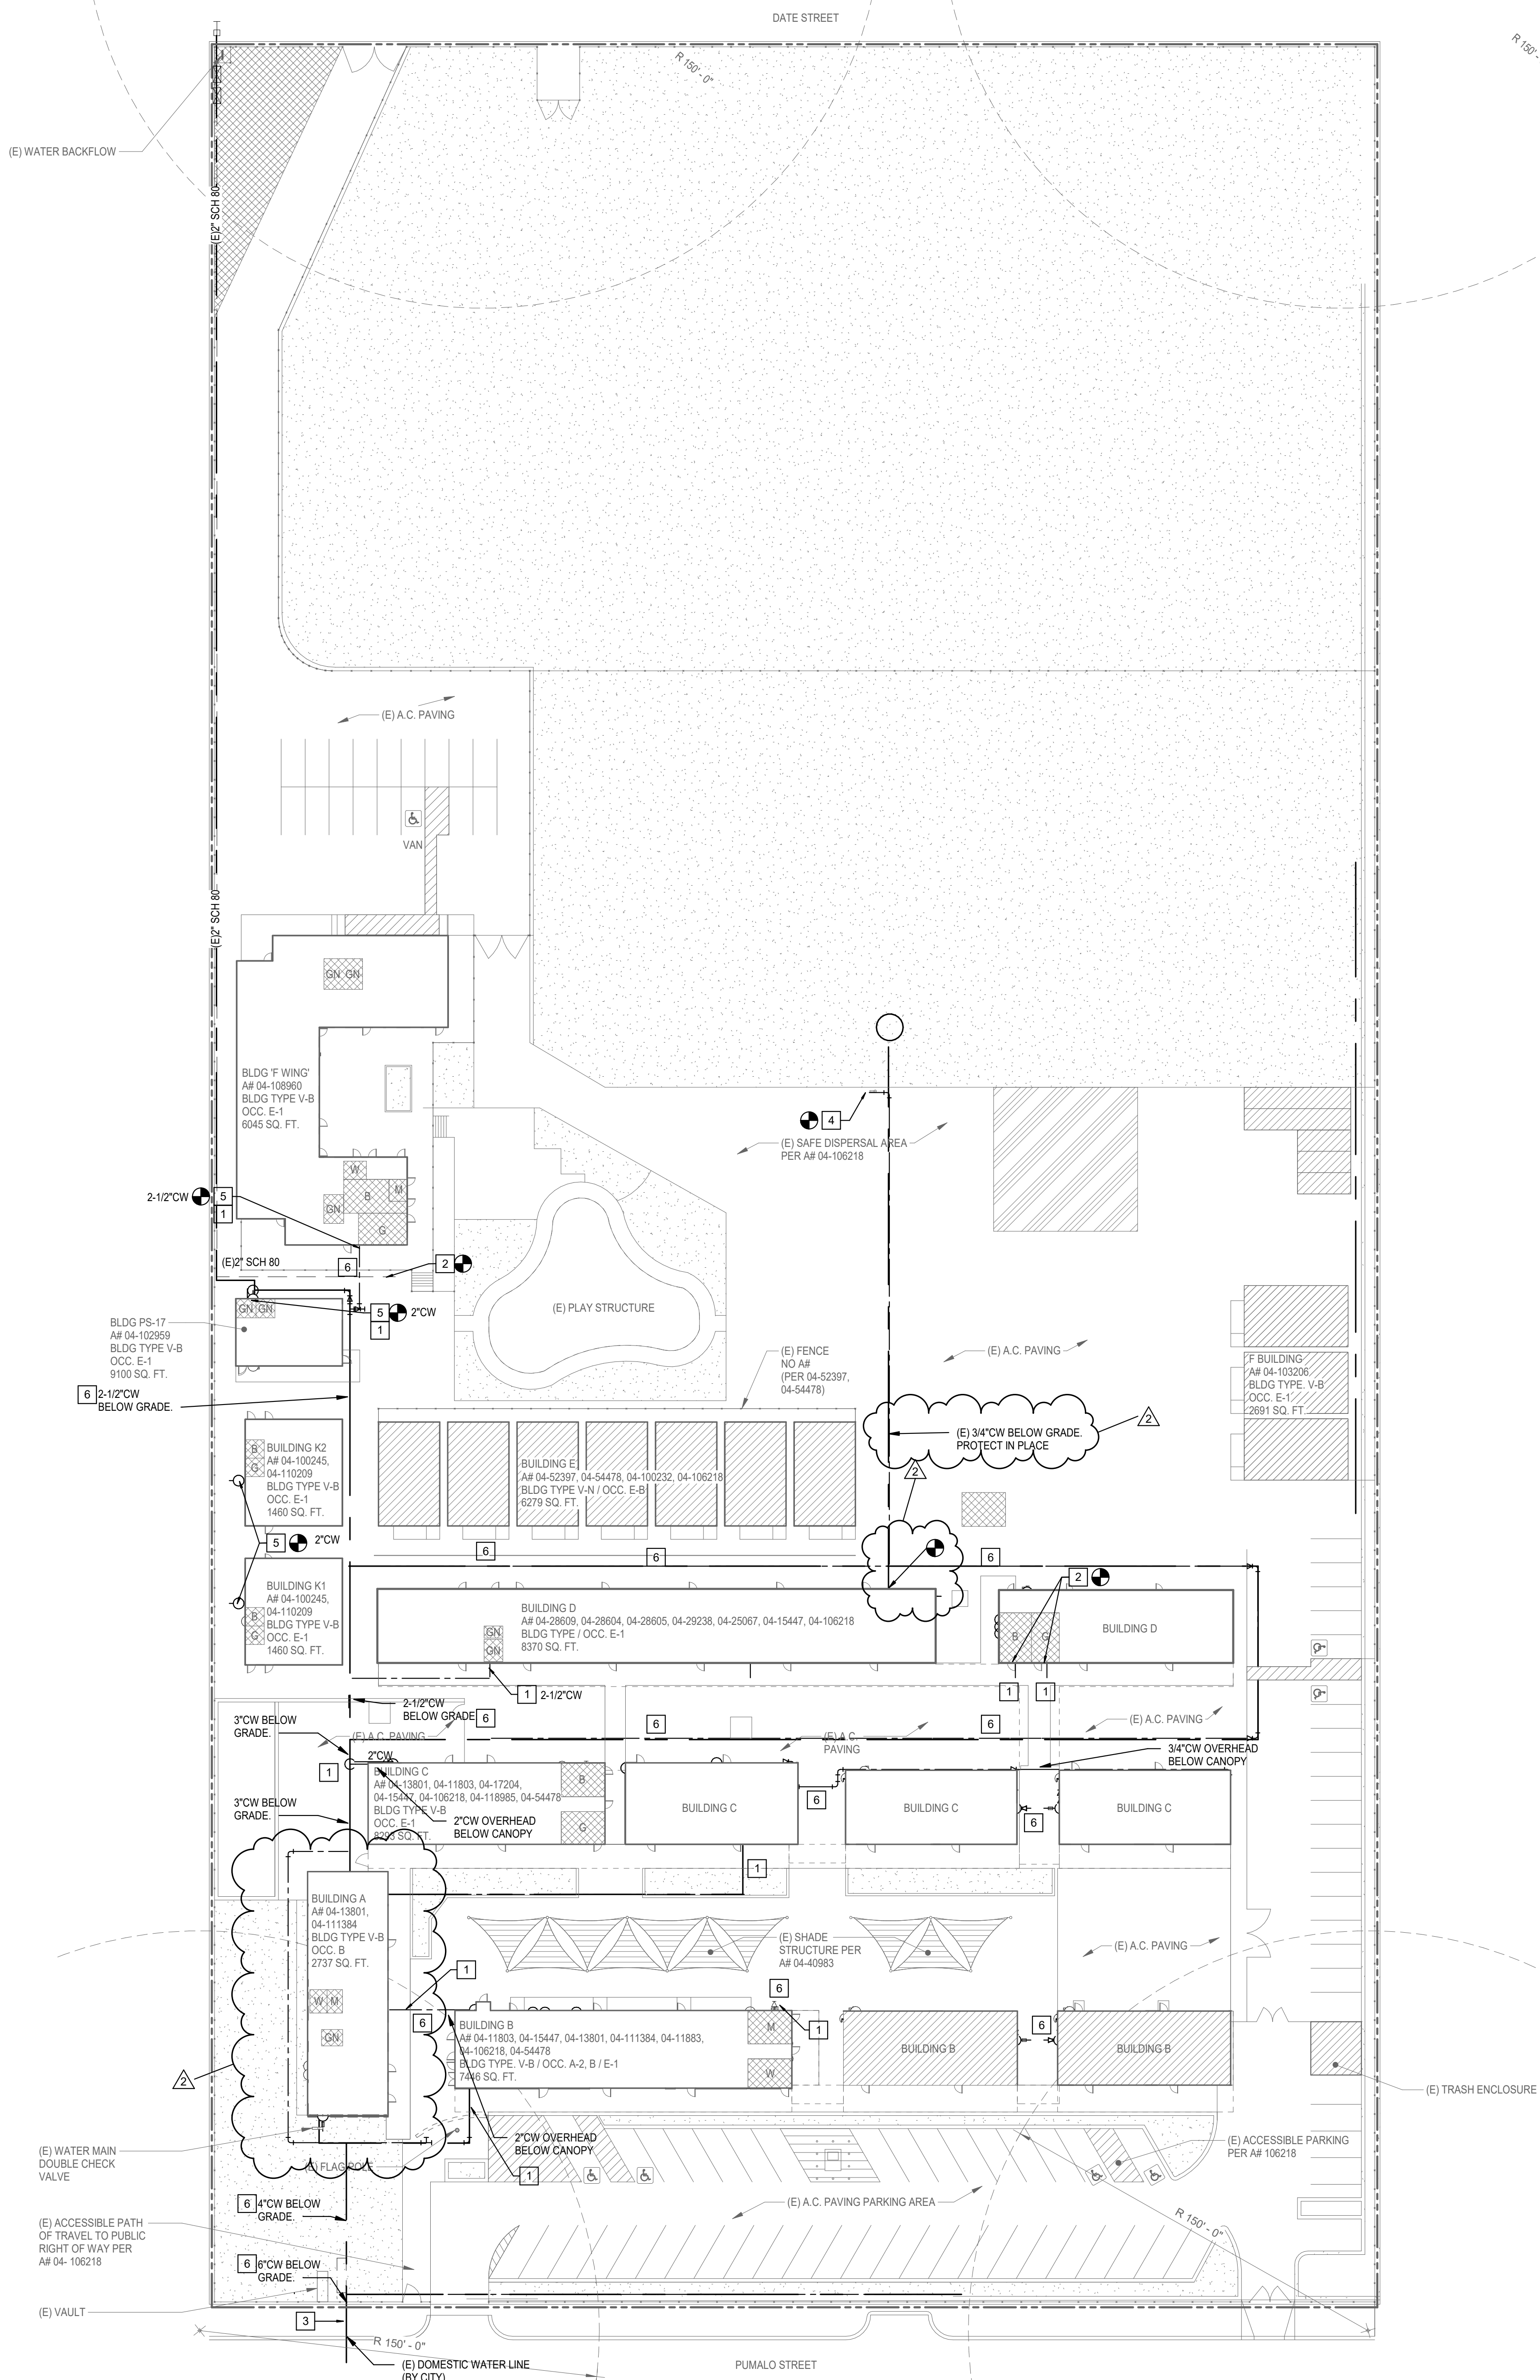

**NOTE:**  
PLUMBING CONTRACTOR TO PROVIDE NEW DOMESTIC UNDERGROUND WATER PIPING AS NOTED. PROVIDE LINE FOR LINE PIPE SIZES. FIELD VERIFY BEFORE START OF WORK.


**GENERAL NOTES**

- SCOPE OF WORK INCLUDES SITE WATER LINE, SUPPLY LATERAL TO THE BUILDING AND OVERHEAD PIPING REPLACEMENT.
- FIELD VERIFY EXACT LOCATION OF EXISTING WATER PIPING, FIXTURES, WATER LATERAL, VALVES & YARD BOXES.
- REMOVE EXISTING DOMESTIC WATER PIPING BELOW GRADE ON SITE AND REPLACE WITH UNDERGROUND PIPE MATERIAL IN ACCORDANCE WITH 2022 CALIFORNIA PLUMBING CODE.
- REMOVE AND REPLACE EXISTING PIPING OVERHEAD AT BUILDING STRUCTURE WHERE NOTED. SEE FLOOR PLAN FOR EXTENT OF REPLACEMENT.
- NO IN WALL PIPING IS REPLACED. EXTEND AND CONNECT NEW PIPING OVERHEAD TO THE EXISTING LATERAL IN-WALL TURN.
- PROVIDE 1/2" DIAMETER VALVE WITH QUARTER TURN.
- PROVIDE ISOLATION TO EACH BUILDING STRUCTURE LATERAL AND AT EACH GROUP OF FIXTURES AND FOR EACH CLASSROOM WITHIN THE STRUCTURE.

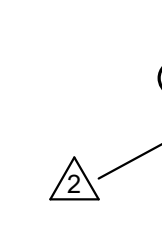

**REMODEL KEY NOTES**

- PROVIDE SHUT-OFF VALVE IN CONCRETE YARD BOX AT BUILDING SUPPLY LATERAL. SEE DETAIL #1/PS 1.
- EXTEND AND CONNECT 2" COLD WATER TO EXISTING IRRIGATION PIPING BELOW GRADE. PROVIDE WITH SHUT-OFF VALVE IN CONCRETE YARD BOX.
- PROVIDE WATER METER TO REPLACE EXISTING METER. COORDINATE ALL WORK WITH EAST VALLEY WATER DISTRICT. PROVIDE 6" METER WITH 4" LATERAL.
- MODIFY, EXTEND AND CONNECT 3/4" COLD WATER TO EXISTING DRINKING FOUNTAIN.
- EXTEND AND CONNECT FULL-SIZE COLD WATER TO EXISTING COLD WATER LATERAL BELOW GRADE. PROVIDE WITH SHUT-OFF VALVE FOR ISOLATION.
- PROVIDE NEW UNDERGROUND DOMESTIC WATER LINE (COORDINATE ALL UNDERGROUND UTILITIES BEFORE START OF WORK.)

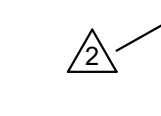



ARCHITECT **PBK Architects, Inc.**  
RANCHO CUCAMONGA  
8163 Rochester Avenue, Suite 100  
Rancho Cucamonga  
California 91730  
P 909-987-0909

CONSULTANT **LEAF ENGINEERS**  
LEAF ENGINEERS  
8163 Rochester Avenue, Suite 100  
Rancho Cucamonga, CA 91730  
909.987-0909  
leafengineers.com

JEFFERSON HUNT ES - WATER LINE REPLACEMENT

PROJECT ADDRESS:  
1342 E. Pumalo St.  
San Bernardino, CA 92404


CONSTRUCTION DOCUMENT

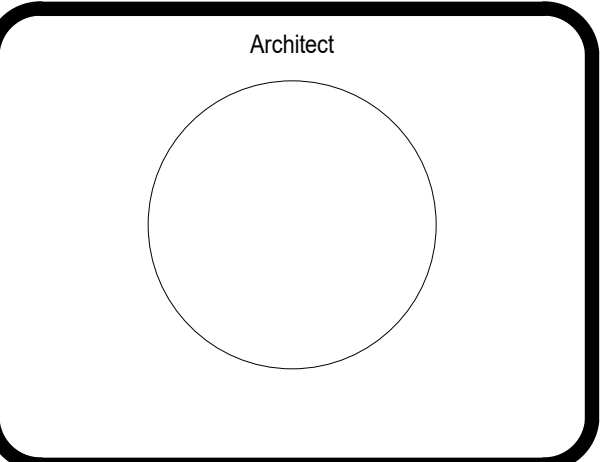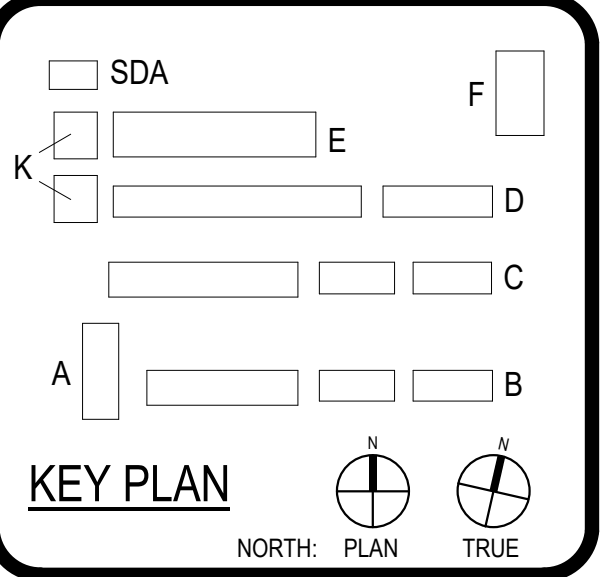




CLIENT		
SAN BERNARDINO CITY USD		PROJECT NUMBER
DATE	230432	
10-10-23		
REVISIONS		
No.	Description	Date
2	Revision 2	4-11-2024

CONSTRUCTION DOCUMENT  
**PLUMBING SITE PLAN NEW**



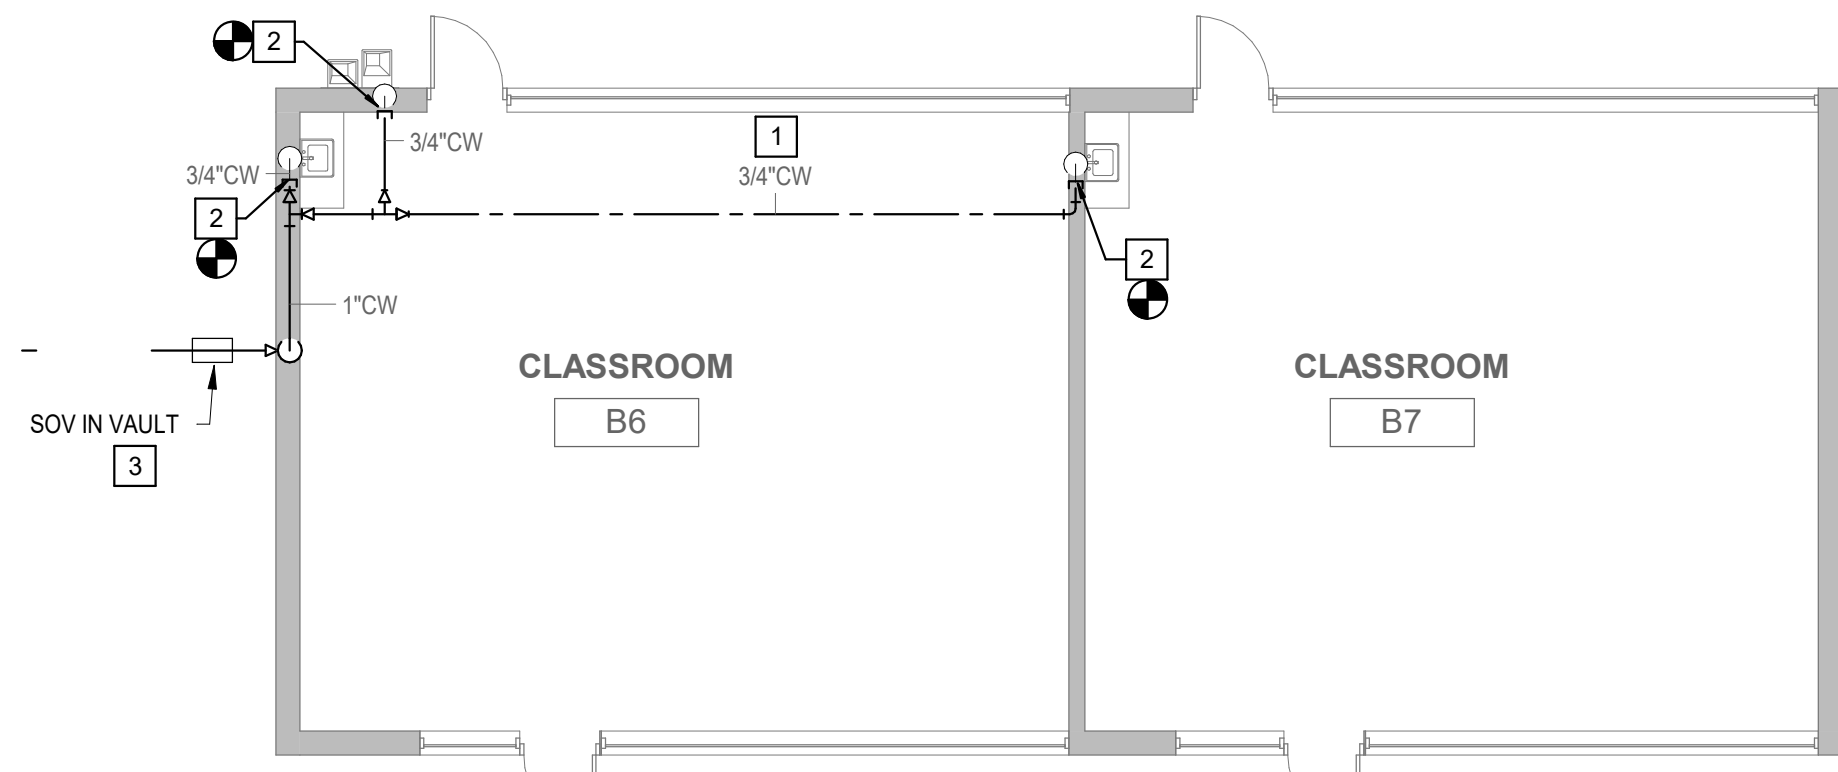


**NOTE:**  
 1. PLUMBING CONTRACTOR TO PROVIDE LIKE FOR LIKE PIPE SIZES FIELD VERIFY BEFORE START OF WORK.  
 2. EXISTING COLD WATER PIPING ABOVE THE CEILING TO BE REMOVED AND REPLACED WITH NEW PIPING IN SAME LOCATION. PROVIDE NEW PIPE SUPPORTS.

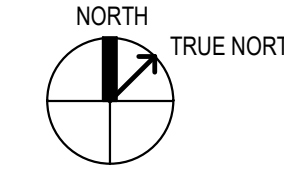
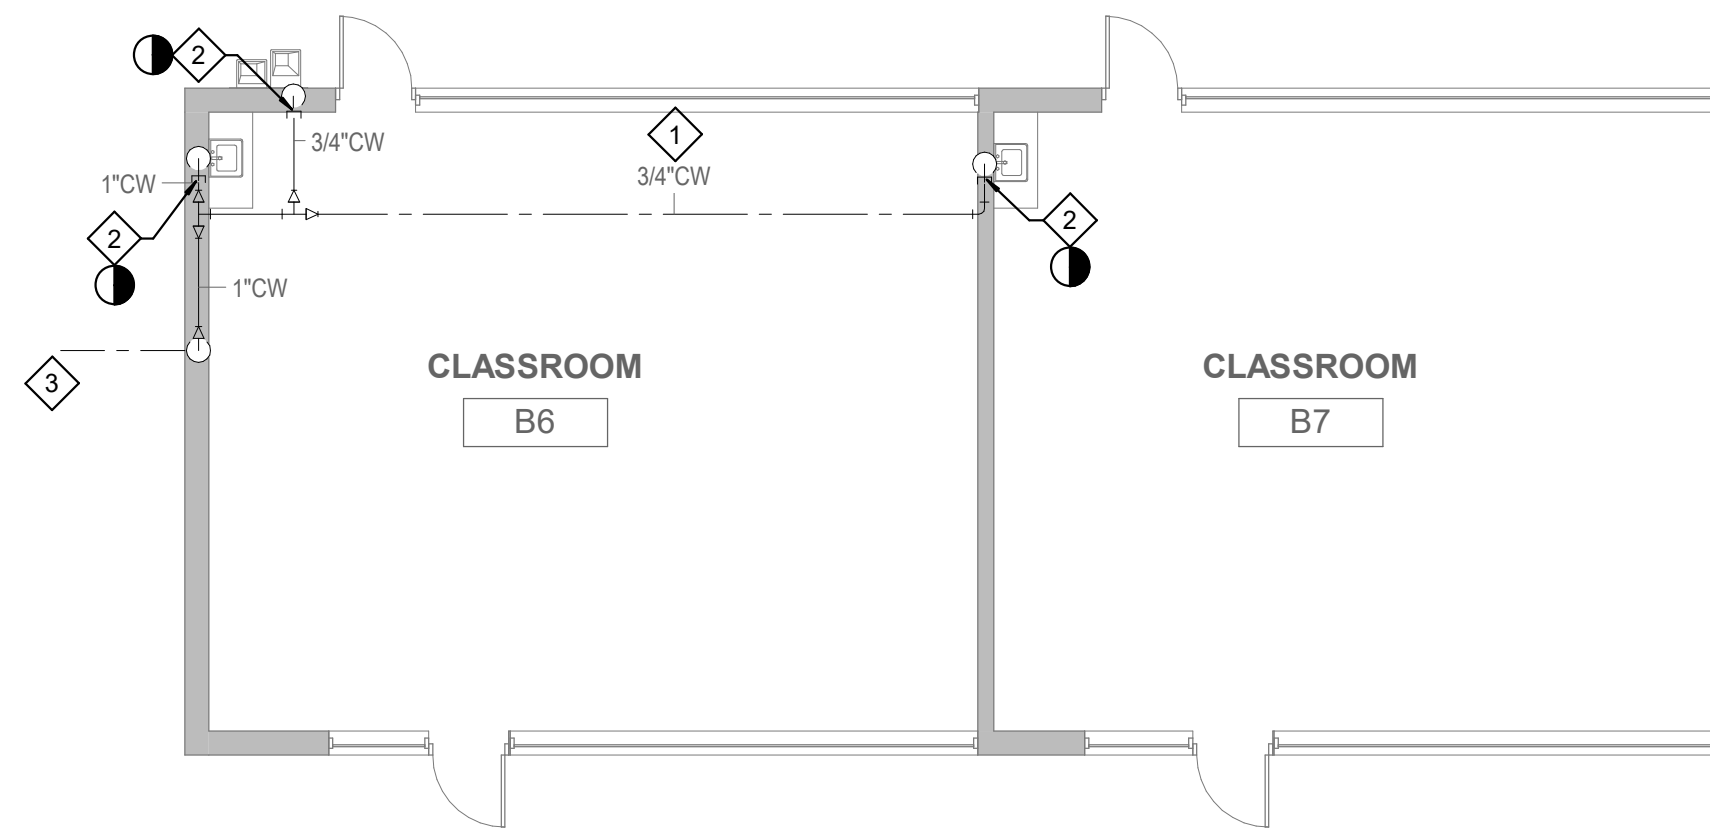
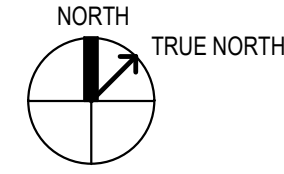


**6** PLUMBING FLOOR PLAN BLDG B EAST - NEW  
 1/8" = 1'-0"

**5** PLUMBING FLOOR PLAN BLDG B EAST - DEMO  
 1/8" = 1'-0"

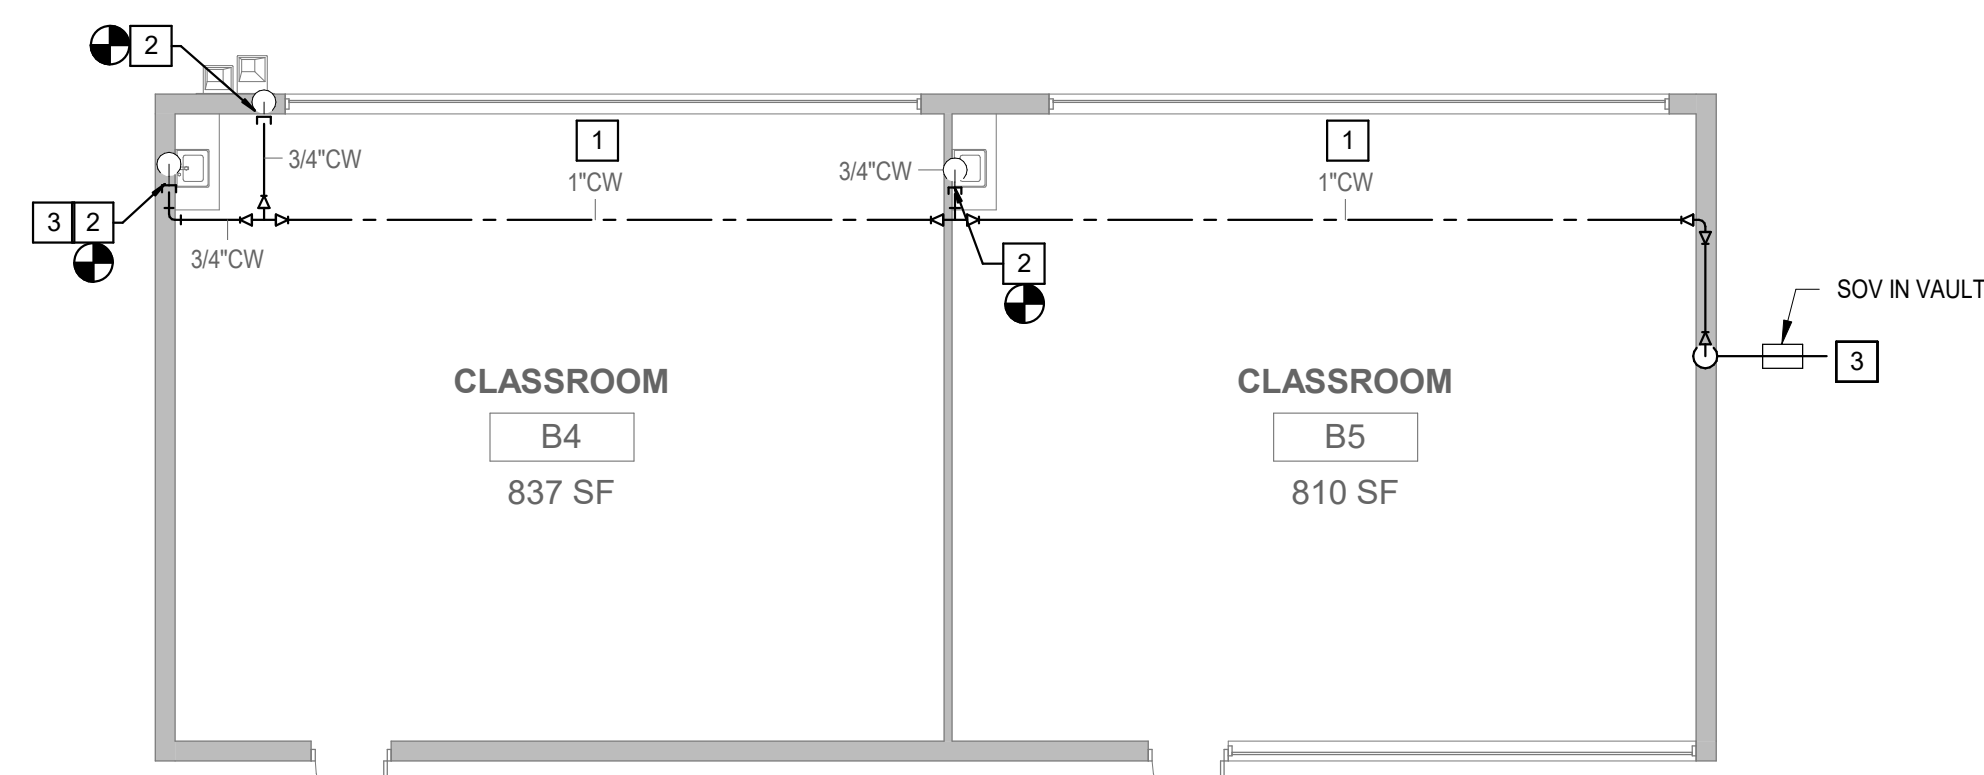


**NOTE:**  
 1. PLUMBING CONTRACTOR TO PROVIDE LIKE FOR LIKE PIPE SIZES FIELD VERIFY BEFORE START OF WORK.  
 2. EXISTING COLD WATER PIPING ABOVE THE CEILING TO BE REMOVED AND REPLACED WITH NEW PIPING IN SAME LOCATION. PROVIDE NEW PIPE SUPPORTS.

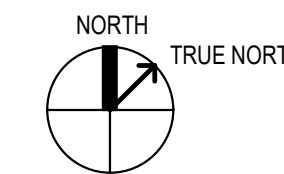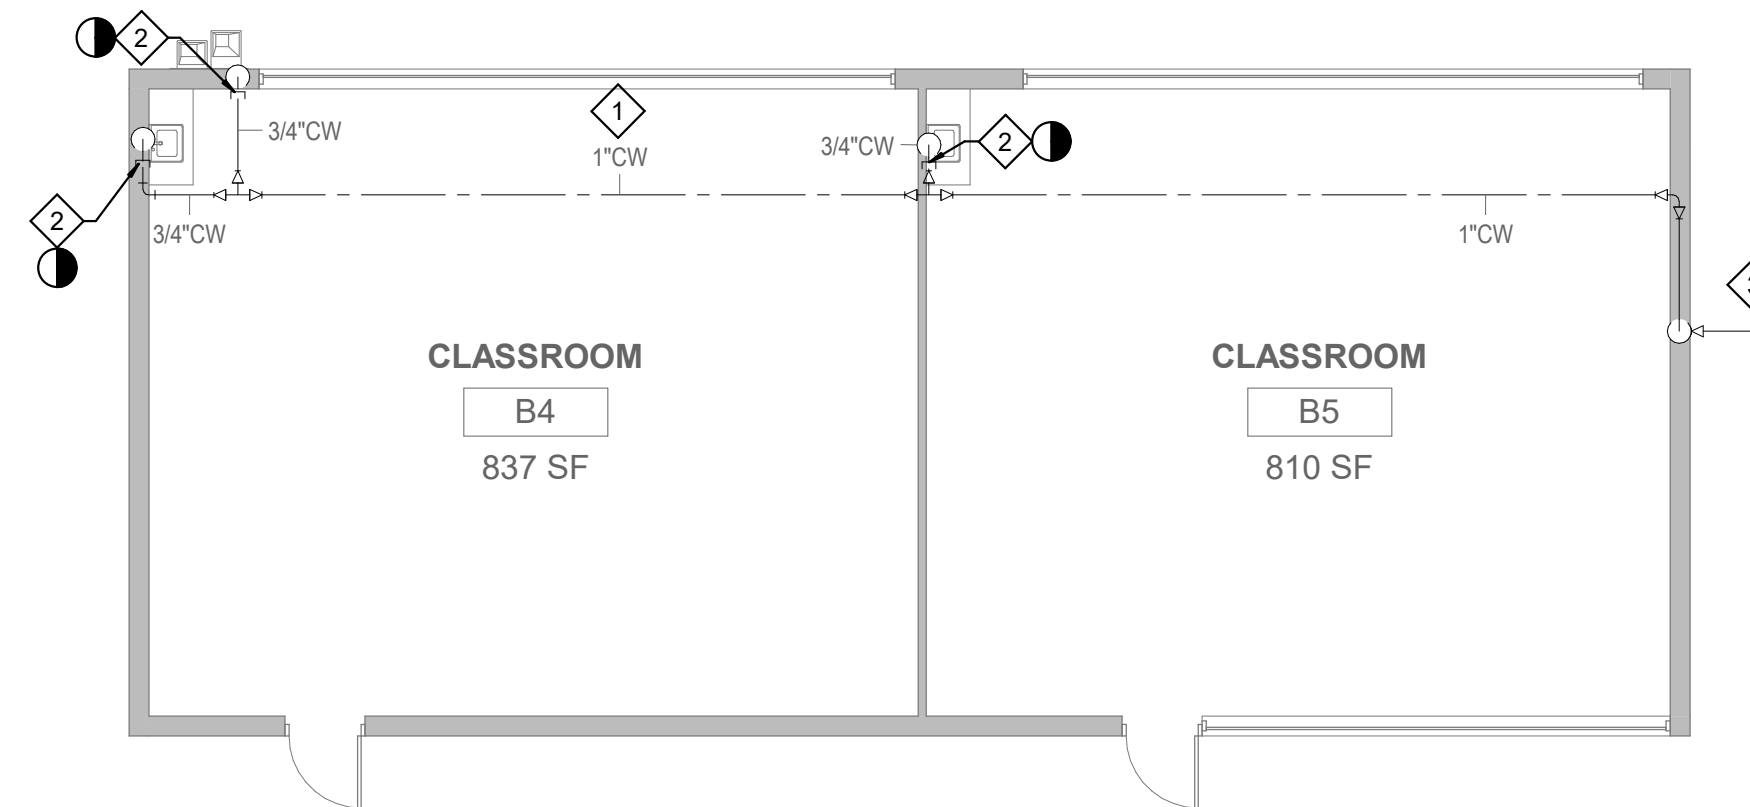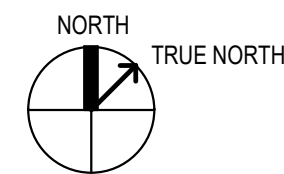


**4** PLUMBING FLOOR PLAN BLDG B CENTRAL - NEW  
 1/8" = 1'-0"


**3** PLUMBING FLOOR PLAN BLDG B CENTRAL - DEMO  
 1/8" = 1'-0"

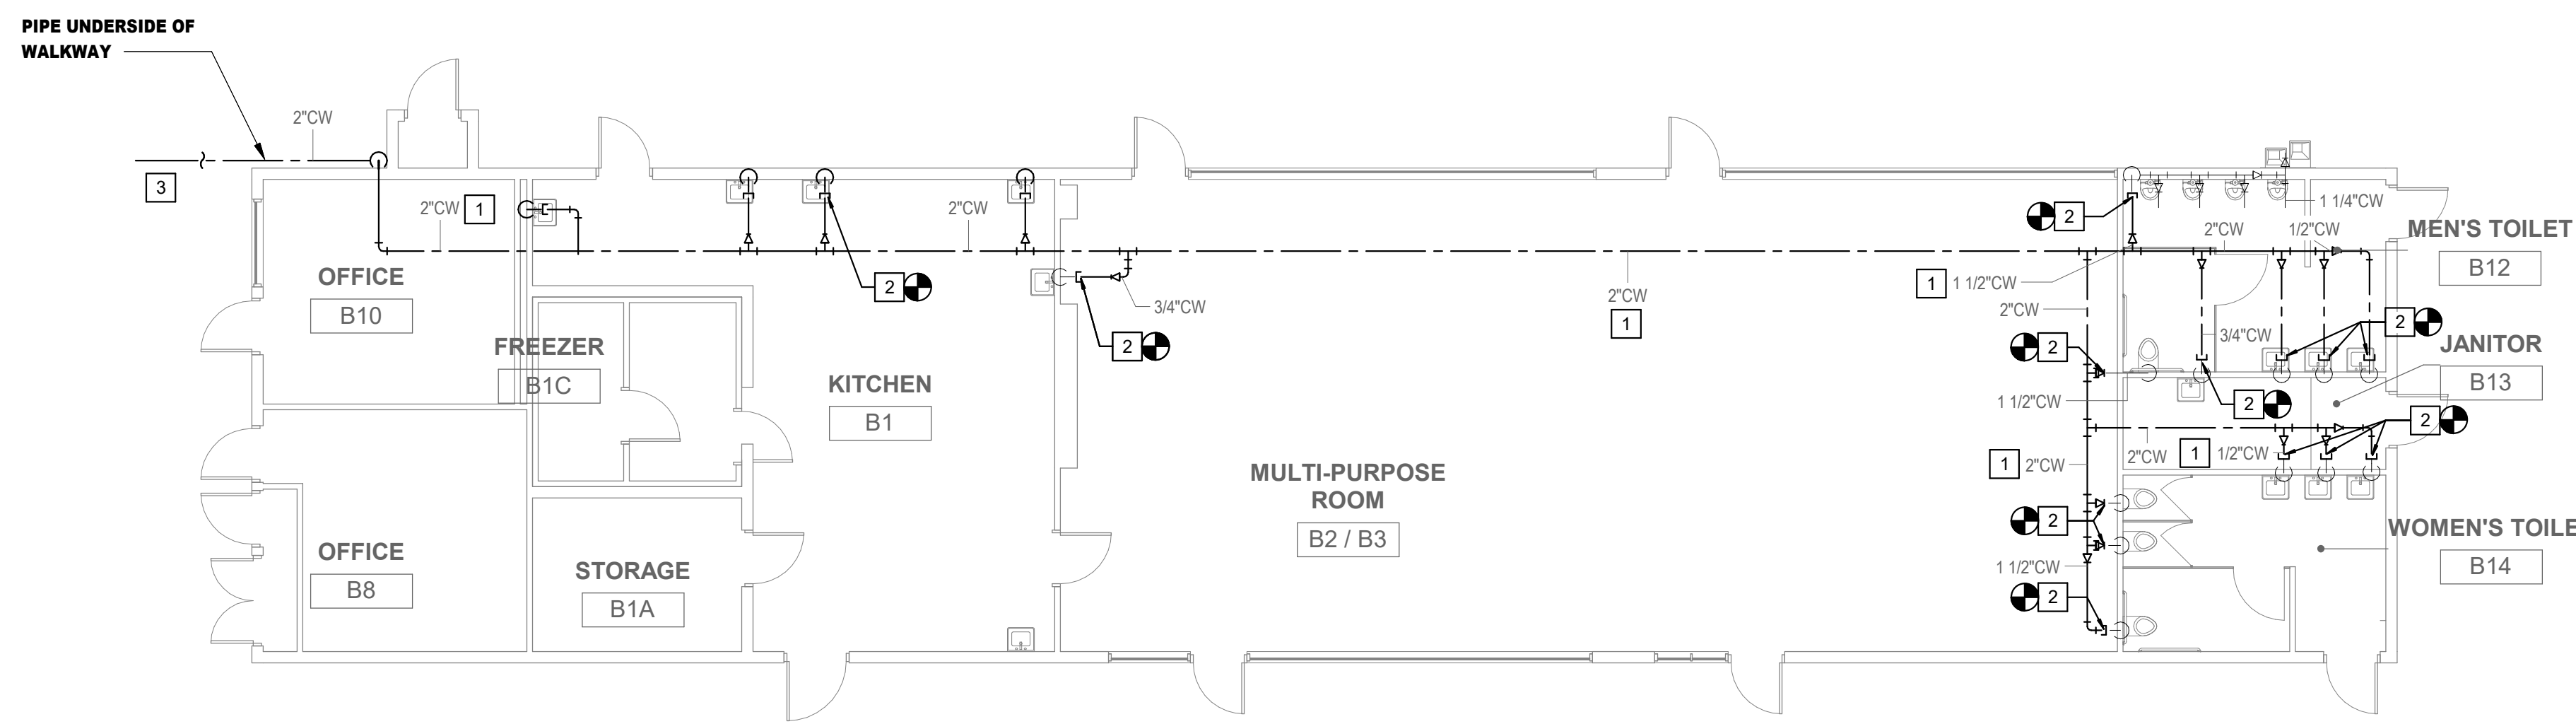


**NOTE:**  
 1. PLUMBING CONTRACTOR TO PROVIDE LIKE FOR LIKE PIPE SIZES FIELD VERIFY BEFORE START OF WORK.  
 2. EXISTING COLD WATER PIPING ABOVE THE CEILING TO BE REMOVED AND REPLACED WITH NEW PIPING IN SAME LOCATION. PROVIDE NEW PIPE SUPPORTS.  
 3. PROVIDE BALL VALVES AT EACH RESTROOM.

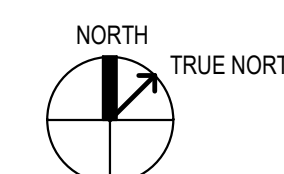

**2** PLUMBING FLOOR PLAN BLDG B WEST - NEW  
 1/8" = 1'-0"

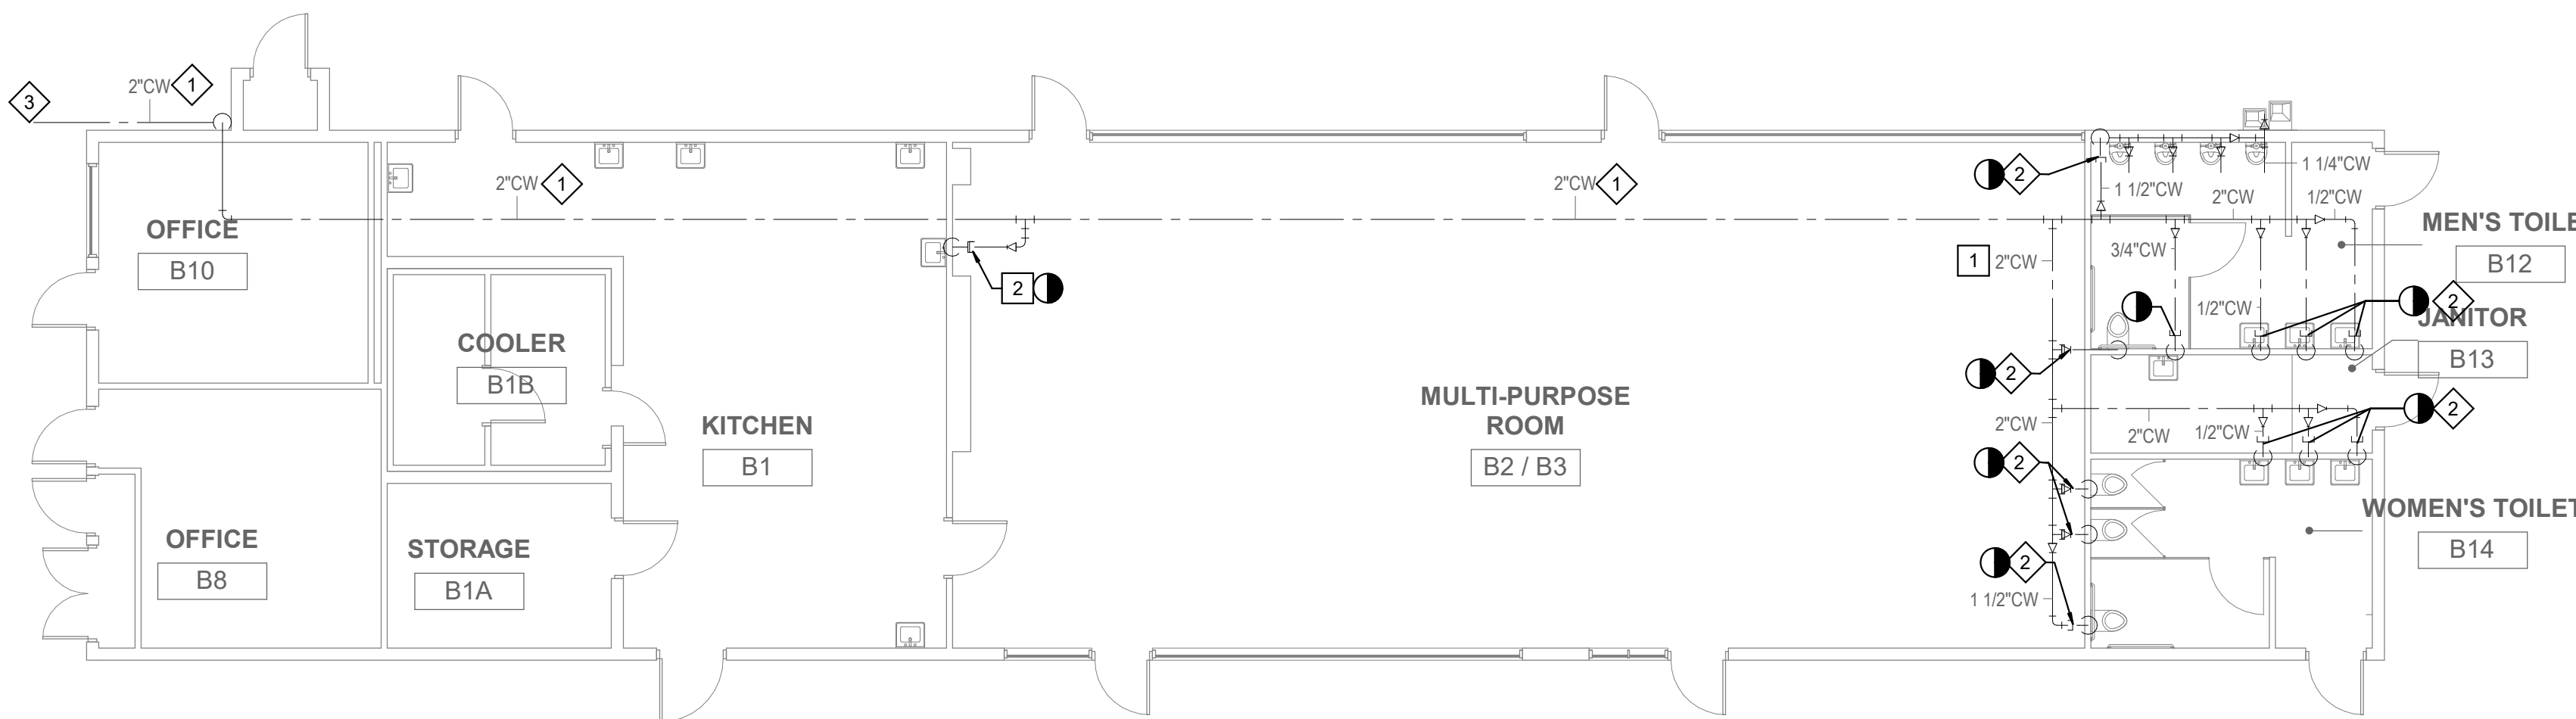

**NOTE:**  
 1. PLUMBING CONTRACTOR TO PROVIDE LIKE FOR LIKE PIPE SIZES FIELD VERIFY BEFORE START OF WORK.  
 2. EXISTING COLD WATER PIPING ABOVE THE CEILING TO BE REMOVED AND REPLACED WITH NEW PIPING IN SAME LOCATION. PROVIDE NEW PIPE SUPPORTS.  
 3. PROVIDE BALL VALVES AT EACH RESTROOM.

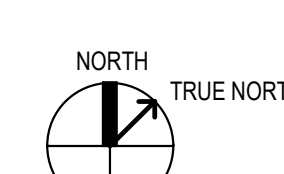

**1** PLUMBING FLOOR PLAN BLDG B WEST - DEMO  
 1/8" = 1'-0"

**GENERAL NOTES**

1. MODIFY EXISTING PIPING SYSTEM ROUGH-IN. EXTEND AND CONNECT TO EXISTING DOMESTIC WATER.
2. PATCH TO MATCH FINISH.
3. FOR CONTINUATION OF ALL UTILITIES SEE BUILDING AS-BUILT / RECORD DRAWINGS.
4. BEFORE COMMENCEMENT OF WORK, THE CONTRACTOR SHALL VERIFY THE EXACT LOCATIONS, ELEVATIONS AND CHARACTERISTICS OF ALL UTILITIES AND PIPING BY PHYSICAL EXCAVATION, AND SHALL IMMEDIATELY NOTIFY THE ARCHITECT OF ANY DISCREPANCIES.
5. THE CONTRACTOR SHALL FIELD VERIFY ALL EXISTING UTILITIES AND POINTS OF CONNECTION PRIOR TO BIDDING PROJECT.
6. THE PLUMBING CONTRACTOR SHALL RUN ALL SERVICE LINES, ROUGH-IN AND MAKE FINAL CONNECTIONS TO ALL FIXTURES AND EQUIPMENT. PLUMBING CONTRACTOR SHALL FURNISH AND INSTALL ALL TRIMS AND COLD WATER STOPS AS REQUIRED.

**DEMOLITION KEY NOTES**

- 1 EXISTING PIPING ABOVE IN CEILING SPACE.
- 2 CAP EXISTING COLD WATER LINE ABOVE IN CEILING SPACE. PREPARE FOR RECONNECTION UNDER RENOVATION PHASE.
- 3 EXISTING COLD WATER LINE BELOW GRADE. REFER TO SITE PLAN FOR POINT OF ENTRY. SEE P1.1

**KEY NOTES**

- 1 PIPING ABOVE IN CEILING SPACE.
- 2 POINT OF CONNECTION TO EXISTING COLD WATER LINE ABOVE IN CEILING SPACE. PROVIDE LINE SIZE SHUT-OFF VALVE AS REQUIRED. PATCH TO MATCH EXISTING FINISH.
- 3 NEW COLD WATER LINE BELOW GRADE. REFER TO SITE PLAN FOR POINT OF ENTRY. SEE P1.1





**ARCHITECT** PBK Architects, Inc.  
 RANCHO CUCAMONGA  
 8163 Rochester Avenue, Suite 100  
 Rancho Cucamonga, California 91730  
 P 909-987-0909  
**CONSULTANT** LEAF ENGINEERS  
 8163 Rochester Avenue, Suite 100  
 Rancho Cucamonga, CA 91730  
 909-987-0909  
 leafengineers.com

JEFFERSON HUNT ES - WATER LINE REPLACEMENT

PROJECT ADDRESS:  
 1342 E. Pinalto St.  
 San Bernardino, CA 92404

CONSTRUCTION DOCUMENT

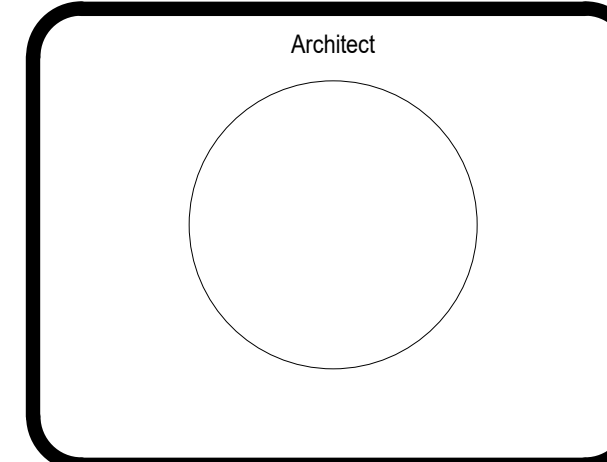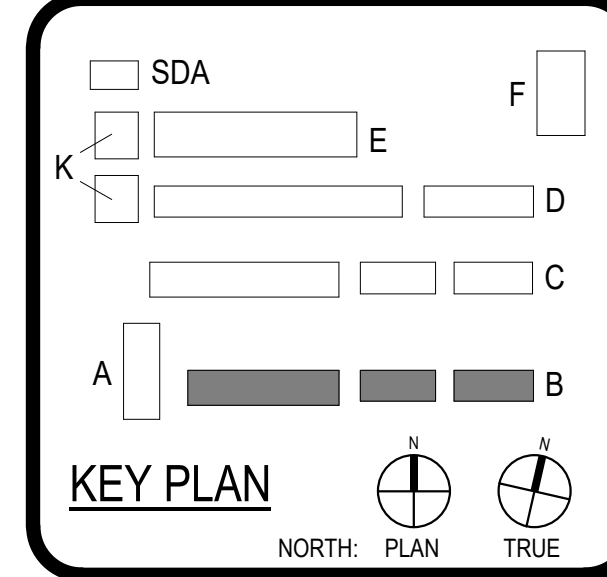


CLIENT: SAN BERNARDINO CITY USD  
 DATE: 10-10-23 PROJECT NUMBER: 230432


No.	Description	Date
2	Revision 2	4-11-2024

CONSTRUCTION DOCUMENT  
**PLUMBING FLOOR PLAN BLDG B**





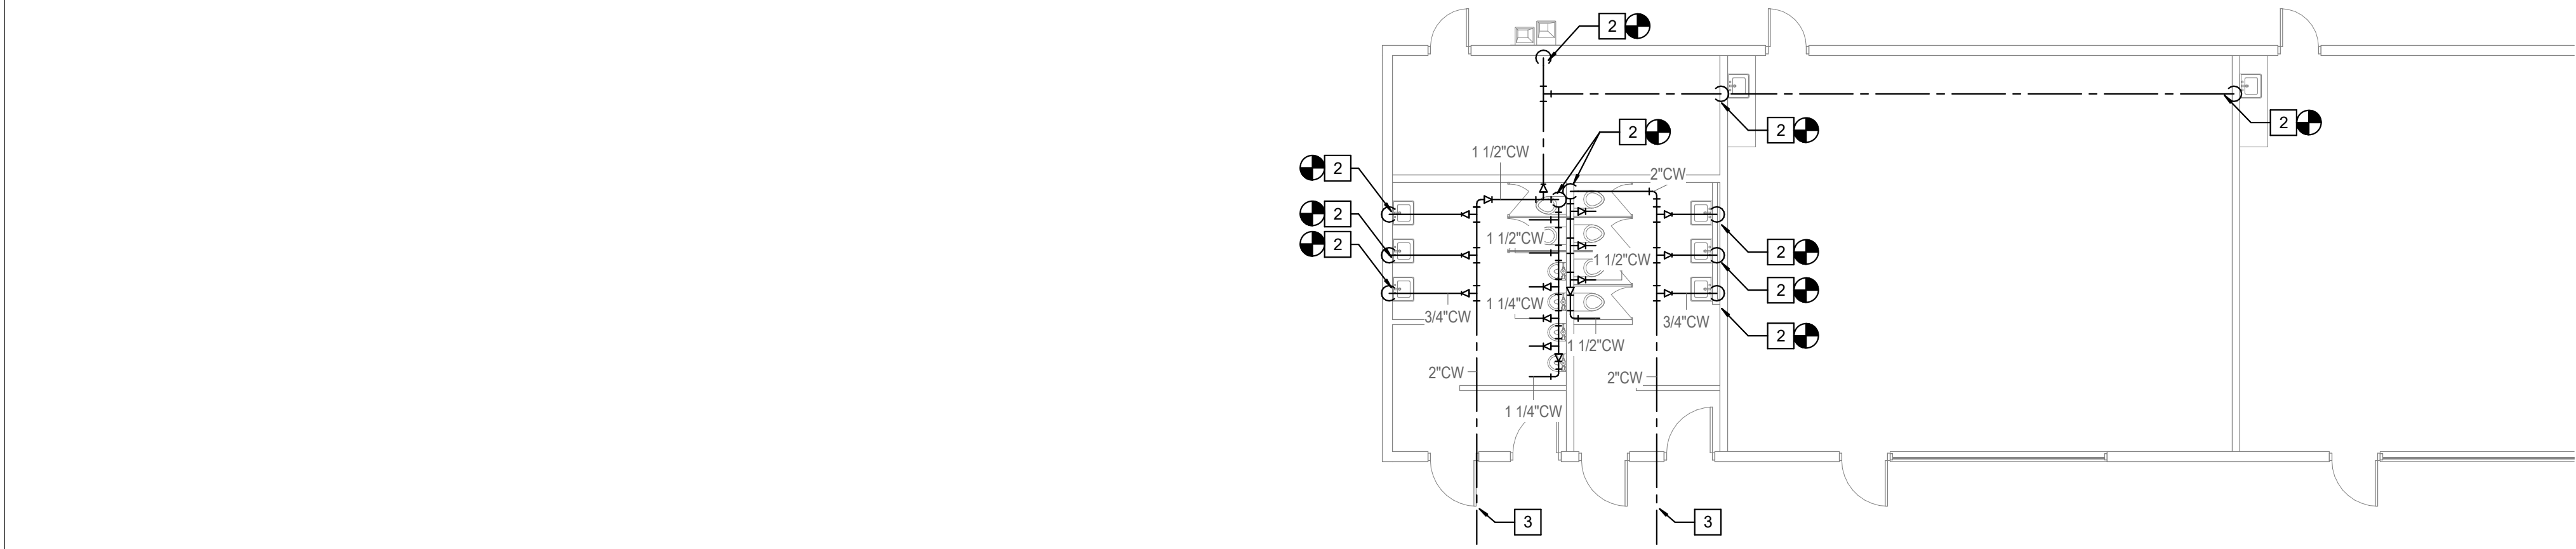



**NOTE:**  
 1. PLUMBING CONTRACTOR TO PROVIDE LIKE FOR LIKE PIPE SIZES FIELD VERIFY BEFORE START OF WORK.  
 2. EXISTING COLD WATER PIPING ABOVE THE CEILING TO BE REMOVED AND REPLACED WITH NEW PIPING IN SAME LOCATION. PROVIDE NEW PIPE SUPPORTS.  
 3. PROVIDE BALL VALVES AT EACH RESTROOM.

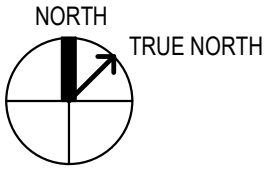



**4** PLUMBING FLOOR PLAN BLDG D EAST - NEW  
 1/8" = 1'-0"

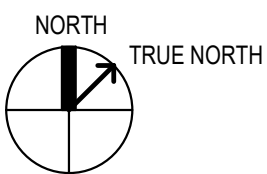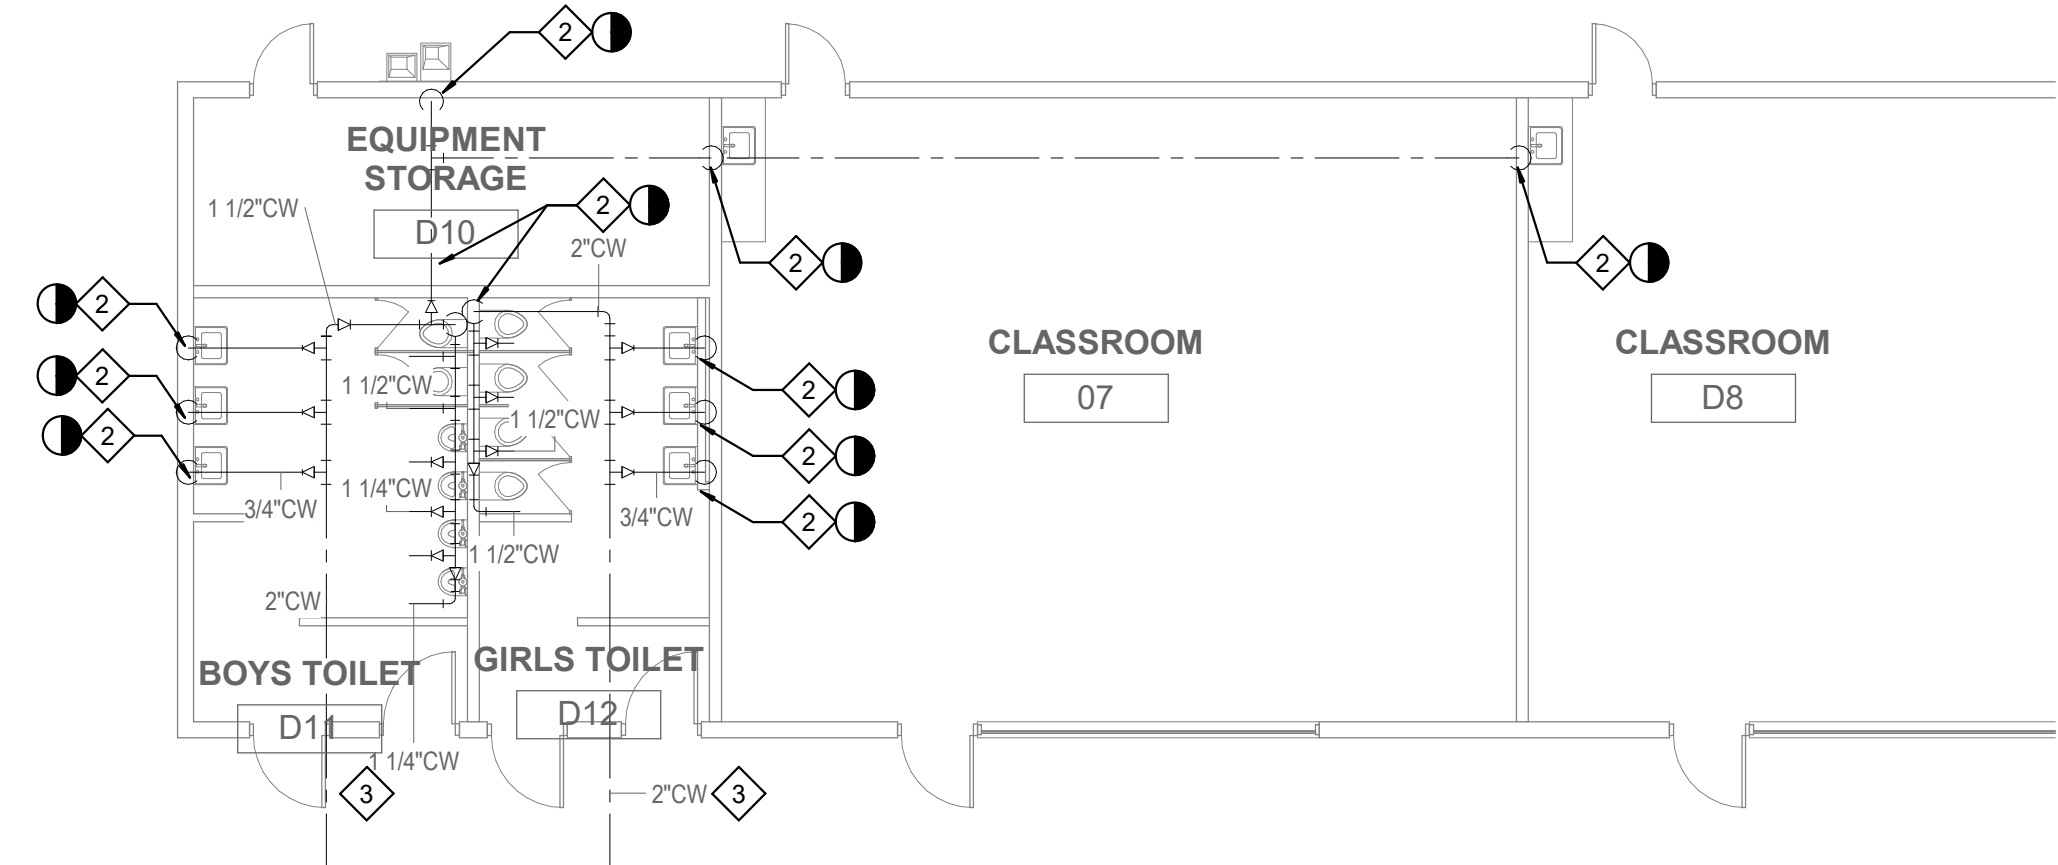

**3** PLUMBING FLOOR PLAN BLDG D EAST - DEMO  
 1/8" = 1'-0"

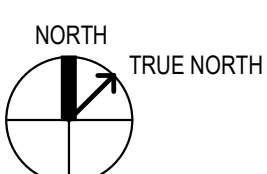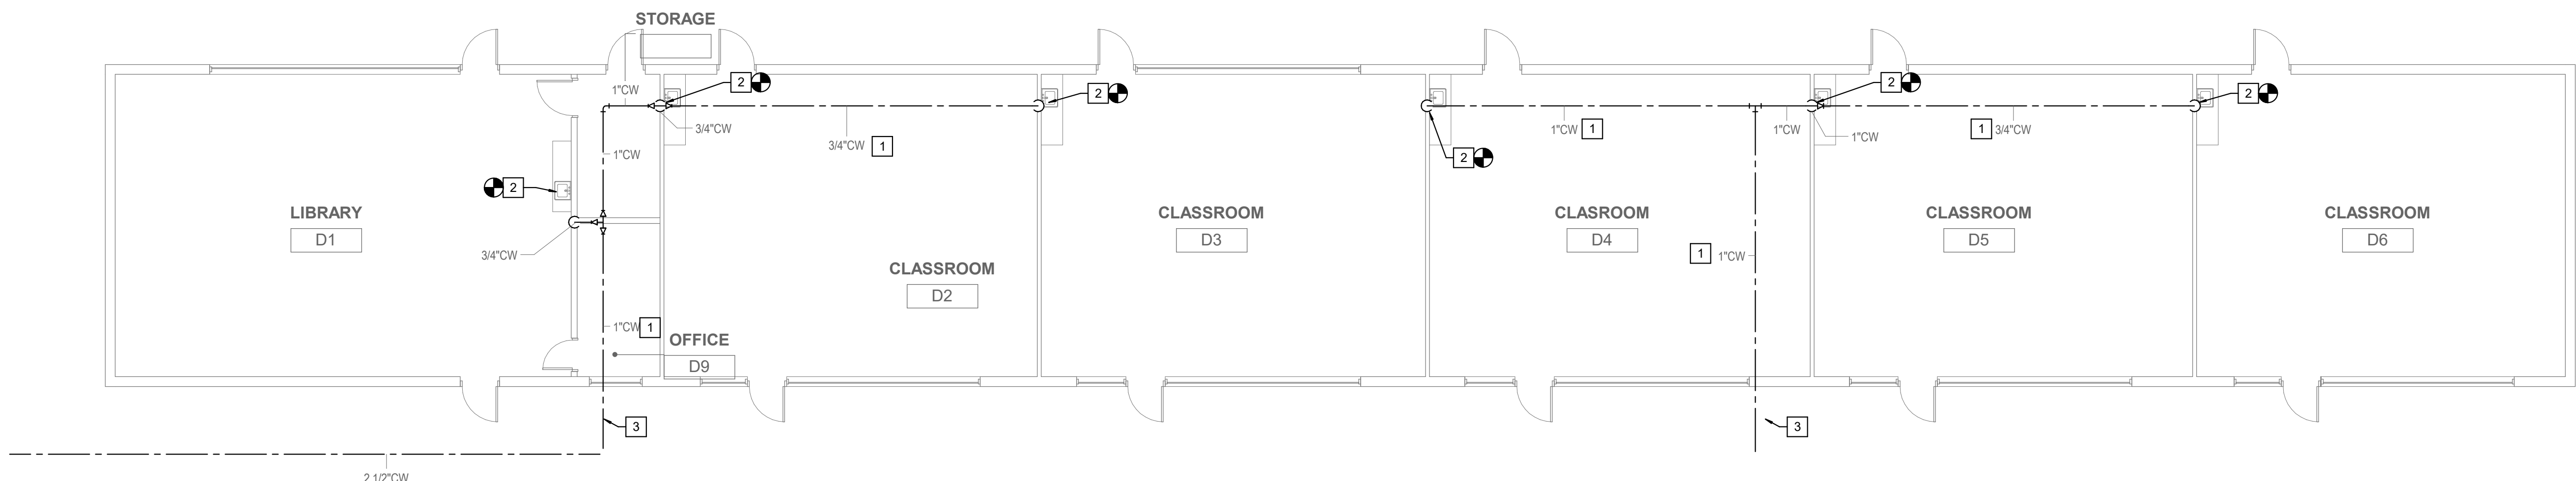

**2** PLUMBING FLOOR PLAN BLDG D - NEW  
 1/8" = 1'-0"

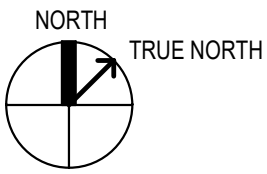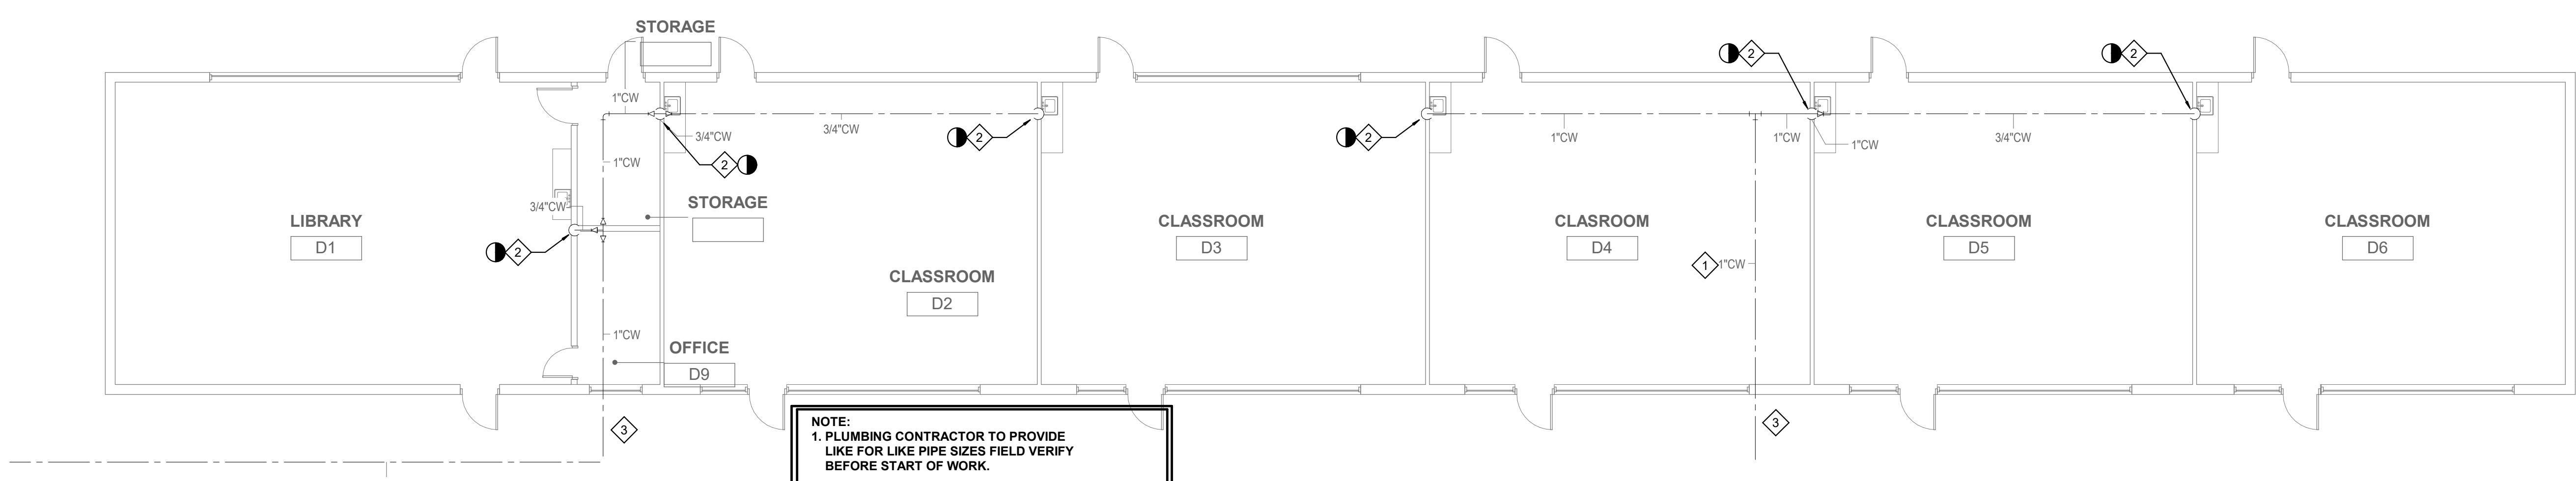

**1** PLUMBING FLOOR PLAN BLDG D - DEMO  
 1/8" = 1'-0"

**NOTE:**  
 1. PLUMBING CONTRACTOR TO PROVIDE LIKE FOR LIKE PIPE SIZES FIELD VERIFY BEFORE START OF WORK.  
 2. EXISTING COLD WATER PIPING ABOVE THE CEILING TO BE REMOVED AND REPLACED WITH NEW PIPING IN SAME LOCATION. PROVIDE NEW PIPE SUPPORTS.

**GENERAL NOTES**

1. MODIFY EXISTING PIPING SYSTEM ROUGH-IN. EXTEND AND CONNECT TO EXISTING DOMESTIC WATER.
2. PATCH TO MATCH FINISH.
3. FOR CONTINUATION OF ALL UTILITIES SEE BUILDING AS-BUILT / RECORD DRAWINGS.
4. BEFORE COMMENCEMENT OF WORK, THE CONTRACTOR SHALL VERIFY THE EXACT LOCATIONS, ELEVATIONS AND CHARACTERISTICS OF ALL UTILITIES AND PIPING BY PHYSICAL EXCAVATION, AND SHALL IMMEDIATELY NOTIFY THE ARCHITECT OF ANY DISCREPANCIES.
5. THE CONTRACTOR SHALL FIELD VERIFY ALL EXISTING UTILITIES AND POINTS OF CONNECTION PRIOR TO BIDDING PROJECT.
6. THE PLUMBING CONTRACTOR SHALL RUN ALL SERVICE LINES, ROUGH-IN AND MAKE FINAL CONNECTIONS TO ALL FIXTURES AND EQUIPMENT. PLUMBING CONTRACTOR SHALL FURNISH AND INSTALL ALL TRIMS AND COLD WATER STOPS AS REQUIRED.

**DEMOLITION KEY NOTES**

- 1 EXISTING PIPING ABOVE IN CEILING SPACE.
- 2 CAP EXISTING COLD WATER LINE ABOVE IN CEILING SPACE. PREPARE FOR RECONNECTION UNDER RENOVATION PHASE.
- 3 EXISTING COLD WATER LINE BELOW GRADE. REFER TO SITE PLAN FOR POINT OF ENTRY. SEE P1.1

**KEY NOTES**

- 1 PIPING ABOVE IN CEILING SPACE.
- 2 POINT OF CONNECTION TO EXISTING COLD WATER LINE ABOVE IN CEILING SPACE. PROVIDE LINE SIZE SHUT-OFF VALVE AS REQUIRED. PATCH TO MATCH EXISTING FINISH.
- 3 NEW COLD WATER LINE BELOW GRADE. REFER TO SITE PLAN FOR POINT OF ENTRY. SEE P1.1





ARCHITECT: PBK Architects, Inc.  
 RANCHO CUCAMONGA  
 8163 Rochester Avenue, Suite 100  
 Rancho Cucamonga, California 91730  
 P 909-987-0909  
 CONSULTANT: LEAF ENGINEERS  
 8163 Rochester Avenue, Suite 100  
 Rancho Cucamonga, CA 91730  
 909-987-0909  
 leafengineers.com

JEFFERSON HUNT ES - WATER LINE REPLACEMENT

PROJECT ADDRESS:  
 1342 E. Pinalto St.  
 San Bernardino, CA 92404



CONSTRUCTION DOCUMENT

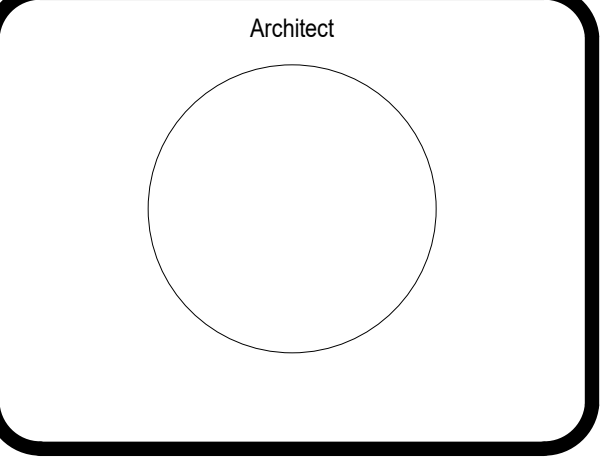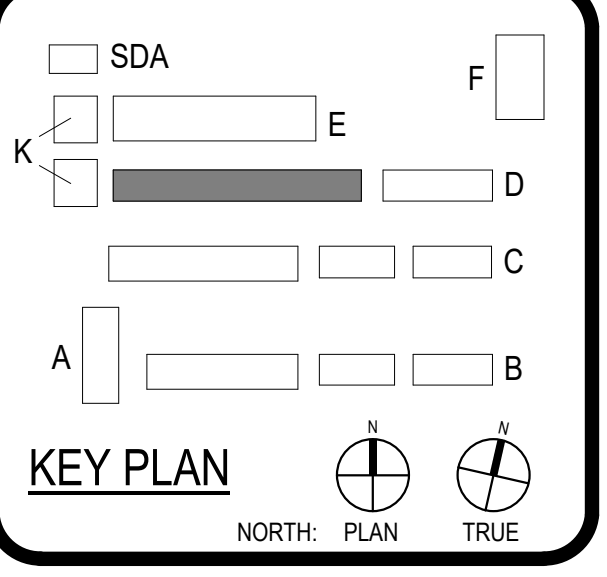



CLIENT: SAN BERNARDINO CITY USD  
 DATE: 10-10-23 PROJECT NUMBER: 230432

No.	Description	Date
2	Revision 2	4-11-2024



CONSTRUCTION DOCUMENT  
**PLUMBING FLOOR PLAN BLDG D**

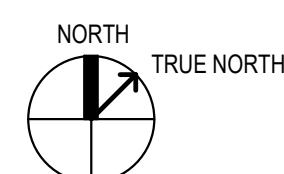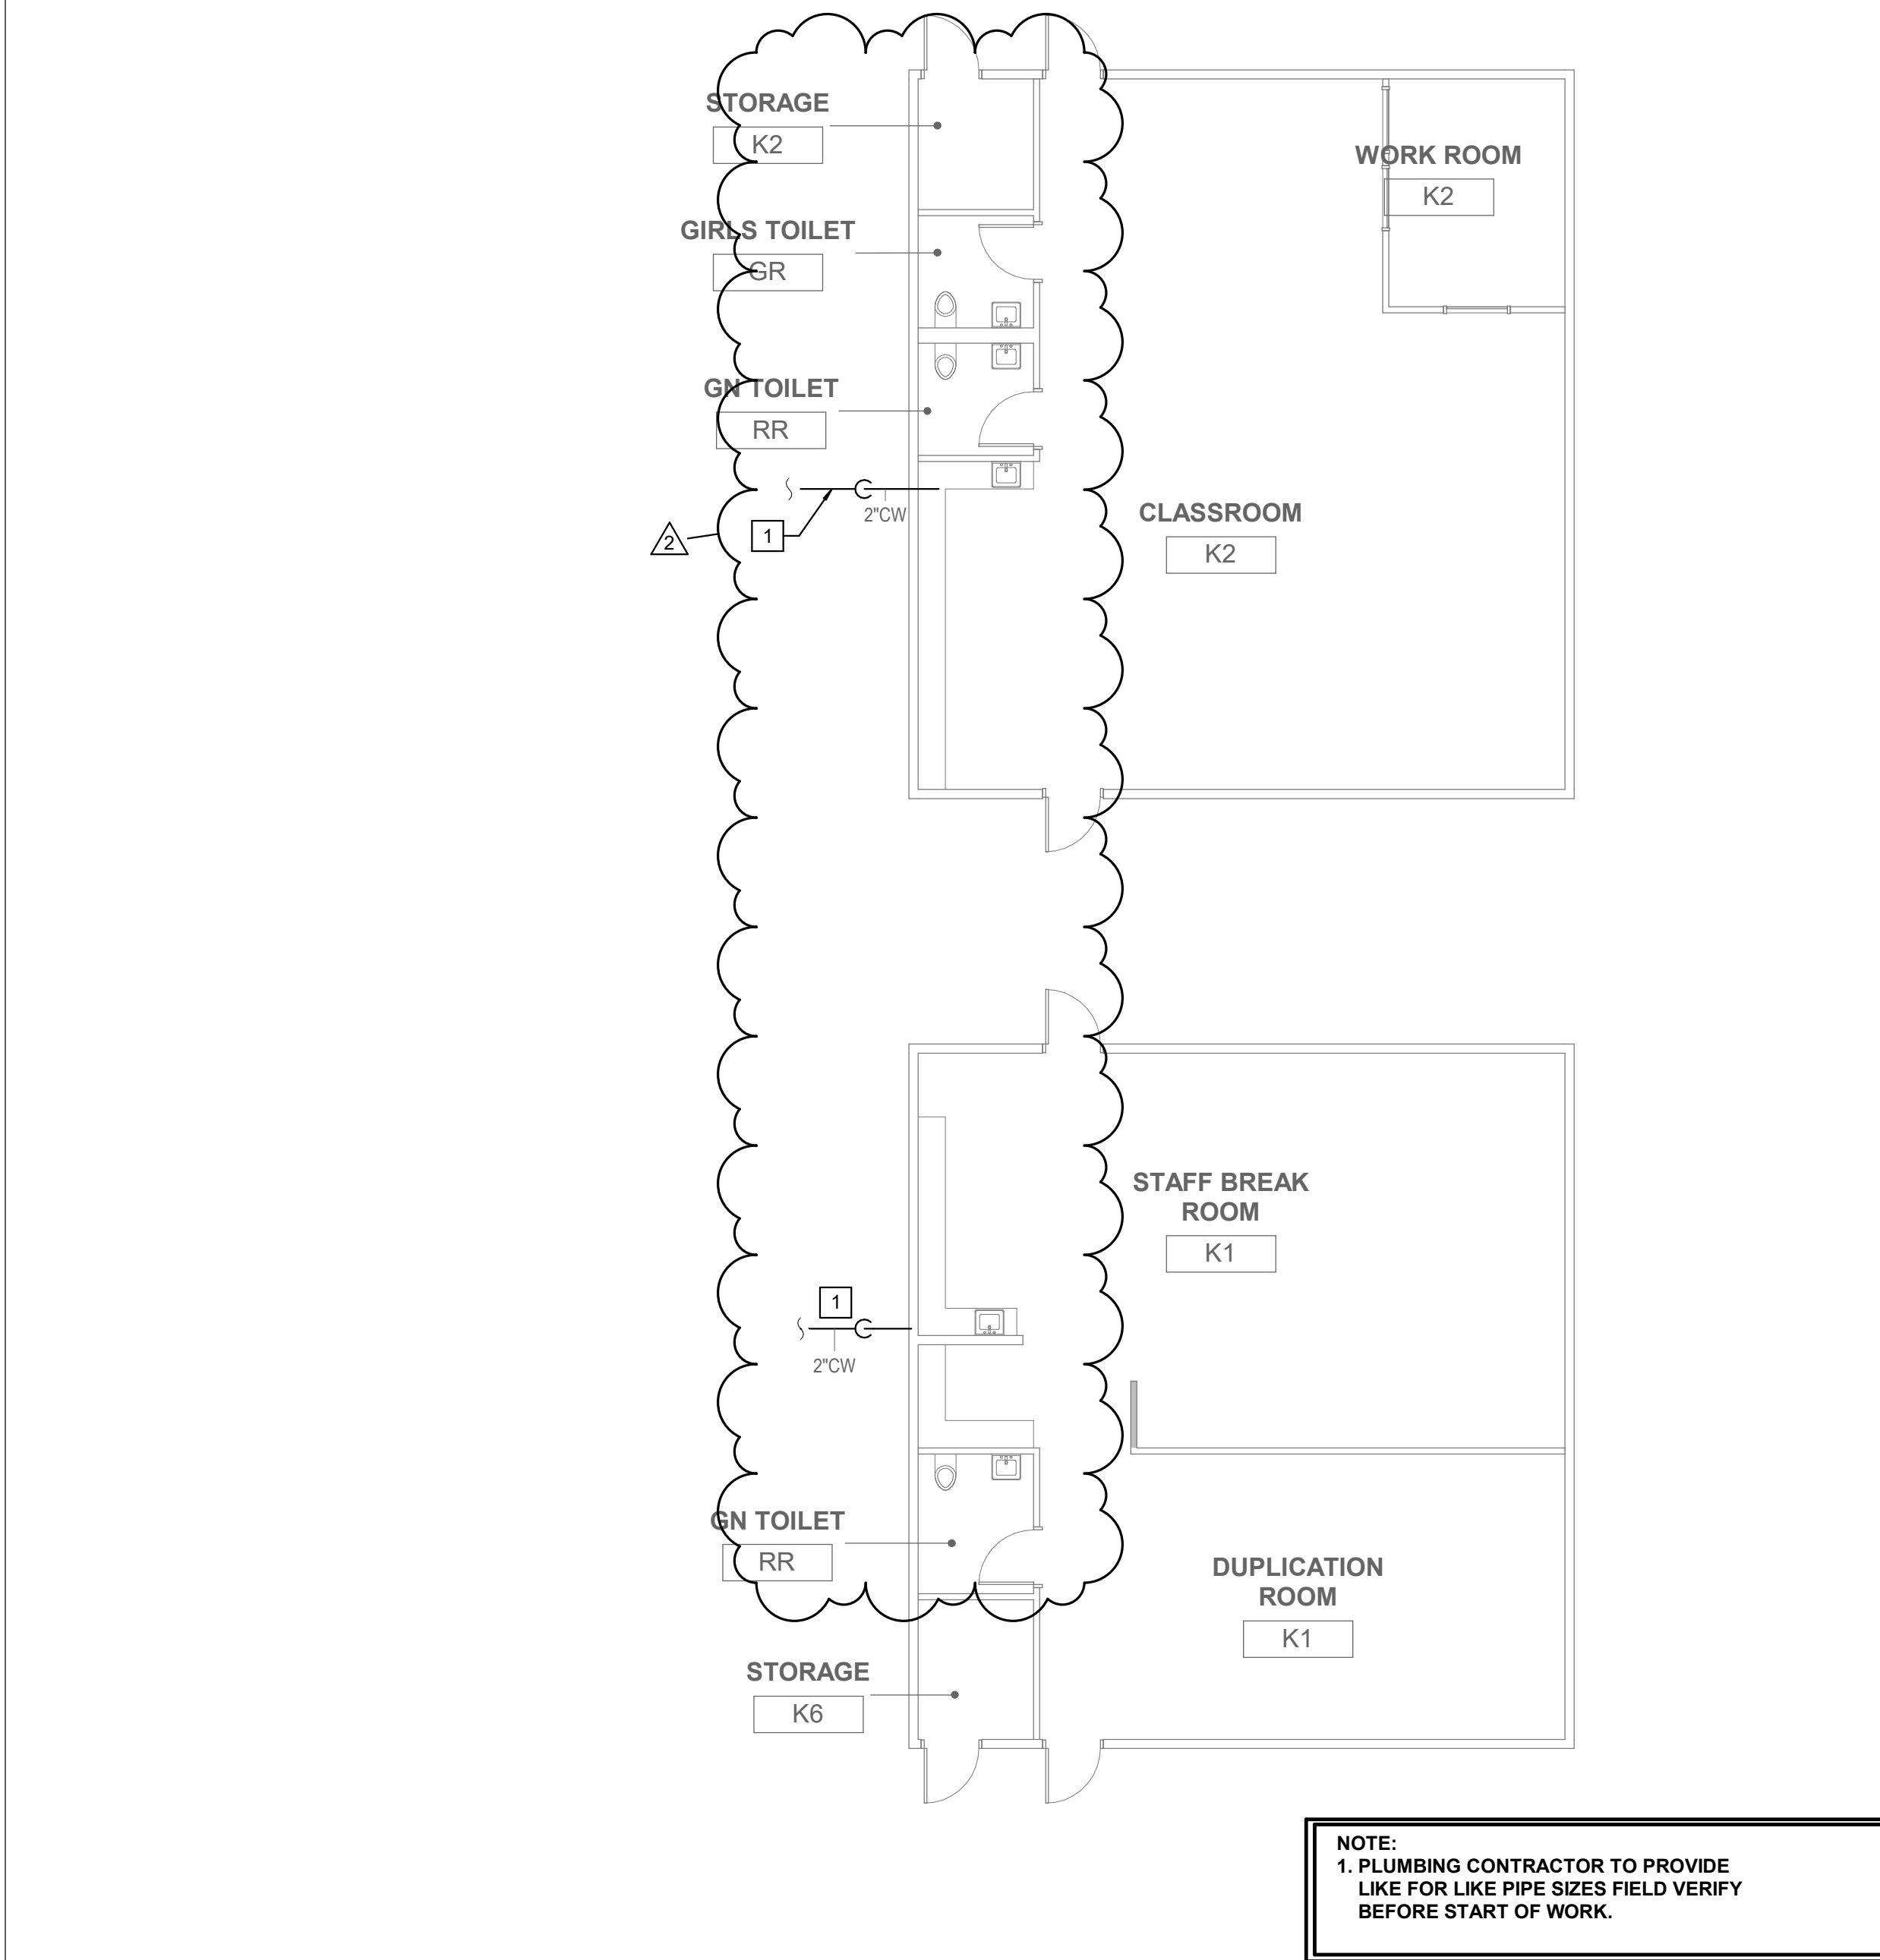



**4** PLUMBING FLOOR PLAN BLDG K - NEW  
1/8" = 1'-0"

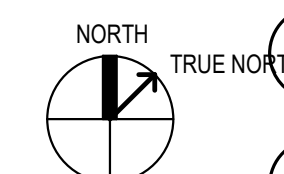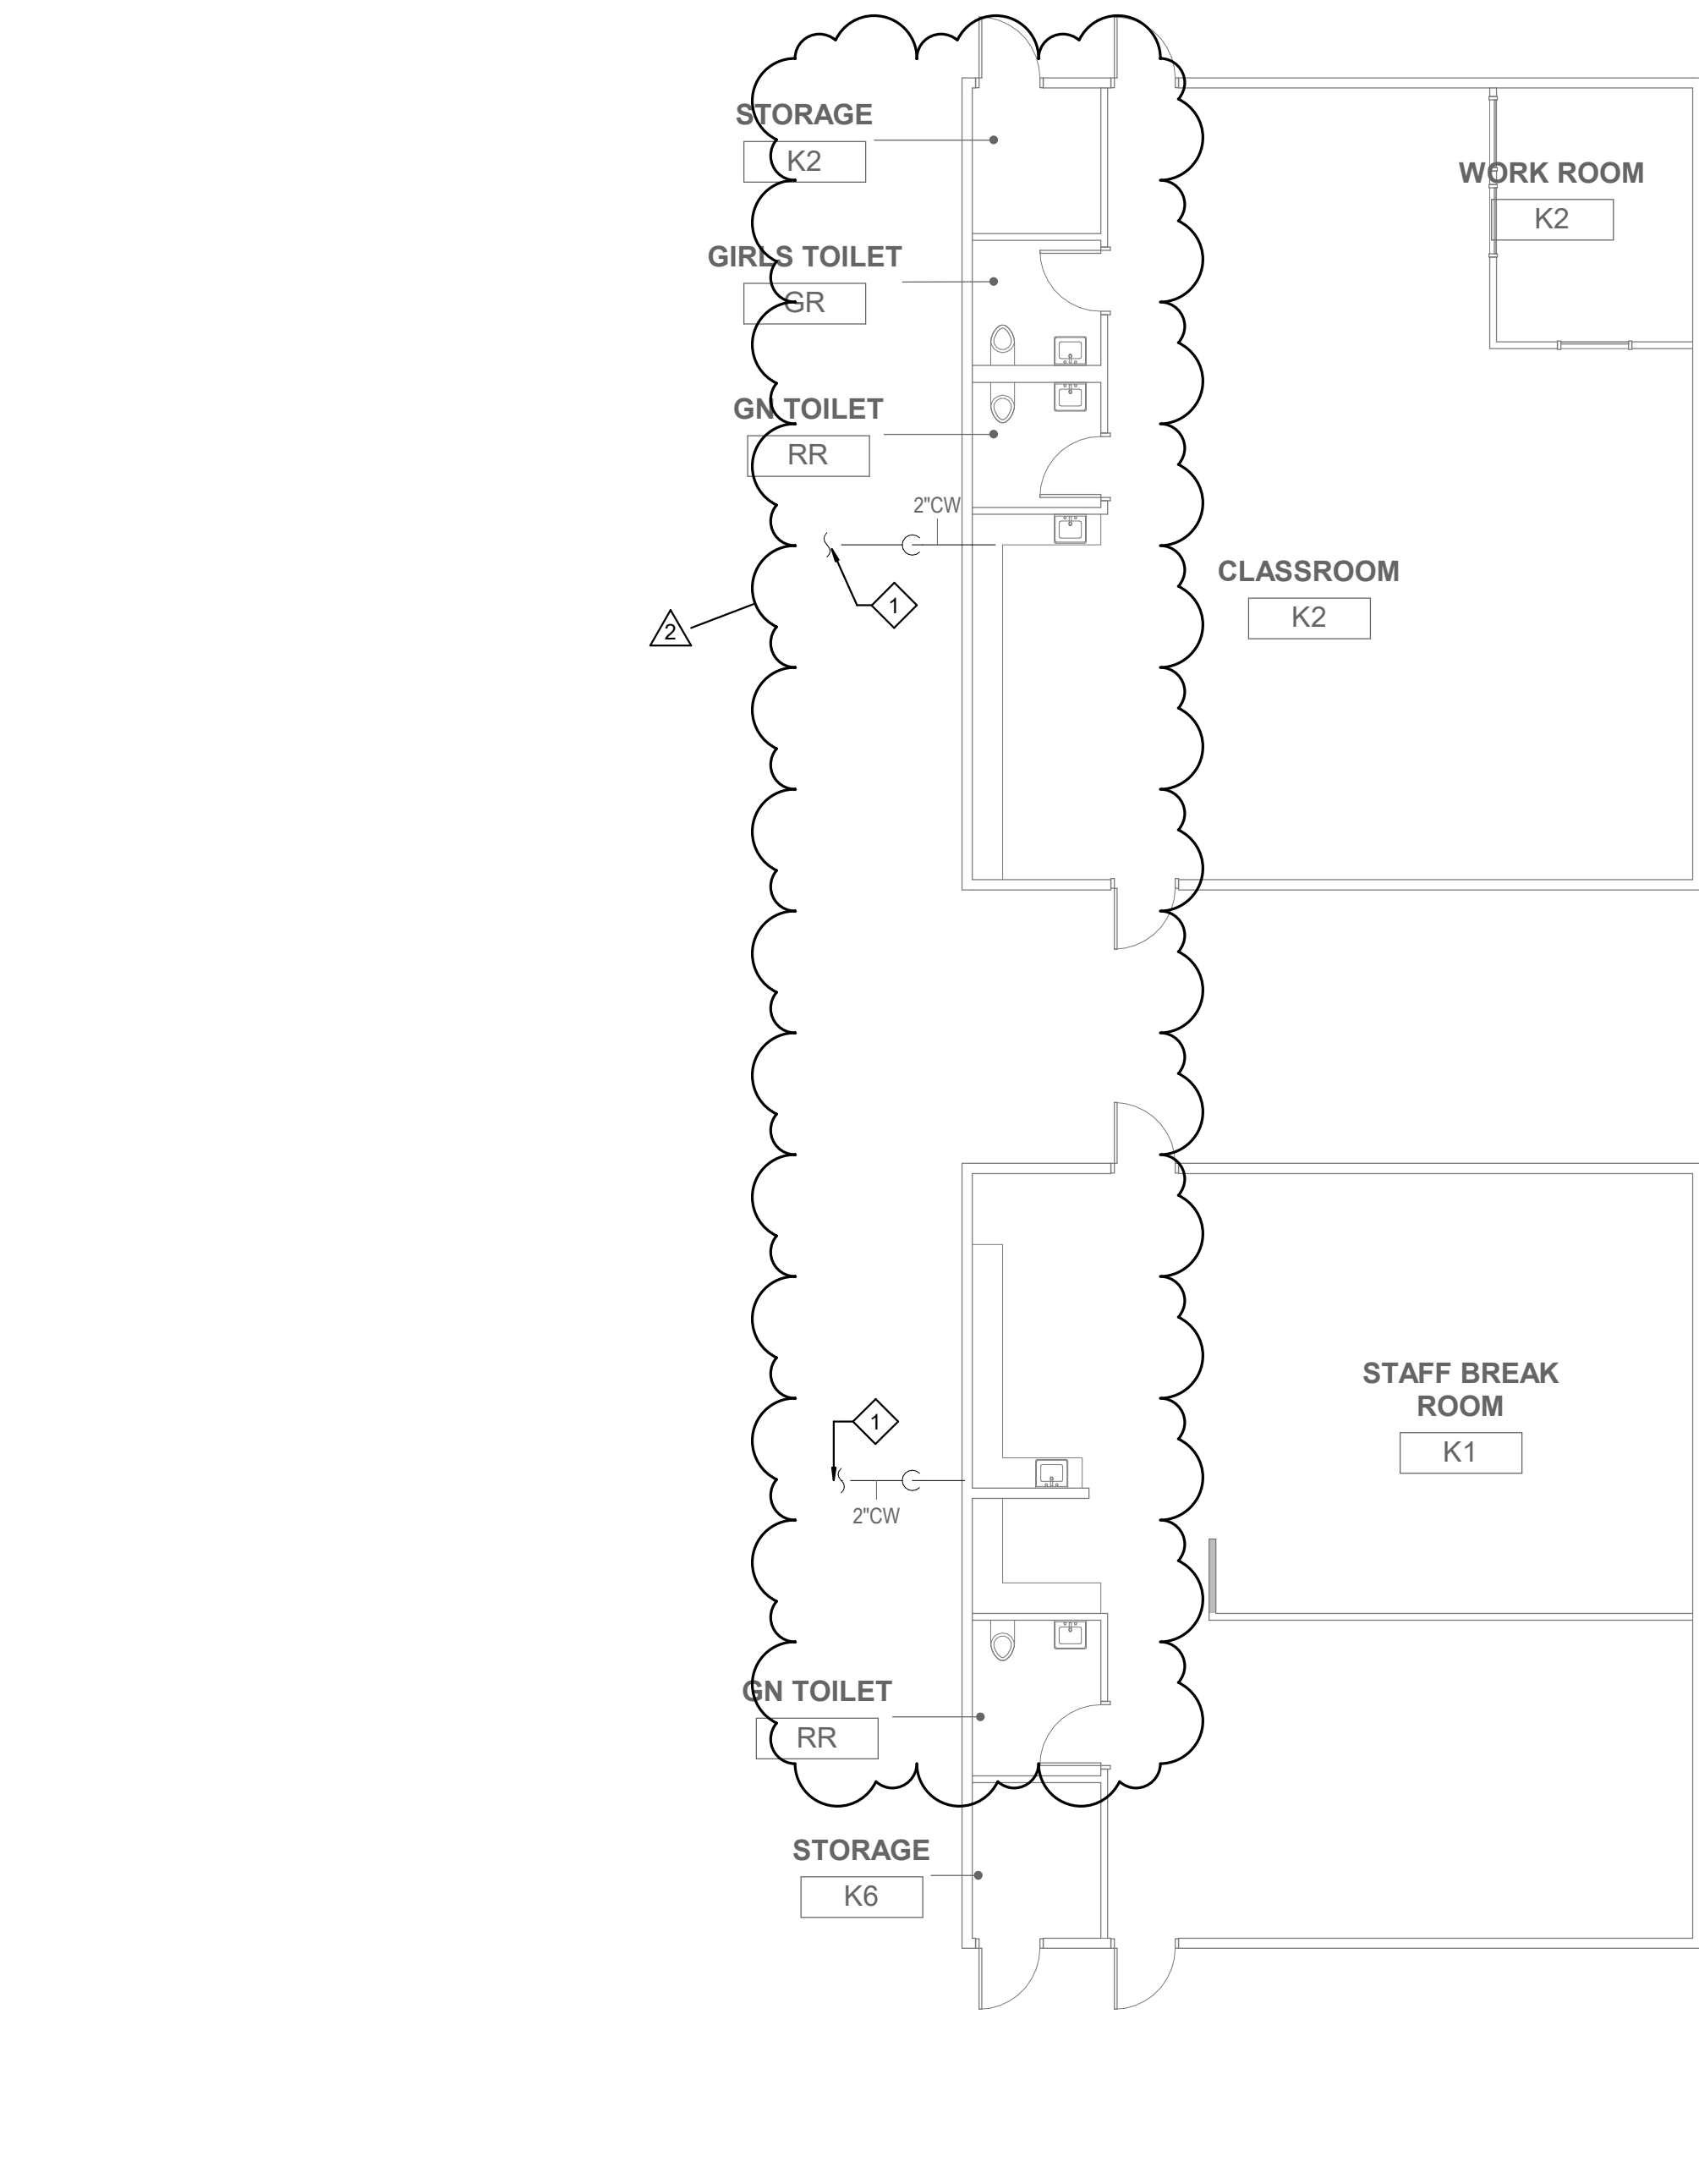

**3** PLUMBING FLOOR PLAN BLDG K - DEMO  
1/8" = 1'-0"

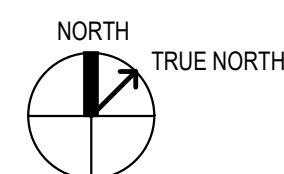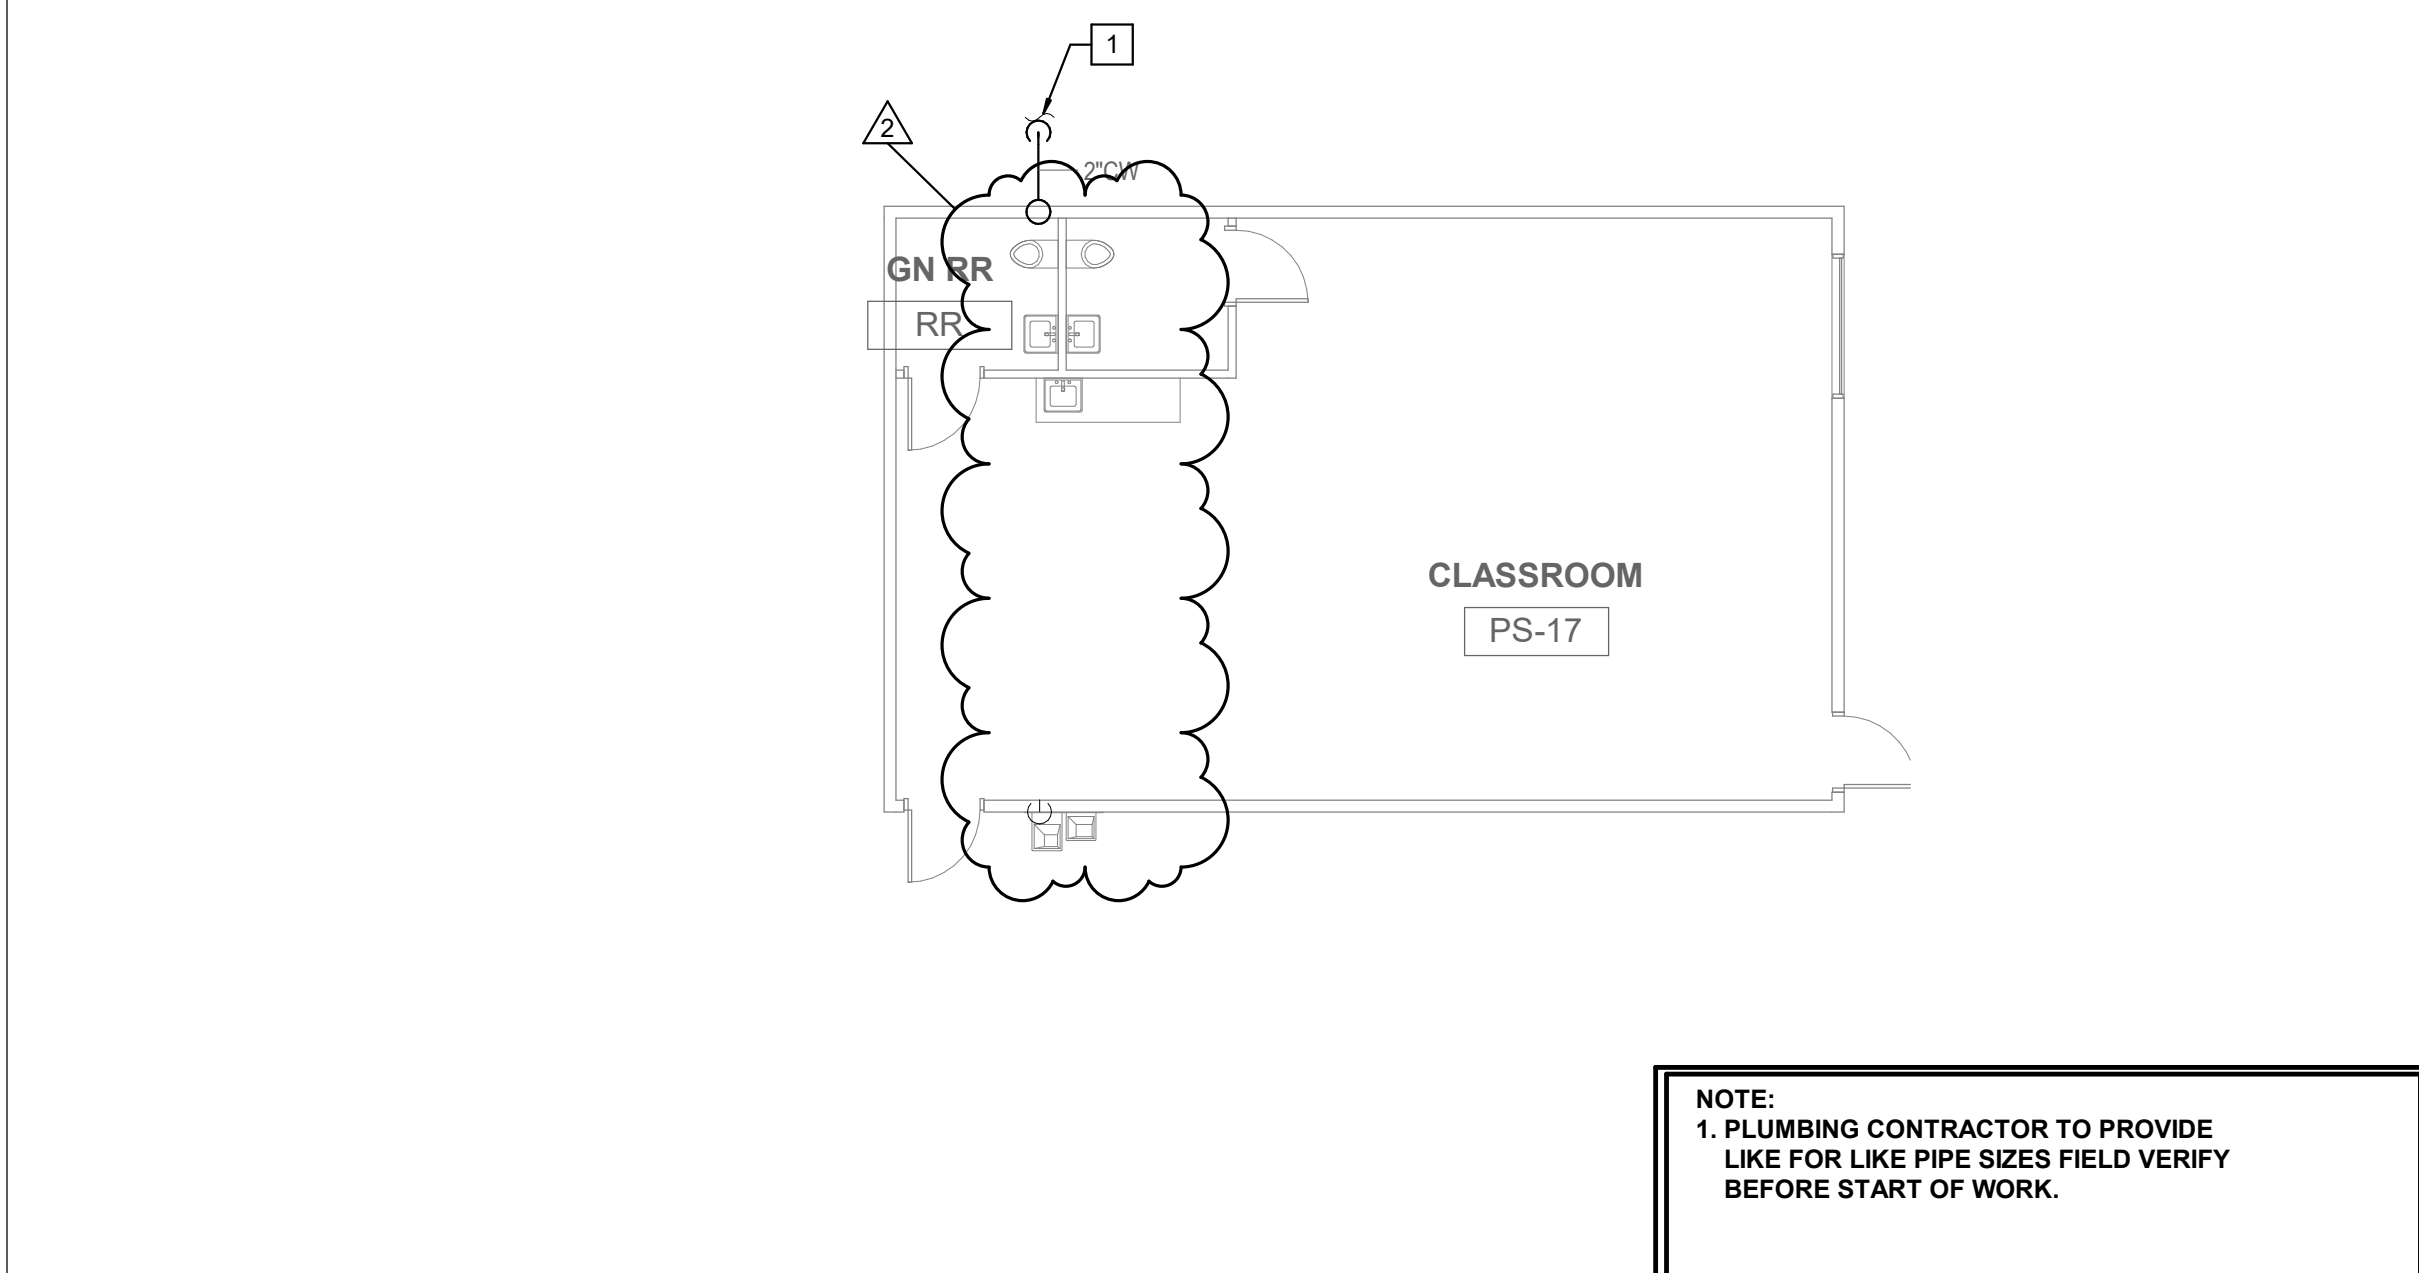

**2** PLUMBING FLOOR PLAN BLDG F - NEW  
1/8" = 1'-0"

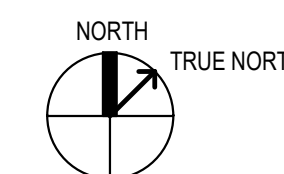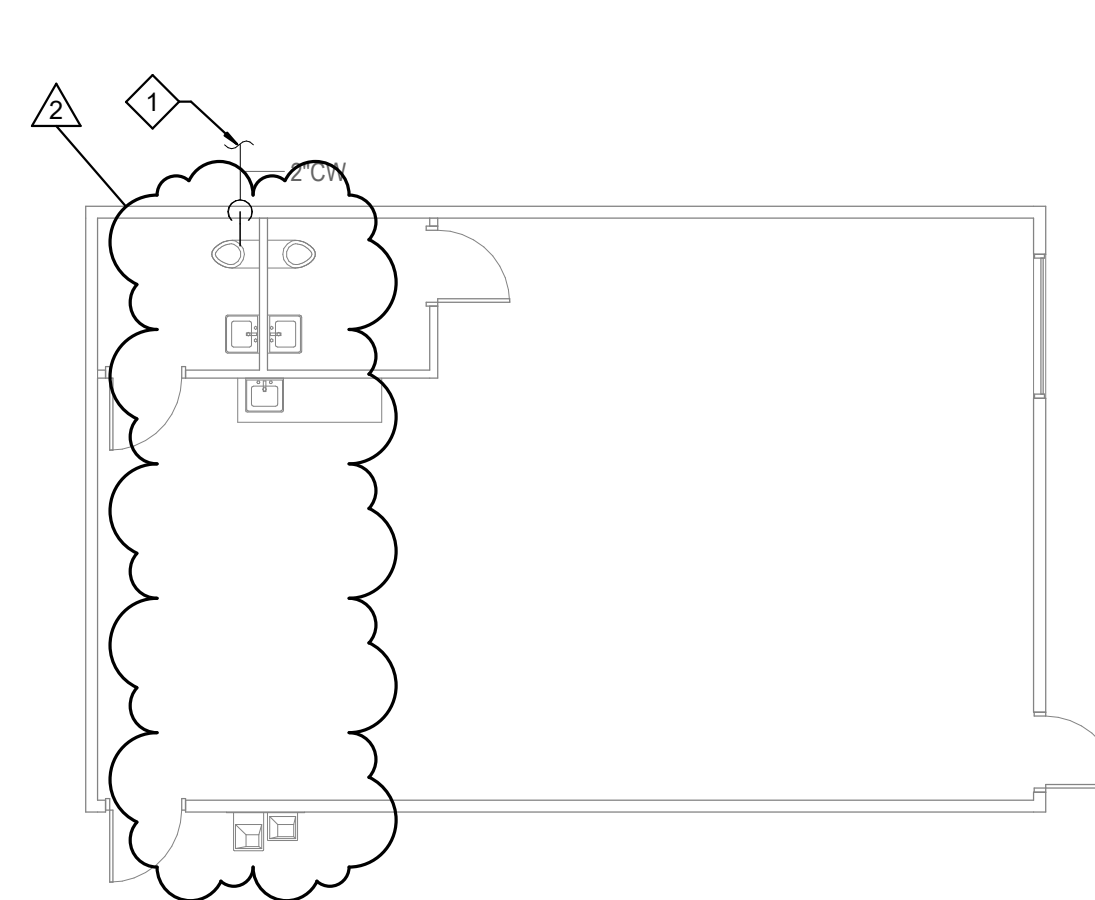

**1** PLUMBING FLOOR PLAN BLDG F - DEMO  
1/8" = 1'-0"

**GENERAL NOTES**

1. MODIFY EXISTING PIPING SYSTEM ROUGH-IN, EXTEND AND CONNECT TO EXISTING DOMESTIC WATER.
2. PATCH TO MATCH FINISH.
3. FOR CONTINUATION OF ALL UTILITIES SEE BUILDING AS-BUILT / RECORD DRAWINGS.
4. BEFORE COMMENCEMENT OF WORK, THE CONTRACTOR SHALL VERIFY THE EXACT LOCATIONS, ELEVATIONS AND CHARACTERISTICS OF ALL UTILITIES AND PIPING BY PHYSICAL EXCAVATION, AND SHALL IMMEDIATELY NOTIFY THE ARCHITECT OF ANY DISCREPANCIES.
5. THE CONTRACTOR SHALL FIELD VERIFY ALL EXISTING UTILITIES AND POINTS OF CONNECTION PRIOR TO BIDDING PROJECT.
6. THE PLUMBING CONTRACTOR SHALL RUN ALL SERVICE LINES, ROUGH-IN AND MAKE FINAL CONNECTIONS TO ALL FIXTURES AND EQUIPMENT. PLUMBING CONTRACTOR SHALL FURNISH AND INSTALL ALL TRIMS AND COLD WATER STOPS AS REQUIRED.

**DEMOLITION KEY NOTES**

- 1. EXISTING COLD WATER LINE BELOW GRADE. REFER TO SITE PLAN FOR POINT OF ENTRY. SEE P1.1

**KEY NOTES**

- 1. NEW COLD WATER LINE BELOW GRADE. REFER TO SITE PLAN FOR POINT OF ENTRY. SEE P1.1





ARCHITECT: PBK Architects, Inc.  
RANCHO CUCAMONGA  
8163 Rochester Avenue, Suite 100  
Rancho Cucamonga, CA 91730  
P 909-987-0909

CONSULTANT: LEAF ENGINEERS  
8163 Rochester Avenue, Suite 100  
Rancho Cucamonga, CA 91730  
909-987-0909  
leafengineers.com

JEFFERSON HUNTES - WATER LINE REPLACEMENT

PROJECT ADDRESS:  
1342 E. Pinalto St.  
San Bernardino, CA 92404

CONSTRUCTION DOCUMENT

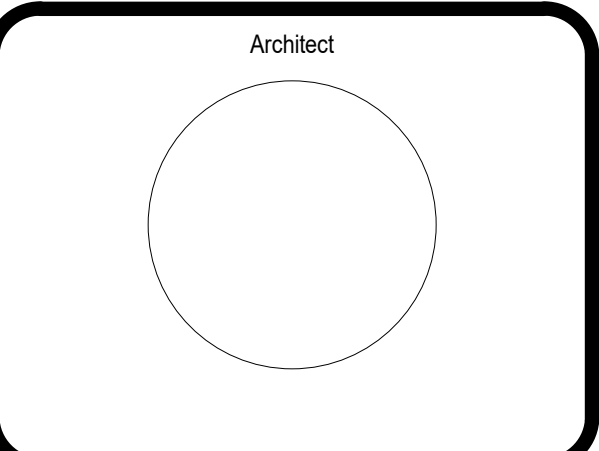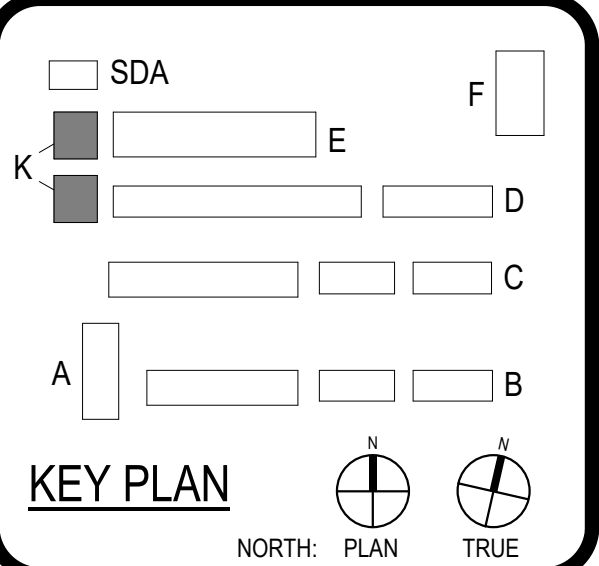


CLIENT: SAN BERNARDINO CITY USD  
DATE: 10-10-23 PROJECT NUMBER: 230432

No.	Description	Date
2	Revision 2	4-11-2024


CONSTRUCTION DOCUMENT

PLUMBING FLOOR PLAN  
BLDG F, K



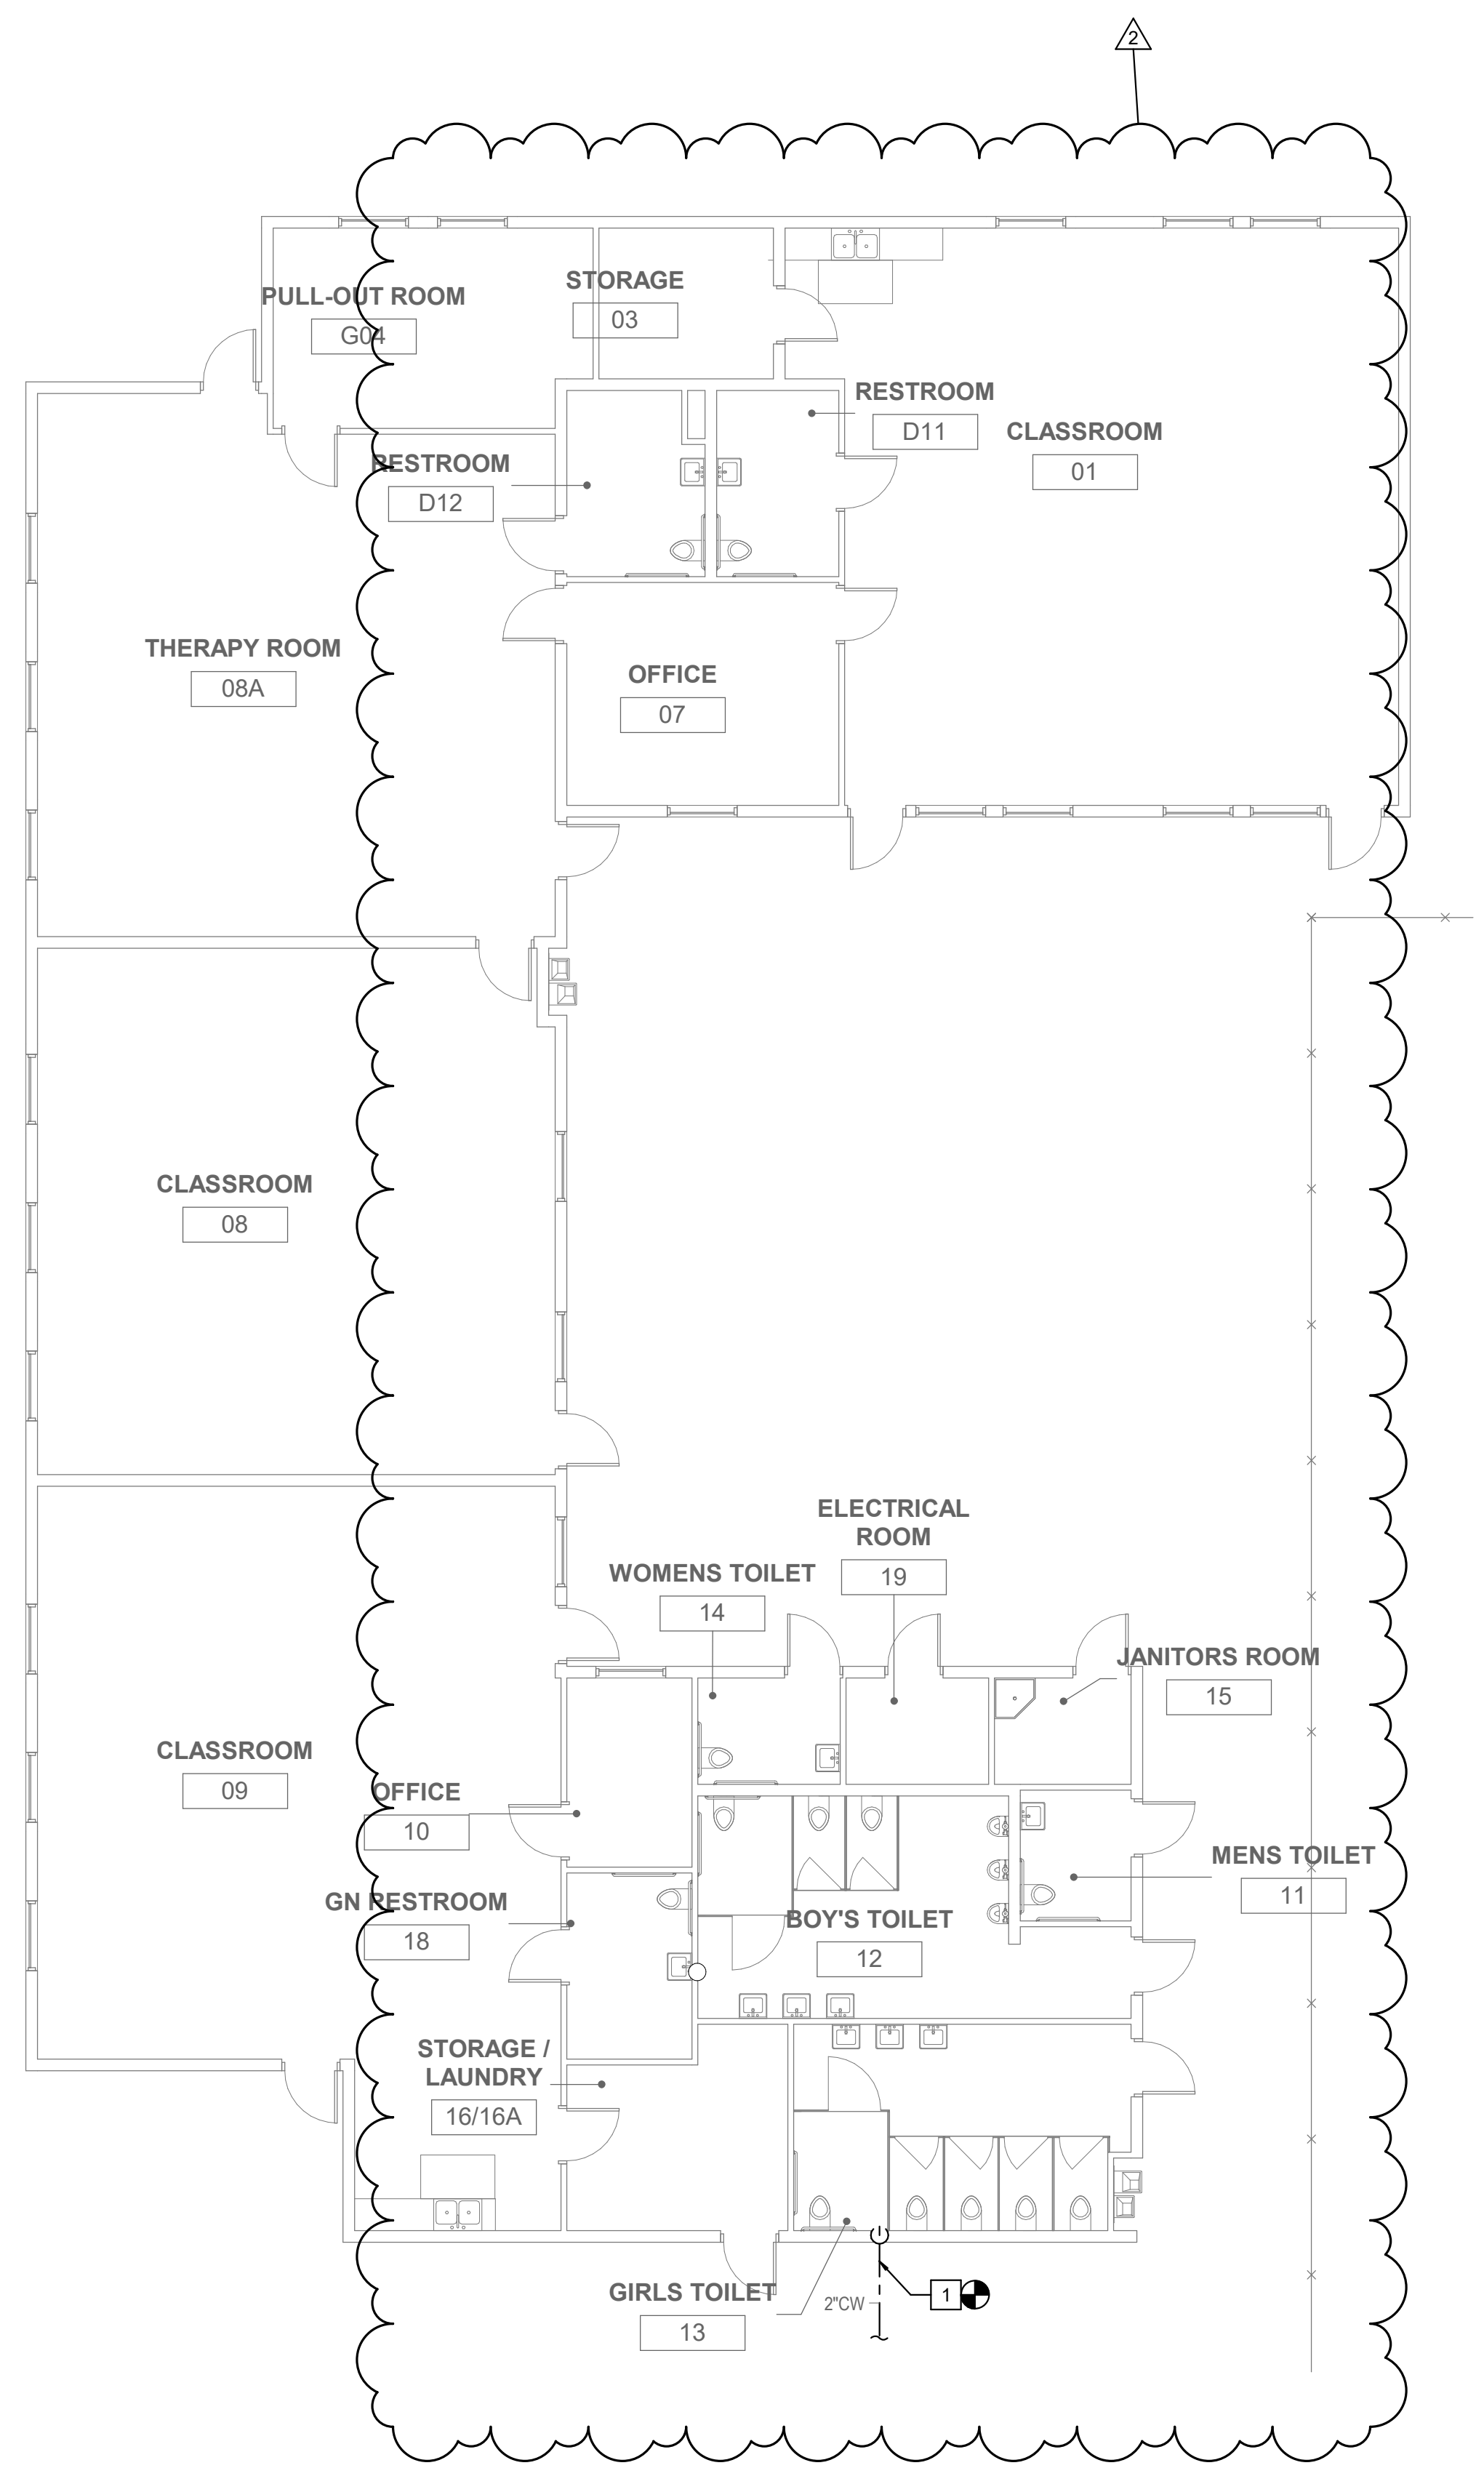

NOTE:  
1. PLUMBING CONTRACTOR TO PROVIDE  
LIKE FOR LIKE PIPE SIZES FIELD VERIFY  
BEFORE START OF WORK.

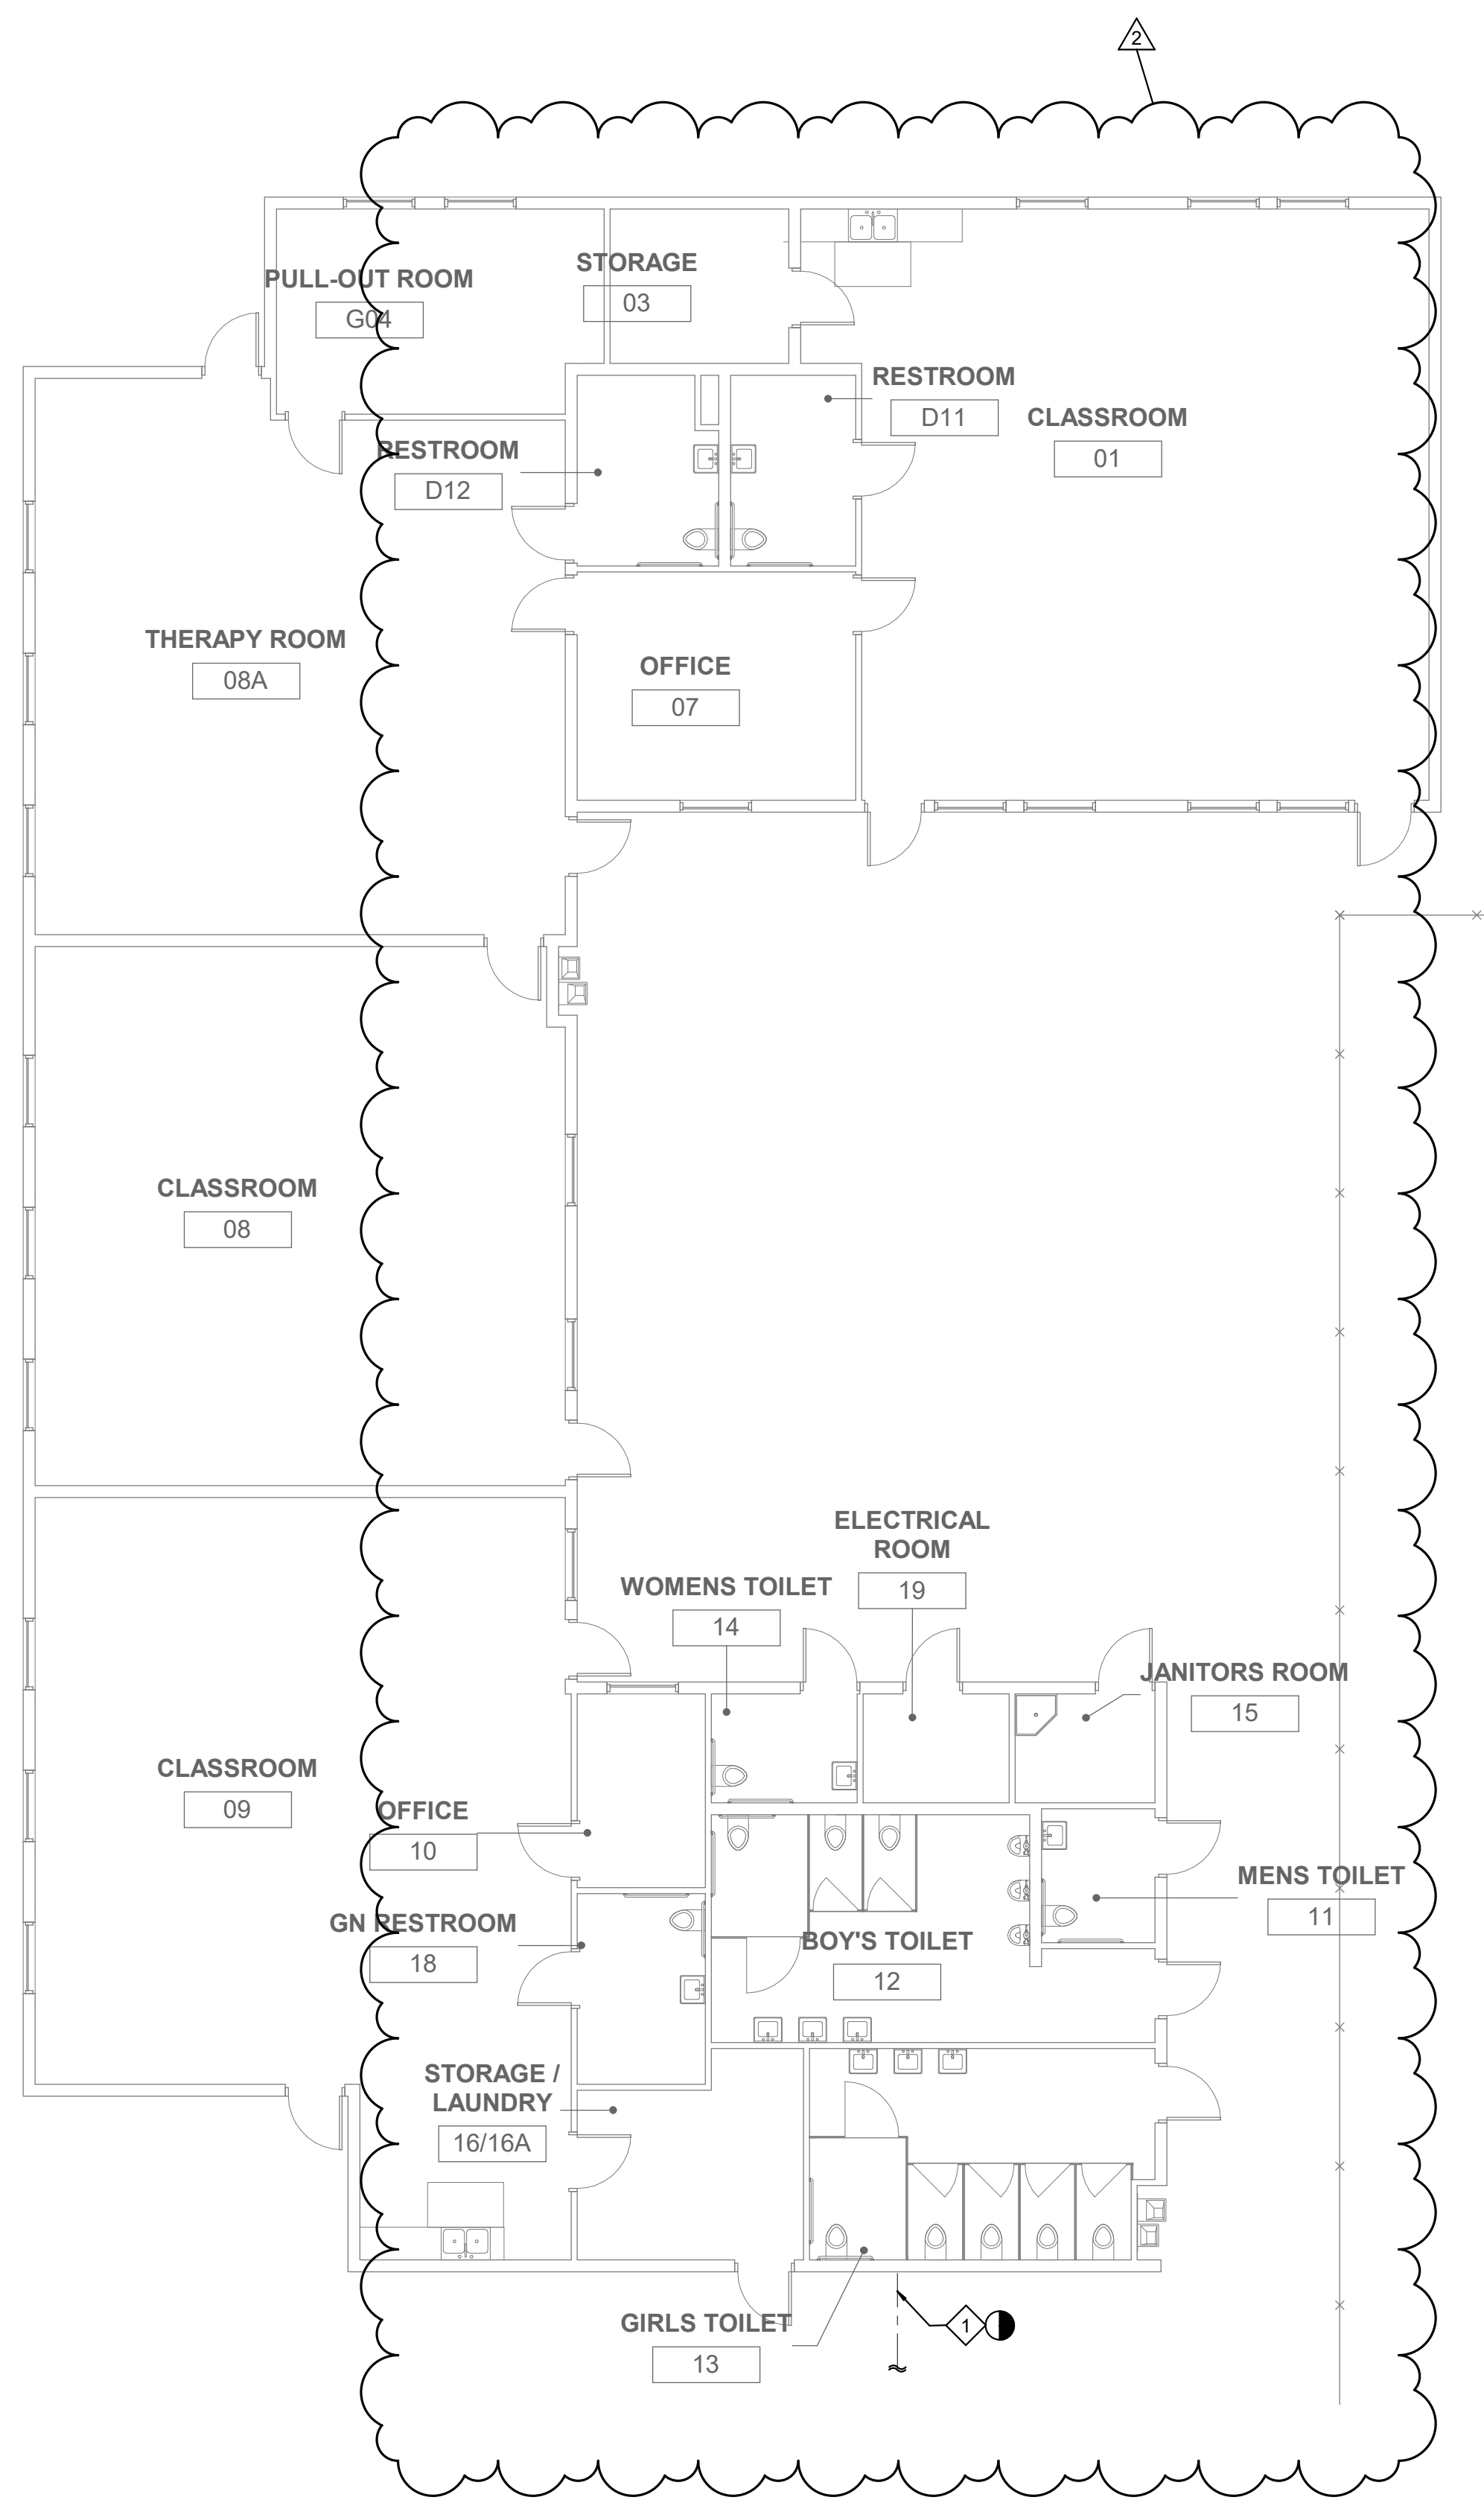

**GENERAL NOTES**

1. MODIFY EXISTING PIPING SYSTEM ROUGH-IN, EXTEND AND CONNECT TO EXISTING DOMESTIC WATER.
2. PATCH TO MATCH FINISH.
3. FOR CONTINUATION OF ALL UTILITIES SEE BUILDING AS-BUILT / RECORD DRAWINGS.
4. BEFORE COMMENCEMENT OF WORK, THE CONTRACTOR SHALL VERIFY THE EXACT LOCATIONS, ELEVATIONS AND CHARACTERISTICS OF ALL UTILITIES AND PIPING BY PHYSICAL EXCAVATION, AND SHALL IMMEDIATELY NOTIFY THE ARCHITECT OF ANY DISCREPANCIES.
5. THE CONTRACTOR SHALL FIELD VERIFY ALL EXISTING UTILITIES AND POINTS OF CONNECTION PRIOR TO BIDDING PROJECT.
6. THE PLUMBING CONTRACTOR SHALL RUN ALL SERVICE LINES, ROUGH-IN AND MAKE FINAL CONNECTIONS TO ALL FIXTURES AND EQUIPMENT. PLUMBING CONTRACTOR SHALL FURNISH AND INSTALL ALL TRIMS AND COLD WATER STOPS AS REQUIRED.

**DEMOLITION KEY NOTES**

1. EXISTING COLD WATER LINE BELOW GRADE. REFER TO SITE PLAN FOR POINT OF ENTRY. SEE P1.1

**KEY NOTES**

1. NEW COLD WATER LINE BELOW GRADE. REFER TO SITE PLAN FOR POINT OF ENTRY. SEE P1.1





ARCHITECT: PBK Architects, Inc.  
RANCHO CUCAMONGA  
8163 Rochester Avenue, Suite 100  
Rancho Cucamonga, CA 91730  
P 909-987-0909

CONSULTANT: LEAF ENGINEERS  
8163 Rochester Avenue, Suite 100  
Rancho Cucamonga, CA 91730  
909.987-0909  
leafengineers.com

**JEFFERSON HUNT ES - WATER LINE REPLACEMENT**

PROJECT ADDRESS:  
1342 E. Pinalo St.  
San Bernardino, CA 92404

CONSTRUCTION DOCUMENT

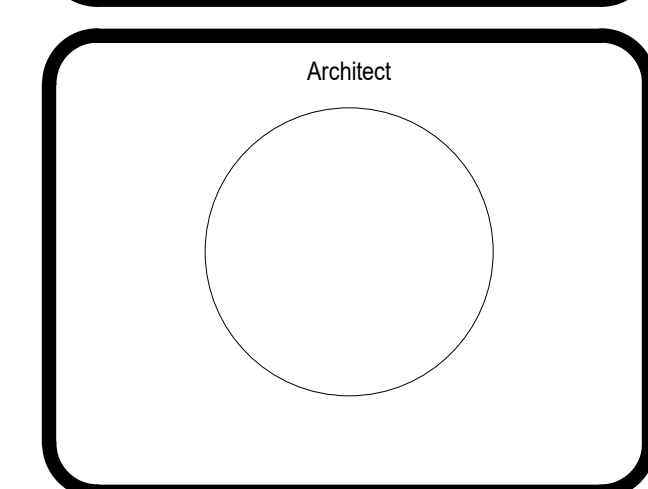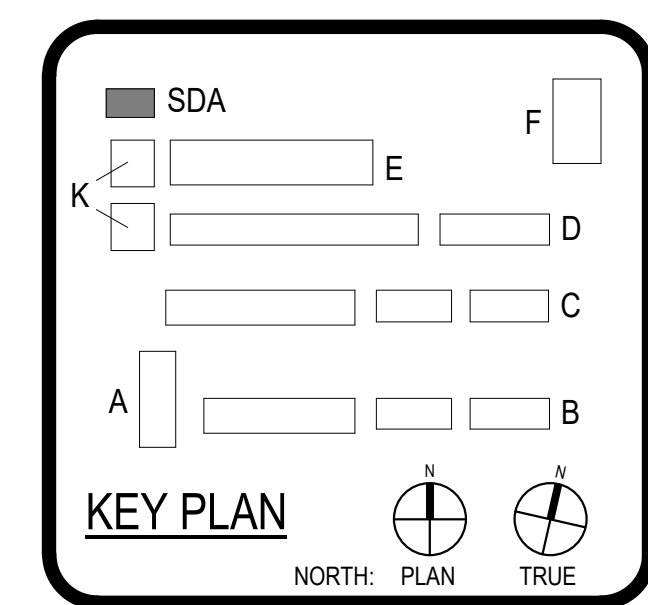

CLIENT: SAN BERNARDINO CITY USD  
DATE: 10-10-23 PROJECT NUMBER: 230432

No.	Description	Date
2	Revision 2	4-11-2024

CONSTRUCTION DOCUMENT

**PLUMBING FLOOR PLAN  
BLDG SDA**











