

April 2, 2021

TO	:	All Bidders
FROM	:	Mark Graham
PROJECT	:	Bonnie Oehl Elementary School Modernization
		1719700.41
SUBJECT	:	Addendum 2
DSA	:	04-118651 / 36-55

The following changes, omissions, and/or additions to the Project Manual and/or Drawings shall apply to proposals made for and to the execution of the various parts of the work affected thereby, and all other conditions shall remain the same.

Careful note of the Addendum shall be taken by all parties of interest so that the proper allowances may be made in strict accordance with the Addendum, and that all trades shall be fully advised in the performance of the work which will be required of them.

Bidder shall acknowledge receipt of this Addendum in the space provided on the Bid Form. Failure to do so may subject Bidder to disqualification.

In case of conflict between Drawings, Project Manual, and this Addendum, this Addendum shall govern.

2 PROJECT MANUAL

- 2.1 ASBESTOS ABATEMENT SPECIFICATIONS
 - A. Add the attached asbestos specification in its entirety.

DRAWINGS

Architectural

- 2.2 DRAWING A1.0 DEMO OVERALL SITE & FLOOR PLAN
 - A. Replaced DSA approved Drawing A1.0 with the attached revised Drawing A1.0 in its entirety.
 - 1. REFERENCE NOTES
 - a. Revised Keynote 0118 by adding 'AND FOOTING'.
 - b. Revised Keynote 0132 detail reference to '9/10.1'.

- c. Revised Keynote 0154 detail reference to '19/10.1'.
- d. Revised Keynote 0172 indicating, 'PATCH (E) FLOOR FINISH AS NECESSARY".
- 2. DETAIL 1
 - a. Removed Keynote 0104 from front entry gate that should be removed.
 - b. Removed Keynote 0132, adjacent from the parking lot, indicating the removal of existing accessible route sign.
- 3. DETAIL 2
 - a. Revised Keynote 0152 to Keynote 0153 to 'DEMO (E) ACCESSIBLE PARKING SIGN".
- 2.3 DRAWING A1.1 NEW OVERALL SITE & FLOOR PLAN
 - A. Replaced DSA approved Drawing A1.1 with the attached revised Drawing A1.1 in its entirety.
 - 1. REFERENCE NOTES
 - a. Added Keynote 0201 indicating '(N) NON-ACCESSIBLE ROUTE SIGN, REF 9/10.1'
 - 2. DETAIL 1
 - a. Added Room Number 'B13'.
 - b. Revised scope of work boundaries at eastern exterior work.
 - c. Added (E) STAFF PARKING LOT tag.
 - d. Removed Keynote 0010 from western route of travel.
 - 3. DETAIL 2
 - a. Added Keynote 0201 along path of travel indicating '(N) NON-ACCESSIBLE ROUTE SIGN'.
 - b. Added dimension string on the firelane lettering and stall striping.
 - c. Added Keynote 0207 at the firelane indicating, '(N) 4" ACCESSIBLE BLUE PARKING STALL STRIPE'.

- 2.4 DRAWING A1.2 DEMO AND NEW ENLARGED SITE PLAN
 - A. Replaced DSA approved Drawing A1.2 with the attached revised Drawing A1.2 in its entirety.
 - 1. REFERENCE NOTES
 - a. Added Keynote 0025 indicating '(E) 4" WIDE WHITE PARKING STRIPES TO REMAIN, PROTECT IN PLACE'.
 - 2. LEGEND
 - a. Revised 'DEMO EXISTING CONCRETE SLAB AND RAMP' to 'DEMO EXISTING CONCRETE PAVING'
 - b. Revised control joints and expansion joints detail reference from '2/2.1' to '10/10.2'.
 - 3. DETAIL 1
 - a. Added 'TYP' and 'OF 4' at keynotes.
 - b. Added Keynote 0025 indicating, '(E) 4" WIDE WHITE PARKING STRIPES TO REMAIN, PROTECT IN PLACE'.
 - 4. DETAIL 2
 - a. Added dimension string onto parking access sign.
 - b. Added Keynote 0208 onto parking access sign.
 - c. Added detail reference callout '6/10.2'.
 - 5. DETAIL 5
 - a. Relocated keynote arrow to correct gate.
- 2.5 DRAWING A1.3 DEMO AND NEW ENLARGED SITE PLAN
 - A. Replaced DSA approved Drawing A1.3 with the attached revised Drawing A1.3 in its entirety.
 - 1. REFERENCE NOTES
 - a. Added Keynote 0132 indicating, 'REMOVE (E) ACCESSIBLE ROUTE SIGN ... REF DTL 9/10.1'.

- b. Added Keynote 0201 indicating '(N) NON-ACCESSIBLE ROUTE SIGN, REF 9/10.1'.
- 2. LEGEND
 - a. Removed irrelevant information from the legend.
- 3. DETAIL 1
 - a. Added Keynote 0132 along non-accessible path of travel.
 - b. Added Keynote 0024 at 6" curb.
 - c. Added north arrow on plan.
- 4. DETAIL 2
 - a. Added Keynote 0201 indicating '(N) NON-ACCESSIBLE ROUTE SIGN'.
 - b. Added north arrow on plan.
- 5. DETAIL 3
 - a. Added dimension string to enlarged site plan.
 - b. Revised Keynote 0024 to 0069 indicating, (E) PLANTER SEAT WALL TO REMAIN'.
 - c. Called out concrete to align with edge of seat wall.
 - d. Added north arrow on plan.
- 6. DETAIL 4
 - a. Added north arrow on plan.

2.6 DRAWING A2.0 - DEMO FIRST FLOOR & CODE PLAN

- A. Replaced DSA approved Drawing A2.0 with the attached revised Drawing A2.0 in its entirety.
 - 1. REFERENCE NOTES
 - a. Added Keynote 0111 indicating 'DEMO (E) COUNTERTOP'.
 - b. Revised Keynote 0115 to 'REMOVE WITH BEST CARE (E) LEARNING WALL AND RETURN TO DISTRICT FOR THEIR USE'.
 - c. Revised Keynote 0156 to 'DEMO AND DISPOSE (E) PARTITION WALL'.

- d. Added Keynote 0177 indicating, 'REMOVE AND RETURN TO DISTRICT (E) PROJECTOR SCREEN.'
- 2. DETAIL 1
 - a. Added room tag at 'NURSE AID B13' and 'EXTERIOR MECHANICAL ROOM'.
 - b. Added room tag at 'CLASSROOMS A1, B1, B2, B3, B4, B5, B6 and B7'.
 - c. Revised Keynote 0115 to Keynote 0111 at countertop.
 - d. Added Keynote 0122 within the 'TEACHERS WORKROOM'.
 - e. Added Keynote 0029 at existing doors to remain.
 - f. Added Keynote 0177 at projector screen on the learning wall.
 - g. Added TYP on Keynote 0114.
 - h. Added Keynote 0156 at southern partition wall.
 - i. Added Keynote 0028 at southern wood column.
- 2.7 DRAWING A2.1 NEW FIRST FLOOR & CODE PLAN
 - A. Replaced DSA approved Drawing A2.1 with the attached revised Drawing A2.1 in its entirety.
 - 1. REFERENCE NOTES
 - a. Revised Keynote 0911 indicating '(N) DEKO MARKERBOARD, COLOR TO BE SELECTED BY ARCHITECT, REF SPECS'.
 - b. Revised Keynote 1604 adding 'WIRE MOLD TO BE PAINTED, COLOR TO BE SELECTED BY ARCHITECT'.
 - 2. LEGEND
 - a. Revised interior concrete legend description to 'PATCH BACK CONCRETE SLAB, REF DTL 6/10.3'.
 - 3. DETAIL 1
 - a. Added door tag and room tag at 'NURSE AID OFFICE, B13'.
 - b. Removed Keynote 0122 within the Teachers Workroom.

- c. Added detail section callout 5D/8.1 at flooring transition.
- d. Added room tag at 'EXTERIOR MECHANICAL ROOM'.
- e. Added room tag at 'CLASSROOMS A1, B1, B2, B3, B4, B5, B6 and B7'.
- f. Added Keynote 0912 within 'READING ROOM'
- g. Removed section detail call out from floor plan.
- h. Remove portion of casework from plan.
- i. Added Keynote 1025 at southern fire extinguisher within the 'LIBRARY'.
- j. Added Keynotes 0906 and 0909 within 'CLASSROOM B7'.
- 2.8 DRAWING A2.2 DEMO AND NEW ENLARGED FIRST FLOOR PLAN
 - A. Replaced DSA approved Drawing A2.2 with the attached revised Drawing A2.2 in its entirety.
 - 1. REFERENCE NOTES
 - a. Revised Keynote 0034 reference detail FROM '7/10.1' TO 8/10.1'.
 - b. Revised Keynote 0109 to indicate 'DEMO AND DISPOSE (E) DOOR'.
 - c. Revised Keynote 0129 reference detail from '13/2.1' to '12/10.2'.
 - d. Revised Keynote 0130 to 'DEMO (E) DOOR IDENTIFICATION SIGNAGE'.
 - e. Revised Keynote 0140 to indicate 'REMOVE AND DISPOSE'.
 - f. Revised Keynote 0171 to indicate 'REMOVE AND DISPOSE'.
 - g. Added Keynote 1002 indicating '(N) WOMAN/GIRLS RESTROOM DOOR SIGN, SEE 3/10.1'.
 - h. Added Keynote 1004 indicating, (N) MEN/BOYS RESTROOM DOOR SIGN, SEE 7/10.1'.
 - 2. DETAIL 1
 - a. Added room tag.

- 3. DETAIL 2
 - a. Added room tag.
 - b. Added Keynote 0109 at restroom door.
- 4. DETAIL 4
 - a. Added room tag.
 - b. Added Keynote 2203 at restroom water closet.
 - c. Added Keynote 1004 at door.
- 5. DETAIL 5
 - a. Added room tag.
 - b. Revised Keynote 1028 to 1002.
 - c. Added Keynote 2203 at restroom water closets.
- 6. DETAIL 11
 - a. Removed door tag and grab bar from view.
- 2.9 DRAWING A3.1 DEMO FIRST FLOOR RCP
 - A. Replaced DSA approved Drawing A3.1 with the attached revised Drawing A3.1 in its entirety.
 - 1. REFERENCE NOTES
 - a. Added Keynote 0176 indicating 'REMOVE AND RELOCATE (E) PROJECTOR'.
 - b. Added Keynote 0178 indicating 'REMOVE AND RETURN TO DISTRICT (E) PROJECTOR'.
 - 2. GENERAL NOTES
 - a. Corrected spelling with Note 4.
 - 3. DEMO LEGEND
 - a. Revised ACT Note to, 'REF GENERAL NOTES'.
 - b. Added hatch and description to 'EXISTING GLULAM BEAM TO REMAIN'

- 4. DETAIL 1
 - a. Added existing projectors and Keynotes 0178 and 0176 to plan.
- 2.10 DRAWING A3.2 NEW FIRST FLOOR RCP
 - A. Replaced DSA approved Drawing A3.2 with the attached revised Drawing A3.2 in its entirety.
 - 1. REFERENCE NOTES
 - a. Added Keynote 1607 indicating, '(E) CEILING MOUNTED PROJECTOR TO BE CENTERED WITH PROJECTOR SCREEN AND LIGHT FIXTURES, REF DTL 5/10.2 & ELECTRICAL DRAWINGS'.
 - 2. NEW LEGEND
 - a. Revised gypsum board detail reference to 'REF 4/9.1 & STRUCT DWGS'.
 - 3. DETAIL 1
 - a. Added projector and Keynote 1607 within 'COMPUTER ROOM'.
 - b. Added note 'CENTER LIGHT TO ALIGN TO EXISTING' within corridor.
 - c. Revised ceiling plan to depict soffit and soffit height.
- 2.11 DRAWING A6.1 INT. ELEV. AND SECTIONS
 - A. Replaced DSA approved Drawing A6.1 with the attached revised Drawing A6.1 in its entirety.
 - 1. REFERENCE NOTES
 - a. Revised Keynote 0031 adding, 'BEAM TO BE PRIMED & PAINTED, COLOR TO BE SELECTED BY ARCHITECT'
 - b. Revised Keynote 0911 to indicate '(N) DEKO MARKERBOARD ... REF SPECS'.
 - c. Revised Keynote 1301 adding, 'COLOR AND FONT TO BE SELECTED BY ARCHITECT'.
 - 2. NEW LEGEND
 - a. Added general note; 'NOTE: ... ARCHITECT'

- 3. DETAIL 1
 - a. Added dual marker boards and projector screen.
- 4. DETAIL 2
 - a. Wrote 'TYP OF..' on vinyl lettering.
 - b. Revised the location of the aluminum letterings.
- 5. DETAIL 3
 - a. Called out glulam 'TO BE PAINTED, COLOR TO BE SELECTED BY ARCHITECT'.
- 6. DETAIL 4
 - a. Visibly shown signage.
- 7. DETAIL 5
 - a. Shown corridor beyond.
- 8. DETAIL 12
 - a. Called out what area is within the foreground and background.
- 2.12 DRAWING 8.1 DOOR AND FRAME SCHEDULE
 - A. Replaced DSA approved Drawing 8.1 with the attached revised Drawing 8.1 in its entirety.
 - 1. WINDOW SCHEDULE
 - a. Added remarks and legend to window schedule.
 - 2. DETAIL 4
 - a. Flipped the window section to match the plans.
 - 3. DETAIL 6
 - a. Added detail header section callout 15/8.1 on 'FRAME TYPE 2.'
 - b. Revised detail jamb section callout to 4/8.1 and 1/8.1 on 'FRAME TYPE 3'.
 - 4. DETAIL 13
 - a. Revised the door schedule to match the plans.

- b. Added remark 14 to legend which called out 'INTERIOR DOOR & FRAME TO BE ... BY ARCHITECT'
- 5. 'DETAIL 15
 - a. Added 'WHERE OCCURS' on section detail.
- 2.13 DRAWING 8.2 DOOR AND FRAME DETAILS
 - A. Replaced DSA approved Drawing 8.2 with the attached revised Drawing 8.2 in its entirety.
 - 1. DETAIL 7
 - a. Added door jamb to detail to match plan.
 - 2. MATERIAL LEGEND
 - a. Added Note 7 to material legend calling out 'REWORK CEILING GRID ... REF 2.60/9.4'.
 - b. Added 'W/ VINYL GRAPHIC ON GLASS' to store front wall abbreviations.
 - 3. FINISH SCHEDULE
 - a. Added 'CLASSROOM B7' to finish schedule.
 - b. Revised 'TEACHER'S WORKROOM' ceiling material.
- 2.14 DRAWING 9.2 ROOM FINISH
 - A. Replaced DSA approved Drawing 9.2 with the attached revised Drawing 9.2 in its entirety.
 - 1. REFERENCE NOTES
 - a. Revised Keynote 0911 to indicate, '(N) DEKO MARKERBOARD... REF SPECS'.
 - b. Added Keynote 1604 indicating, '(N) WIREMOLD PER ELEC... COLOR TO BE SELECTED BY ARCHITECT'.
 - 2. LEGEND
 - a. Reworded the vinyl graphic that will be placed on the glass description to 'VINYL GRAPHIC ON GLASS, IMAGE...'
 - b. Called out 'REF DETAILS 18, 19, & 20/10.3 COLOR 1 & 2. COLORS TO BE SELECTED BY ARCHITECT' within the tackable wall portion.

- c. Revised the VCT to LVT.
- 3. DETAIL 1
 - a. Added adjacent room tags on plans.
 - b. Removed irrelevant keynote within the 'TEACHERS WORKROOM'.
 - c. Added dimensions and description to 'ALIGN W/ COLUMN FINISH' where the flooring meets the column.
- 4. DETAIL 2
 - a. Revised elevation to show two markerboards and projector screen.
- 5. DETAIL 3
 - a. Added wiremold and Keynote 1604.
 - b. Added dimension string to the fire extinguisher.
- 6. DETAIL 4
 - a. Revised wall finish to tackable wallboard.
- 7. DETAIL 5
 - a. Added casework tags.
- 8. DETAIL 6
 - a. Revised wall finish to tackable wallboard.
 - b. Added casework tags.
- 9. DETAIL 7
 - a. Revised verbiage to 'VINYL GRAPHIC ON GLASS'
- 10. DETAIL 8
 - a. Added casework tags.
 - b. Added vinyl graphic hatch over storefront glass.

- 2.15 DRAWING 9.3 ROOM FINISH
 - A. Replaced DSA approved Drawing 9.3 with the attached revised Drawing 9.3 in its entirety.
 - 1. REFERENCE NOTES
 - a. Revised Keynote 0031 to include, 'BEAM TO BE PRIMED AND PAINTED, COLOR TO BE SELECTED BY THE ARCHITECT'.
 - b. Revised Keynote 0914 to include, 'PRIMED AND PAINTED'.
 - 2. LEGEND
 - a. Revised tackable wallboard description to include, 'REF DETAILS 18, 19 & 20/10.3 COLOR 1 & 2, COLORS TO BE SELECTED BY ARCHITECT'
 - 3. DETAIL 1
 - a. Wrote 'TYP OF..' on vinyl lettering.
 - b. Revised the location of the aluminum letterings.
 - 4. DETAIL 3
 - a. Added door tags to elevation.
 - b. Called on which elevation is in the foreground and background.
 - 5. DETAIL 4
 - a. Added door tag to elevation.
 - b. Added glass distinction to glass.
 - c. Called out which elevation is in the foreground and background
 - d. Added Keynote 0909 to the wall base.
 - 6. DETAIL 5
 - a. Added Keynote 0909 to the wall base.
 - b. Called out 'TYP OF' on the wall hooks
 - c. Added section detail.

- 7. DETAIL 6
 - a. Added vinyl graphic hatch on B8A storefront.
- 2.16 DRAWING 10.1 SPECIALTY DETAILS
 - A. Replaced DSA approved Drawing 10.1 with the attached revised Drawing 10.1 in its entirety.
 - 1. SIGNAGE SCHEDULE
 - a. Revised detail reference on the 'STUDENT DROP OFF SIGN' to 19.10.1.
 - b. Revised detail reference on the 'NON-ACCESSIBLE ROUTE' to 9/10.1.
 - 2. DETAIL 9
 - a. Added new detail in its entirety.
 - 3. DETAIL 19
 - a. Added new detail in its entirety.
- 2.17 DRAWING 10.2 SPECIALTY DETAILS
 - A. Replaced DSA approved Drawing 10.2 with the attached revised Drawing 10.2 in its entirety.
 - 1. DETAIL 5
 - a. Removed irrelevant detail and replaced in its entirety.
 - 2. DETAIL 6
 - a. Added where specific items are located with the detail, either exterior or interior only.
 - 3. DETAIL 7
 - a. Revised font note to indicate 'FONT TO BE CENTURY GOTHIC ... CHOSEN BY THE ARCHITECT'.
 - 4. DETAIL 18
 - a. Revised header blocking.

- 2.18 DRAWING 10.3 SPECIALTY DETAILS
 - A. Replaced DSA approved Drawing 10.3 with the attached revised Drawing 10.3 in its entirety.
 - 1. DETAIL 18
 - a. Added new detail in its entirety.
 - 2. DETAIL 19
 - a. Added new detail in its entirety.
 - 3. DETAIL 20
 - a. Added new detail in its entirety.

<u>Electrical</u>

- 2.19 DRAWING E2.2 DEMO & NEW POWER FLOOR PLANS
 - A. Replaced DSA approved Drawing E2.2 with the attached revised Drawing E2.2 in its entirety.
 - 1. Revised Keynotes 8, 9, and 10 from "CAT-6" cable to "CAT-6A" cable.
 - 2. Added Keynote 8 to "WAP" in Room B9.
 - 3. Added existing "Existing Relocated" projector to Room B9.

Mechanical

- 2.20 DRAWING M2.1 MECH. DEMO & NEW ENLARGED FIRST FLOOR PLAN
 - A. Replaced DSA approved Drawing M2.1 with the attached revised Drawing M2.1 in its entirety.
 - 1. Relocated the existing thermostats.

END OF ADDENDUM 2

Submitted by,

Mark Canhon

MARK GRAHAM Architect, AIA LEED™ GA NOMA Principal

MG:CL:hb/P4171970000x2-add

Attachments: Asbestos Abatement Specifications Drawings A1.0, A1.1, A1.2, A1.3, A2.0, A2.1, A2.2, A3.1, A3.2, A6.1, 8.1, 8.2, 9.2, 9.3, 10.1, 10.2, 10.3, E2.2, M2.1



BONNIE OEHL ELEMENTARY SCHOOL MODERNIZATION



https://oehl.sbcusd.com/hom

- THESE DRAWINGS DO NOT CONTAIN THE NECESSARY COMPONENTS FOR CONSTRUCTION SAFETY. LOCATIONS OF ALL UTILITIES SHOWN ARE APPROXIMA AND
- CONTRACTOR SHALL EXERCISE EXTREME CAUTION IN EXCAVATING AND TRENCHING ON THIS SITE TO AVOID INTERCEPTING EXISTING PIPING OR CONDUITS. IT SHALL BI THE RESPONSIBILITY OF THE CONTRACTOR TO LOCATE ALL EXISTING UTILITIES WHETHER SHOWN HEREON OR NOT AND TO PROTECT THEM FROM DAMAGE. THE ARCHITECT IS NOT FOR THE LOCATION OF UNDERGROUND UTILITIES OR STRUCTURES WHETHER OR NOT SHOWN O DETAILED AND INSTALLED BY ANY OTHER CONTRACT THE CONTRACTOR SHALL BEAR ALL EXPENSE OF REPAIR OR REPLACEMENT OF UTILITIES OR OTHER PROPERTY DAMAGED

BY OPERATIONS IN CONJUNCTION WITH THE EXECUTION OF THIS WORK

- THESE DOCUMENTS AND THE IDEAS AND DESIGNS INCORPORATED HEREIN, AS AN INSTRUMENT OF PROFESSIONAL SERVICE, ARE THE PROPERTY OF WLC ARCHITECTS, INC., AND ARE NOT TO BE USED, IN WHOLE OR IN PART, FOR ANY OTHER PROJECT WITHOUT THE WRITTEN AUTHORIZATION OF WLC ARCHITECTS, INC.
- THE WORK SHOWN ON THESE DRAWINGS AS EXISTING CONDITIONS WAS PREPARED FROM INFORMATION FURNISHED BY THE OWNER. WHILE THIS INFORMATION IS BELIEVED TO BE RELIABLE. WLC ARCHITECTS, INC. IS NOT RESPONSIBLE FOR THE ACCURACY OR ADEQUACY OF ANY WORK SHOWN AS EXISTING NOR IS WLC ARCHITECTS, INC. RESPONSIBLE FOR ANY ERRORS OR OMISSIONS WHICH MAY HAVE BEEN INCORPORATED INTO THESE DRAWINGS AS A RESULT.
- EACH BIDDER SHALL POSSESS AT THE TIME OF BID A CLASS R
- OR THE APPROPRIATE CLASS C CONTRACTOR'S LICENSE PURSUANT TO PUBLIC CONTRACT CODE SECTION 3300 AND BUSINESS AND PROFESSIONS CODE SECTION 7028.15. THE SUCCESSFUL BIDDER MUST MAINTAIN THE LICENSE THROUGHOUT THE DURATION OF THIS CONTRACT.
- FIRE SAFETY DURING CONSTRUCTION GENERAL: FIRE SAFETY DURING CONSTRUCTION SHALL A. COMPLY WITH CALIFORNIA FIRE CODE (CFC) CALIFORNIA CODE
- OF REGULATIONS (CCR) TITLE 24, PART 9, CHAPTER 5 AND CHAPTER 33 ACCESS ROADS: FIRE DEPARTMENT ACCESS ROADS SHALL B. BF
- ESTABLISHED AND MAINTAINED IN ACCORDANCE WITH CHAPTER 5, SECTION 501.4 AND CHAPTER 33, SECTION 3310.
- C. WATER SUPPLY: WATER MAINS AND HYDRANTS SHALL BE **OPERATIONAL IN ACCORDANCE WITH CHAPTER 5, SECTION** 501.4 AND CHAPTER 33, SECTION 3312. BUILDING ACCESS: ACCESS TO BUILDINGS FOR THE
- D. PURPOSE OF FIREFIGHTING SHALL BE PROVIDED. CONSTRUCTION MATERIAL SHALL NOT BLOCK ACCESS TO BUILDINGS, HYDRANTS OR FIRE APPLIANCES. ALTERATIONS OF BUILDINGS: SHALL COMPLY WITH E. APPLICABLE
- **PROVISIONS OF CHAPTER 33.** DEMOLITION OF BUILDINGS: SHALL COMPLY WITH F. FIRE WATCH: MAINTAIN FIRE WATCH WHEN REQUIRED BY THEVISIONS OF CHAPTER 33.
- BUILDING OFFICIAL AND WHEN EXISTING FIRE PROTECTION G. SYSTEMS ARE SHUT DOWN FOR ALTERATIONS IN ACCORDANCE
- WITH CHAPTER 33, SECTION 3304.5. FIRE WATCH SHALL REMAIN IN EFFECT UNTIL EXISTING FIRE PROTECTION SYSTEMS ARE RETURNED TO SERVICE OR AS ALLOWED BY THE BUILDING OFFICIAL.
- PENETRATIONS TO FIRE RATED MATERIALS OR ASSEMBLIES SHALL BE RESTORED TO EQUAL RATING. FIRE STOP NONRESIDENTIAL ENERGY STANDARDS COMPLIANCE ES STATEMENT (TITLE 24, PART 6): RESISTANCE DIRECTORY. FIRE
- THE DESIGN INDICATED HEREIN COMPLIES WITH THE REQUIREMENTS OF THE ENERGY CONSERVATION STANDARDS
- OF TITLE 24, PART 6, CALIFORNIA CODE OF REGULATIONS. THE PROPOSED BUILDING(S) WILL BE IN COMPLIANCE WITH THE ENERGY CONSERVATION STANDARDS PROVIDED IT (THEY) IS (ARE) BUILT ACCORDING TO THESE DRAWINGS AND SPECIFICATIONS AND PROVIDED ANY FUTURE IMPROVEMENTS
- ARE COMPLETED ACCORDING TO THE REQUIREMENTS OF TITLE 24, PART 6, CALIFORNIA CODE OF REGULATIONS. THESE
- PLANS AND SPECIFICATIONS HAVE BEEN PREPARED TO INCLUDE ALL SIGNIFICANT ENERGY CONSERVATION FEATURES
- REQUIRED FOR COMPLIANCE WITH THE STANDARDS. BUILDING AREAS THAT ARE UNCONDITIONED AND/OR NOT SUBJECT TO THE STANDARDS ARE INDICATED ON THE PLANS.

GENERAL NOT

ENVELOPE MANDATORY MEASURES

- . INSTALLED INSULATING MATERIALS SHALL HA CERTIFIED BY THE MANUFACTURER TO COM CALIFORNIA QUALITY STANDARDS FOR INSUL MATERIAL
- . ALL INSULATING MATERIALS SHALL BE INST. COMPLIANCE WITH THE FLAME SPREAD RAT DENSITY REQUIREMENTS OF TITLE 24, PART CODE OF REGULATIONS. SECTIONS 720 AND
- C. ALL EXTERIOR JOINTS AND OPENINGS IN THE ENVELOPE THAT ARE POTENTIAL AND OBSER SOURCES
- OF AIR LEAKAGE SHALL BE CAULKED, GASK WEATHERSTRIPPED OR OTHERWISE SEALED D. SITE CONSTRUCTED DOORS, WINDOWS, AND SHALL BE CAULKED BETWEEN THE UNIT AND AND SHALL BE WEATHERSTRIPPED (EXCEPT

GLASS DOORS AND FIRE DOORS).

- E. MANUFACTURED DOORS AND WINDOWS INS HAVE AIR INFILTRATION RATES CERTIFIED BY MANUFACTURER IN ACCORDANCE WITH TITLE CALIFORNIA CODE OF REGULATIONS, SECTIO
- F. MANUFACTURED FENESTRATION PRODUCTS ENVELOPE OF THE BUILDING, INCLUDING, BUT NOT LIMIT WINDOWS, SLIDING GLASS DOORS, FRENCH SKYLIGHTS, CURTAIN WALLS, AND GARDEN W BE LABELED FOR U-VALUE IN ACCORDANCE \ NATIONAL FENESTRATION RATING COUNCIL'S
- U-VALUE RATING PROCEDURE. G. DEMISING WALL INSULATION SHALL BE INSTAI OPAQUE PORTIONS OF FRAMED WALLS (EXCE

DEFERRED APPROVAL ITEMS:

INSTALLATION OF DEFERRED APPROVAL ITEM BE STARTED UNTIL DETAILED PLANS, SPECIF ENGINEERING CALCULATIONS HAVE BEEN AC SIGNED BY THE ARCHITECT OR ENGINEER IN RESPONSIBLE CHARGE OF DESIGN AND SIGNI CALIFORNIA REGISTERED ARCHITECT OR PRO ENGINEER WHO HAS BEEN DELEGATED RESP COVERING THE WORK SHOWN ON A PARTICU SPECIFICATION AND APPROVED BY THE DIVIS STATE ARCHITECT.

DEFFERED APPROVAL ITEMS SHALL BE SUBM **REVIEW NO LATER THAN 60 DAYS AFTER THE** PROCEED.

DEFERRED APPROVAL ITEMS FOR THIS PROJE FOLLOWING ITEMS: A. [NONE]

12. A DSA ACCEPTED TESTING LABORATORY DIRE EMPLOYED BY THE DISTRICT (OWNER) SHALL THE REQUIRED TEST AND INSPECTIONS FOR


13. INSPECTOR OF RECORD REQUIREMENTS


- A. ONE OR MORE INSPECTORS EMPLOYED BY ACCORDANCE WITH THE REQUIREMENTS OF THE CALIFORNIA CODE OF REGULATIONS WI ASSIGNED TO THE WORK. THE INSPECTORS SPECIFICALLY DEFINED IN SECTION 4-342 OF PART 1 AND IN ADDITION SHALL BE AS STIPU INTERPRETATION OF REGULATION DOCUMEN
- B. INSPECTOR SHALL BE CERTIFIED AS A CLASS INSPECTOR THROUGH THE DIVISION OF THE ARCHITECT INSPECTOR EXAMINATION PROG INSPECTOR SHALL ALSO BE SPECIFICALLY A THE DIVISION OF THE STATE ARCHITECT FO PROJECT AT LEAST 10 DAYS PRIOR TO THE WORK FOR THIS PROJECT.
- 14. ALL WORK SHOWN ON THESE DRAWINGS SHA WITH THE REQUIREMENTS OF TITLE 24, 2016 C CODE OF REGULATIONS (CCR).
- CHANGES TO THE APPROVED DRAWINGS AND 15. SPECIFICATIONS SHALL BE MADE BY AN ADDE CONSTRUCTION CHANGE DOCUMENT APPROV DIVISION OF THE STATE ARCHITECT, AS REQU TITLE
- 24, CCR, PART 1, SECTION 4-338.
- 16 ROAD AND ACCESS REQUIREMENTS AND ENV HEALTH CONCIDERATIONS SHALL COMPLY WI ORDINANCES.
- 17. DRINKING WATER SHALL COMPLY WITH ALL LO DEPARTMENT REQUIREMENTS.


2525 N PALM AVE, HIGHLAND, CA 92346 SAN BERNARDINO CITY UNIFIED SCHOOL DISTRICT


TES		PROJECT TEAM	
 19. THE INTENT OF THESE DRAWINGS AND SPECIFICATIONS IS THAT THE WORK OF THE ADDITION, ALTERATION OR RECONSTRUCTION IS IN COMPLIANCE WITH THE REQUIREMENTS OF TITLE 24, CALIFORNIA CODE OF REGULATIONS. SHOULD ANY COMNDITIONS SUCH AS DETERIORATION OR NON-COMPLYING CONSTRUCTION BE DISCOVERED WHICH IS NOT IDENTIFIED BY THE CONTRACT DOCUMENTS WHERIN THE FINAL WORK WOULD NOT COMPLY WITH THE REQUIREMENTS OF TITLE 24, CALIFORNIA CODE OF REGULATIONS, THE CONTRACT DOCUMENTS WHERIN THE FINAL WORK WOULD NOT COMPLY WITH THE REQUIREMENTS OF TITLE 24, CALIFORNIA CODE OF REGULATIONS, THE CONTRACTOR SHALL IMMEDIATELY NOTIFY THE OWNER AND THE ARCHITECT OF THE CONDITION IN WRITING. NECESSARY INFORMATION REQUIRED TO CORRECT THE CONDITIONS ENCOUNTERED WILL BE ISSUED BY THE ARCHITECT. A CHANGE ORDER MAY BE ISSUED TO ADJUST THE CONTRACT SUM OR TIME COMMENSURATE WITH THE AMOUNT OF ADDITIONAL WORK REQUIRED IF ANY. THE CHANGE ORDER SHALL BE APPROVED BY THE DIVISION OF THE STATE ARCHITECT PRIOR TO PROCEEDING WITH THE WORK REQUIRED IF ANY. THE CHANGE ORDER SHALL BE APPROVED BY THE DIVISION OF THE STATE ARCHITECT PRIOR TO PROCEEDING WITH THE WORK REQUIRED BY THE CHANGE ORDER. 20. ALL SLOPE AND CROSS SLOPE OF ACCESSIBLE ROUTE PAVING INDICATED ON THESE DRAWINGS WAS DESIGNED IN COMPLIANCE WITH THE 2010 ADA STANDARDS FOR 		OWNER SAN BERNARDINO CITY UNIFIED SCHOOL DISTRICT 3395 MOUNTAIN AVE SAN BERNARDINO, CA 92404 PHONE: (909) 388-6100 FAX: (909) 885-9991 ARCHITECTS, INC. 8163 ROCHESTER AVENUE, SUITE 100 RANCHO CUCAMONGA, CA 91730 PHONE: (909) 987-9090 FAX: (909) 980-9980 CIVIL ENGINEERING, INC. 118 W LIME AVE MONROVIA, CA 91016 PHONE: (626) 357 - 0588 FAX: (626) 303-7957 STRUCTURAL ENGINEER	INDEX TITLE A0.1 GENERAL NOTES & PROJECT DIRECTORY 1 A0.2 ARCHITECTURAL DRAWING ABBREVIATIONS 2 INDEX CIVIL 2 INDEX CIVIL 3 C0.01 TITLE SHEET 3 C0.02 ABBREVIATIONS, LEGEND AND NOTES 4 C2.01 PRECISE GRADING PLAN 5 C2.02 PRECISE GRADING PLAN 6 C2.03 PRECISE GRADING PLAN 7 C3.01 IMPROVEMENT PLAN DETAILS 8 INDEX ARCHITECTURAL A1.0 DEMO OVERALL SITE & FLOOR PLAN 9 A1.1 NEW OVERALL SITE & FLOOR PLAN 10 A1.2 DEMO AND NEW ENLARGED SITE PLAN 11 A1.3 DEMO AND NEW ENLARGED SITE PLAN 11
TS IN THE MITED TO, CH DOORS, N WINDOWS MUST E WITH THE (NFRC) IL'S INTERIM STALLED IN ALL XCEPT DOORS).	2016 CALIFORNIA BUILDING STANDARDS	LONG BEACH, CA 90808 PHONE: (562) 985-3200 FAX: (562) 985-1011 MECHANICAL ENGINEER POCOCK DESIGN SOLUTIONS, INC. 14451 CHAMBERS ROAD SUITE 210 TUSTIN, CA 92780 PHONE: (909) 417-3903 FAX: (909) 419-1393 ELECTRICAL ENGINEER IMEG CORP. 901 VIA PIEMONTE SUITE 400 ONTARIO, CA 91764	A2.0DEMO FIRST FLOOR AND CODE PLAN13A2.1NEW FIRST FLOOR & CODE PLAN14A2.2DEMO AND NEW ENLARGED FIRST FLOOR PLAN15A3.1DEMO FIRST FLOOR RCP16A3.2NEW FIRST FLOOR RCP17A6.1INT. ELEV. AND SECTIONS186.1MILLWORK DETAILS AND SCHEDULES198.1DOOR AND FRAME SCHEDULE208.2DOOR AND FRAME DETAILS219.1ROOM FINISH & WALL SCHEDULE229.2ROOM FINISH239.3ROOM FINISH24
TEMS SHALL NOT CIFICATIONS, AND ACCEPTED AND IN GENERAL GNED BY A PROFESSIONAL ESPONSIBILITY CULAR PLAN OR VISION OF THE	ADMINISTRATIVE CODE CALIFORNIA CODE OF REGULATIONS (CCR) TITLE 24, PART 1 2016 CALIFORNIA BUILDING CODE (CBC) CALIFORNIA CODE OF REGULATIONS (CCR) TITLE 24, PART 2 2016 CALIFORNIA ELECTRICAL CODE (CEC) CALIFORNIA CODE OF REGULATIONS (CCR) TITLE 24, PART 3 2016 CALIFORNIA ELECTRICAL CODE (CEC) CALIFORNIA CODE OF REGULATIONS (CCR) TITLE 24, PART 3	PHONE: (909) 477-6915 FAX: (909) 477-6916 PLUMBING ENGINEER POCOCK DESIGN SOLUTIONS, INC. 14451 CHAMBERS ROAD SUITE 210 TUSTIN, CA 92780 PHONE: (909) 417-3903 FAX: (909) 419-1393	9.4SUSPENDED CEILING DETAILS2510.1SPECIALTY DETAILS2610.2SPECIALTY DETAILS2710.3SPECIALTY DETAILS28INDEX STRUCTURALS0.1STRUCTURAL NOTES AND DETAILS29S0.2SECTIONS AND DETAILS30
BMITTED FOR HE NOTICE TO	(CCR) TITLE 24, PART 3AMENDMENTS)2016 CALIFORNIA MECHANICAL CODE (CMC) CALIFORNIA CODE OF REGULATIONS (CCR) TITLE 24, PART 4(2015 UNIFORM MECHANICAL CODE (UMC) W/ CALIFORNIA AMENDMENTS)	DOOR HARDWARE ARCHITECTURAL HARDWARE SERVICES 150 EAST MEDA AVENUE, SUITE 240 GLENDORA, CA 91741 PHONE: (909) 852-8802	INDEX MECHANICAL
OJECT ARE THE	2016 CALIFORNIA PLUMBING CODE (CPC) CALIFORNIA CODE OF REGULATIONS (CCR) TITLE 24, PART 5 2016 CALIFORNIA ENERGY CODE	FAX: (909) 852-8812	M0.1 MECH. LEGEND, SCHEDULES, AND GENERAL NOTES 31 M2.1 MECH. DEMO & NEW ENLARGED FIRST FLOOR PLAN 32 INDEX PLUMBING
DIRECTLY ALL CONDUCT ALL OR THE PROJECT	CALIFORNIA CODE OF REGULATIONS (CCR) TITLE 24, PART 6 2016 CALIFORNIA HISTORICAL BUILDING CODE CALIFORNIA CODE OF REGULATIONS (CCR) TITLE 24, PART 8	Pledmont Dr Pledmont Dr AMBER HILLS Palm Crest Dr UNWOOD Dr Pelm Crest Dr UNWOOD Dr PROJECT LOCATION: 2525 N PALM AVE, HIGHLAND, CA 92346 Str. St E Str. St E Str. St E	P0.1PLUMBING LEGEND, SCHEDULES, AND GENERAL NOTES33P1.1PLUMBING DEMOLITION FLOOR PLAN34P2.1PLUMBING NEW FLOOR PLAN35P4.1PLUMBING DEMOLITION & NEW ENLARGED PLANS36INDEX ELECTRICAL
Y THE OWNER IN OF TITLE 24 OF WILL BE ORS DUTIES ARE OF SAID TITLE 24, IPULATED IN MENT IR A-8. ASS 2 HE STATE OGRAM. Y APPROVED BY FOR THIS HE START OF ANY	2016 CALIFORNIA FIRE CODE (CFC) CALIFORNIA CODE OF REGULATIONS (CCR) TITLE 24, PART 9(2015 INTERNATIONAL FIRE CODE (IFC) W/ CALIFORNIA AMENDMENTS)2016 CALIFORNIA EXISTING BUILDING CODE CALIFORNIA CODE OF REGULATIONS (CCR) TITLE 24, PART 10(2015 INTERNATIONAL EXISTING BUILDING CODE (IEBC) W/ CALIFORNIA AMENDMENTS)2016 CALIFORNIA GREEN BUILDING STANDARDS CODE (CGBSC) CALIFORNIA CODE OF REGULATIONS (CCR) TITLE 24, PART 111990 STATE FIRE MARSHAL REGULATIONS (AS AMENDED TO DATE) CALIFORNIA CODE OF REGULATIONS (CCR) TITLE 24, PART 112016 CALIFORNIA REFERENCED STANDARDS CODE (CALIFORNIA CODE OF REGULATIONS (CCR) TITLE 24, PART 112010 AMERICANS WITH DISABILITIES ACT (ADA) STANDARDS FOR ACCESSIBLE DESIGN (ADAS)	The Department of State Hospitals - Patton Hond St Dable Dx Walmart Super Highland Ave E Highland Ave E Highland Ave Central A	E0.1GENERAL NOTES, LEGEND AND DRAWING LIST37E0.2FIXTURE & PANEL SCHEDULE38E0.3TITLE 2439E1.1SITE PLAN40E2.1DEMO & NEW LIGHTING FLOOR PLANS41E2.2DEMO & NEW POWER FLOOR PLANS42E3.1DETAILS43FA0.1GENERAL NOTES, LEGEND AND DRAWING LIST44FA0.2SITE PLAN45FA1.1DEMO AND NEW FIRST FLOOR PLAN46FA2.1FIRE RISER, CALCS & DETAILS47
SHALL COMPLY 16 CALIFORNIA	APPLICABLE NFPA STANDARDS NFPA 13 - AUTOMATIC SPRINKLER SYSTEMS, 2016 EDITION NFPA 14 - STANDPIPE SYSTEMS, 2013 EDITION NFPA 17 - DRY CHEMICAL EXTINGUISHING SYSTEMS, 2013 EDITION	Stratford St	
AND DDENDUM OR A ROVED BY THE EQUIRED BY	 NFPA 17A - WET CHEMICAL SYSTEMS, 2013 EDITION NFPA 20 - STATIONARY PUMPS, 2016 EDITION NFPA 22 - WATER TANKS FOR PRIVATE FIRE PROTECTION, 2013 EDITION NFPA 24 - PRIVATE FIRE MAINS, 2016 EDITION NFPA 72 - NATIONAL FIRE ALARM CODE, 2016 EDITION NFPA 80 - FIRE DOORS AND OTHER OPENING PROTECTIVES, 2016 EDITION 	VICINITY MAP 1" = 100'-0" THE SCOPE OF THE WORK AS STATED BELOW IS FOR DSA	47 TOTAL PAGES
ENVIROMENTAL WITH ALL LOCAL L LOCAL HEALTH	 NFPA 92 - STANDARD FOR SMOKE CONTROL SYSTEMS, 2015 EDITION NFPA 253 - CRITICAL RADIANT FLUX OF FLOOR COVERINGS, 2015 EDITION NFPA 2001 - CLEAN AGENT FIRE EXTINGUISHING SYSTEMS, 2015 EDITION ICC 300 - ICC STANDARDS FOR BLEACHERS, FOLDING AND TELESCOPIC SEATING, AND GRANDSTANDS, 2012 EDITION UL 300 - FIRE TESTING OF FIRE EXTINGUISHING SYSTEMS FOR PROTECTION OF COMMERCIAL RESTAURANT COOKING AREAS, 2005 EDITION UL 464 - AUDIBLE SIGNAL APPLIANCES, 2003 EDITION UL 521 - HEAT DETECTORS FOR FIRE PROTECTIVE SIGNALING SYSTEMS, 1999 EDITION NOTE: ALL NFPA STANDARDS AS LISTED ARE TO CONFORM TO THE EDITION AS LISTED WITH THE LATEST CALIFORNIA AMENDMENTS. REFERNECE THE 2016 CBC, TITLE 24, PART 2 - CHAPTER 35 FOR ADDITIONAL APPLICABLE NFPA, UL. STANDARDS AND ANY CALIFORNIA AMENDMENTS TO NFPA STANDARDS. 	THE SCOPE OF THE WORK AS STATED BELOW IS FOR DSA PLAN REVIEW PURPOSES ONLY AND DOES NOT CONSTITUTE A DETAILED AND FULL EXPLANATION OF THE REQUIREMENTS OF THE CONTRACT DOCUMENTS. REMODEL EXISTING WORKROOM B11, LIBRARY/MEDIA CENTER B9/B10, AND CLASSROOM B8. RELOCATE AND REWORK TWO NON-ACCESSIBLE SINKS/ DRINKING FOUNTAIN. UPGRADE PATH OF TRAVEL TO SCOPE OF WORK AND RESTROOMS AT G10, C10, A10.	STRUCTURAL SAFETY SECTION (DSA/SSS) 10920 VIA FRONTERA, SUITE 300 SAN DIEGO, CALIFORNIA 92127 (858) 674-5400 DIVISION OF THE STATE ARCHITECT ACCESS COMPLIANCE (DSA/ACS) 10920 VIA FRONTERA, SUITE 300 SAN DIEGO, CALIFORNIA 92127 (858) 674-5400 DIVISION OF THE STATE ARCHITECT FIRE AND LIFE SAFETY SECTION (DSA/FLS) 10920 VIA FRONTERA, SUITE 300 SAN DIEGO, CALIFORNIA 92127
	GOVERNING CODES 1/8" = 1'-0"	SCOPE OF WORK 1:1	GOVERNING AGENCIES



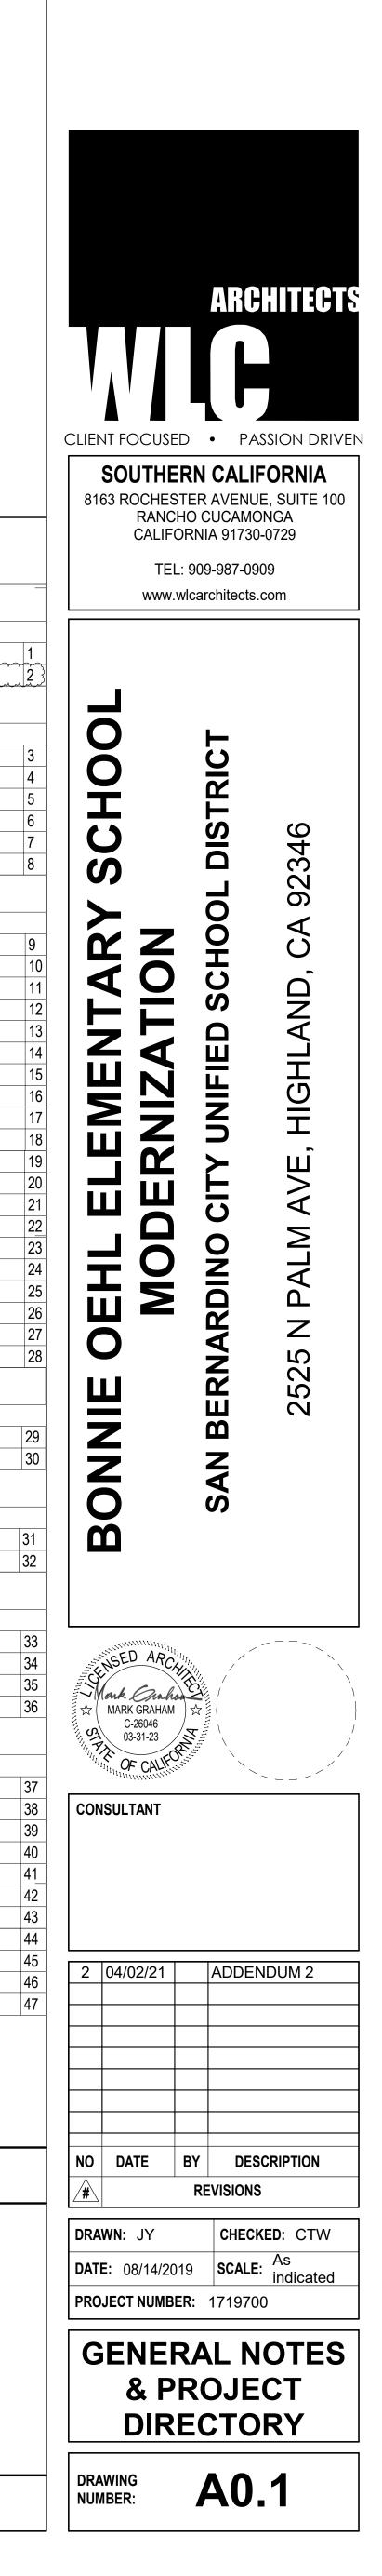


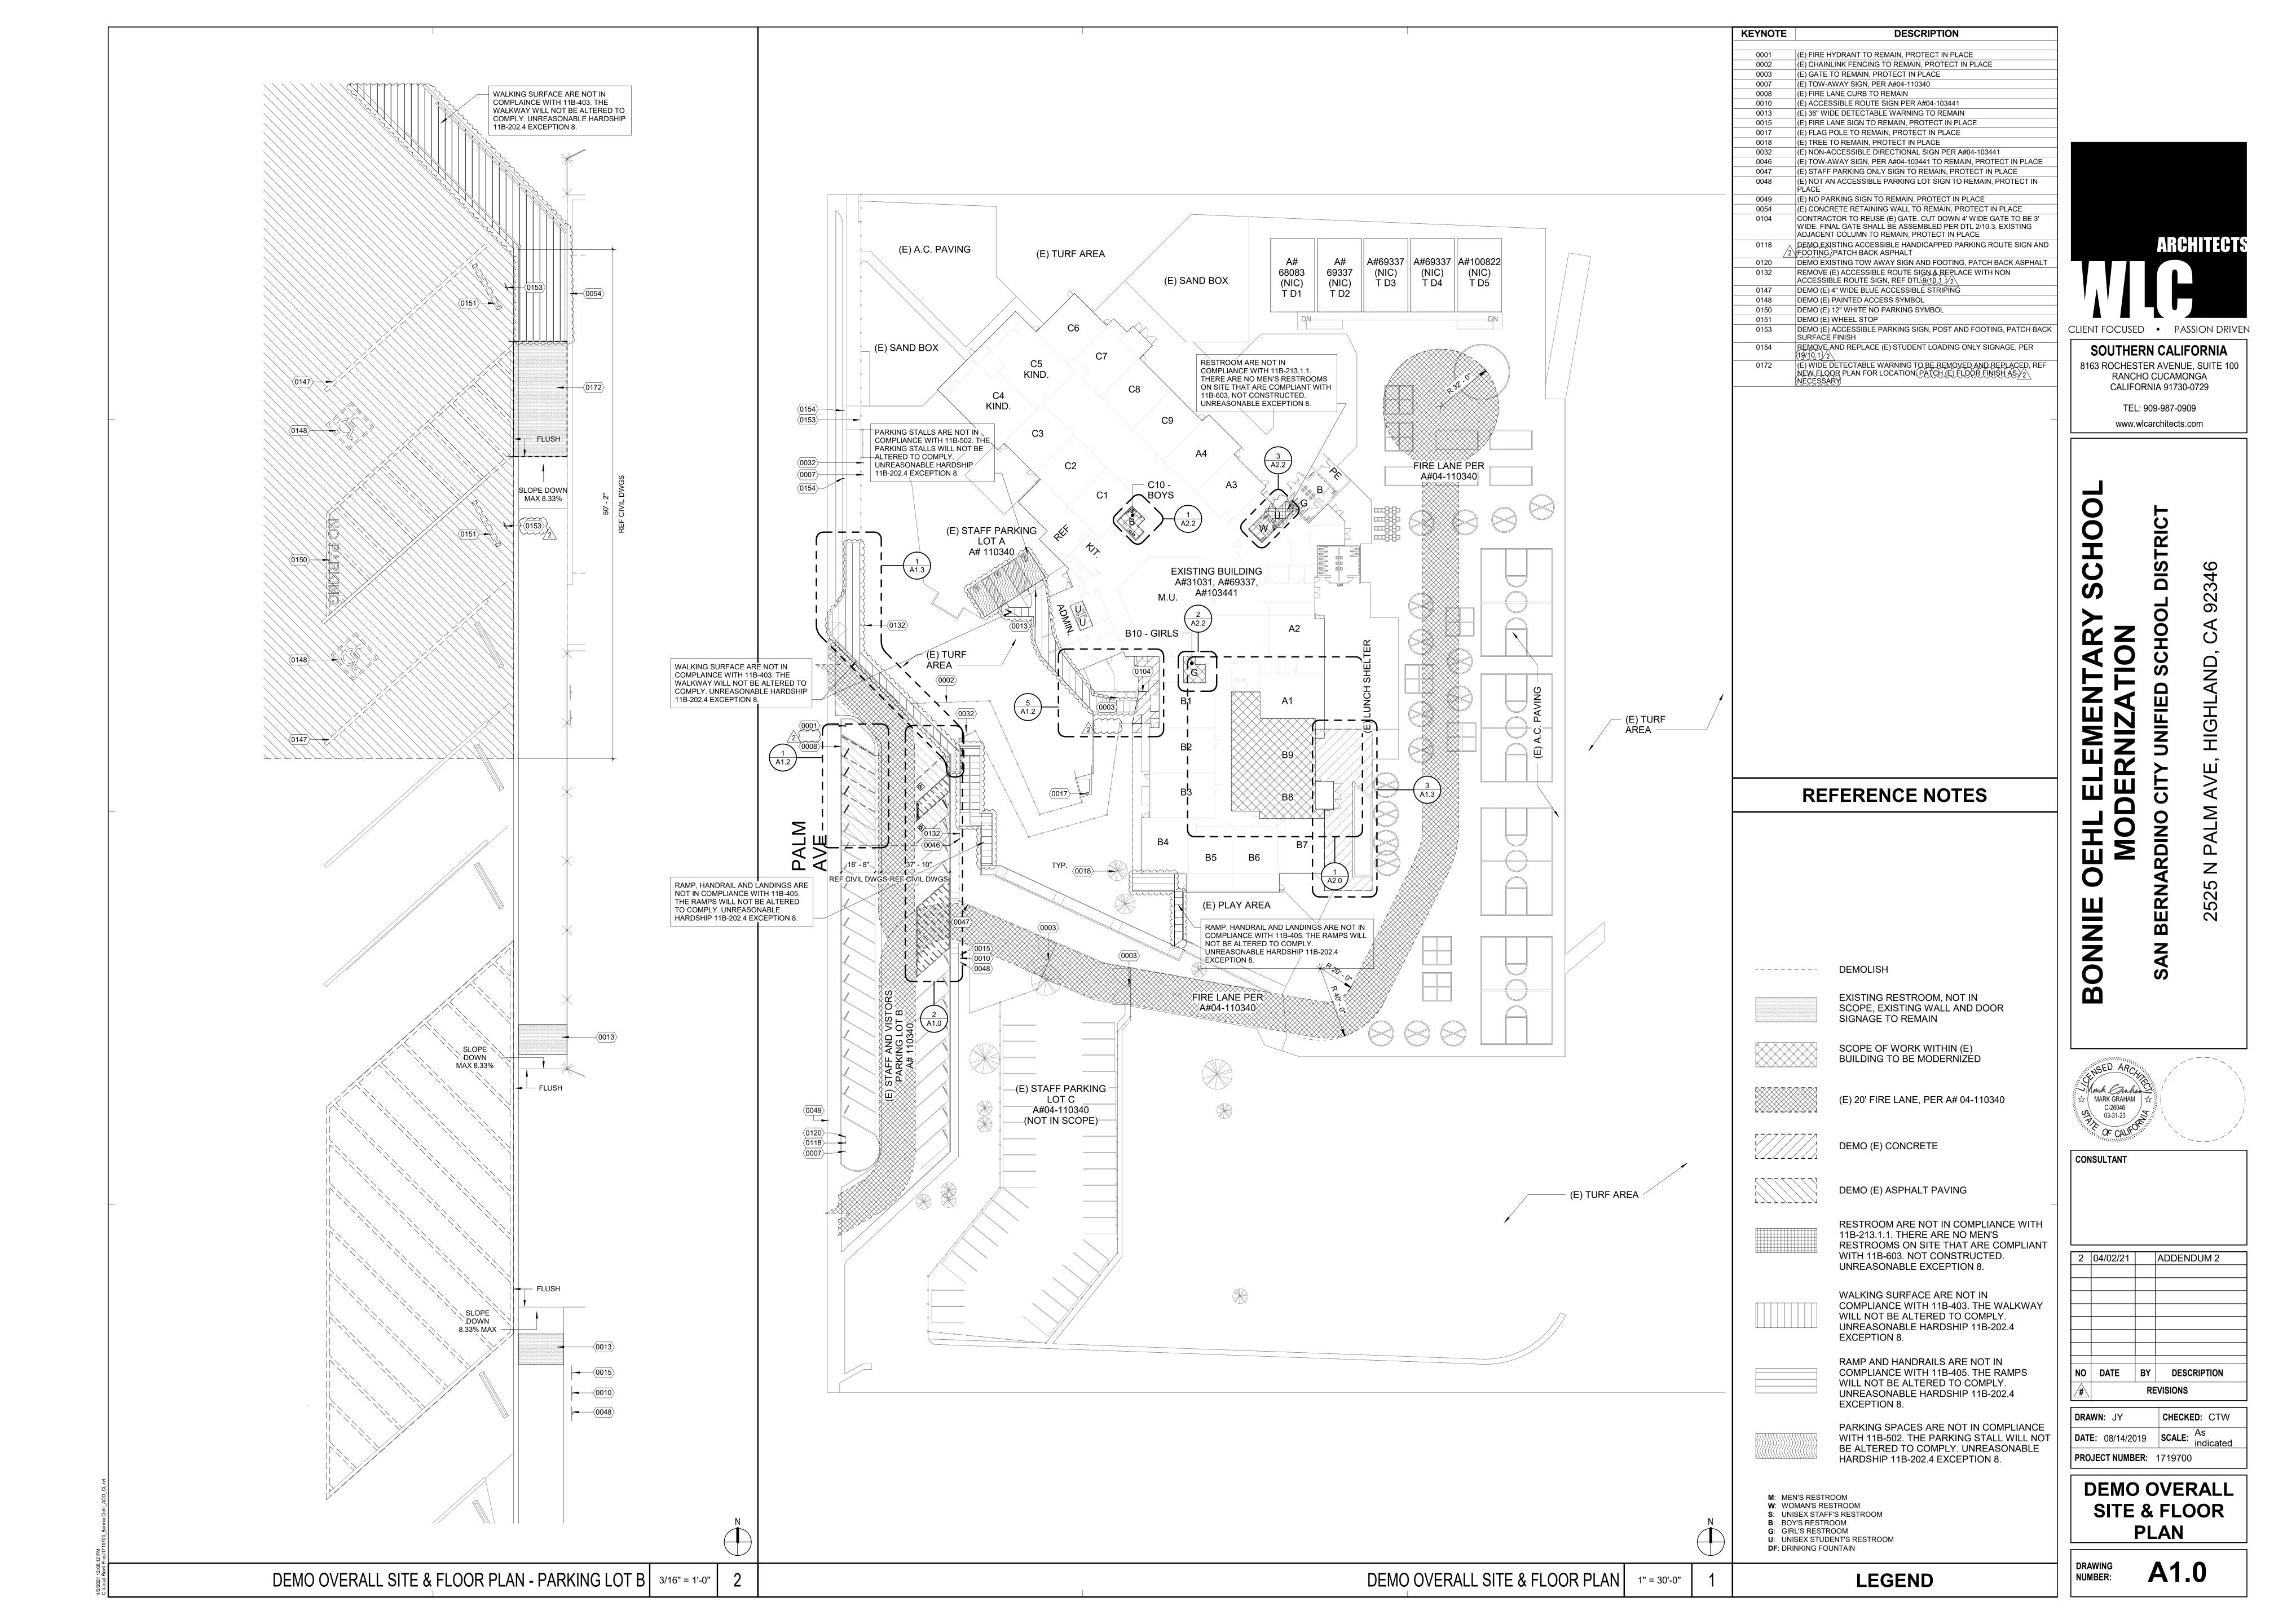


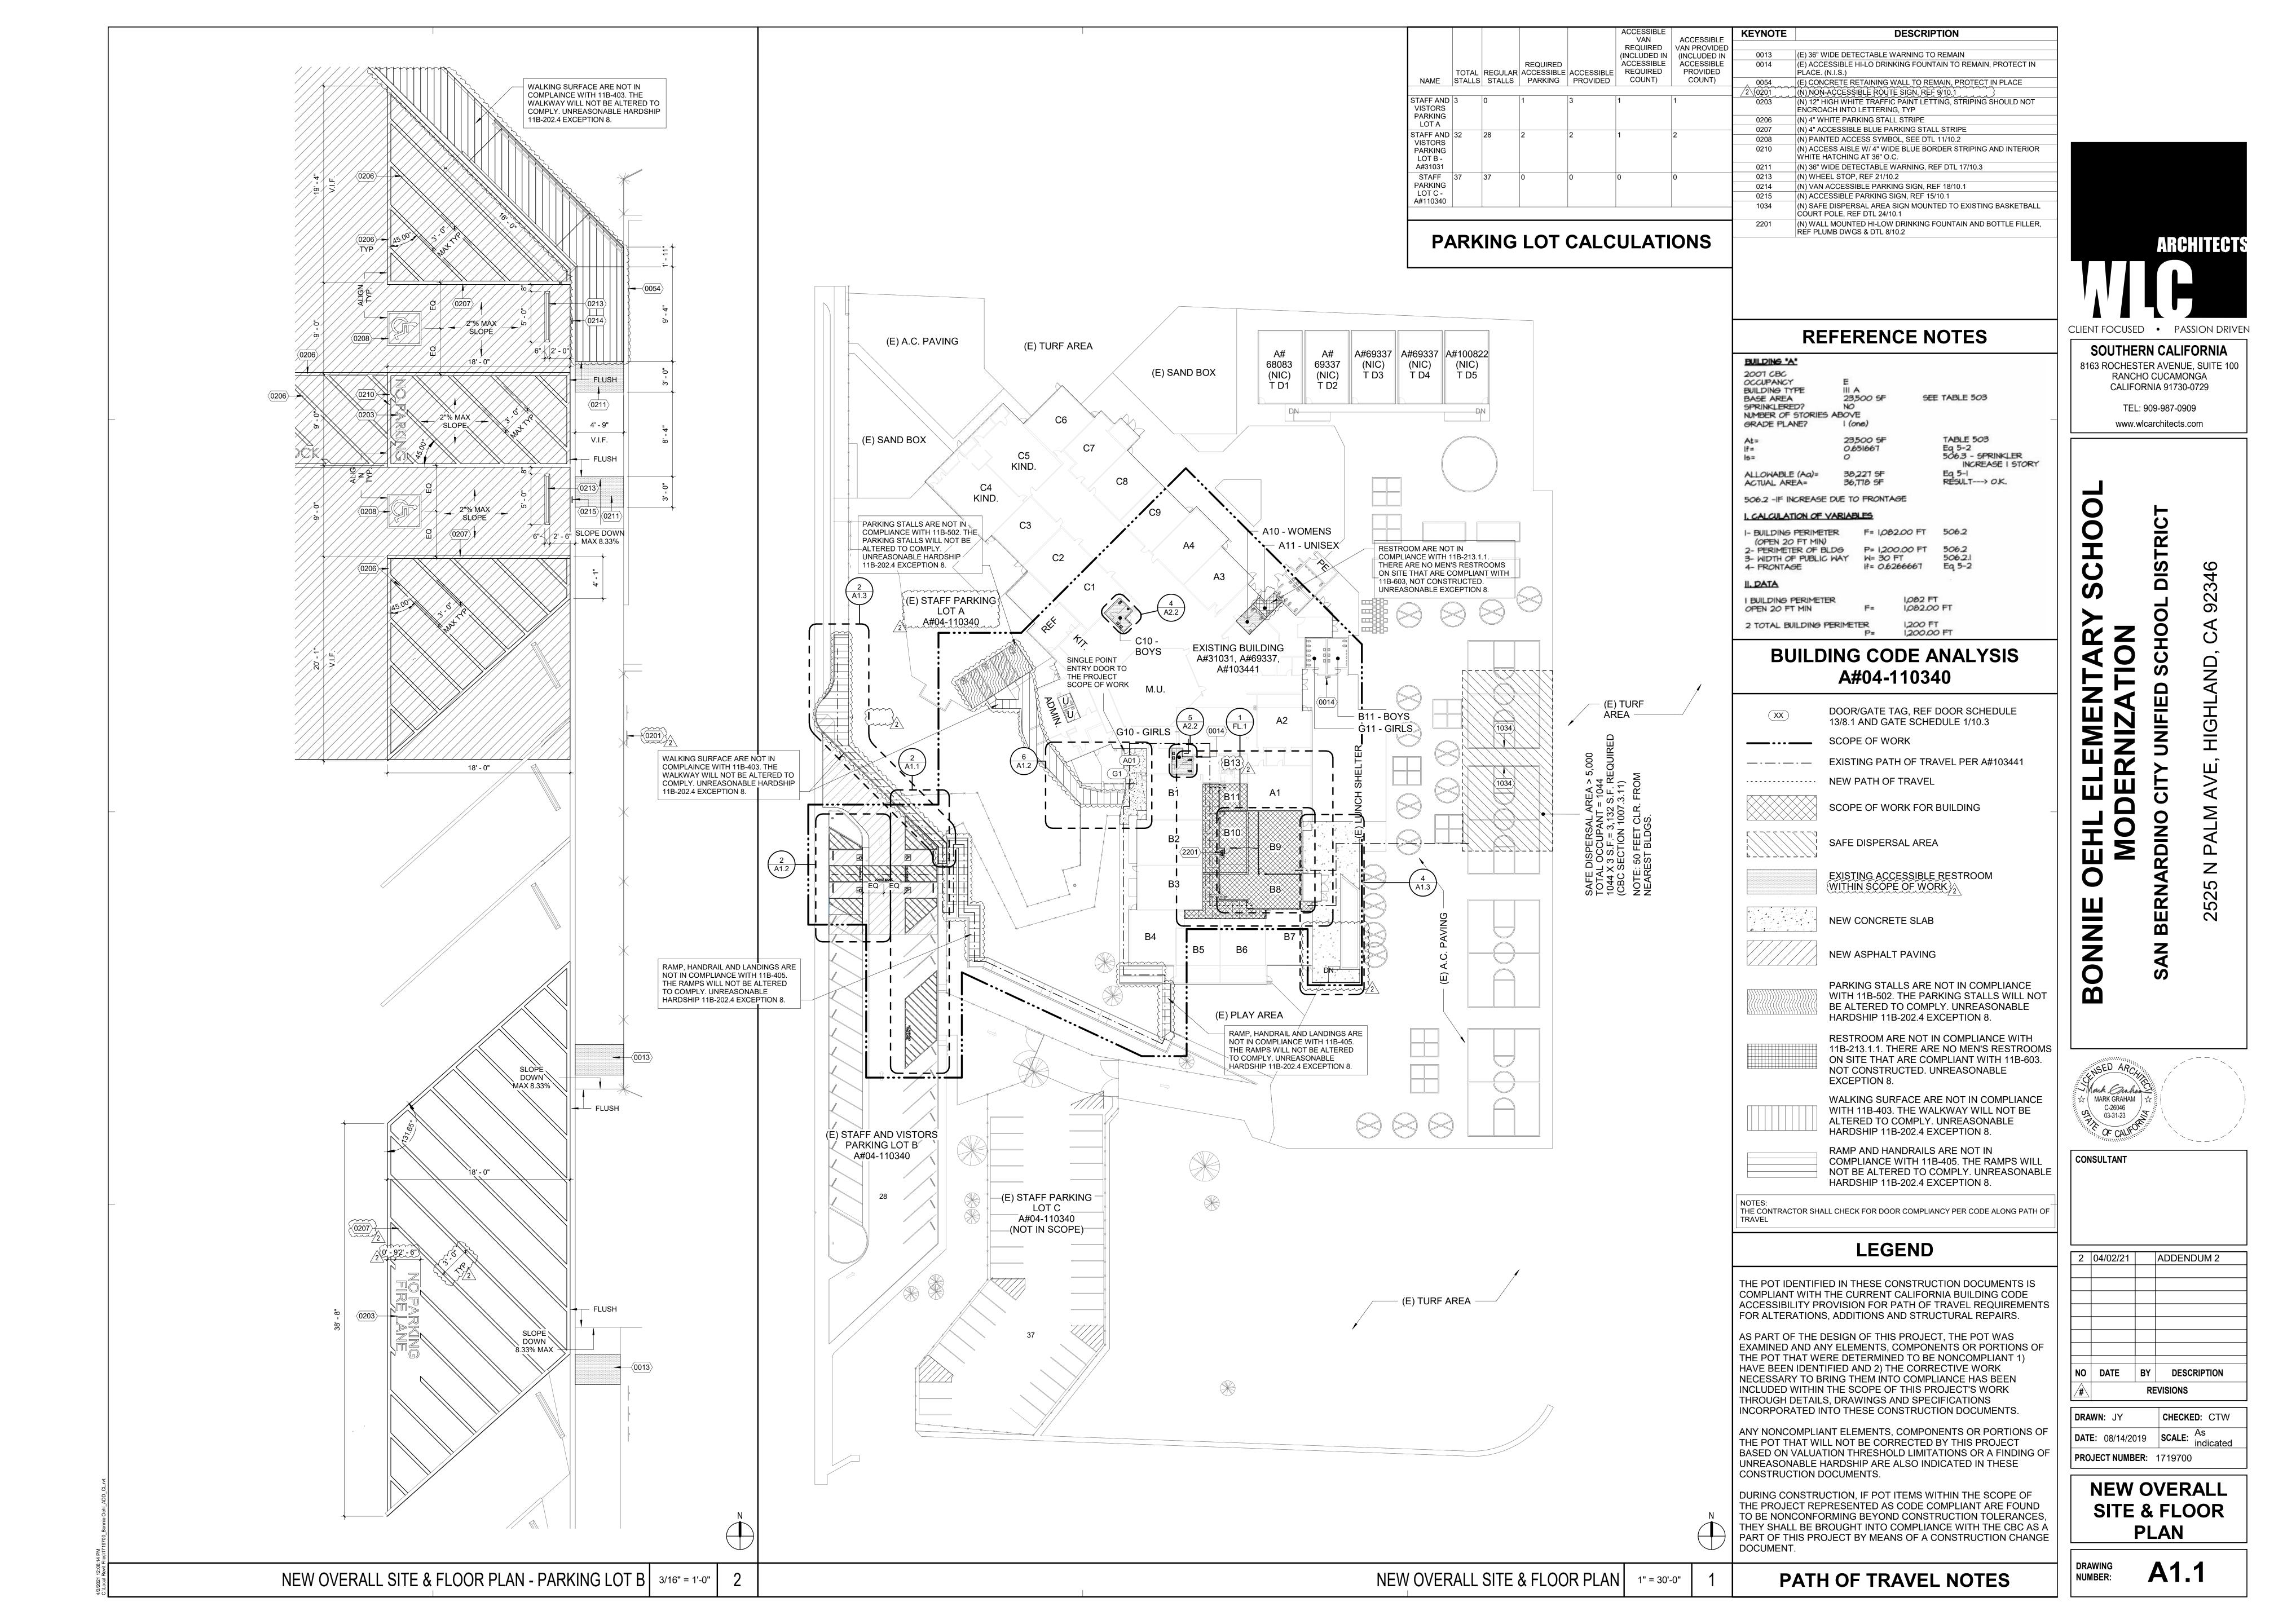


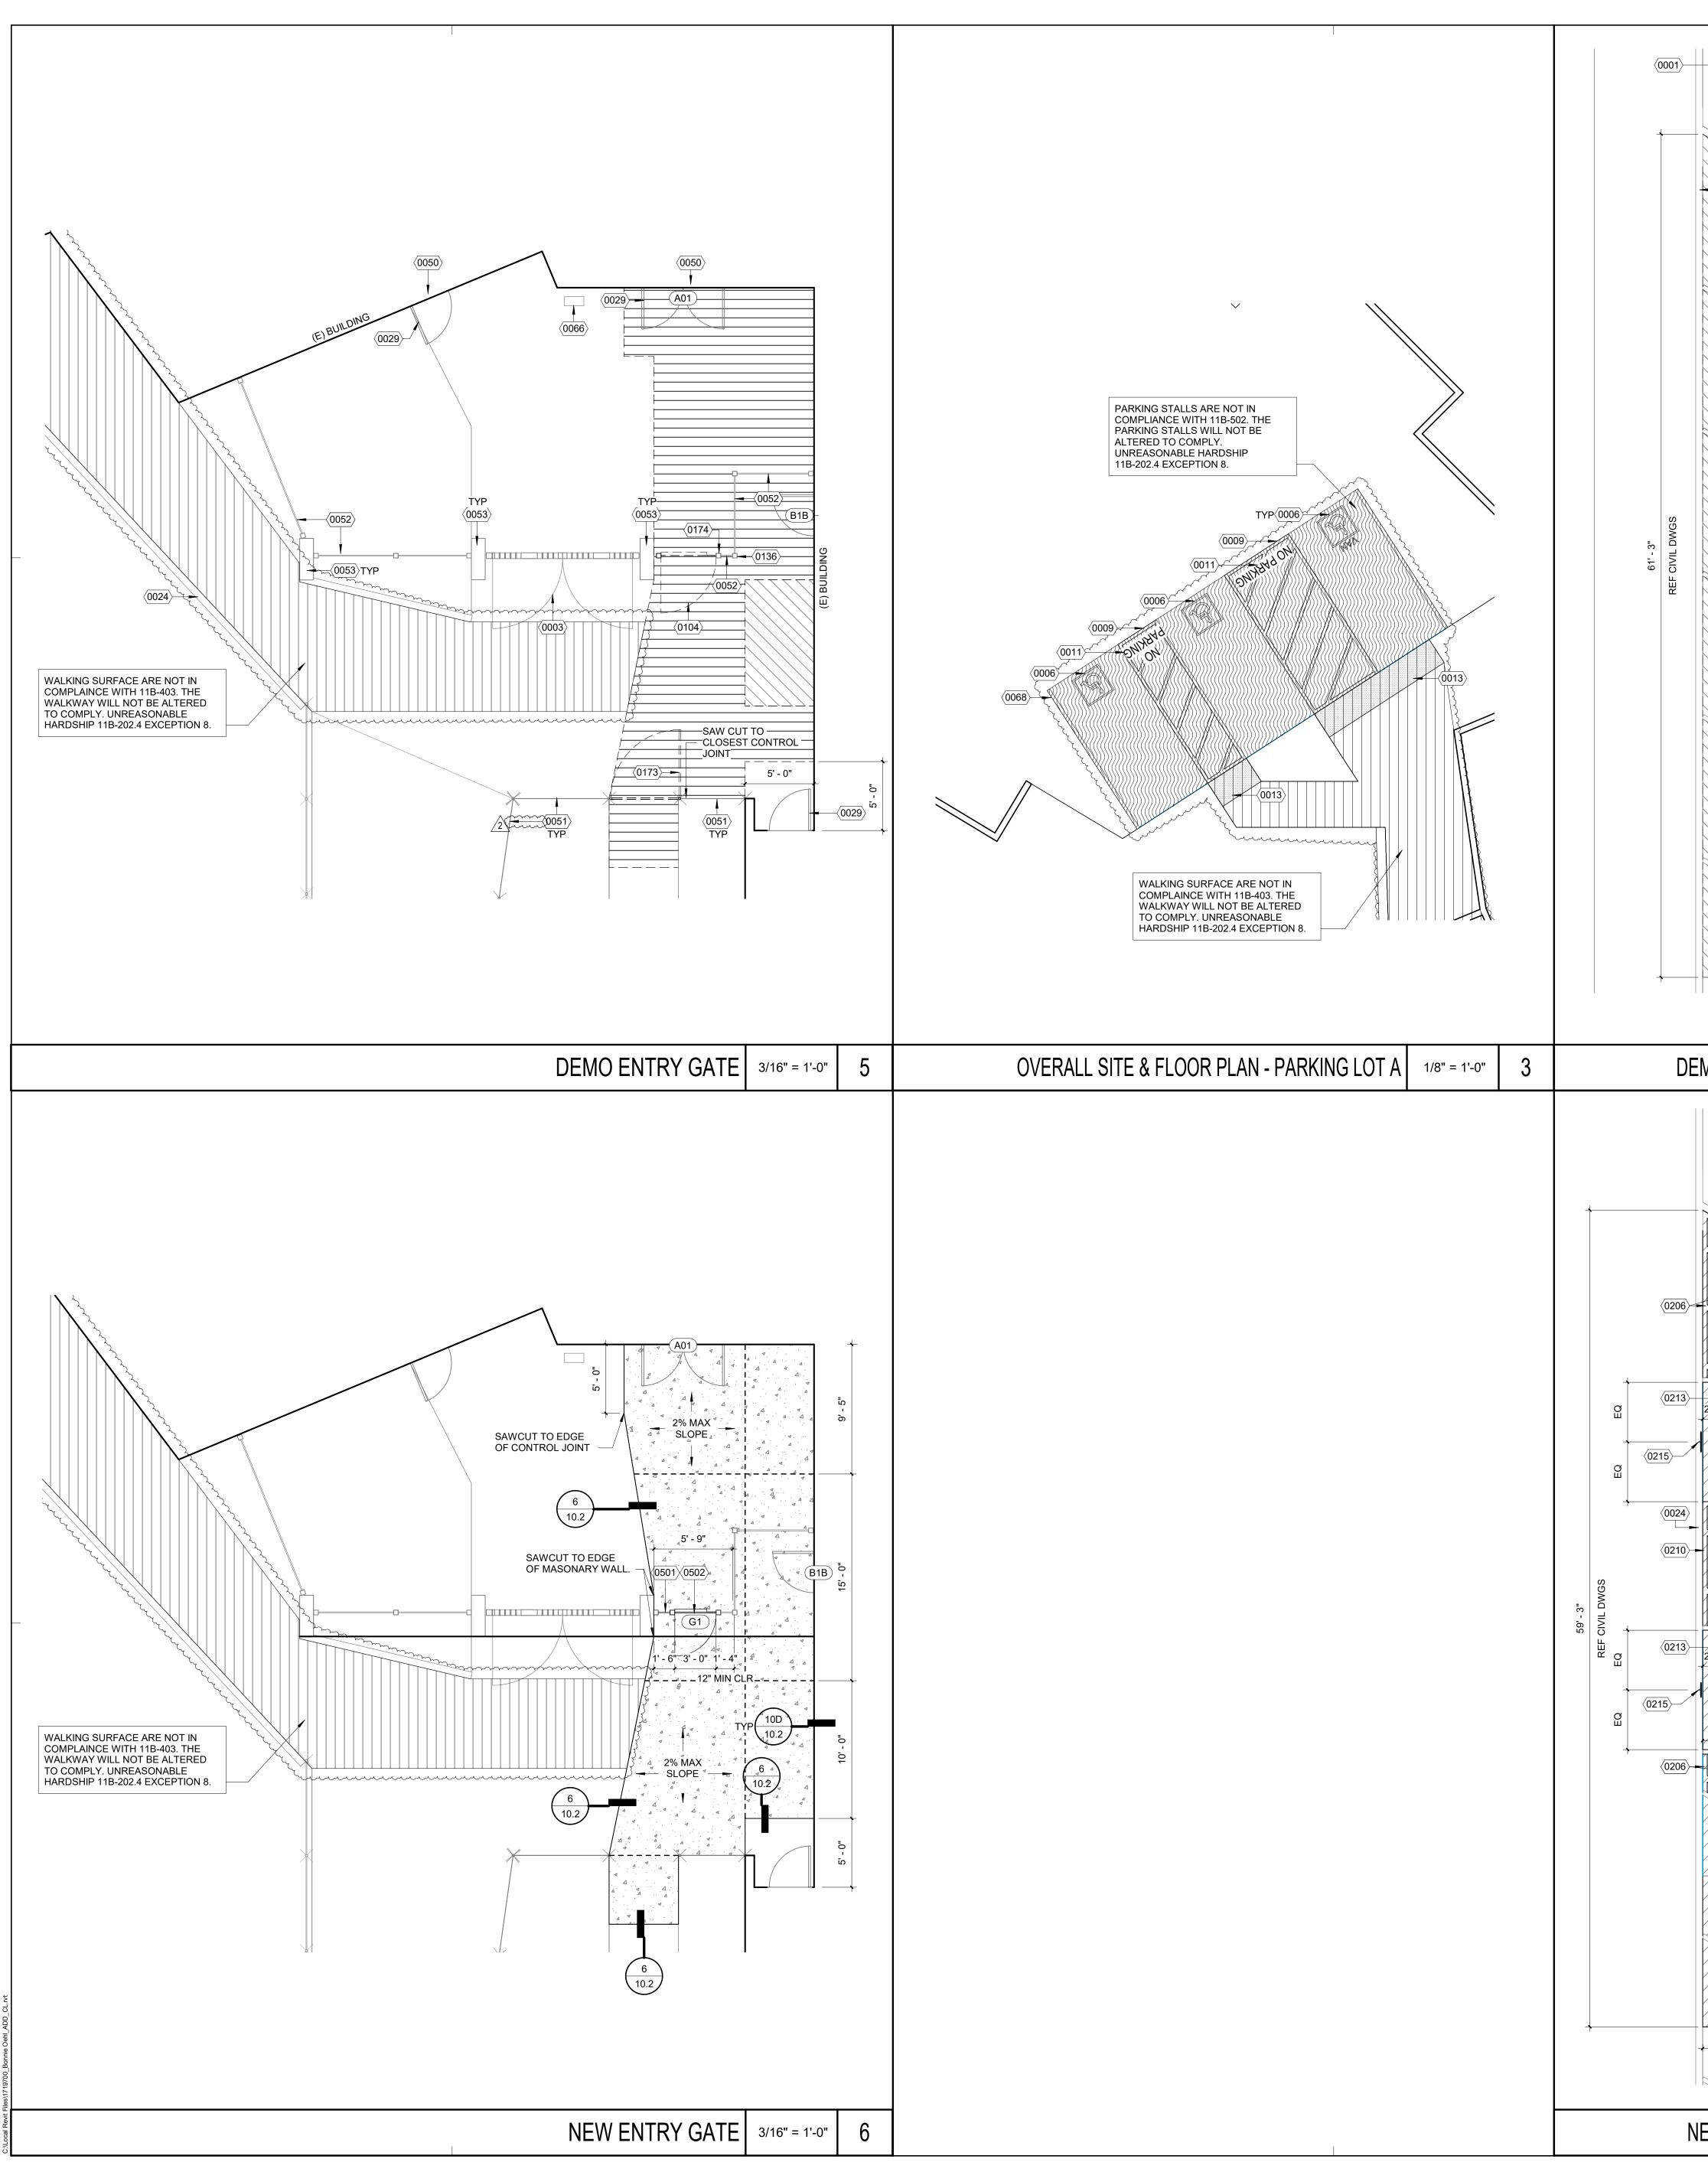

	K	EYNOTE	DESCRIPTION
		0003 (E) FIRE HYDRANT TO REMAIN, PROTECT IN PLACE E) GATE TO REMAIN, PROTECT IN PLACE
0008		0008 (0009 (E) ACCESSIBLE PARKING SIGN TO REMAIN, PROTECT IN PLACE E) FIRE LANE CURB TO REMAIN E) ACCESS AISLE W/ 4" WIDE BLUE BORDER STRIPING AND INTERIC
		0011 (0012 (WHITE HATCHING AT 36" O.C. TO REMAIN E) 12" HIGH PAINTED WHITE LETTERING TO REMAIN E) WHEEL STOP TO REMAIN, PROTECT IN PLACE
	/2	0024 (2 0025 (E) 36" WIDE DETECTABLE WARNING TO REMAIN E) 6" CURB TO REMAIN, PROTECT IN PLACE E) 4" WIDE WHITE PARKING STRIPES TO REMAIN, PROTECT IN PLAC
		0050 (E) DOOR TO REMAIN, PROTECT IN PLACE E) THRESHOLD TO REMAIN, PROTECT IN PLACE E) FENCE AND FOOTING TO REMAIN, PROTECT IN PLACE
		0053 (E) STEEL TUBE FENCE TO REMAIN, PROTECT IN PLACE E) BRICK COLUMN TO REMAIN, PROTECT IN PLACE E) PLAQUE TO REMAIN, PROTECT IN PLACE
		0104 C	E) 4" WIDE BLUE PARKING STRIPES TO REMAIN, PROTECT IN PLACI CONTRACTOR TO REUSE (E) GATE. CUT DOWN 4' WIDE GATE TO BE WIDE. FINAL GATE SHALL BE ASSEMBLED PER DTL 2/10.3. EXISTING
		0136 C 0138 E	ADJACENT COLUMN TO REMAIN, PROTECT IN PLACE CORNER COLUMN TO REMAIN, PROTECT IN PLACE DEMO (E) CONCRETE GUTTER, PREP FOR NEW GUTTER PER CIVIL
		0146 E 0151 E	DRAWINGS DEMO (E) 4" WIDE WHITE STRIPING DEMO (E) WHEEL STOP
		0174 (DEMO AND DISPOSE (E) GATE, CONTRACTOR TO TURN GATE HARD OVER TO THE DISTRICT E) FENCE POST TO REMAIN
		0206 (N) 12" HIGH WHITE TRAFFIC PAINT LETTING, STRIPING SHOULD NO ENCROACH INTO LETTERING, TYP N) 4" WHITE PARKING STALL STRIPE N) 4" ACCESSIBLE BLUE PARKING STALL STRIPE
		0208 (0210 (N) 4 ACCESSIBLE BLOE PARKING STALL STRIFE N) PAINTED ACCESS SYMBOL, SEE DTL 11/10.2 N) ACCESS AISLE W/ 4" WIDE BLUE BORDER STRIPING AND INTERIC VHITE HATCHING AT 36" O.C.
		0213 (0215 (N) WHEEL STOP, REF 21/10.2 N) ACCESSIBLE PARKING SIGN, REF 15/10.1 N) CONCRETE GUTTER, REF CIVIL DRAWINGS
		0501 (N) STEEL TUBE FENCING. REF DTL 2/10.3 N) STEEL TUBE GATE, REG GATE SCHEDULEE 1/10.3
EMO OVERALL SITE & FLOOR PLAN - PARKING 3/16" =	1'-0" 1		REFERENCE NOTES
	//// N	NOTE:	REFERENCE NOTES ALL ITEMS WITHIN FRONT RECEPTION AREA FEND
EMO OVERALL SITE & FLOOR PLAN - PARKING 3/16" =		NOTE: 1. REMOVE CANOPY AF CONSTRUC	ALL ITEMS WITHIN FRONT RECEPTION AREA FEN REA; BIKE RACK AND BENCH, RELOCATE DURING TION. REINSTALL EXISTING ITEMS. INSTALL BIKE

3 DEMO EXISTING ASPHALT PAVING MEW ASPHALT PAVING, REF CIVIL PLAN DEMO EXISTING CONCRETE PAVING SAW CUT TO CONTROL JOINT OF ADJACENT LANDING PAD NEW CONCRETE PAVING, REF CIVIL PLAN NEW CONCRETE PAVING, REF CIVIL DWGS CONTROL JOINTS (EJ), REF (10/10.2)/2 EXPANSION JOINTS (EJ), REF (10/10.2)/2 EXPANSION JOINTS (EJ), REF (10/10.2)/2 WALKING SURFACE ARE NOT IN COMPLIANCE WITH 11B-403. THE WALKWAY WILL NOT BE ALTERED TO COMPLY. UNREASONABLE HARDSHIP 11B-202.4 EXCEPTION 8. PARKING SPACES ARE NOT IN COMPLIANCE WITH 11B-502. THE PARKING STALL WILL NOT BE ALTERED TO COMPLY. UNREASONABLE HARDSHIP 11B-202.4 EXCEPTION 8. PARKING SPACES ARE NOT IN COMPLIANCE WITH 11B-502. THE PARKING STALL WILL NOT BE



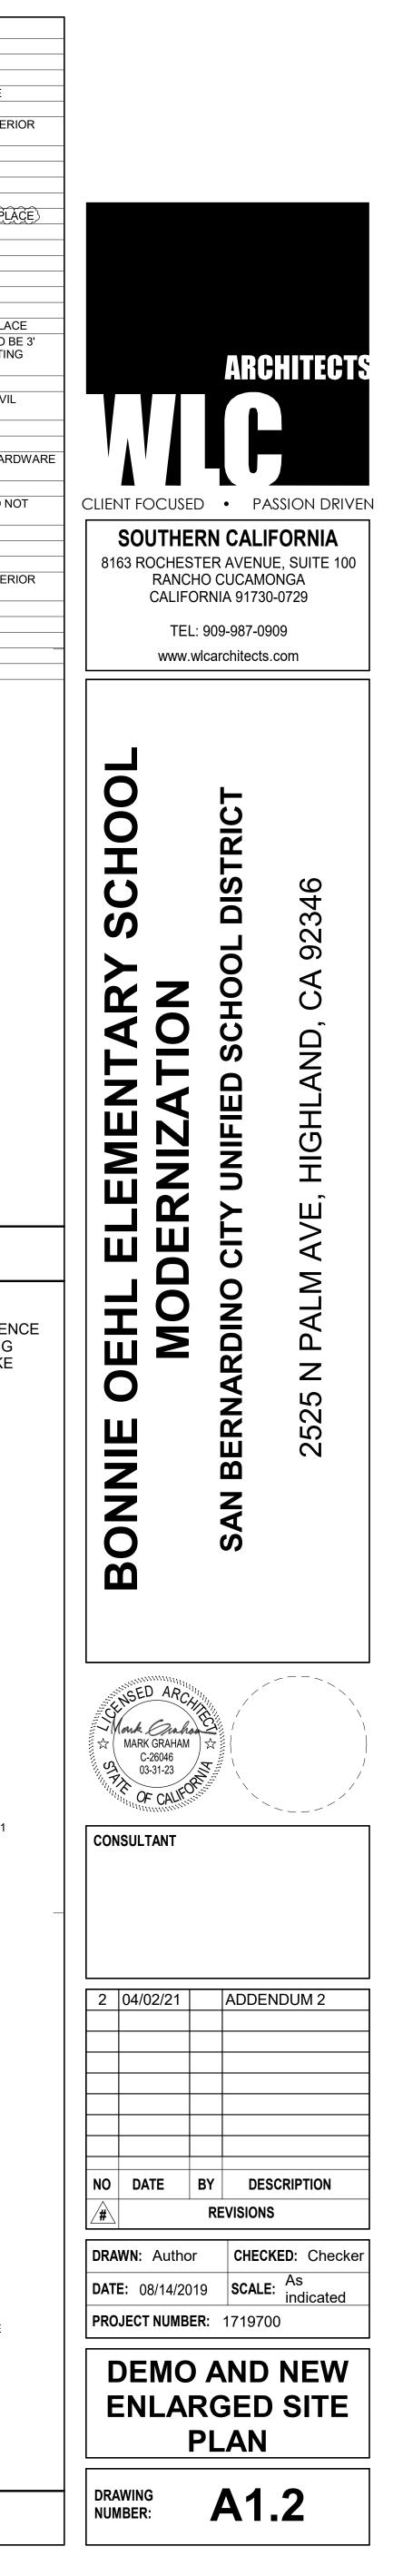

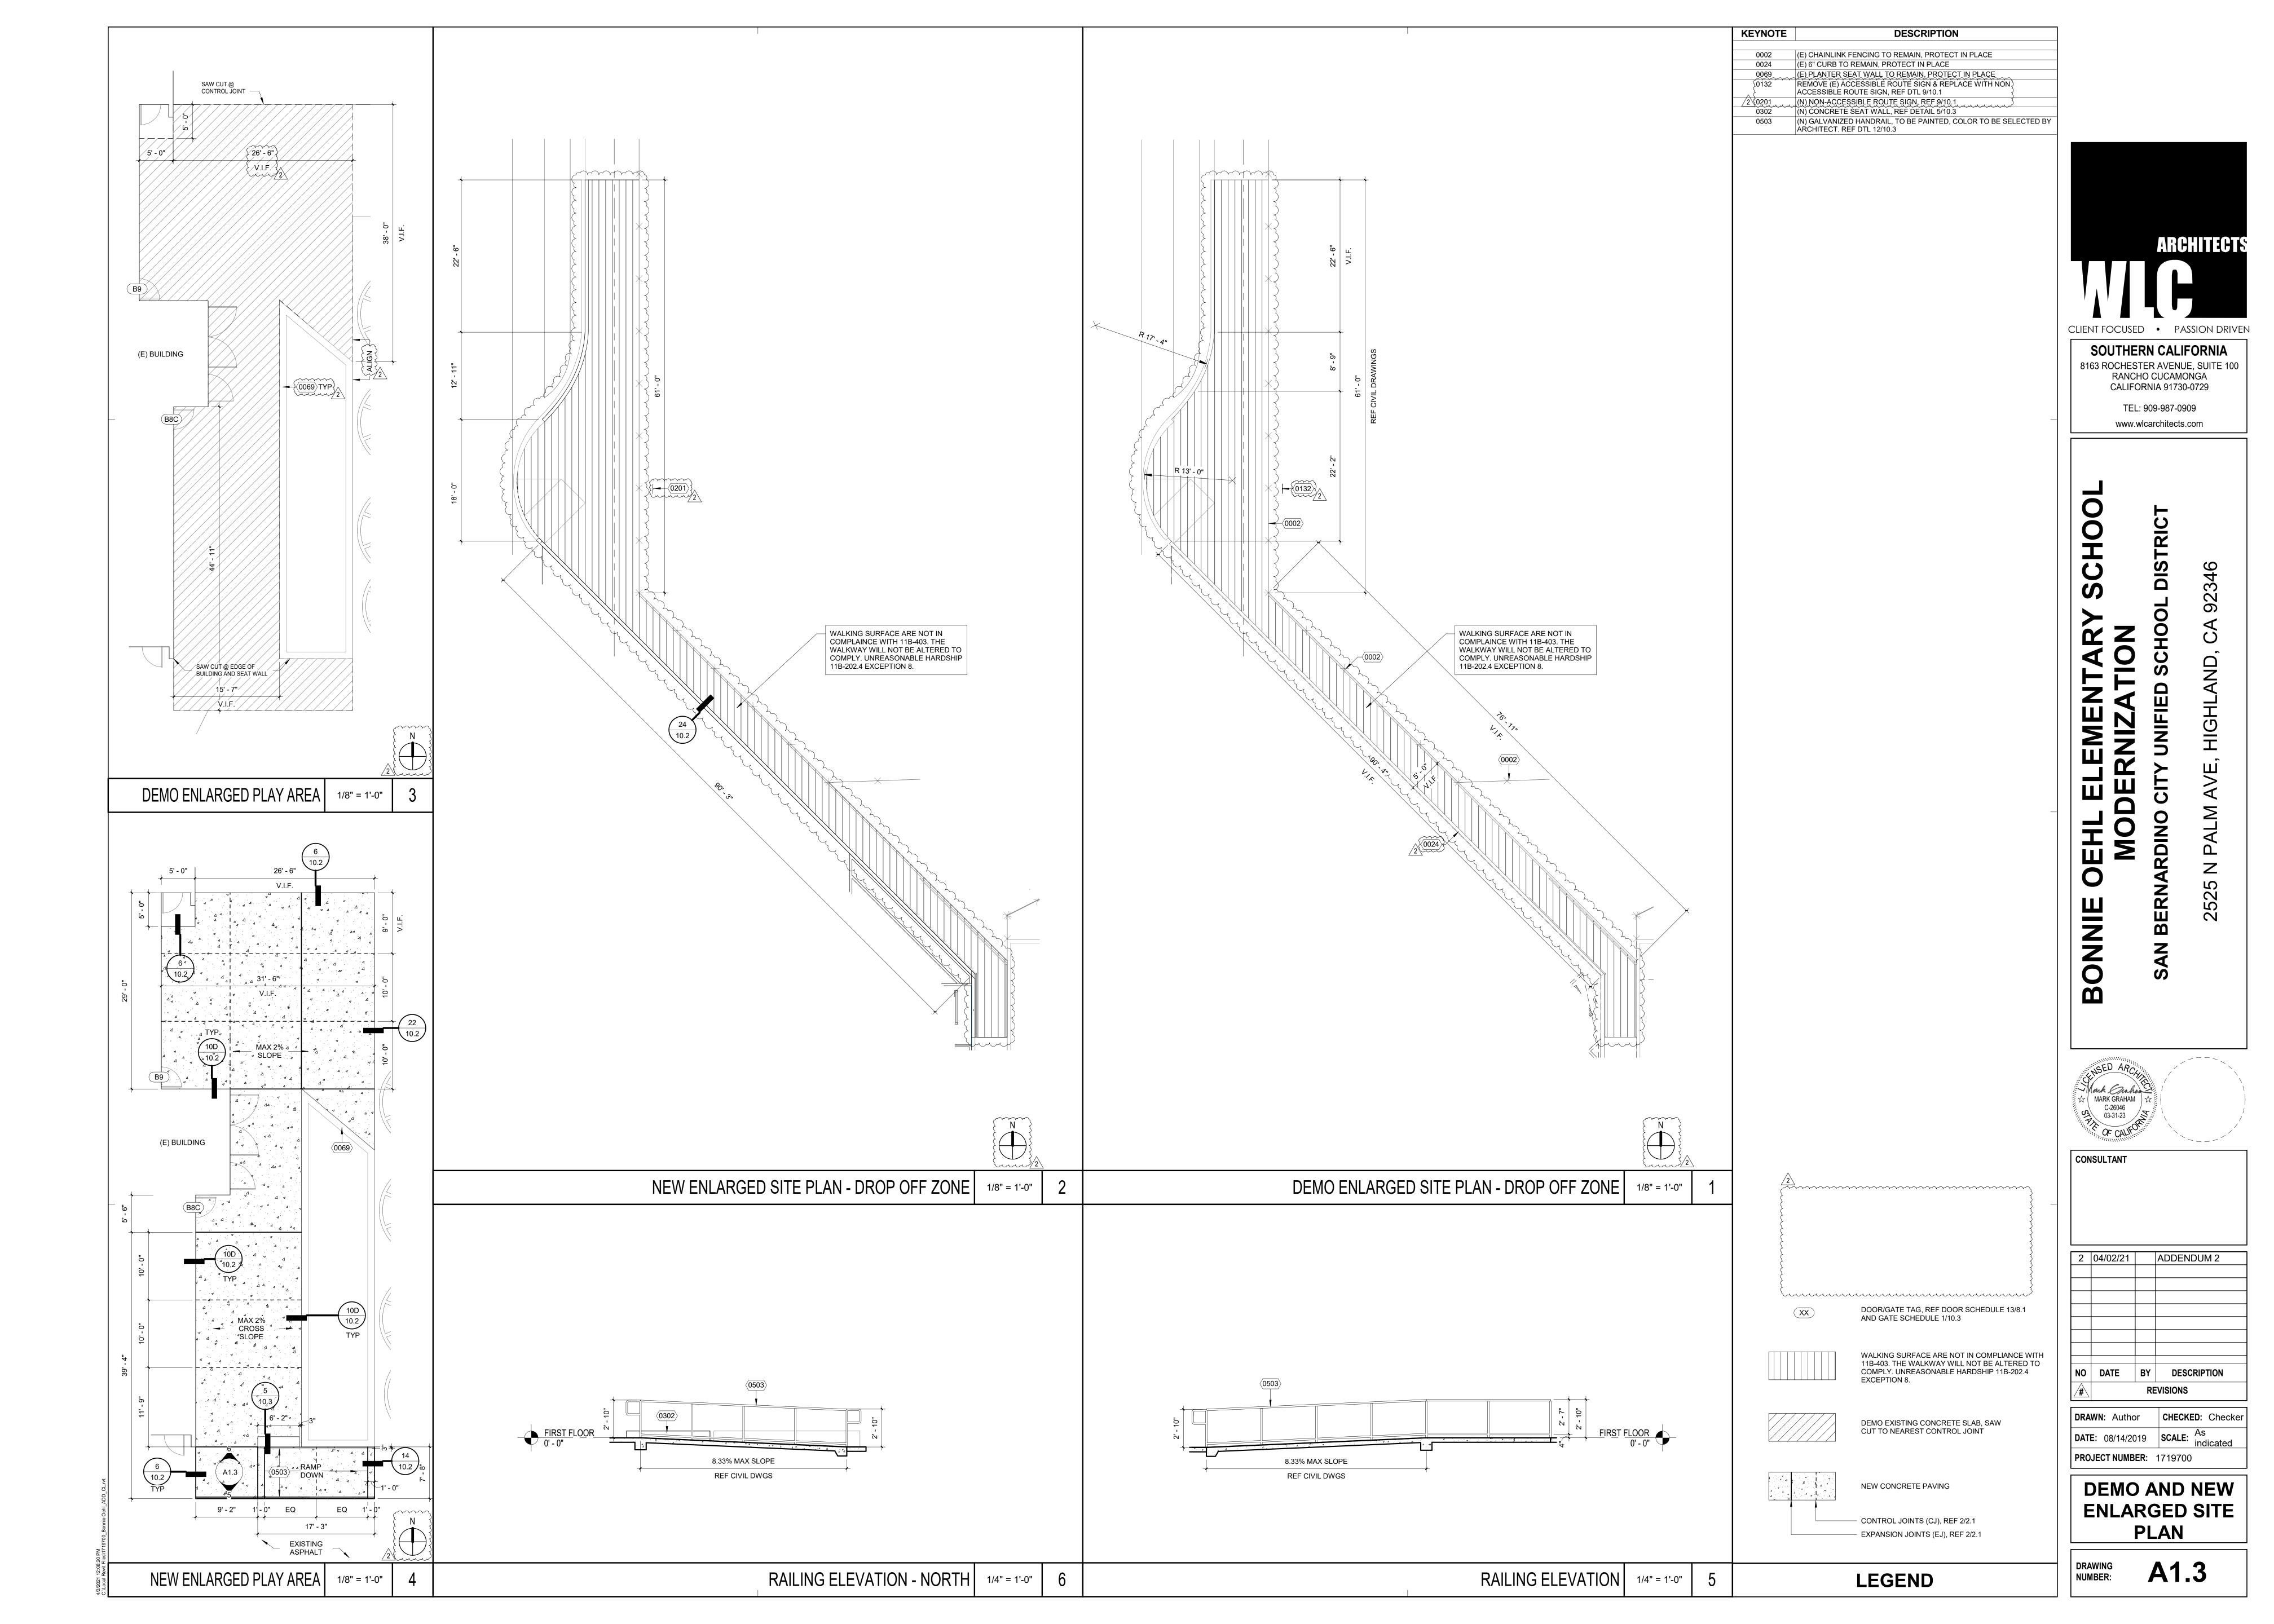

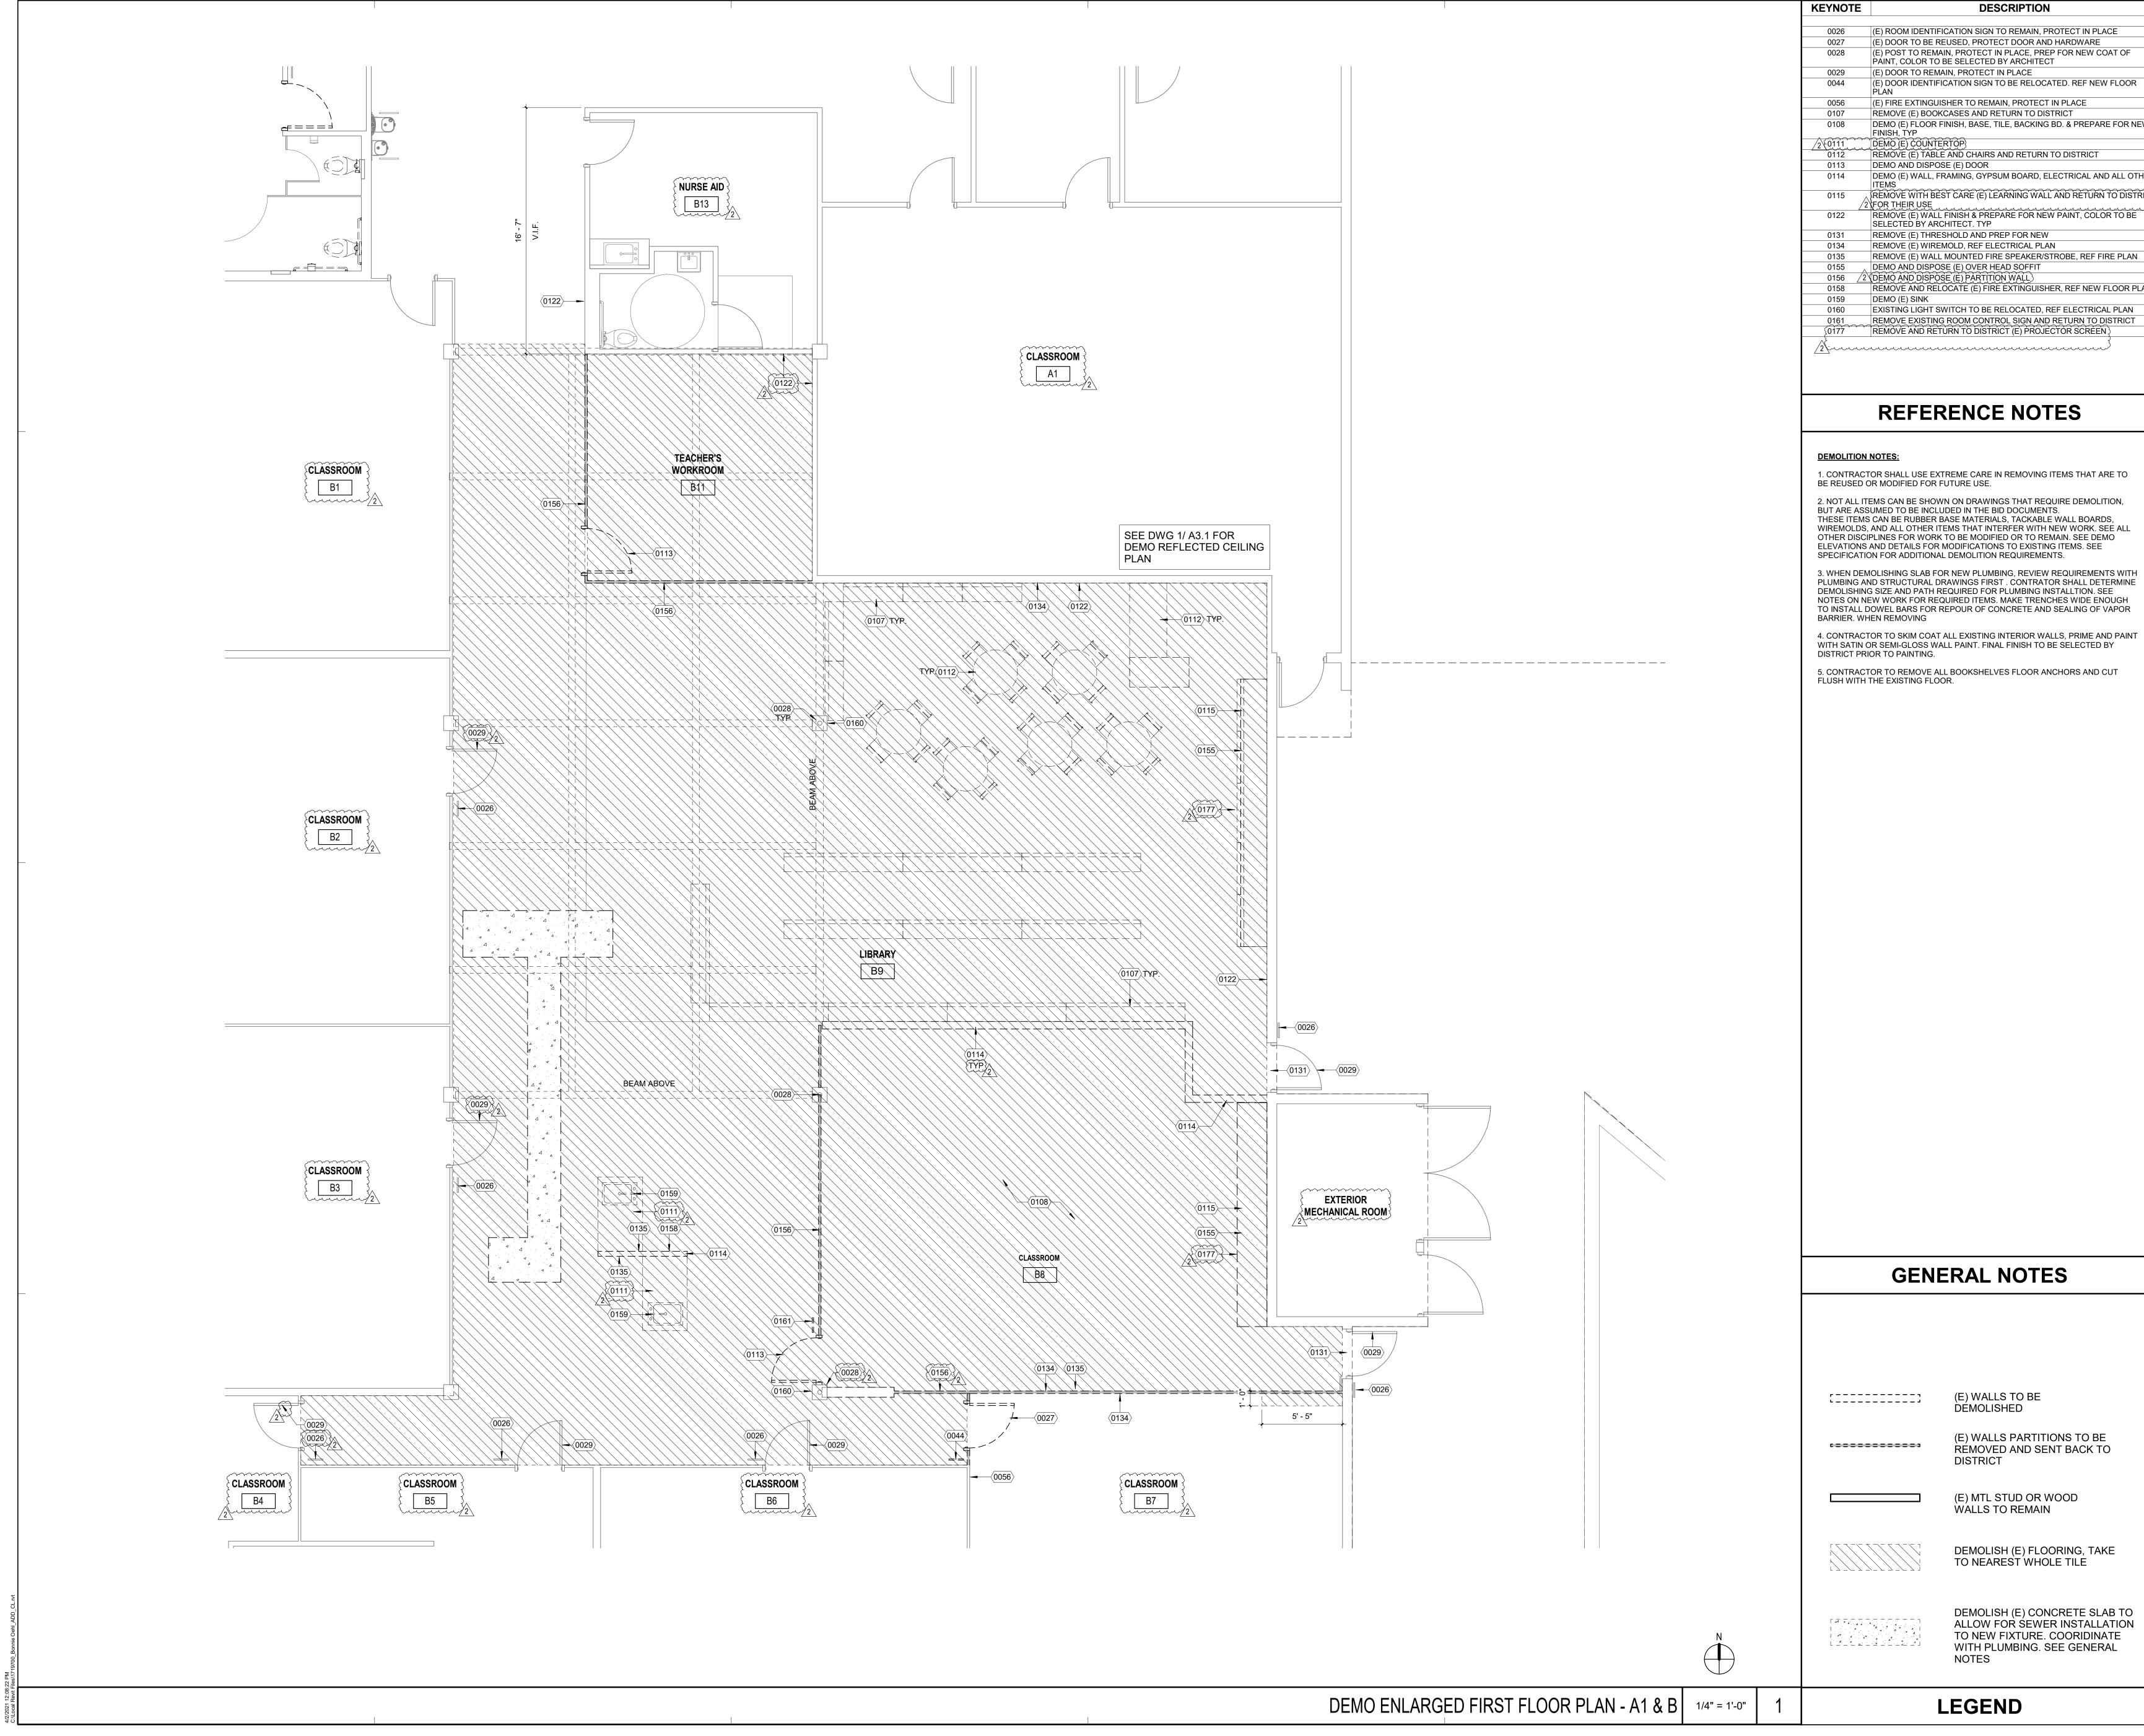



KEYNOTE	DESCRIPTION
0026	(E) ROOM IDENTIFICATION SIGN TO REMAIN, PROTECT IN PLACE
0027	(E) DOOR TO BE REUSED, PROTECT DOOR AND HARDWARE
0028	(E) POST TO REMAIN, PROTECT IN PLACE, PREP FOR NEW COAT OF PAINT, COLOR TO BE SELECTED BY ARCHITECT
0029	(E) DOOR TO REMAIN, PROTECT IN PLACE
0044	(E) DOOR IDENTIFICATION SIGN TO BE RELOCATED. REF NEW FLOOP PLAN
0056	(E) FIRE EXTINGUISHER TO REMAIN, PROTECT IN PLACE
0107	REMOVE (E) BOOKCASES AND RETURN TO DISTRICT
0108	DEMO (E) FLOOR FINISH, BASE, TILE, BACKING BD. & PREPARE FOR N FINISH, TYP
2 { 0111	DEMO (E) COUNTERTOP}
0112	REMOVE (E) TABLE AND CHAIRS AND RETURN TO DISTRICT
0113	DEMO AND DISPOSE (E) DOOR
0114	DEMO (E) WALL, FRAMING, GYPSUM BOARD, ELECTRICAL AND ALL O
0115	REMOVE WITH BEST CARE (E) LEARNING WALL AND RETURN TO DIS
0122	REMOVE (E) WALL FINISH & PREPARE FOR NEW PAINT, COLOR TO BE SELECTED BY ARCHITECT. TYP
0131	REMOVE (E) THRESHOLD AND PREP FOR NEW
0134	REMOVE (E) WIREMOLD, REF ELECTRICAL PLAN
0135	REMOVE (E) WALL MOUNTED FIRE SPEAKER/STROBE, REF FIRE PLAI
0155	DEMO AND DISPOSE (E) OVER HEAD SOFFIT
0156 2	DEMO AND DISPOSE (E) PARTITION WALL
0158	REMOVE AND RELOCATE (E) FIRE EXTINGUISHER, REF NEW FLOOR F
0159	DEMO (E) SINK
0160	EXISTING LIGHT SWITCH TO BE RELOCATED, REF ELECTRICAL PLAN
0161	REMOVE EXISTING ROOM CONTROL SIGN AND RETURN TO DISTRICT
<u></u>	REMOVE AND RETURN TO DISTRICT (E) PROJECTOR SCREEN

1. CONTRACTOR SHALL USE EXTREME CARE IN REMOVING ITEMS THAT ARE TO BE REUSED OR MODIFIED FOR FUTURE USE.


THESE ITEMS CAN BE RUBBER BASE MATERIALS, TACKABLE WALL BOARDS, WIREMOLDS, AND ALL OTHER ITEMS THAT INTERFER WITH NEW WORK. SEE ALL OTHER DISCIPLINES FOR WORK TO BE MODIFIED OR TO REMAIN. SEE DEMO


3. WHEN DEMOLISHING SLAB FOR NEW PLUMBING, REVIEW REQUIREMENTS WITH PLUMBING AND STRUCTURAL DRAWINGS FIRST . CONTRATOR SHALL DETERMINE DEMOLISHING SIZE AND PATH REQUIRED FOR PLUMBING INSTALLTION. SEE NOTES ON NEW WORK FOR REQUIRED ITEMS. MAKE TRENCHES WIDE ENOUGH TO INSTALL DOWEL BARS FOR REPOUR OF CONCRETE AND SEALING OF VAPOR

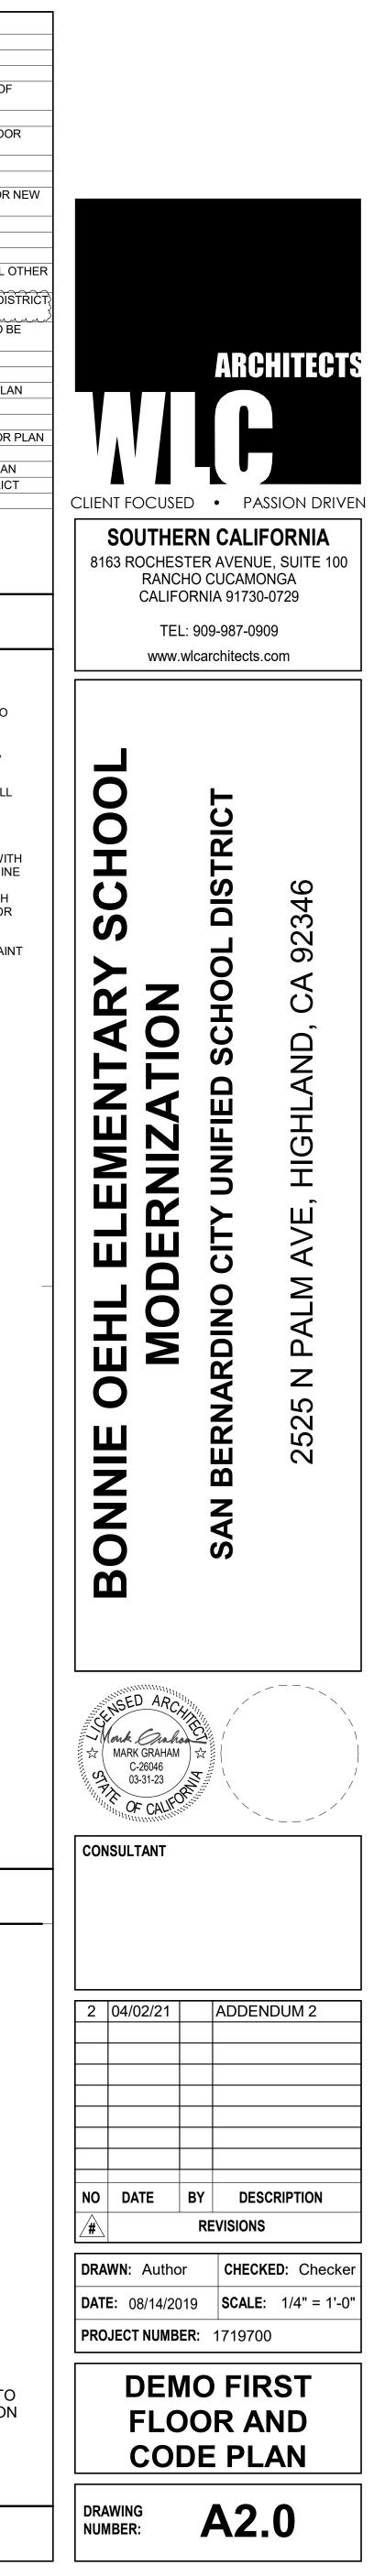


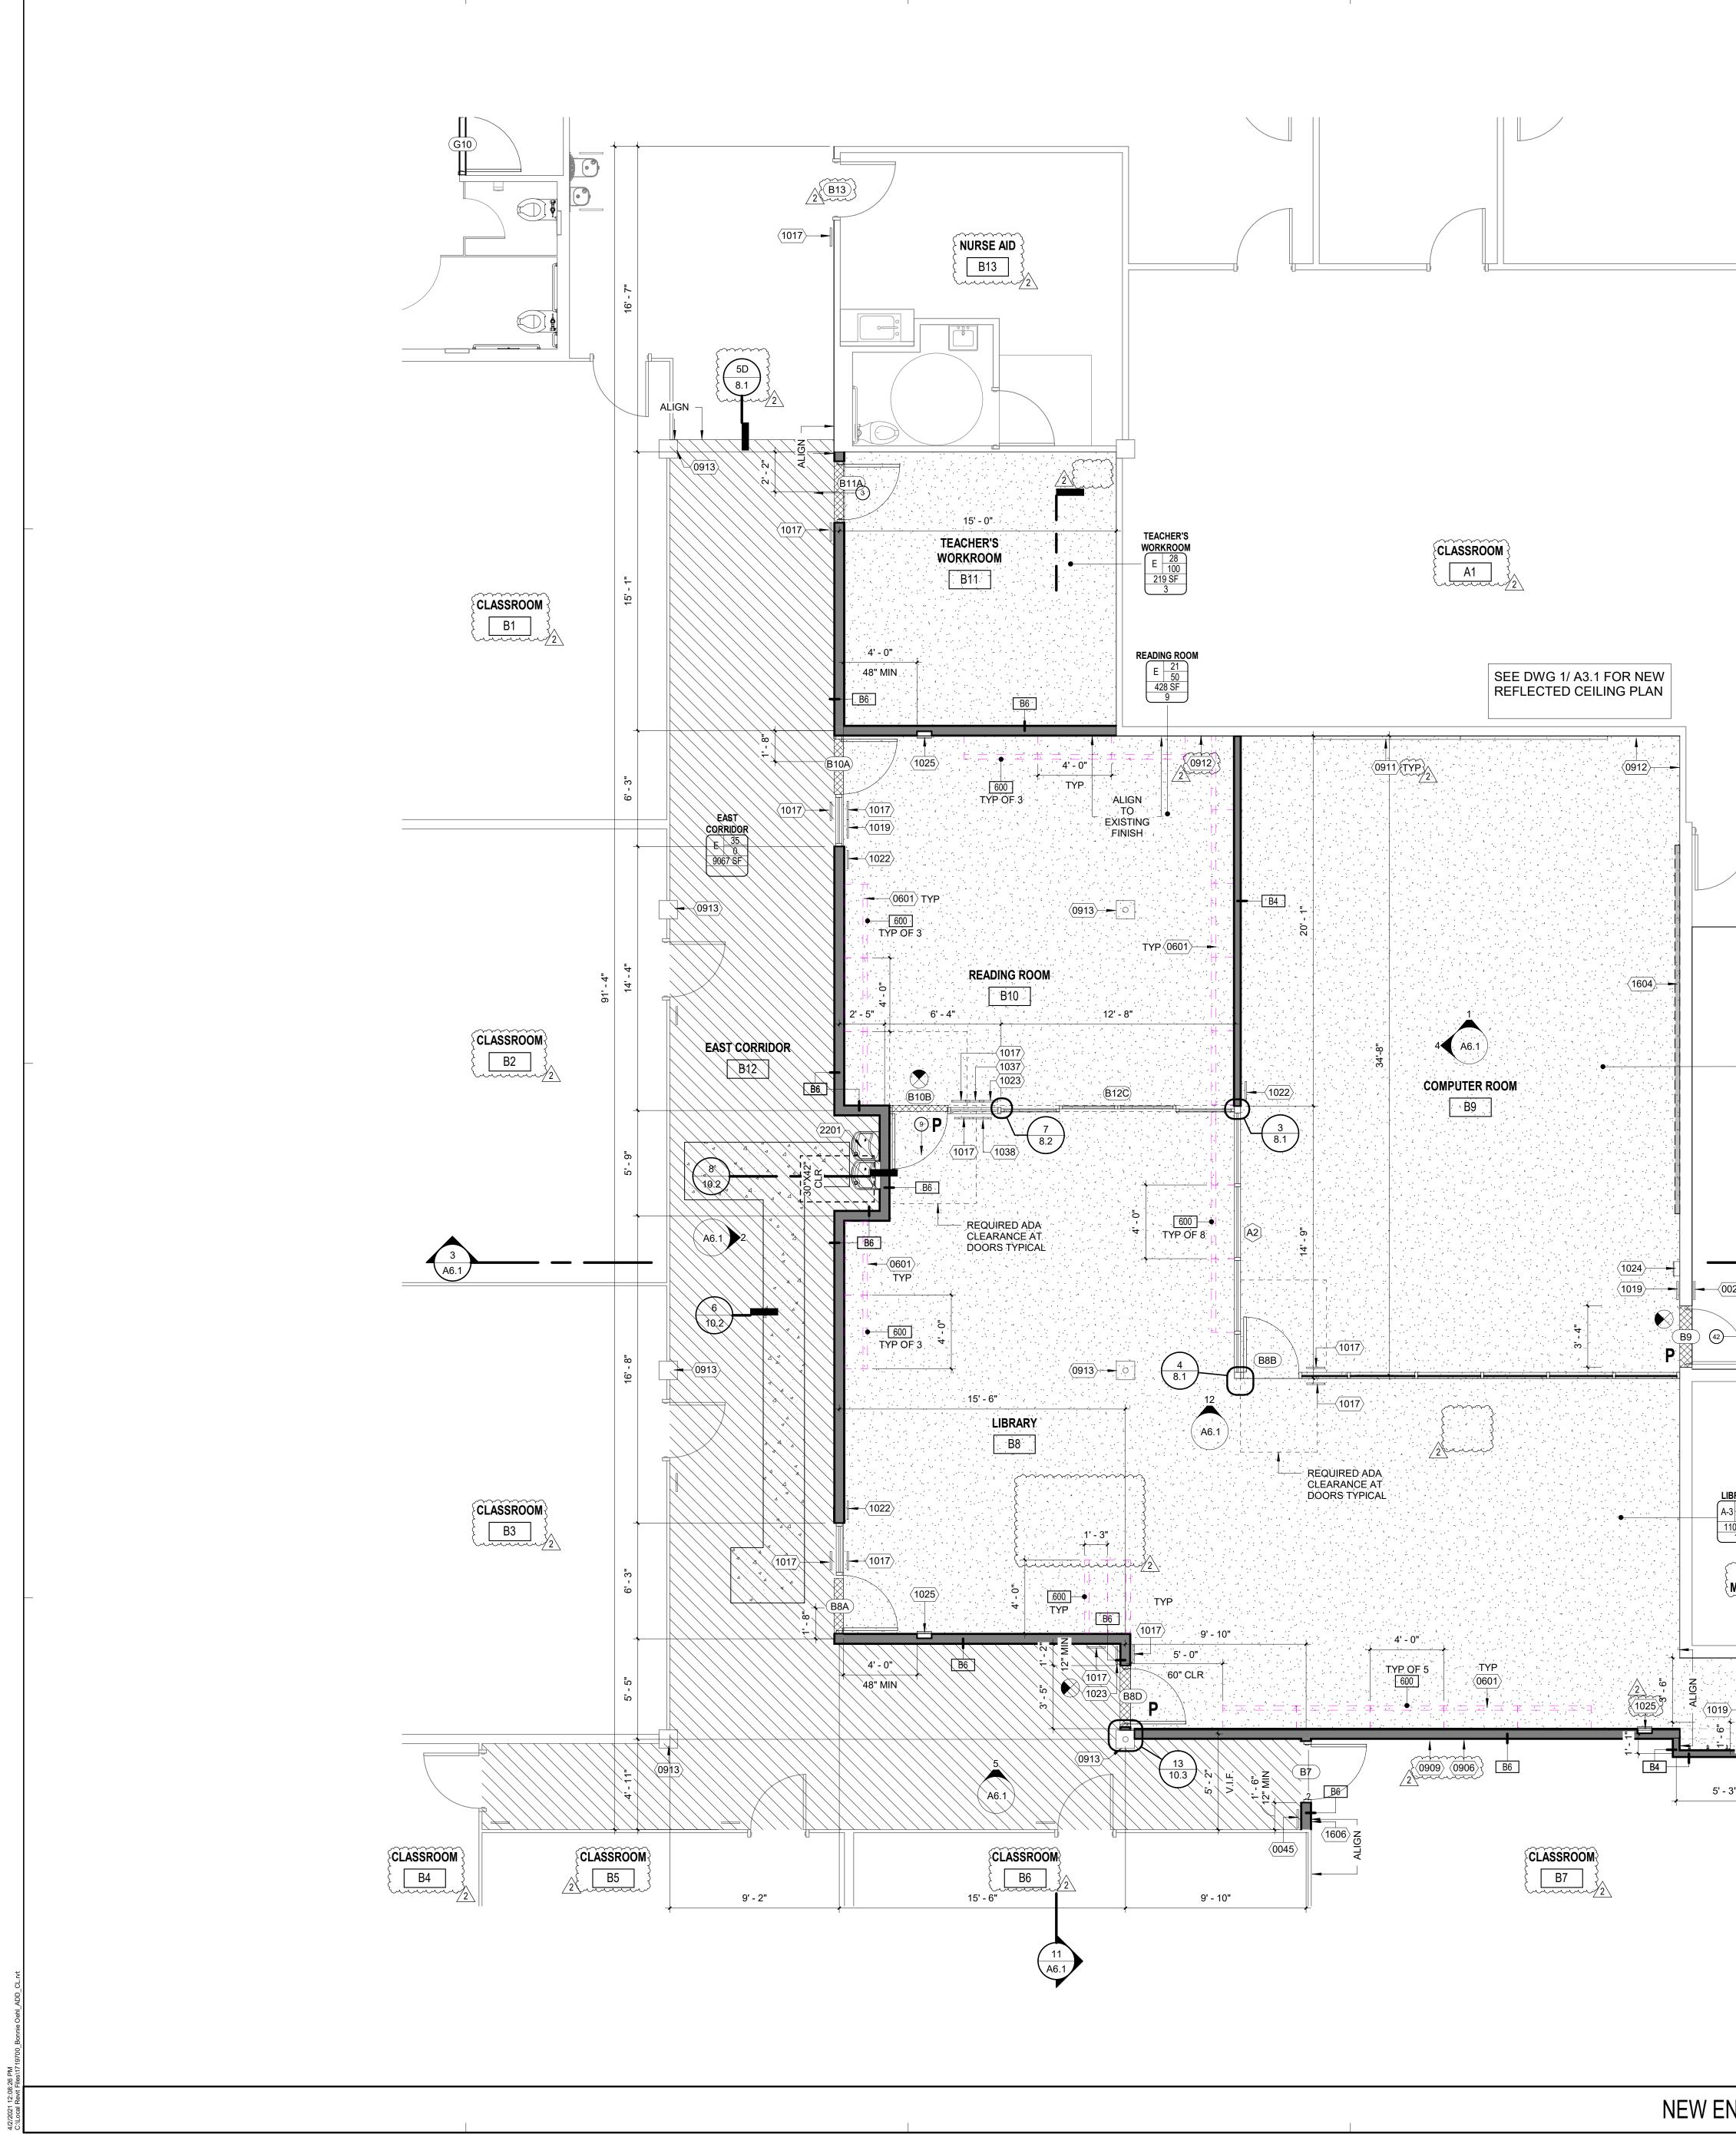

			KEYNOTE		DESCRIPTION	
			0045 0601 0906	RELOCATED (E) (N) CASEWORK,	DOOR INDENTIFICATION SIGN REF SHT SERIES 6 1 BOARD, PAINTED, COLOR SELECTED BY	
			0909 0911	(N) 4" RUBBER B {(N) DEKO MARKI SPECS	ASE ERBOARD, COLOR TO BE SELECTED BY	ARCHITECT
			0912 0913 1017	(E) WALL TO BE (E) POST TO BE	PAINTED, COLOR TO BE SELECTED BY A PAINTED, COLOR TO BE SELECTED BY A FIFICATION SIGN, SEE DTL 10/10.1	RCHITECT
			1019 1022 1023	(N) EXIT SIGNAG	GE, REF DTL 21/10.1 ISTENING SIGN, REF DTL 13/10.1 SIGNAGE, REF DTL 22/10.1	
			1024 1025 1037	(N) SURFACE MO (N) RECESSED F	DUNTED FIRE EXTINGUISHER FIRE EXTINGUISHER, REF 2/10.2 E ENTRY SIGNAGE, REF 23/10.1	
			1037 1038 1604	(N) ACCESSIBLE (N) WIREMOLD F	ENTRY SIGNAGE WITH ARROW, REF 1/. PER ELEC. DWGS. COORDINATE LOCATIC ALLATION, WIRE MOLD TO BE PAINTED, C	N W/ QWN
			1606 2201	RELOCATED (E)	RCHITECT S CLASSROOM LIGHT SWITCH, REF ELECT TED HI-LOW DRINKING FOUNTAIN AND B	2 PLAN
				BPE	RENCE NOTES	
EW AN			E-1- 900 4:	SF 5 * 9	6 = SPACE USE - REF SPACE USE SCH 20 = OCCUPANT LOAD FACTOR (CBC T 200 = FLOOR AREA - SQUARE FEET 45 = TOTAL OCCUPANTS 7 = OCCUPANT LOAD SIGN REQUIRED NOTED CBC SEC 1002.3), REF SIGNAGE SCHE PATH OF EGRESS - 120 = OCCUPANT L	ABLE 10-A WHEN DULE
				F	PATH OF EGRESS - 120 = OCCUPANT L	.OAD
					EXIT SIGN - REF ELEC. TACTILE EXIT S REQUIRED. REF SIGNAGE SCHEDULE	IGN ALSO
			F	•	PANIC HARDWARE DEVICE - REF DOO AND HARDWARE GROUP	R SCHED
			OCCUPANT LO. 1004.1.2	AD FACTORS AR	RE ACCORDING TO CBC SECTION 1004	, TABLE NO
				CODE	PLAN LEGEND	
COMPUTER ROOM			#	OCC	UPANCY LOAD FACTOR	0
$ \begin{array}{c c} E & 17 \\ \hline 20 \\ \hline 829 SF \\ \hline 42 \\ \hline \end{array} $			21 2	7 CLASSROC 1 LIBRARY - F 22 LIBRARY - S	OM READING ROOM	
				28 OFFICE 35 CORRIDOR		
			GENERAL NOT		JDE NOTES	
$\mathbf{B} = \mathbf{P}$			1. REFER TO R 2. DIMENSIONS 3. ALL INTERIO SHEET 9.1 4. REFER TO D 5. ALL DOOR A 6. REFER TO 10 ASSISTIVE LIS CONTRACTOR ADDITIONAL RI 601 OCCUPANT 601 X 4% = 24.0 PROVIDE MIN. AND A MIN. OF WITH A TOTAL 1. ASSISTIVE-L SECTION 11B-2 2. THE MINIMUI THE TOTAL NU RECIEVERS PR	OOM FINISH SCH SARE TO CENTER R WALLS ARE AT ETAILS SHEET 8 S ND WINDOW DIMI 0.1 FOR ROOM AN TENING NOTES: TO PROVIDE ASS EQUIREMENTS. T TS 14 OF (18) RECEIVER (7) HEARING AID OF (18) RECEIVER (7) HEARING AID OF MIN (25) RECE ISTENING SYSTER 219 AND SHALL CO M NUMBER OF RE MBER OF SEATS, ROVIDED, BUT NO N ACCORDANCE 1	TACHED TO ROOF STRUCTURE, REF W/ SERIES FOR DOOR SCHEDULE ENSIONS ARE TO THE FACE OF JAMB/M ND DOOR SIGNAGE SCHEDULES AND DE SISTIVE LISTENING SYSTEM, SEE ELECT HE MORE RESTRICTIVE REQUIREMENTS RS COMPATIBLE RECEIVERS EIVERS MS SHALL BE PROVIDED IN ACCORDANG OMPLY WITH CBC SECTION 11B-706. ECIEVERS TO BE PROVIDED SHALL BE E , BUT IN NO CASE LESS THAN TWO. 25% FEWER THAN TWO, SHALL BE HEARING WIITH CBC SECTION 11B-706.3	ALL DETAIL ULLION TAILS RICAL FOR S APPLY. CE WITH CI QUAL TO 4 MINIMUM
				GEN	IERAL NOTES	
MECHANICAL ROOM 2				Â1	WINDOW TAG, REF WINDO	
				XX	DOOR TAG, REF DOOR SCH	EDULE
					(N) WOOD STUD NON-BEAR WALLS, REF WALL SCHEDU SHEET 9.1 AND FRAMING D	LE ON
5' - 3"					(N) LVT FLOOR, REF TO RO FINISH SCHEDULE SHT SEF	
					(N) CARPET FLOOR, REF TO ROOM FINISH SCHEDULE S SERIES 9	
					(N) THRESHOLD, REF 5&11/3	3.1
	N				PATCH BACK CONCRETE SLAB, REF DTL 6/10.2	
NEW ENLARGED FIRST FLOOR PLAN - A1 & B	1/4" = 1'-0"	1			LEGEND	

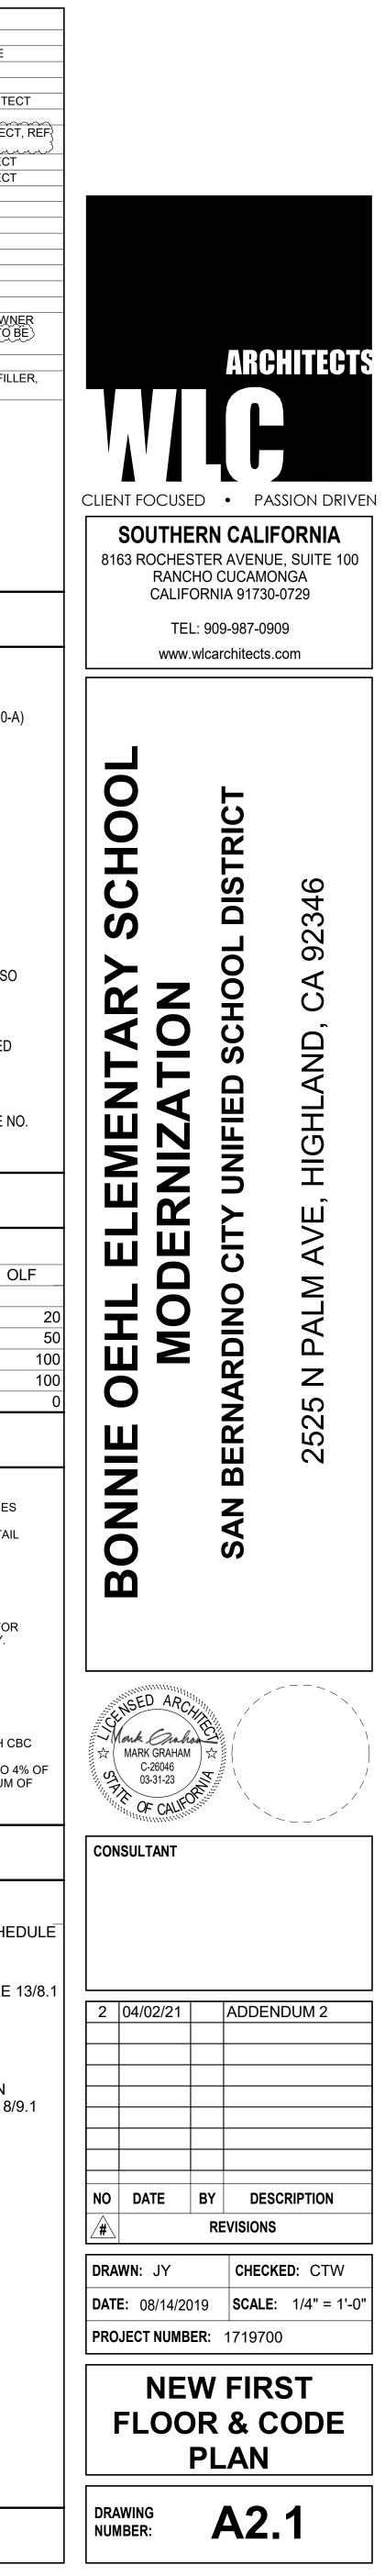


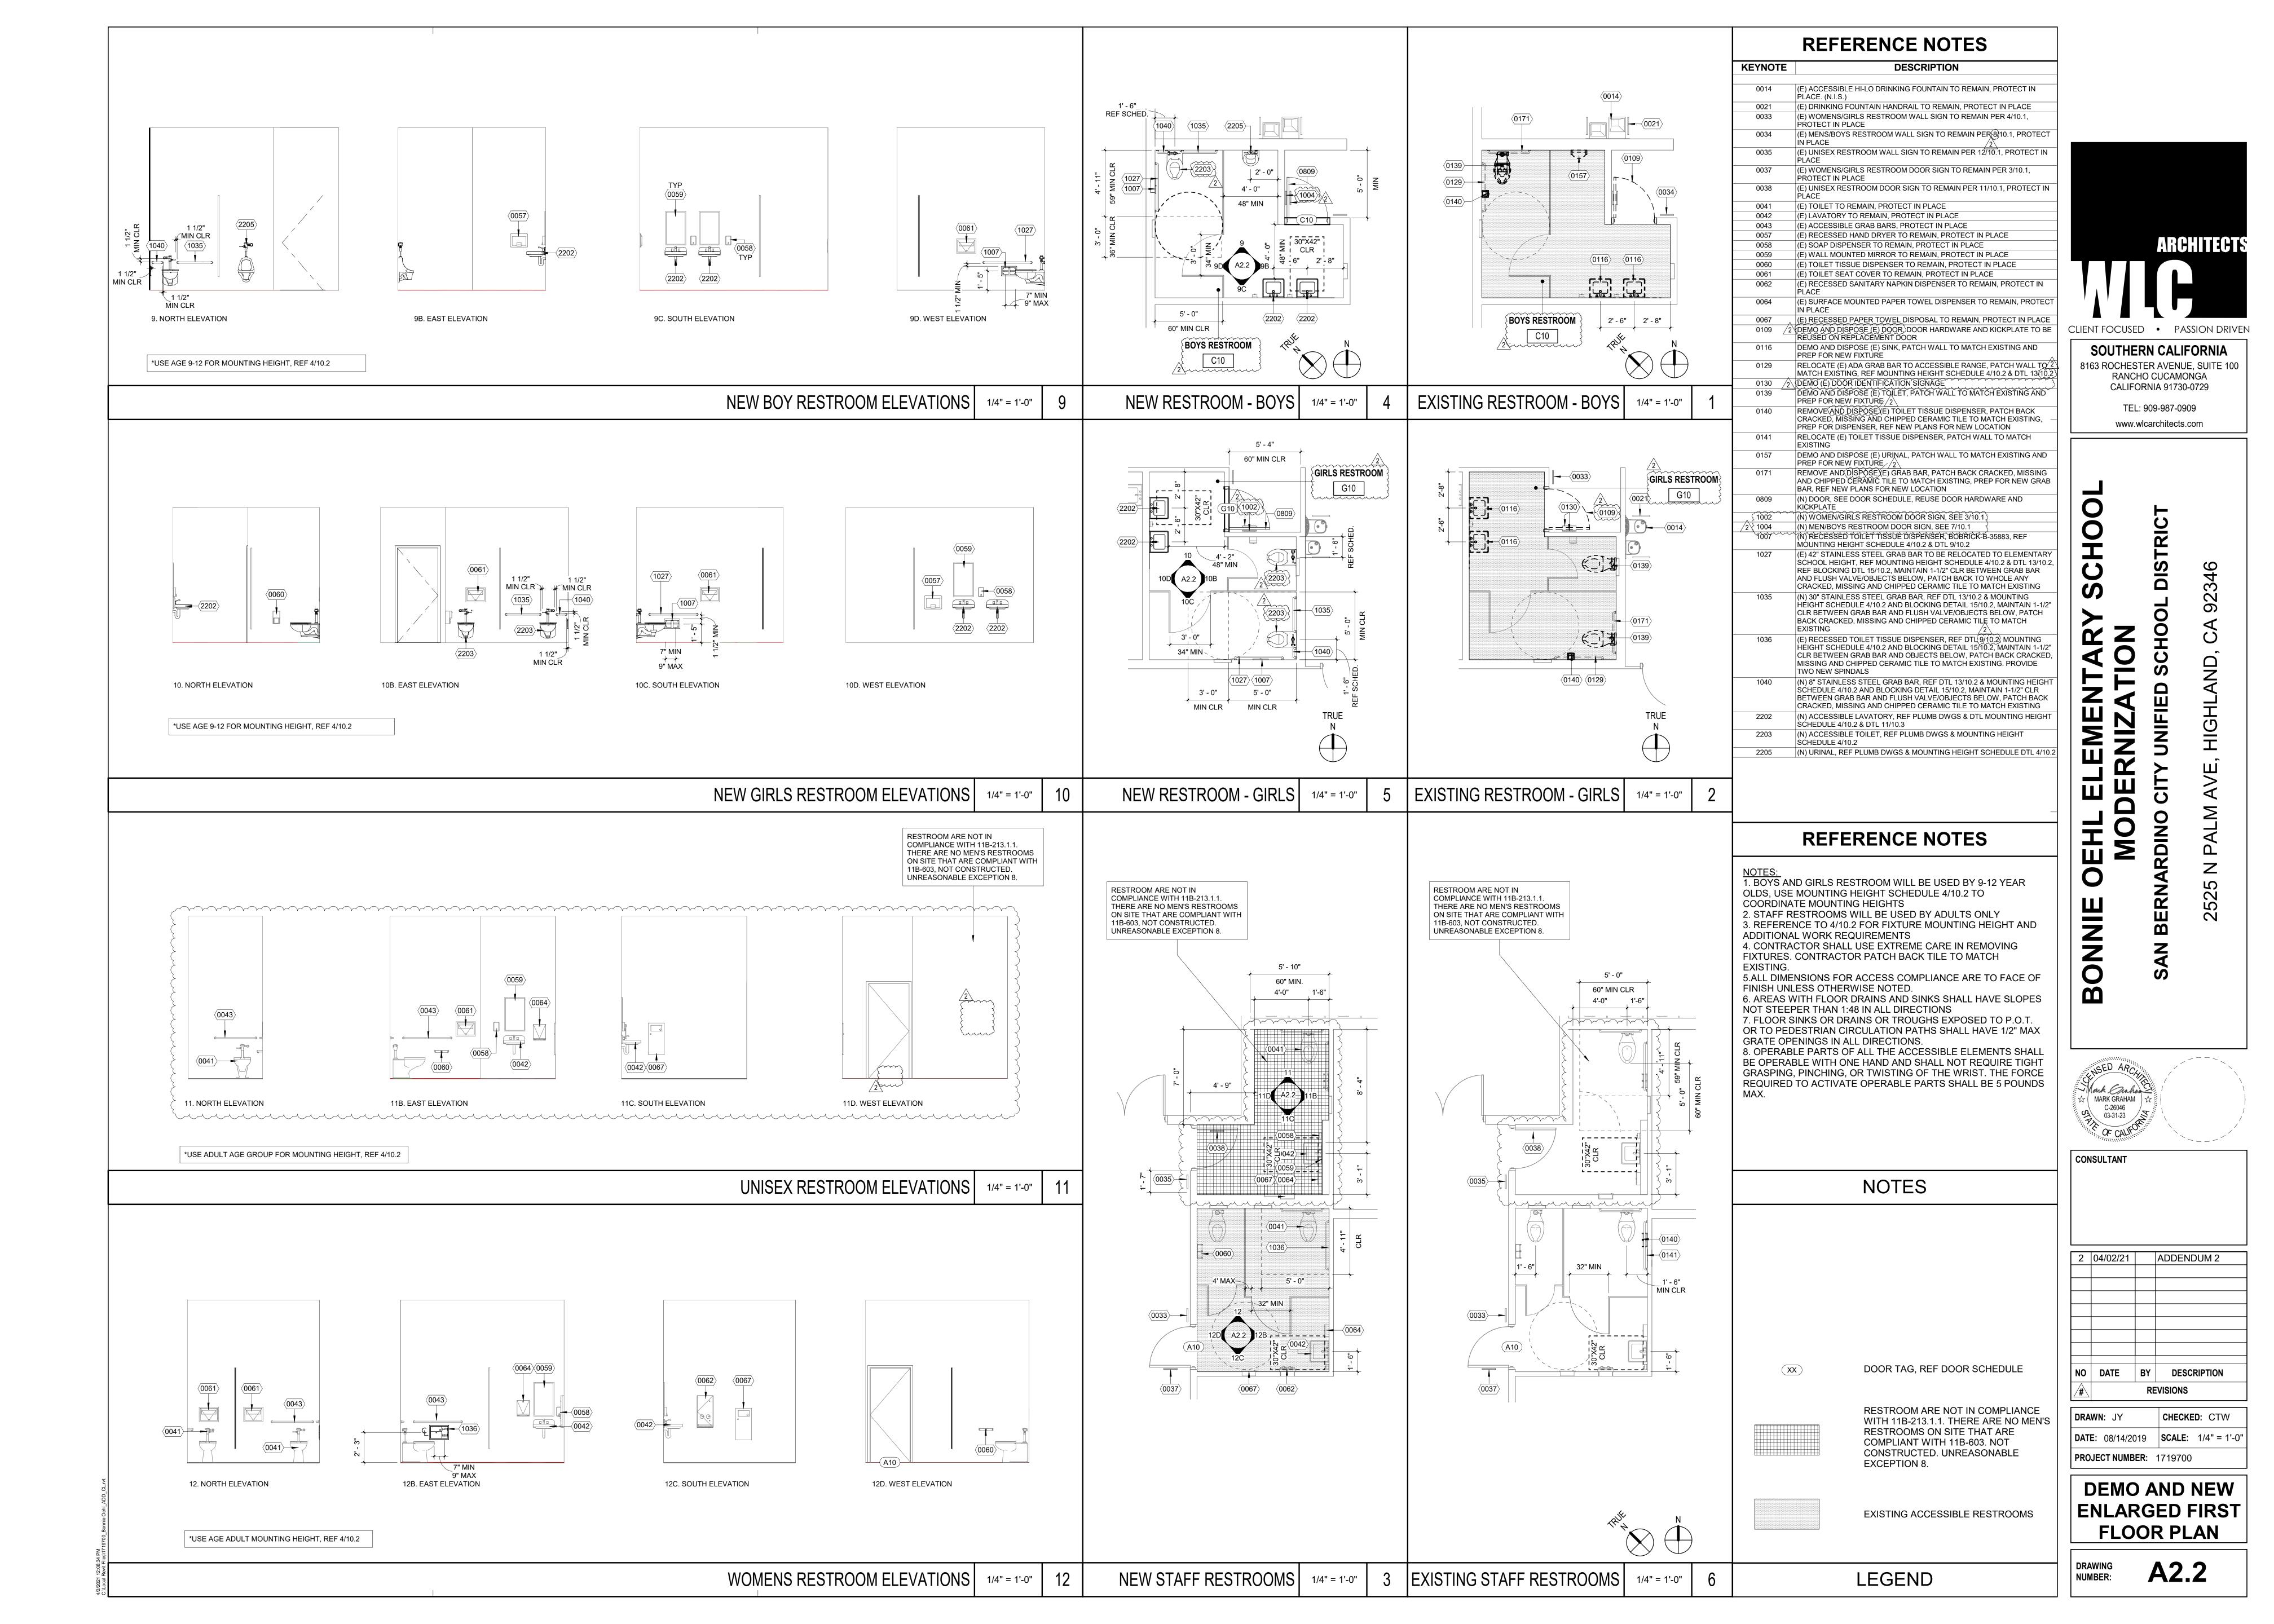


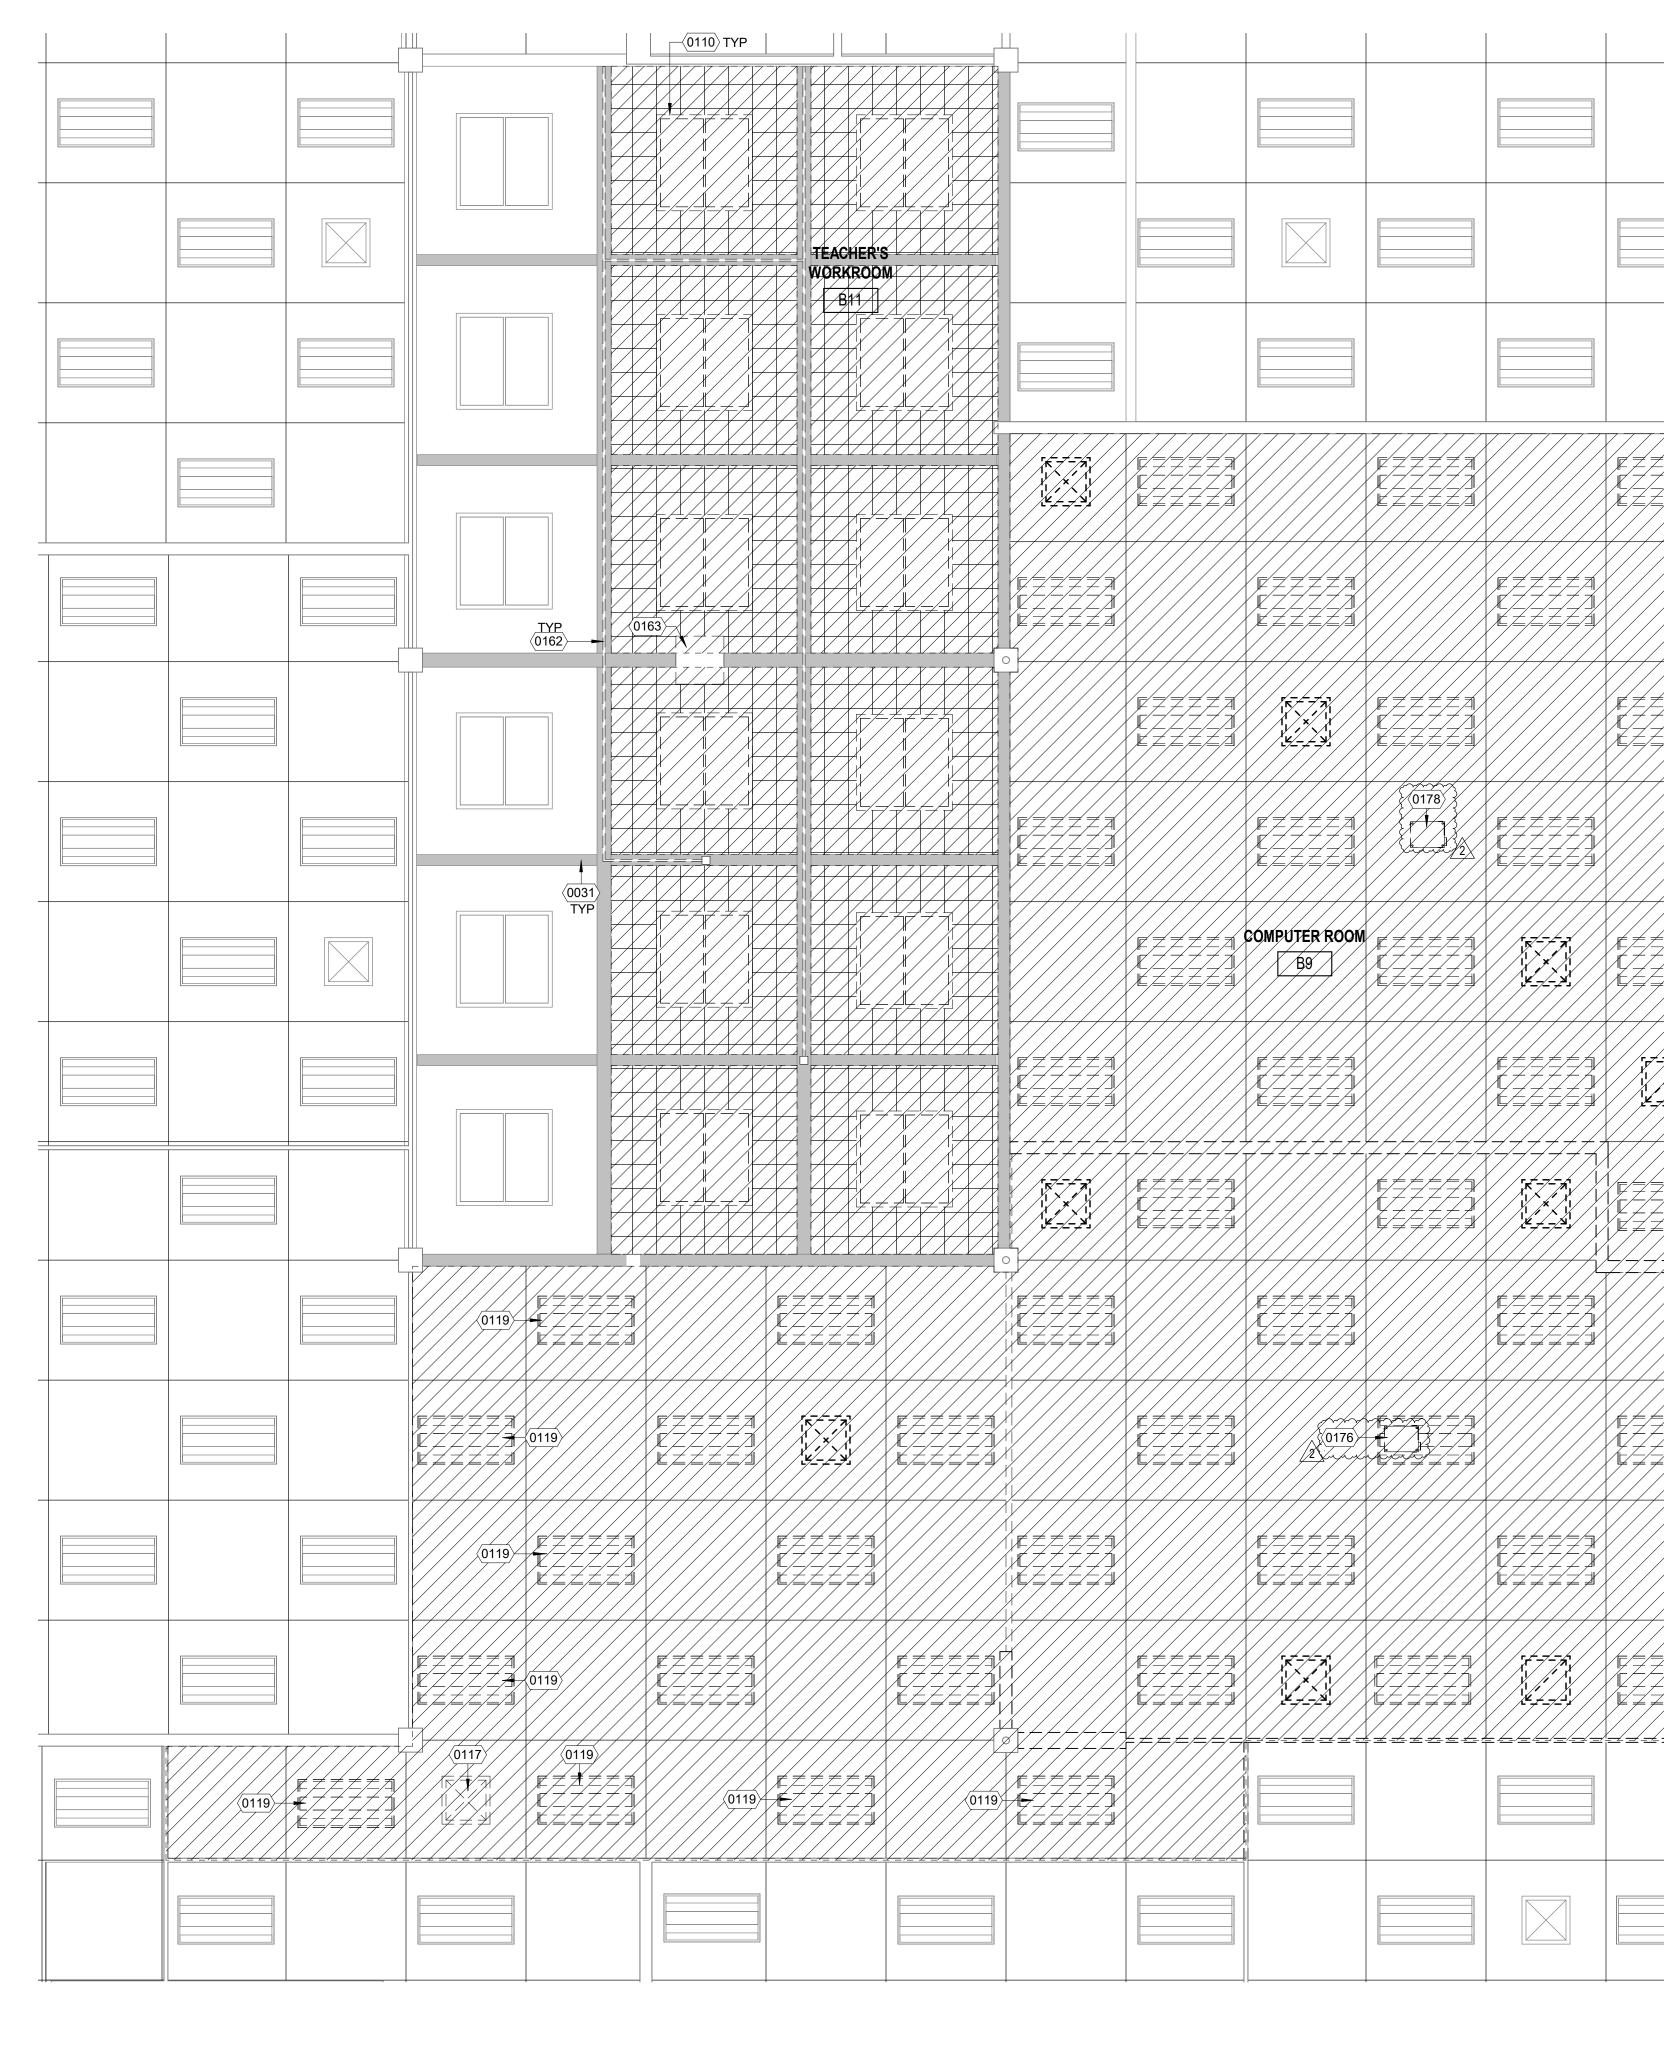

2021 12:08:36 PM


			KEYNOTE	(E) WOOD BEAM S	DESCRIPTION STRUCTURAL TO REMAIN, PROTECT IN PLACE, BEA NTED, COLOR TO BE SELECTED BY ARCHITECT
			0110 0117 0119	DEMO (E) LIGHTIN REMOVE AND REL	G FIXTURE, REF ELECT DWGS OCATE (E) MECHANICAL DIFFUSER, REF MECH DV T FIXTURE, CLEAN, PROTECT AND RELOCATE, REF
			0162 0163	RELOCATE (E) FIR REMOVE (E) CLOC ELECTRICAL PLAN	RE ALARM ELETRICAL LINES, REF ELECTRICAL PLA CK, DEMO ALL ELECTRICAL WIRING PER REQUIRED NS -OCATED (E) PROJECTOR
			2 0178		
				REFE	RENCE NOTES
					TREME CARE IN REMOVING ITEMS THAT ARE TO
			CEILING THA		ILLY REMOVE ALL ITEMS ATTACHED TO THE OUT TO BE DEMOLISHED. CLEAN, PROTECT O NEW CIELING.
			4. REMOVE	ALL CEILING TILE, CE	JTER LAB CIELING AREAS ONLY EILING GRIDS, HANGER AND SRLAY WIRES, ER TRIM AND PROVIDE ALL NEW PER SHEET 9.1
			DAMAGING (NG AT GRID INTERSECTION WITHOUT ILES WITHIN CLASSROOMS THAT ARE NOT RUCTION,
TYP					
				GENI	ERAL NOTES
					DEMOLISH (E) ACT CEILING AND T BAR, REF GENERAL NOTES
					EXISTING GLULAM BEAM TO REM
					EXISTING WALLS TO REMAIN
					EXISTING ACT CEILING TO
					REMAIN IN PLACE
					LIGHT FIXTURE TO BE DEMOLISHE REFER TO ELECTRICAL PLANS UNLESS NOTED OTHERWISE TO E
				()	REMOVED AND RELOCATED
		N			HVAC FIXTURE TO BE DEMOLISHE REFER TO MECHANICAL PLANS UNLESS NOTED OTHERWISE TO E
	F				REMOVED AND RELOCATED
ST REFLECTED CEILING F	PLAN - A1 & B	1/4" = 1'-0"		DEN	

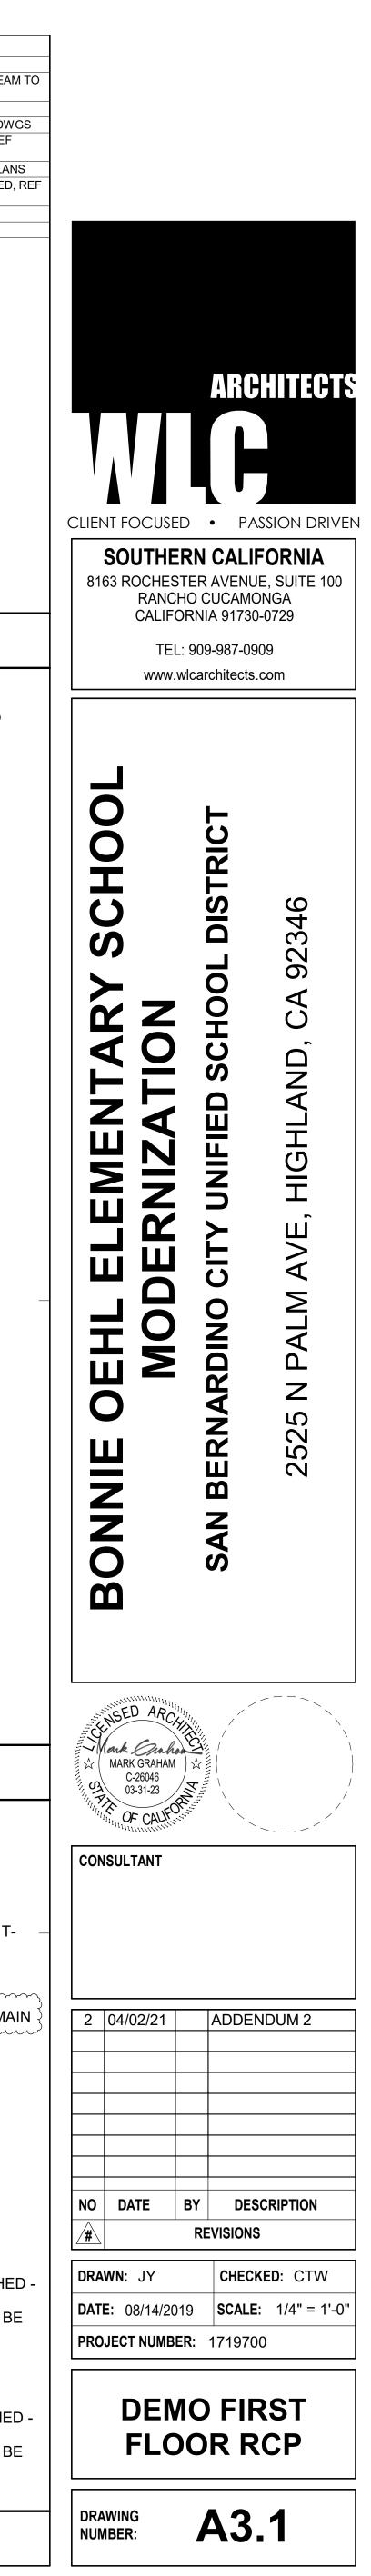


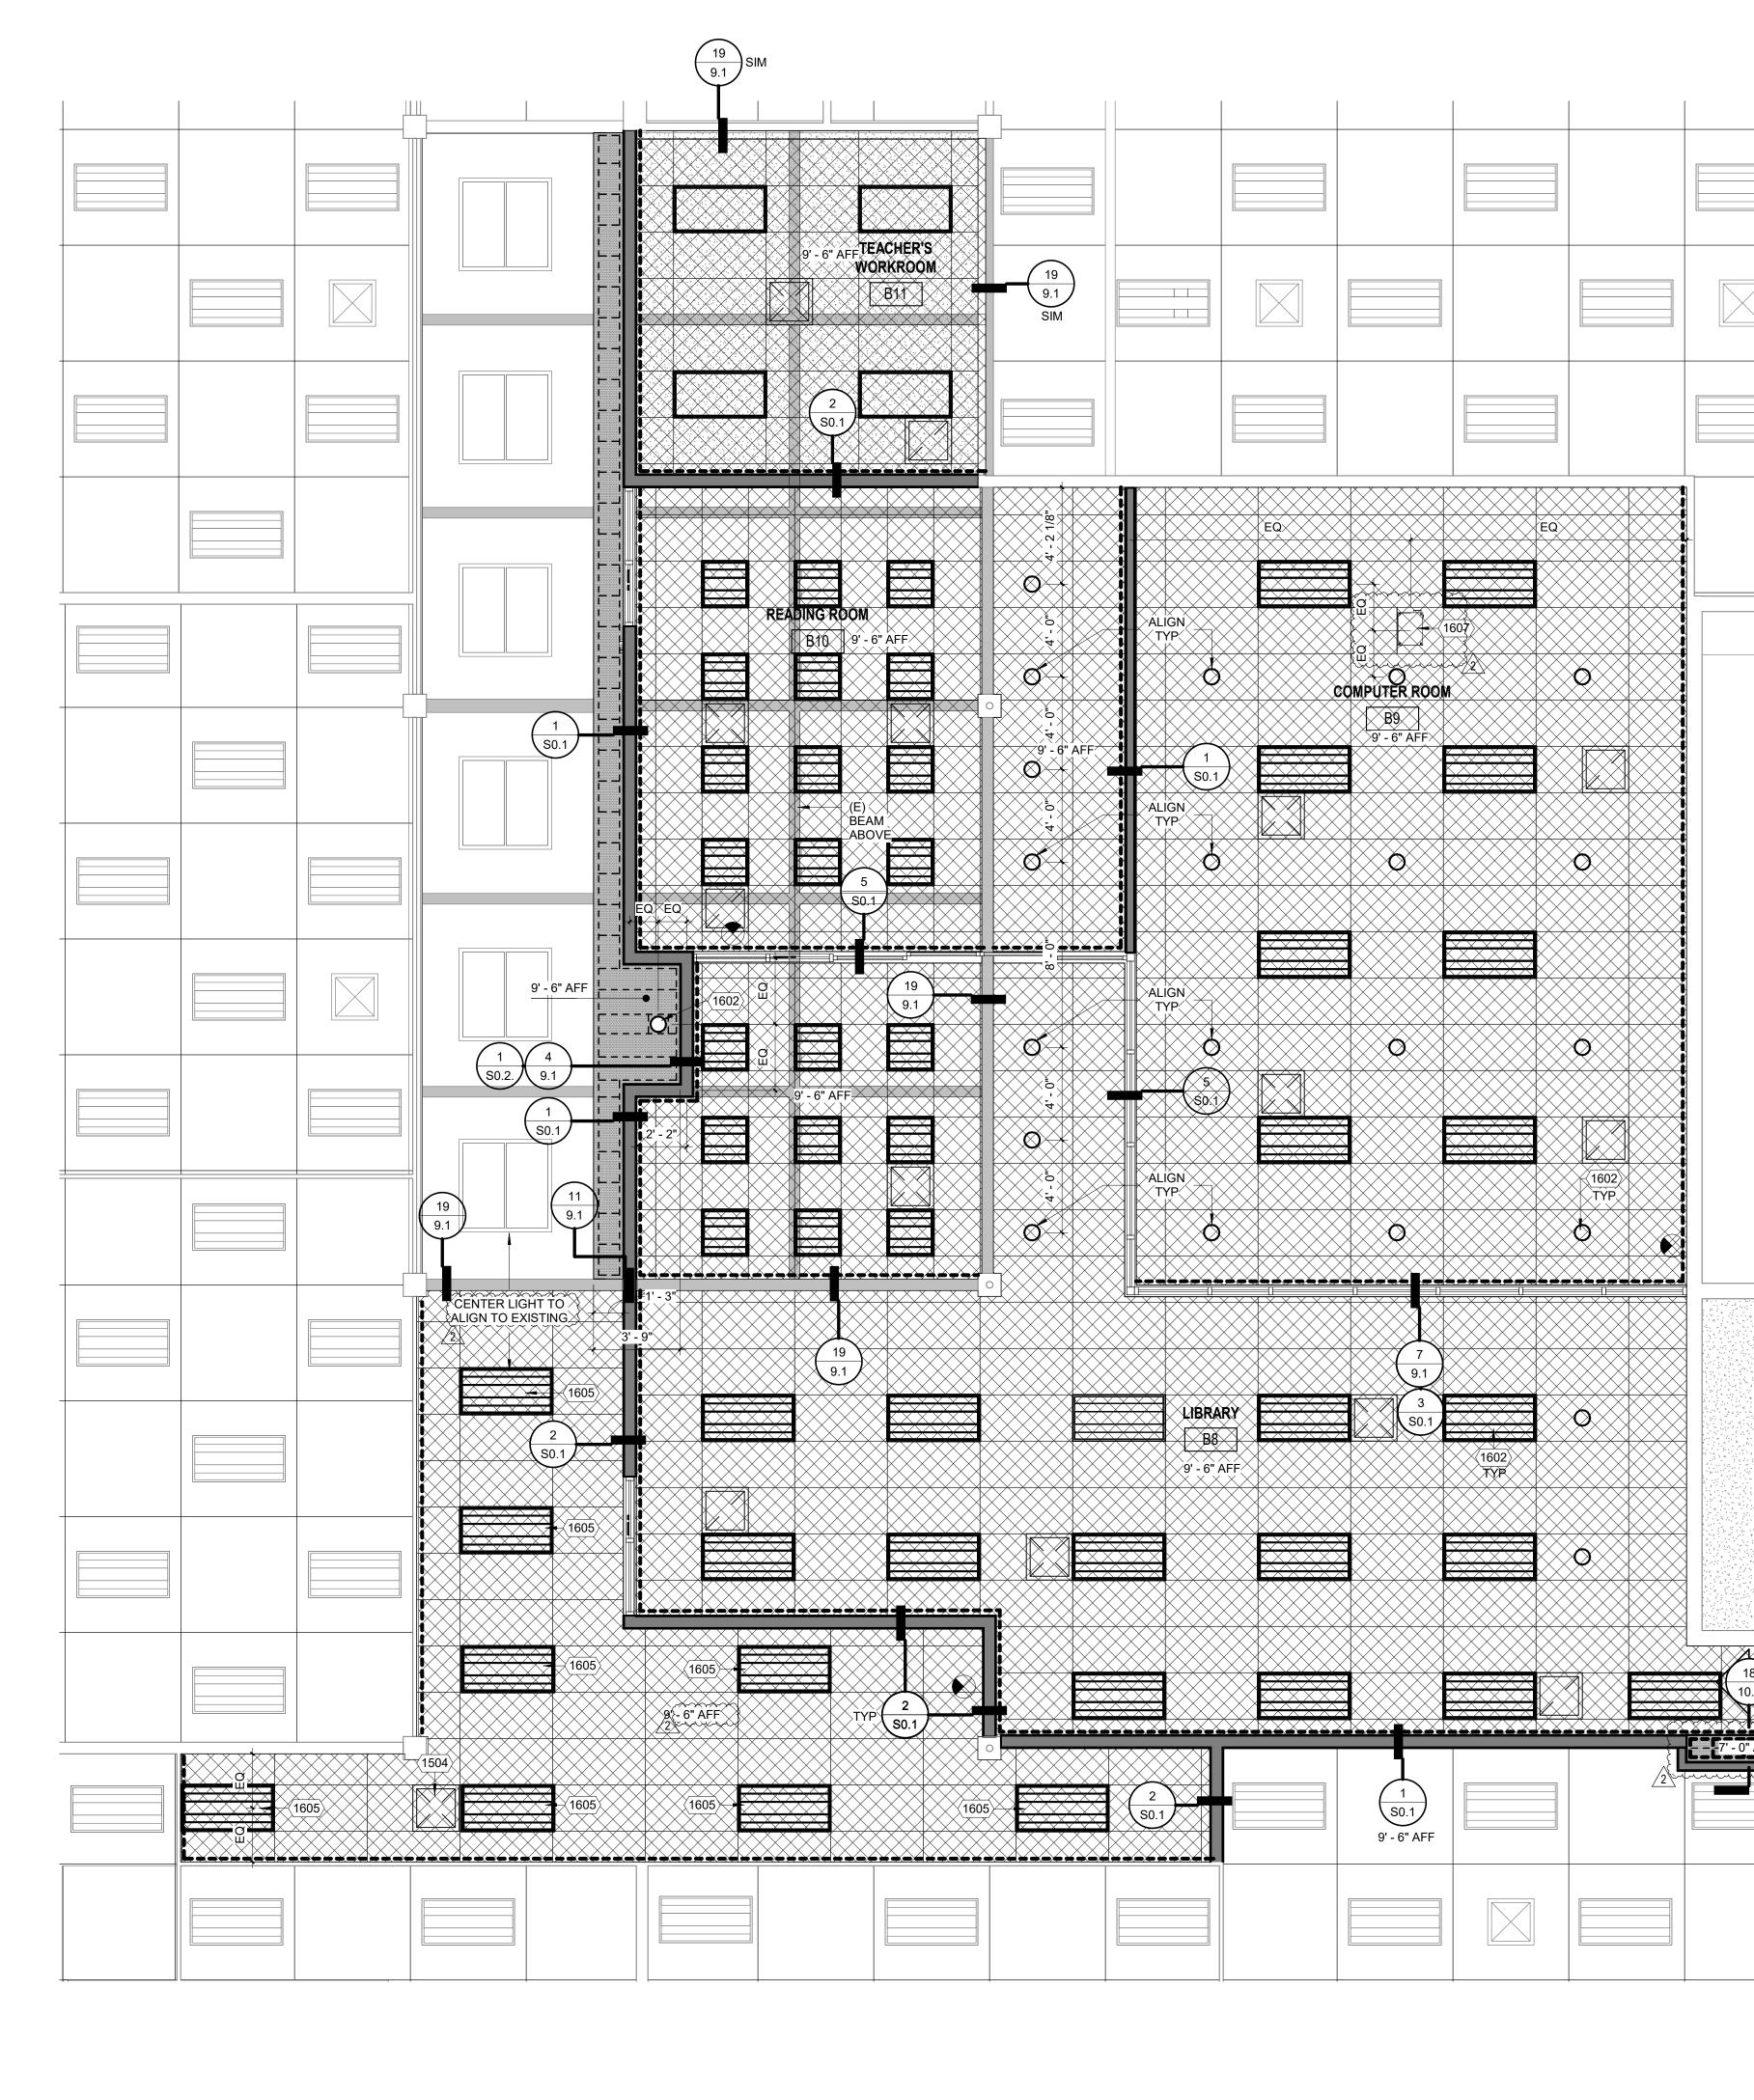





	KEYNOTE DESCRIPTION 1504 (E) MECHANICAL GRILL TO BE CLEAN, PROTECTED AND RELOCA MECH DWGS 1602 (N) LIGHTING FIXTURE, SEE ELECT DWGS 1605 (E) LIGHT FIXTURE TO BE CLEANED, PROTECTED AND RELOCAT ELECT DWGS 1607 (E) CEILING MOUNTED PROJECTOR TO BE CENTERED WITH PRO SCREEN AND LIGHT FIXTURES, REF DTL 5/10.2 & ELECT DWGS 2 2
	REFERENCE NOTES
	(N) ILLUMINATED EXIT SIG
	EXISTING GLULAM TO REMAIN, PROTECT IN PLAC
	FREE END TYP FREE END TYP
	NEW GYP BOARD CEILING WOOD FRAMING, REF 4/9 STRUCT DWGS 2X6 DF FRAMING AT 16" ON CENTER TYP. RIM. JOIST TO MATCH TYP
	(N) MECHANICAL FIXTURE REFER TO MECHANICAL P
	LIGHTING FIXTURE - REFE TO ELECTRICAL PLANS
NEW FIRST REFLECTED CEILING PLAN - A1 & B 1/4" = 1'-0" 1	NEW LEGEND

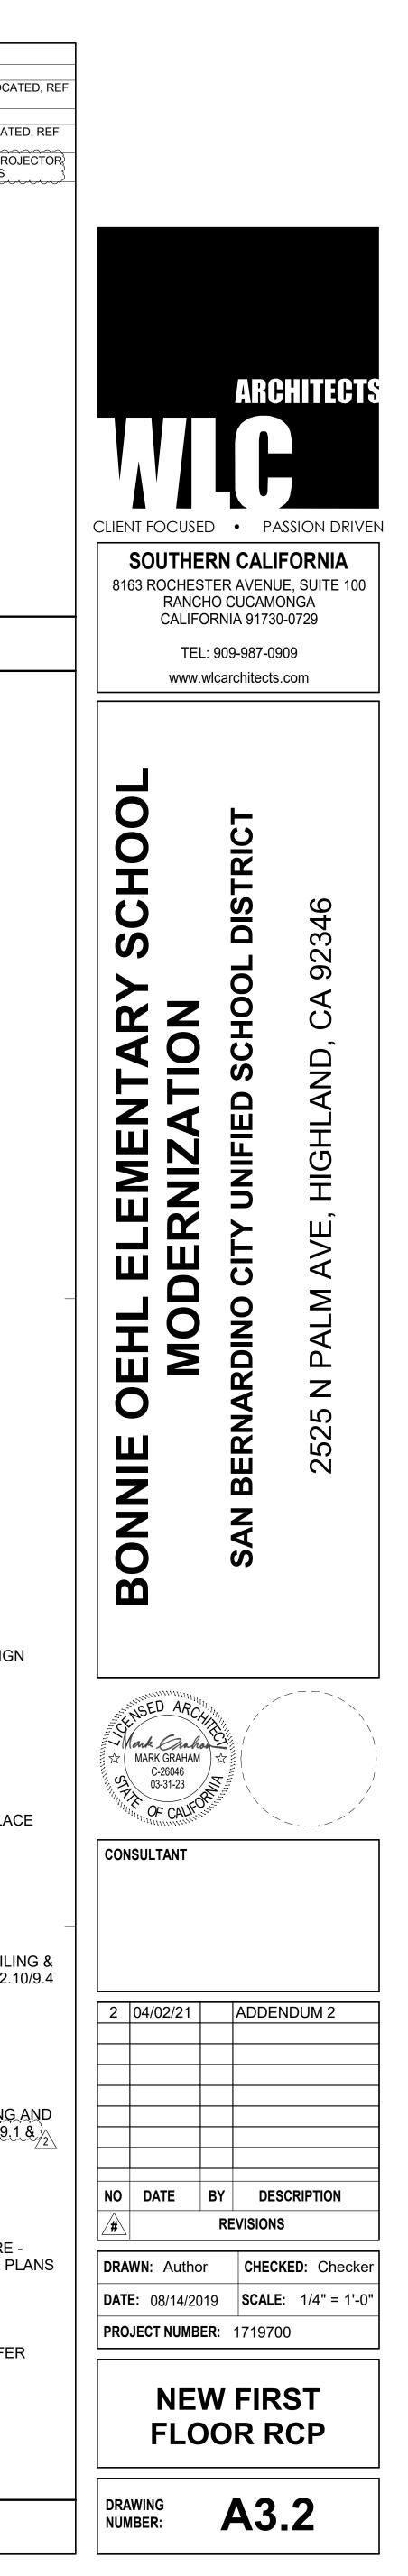


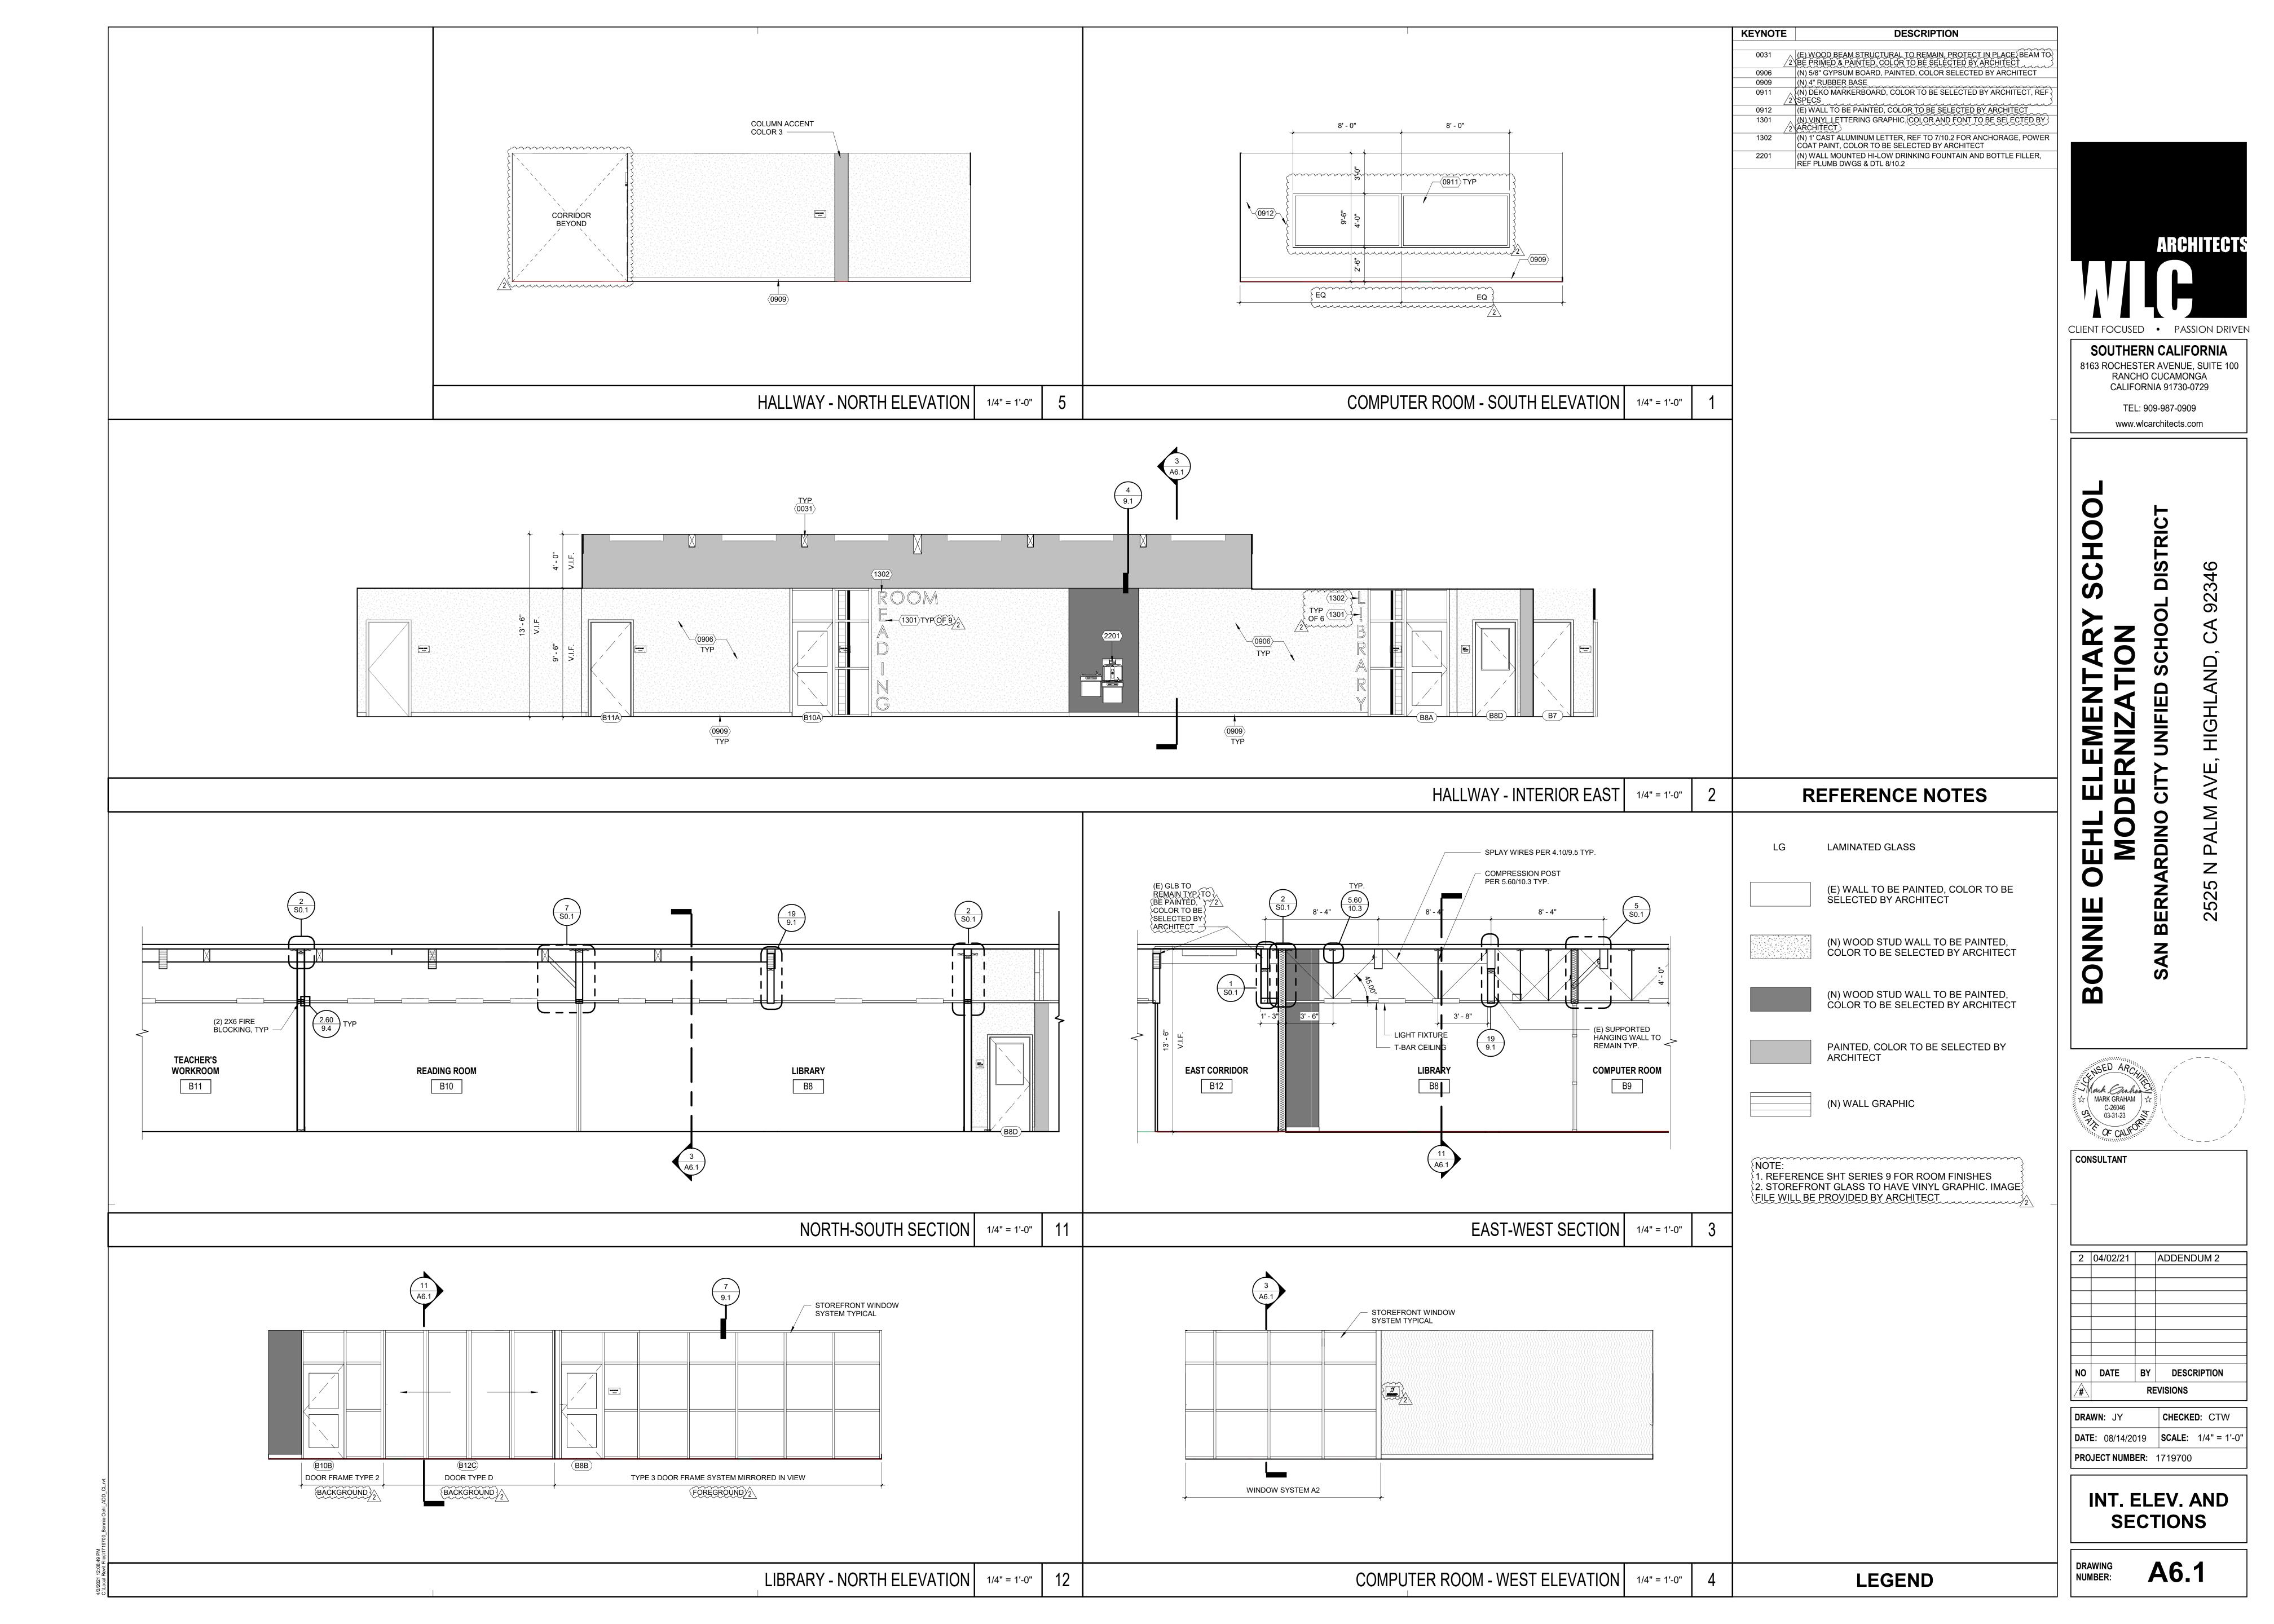


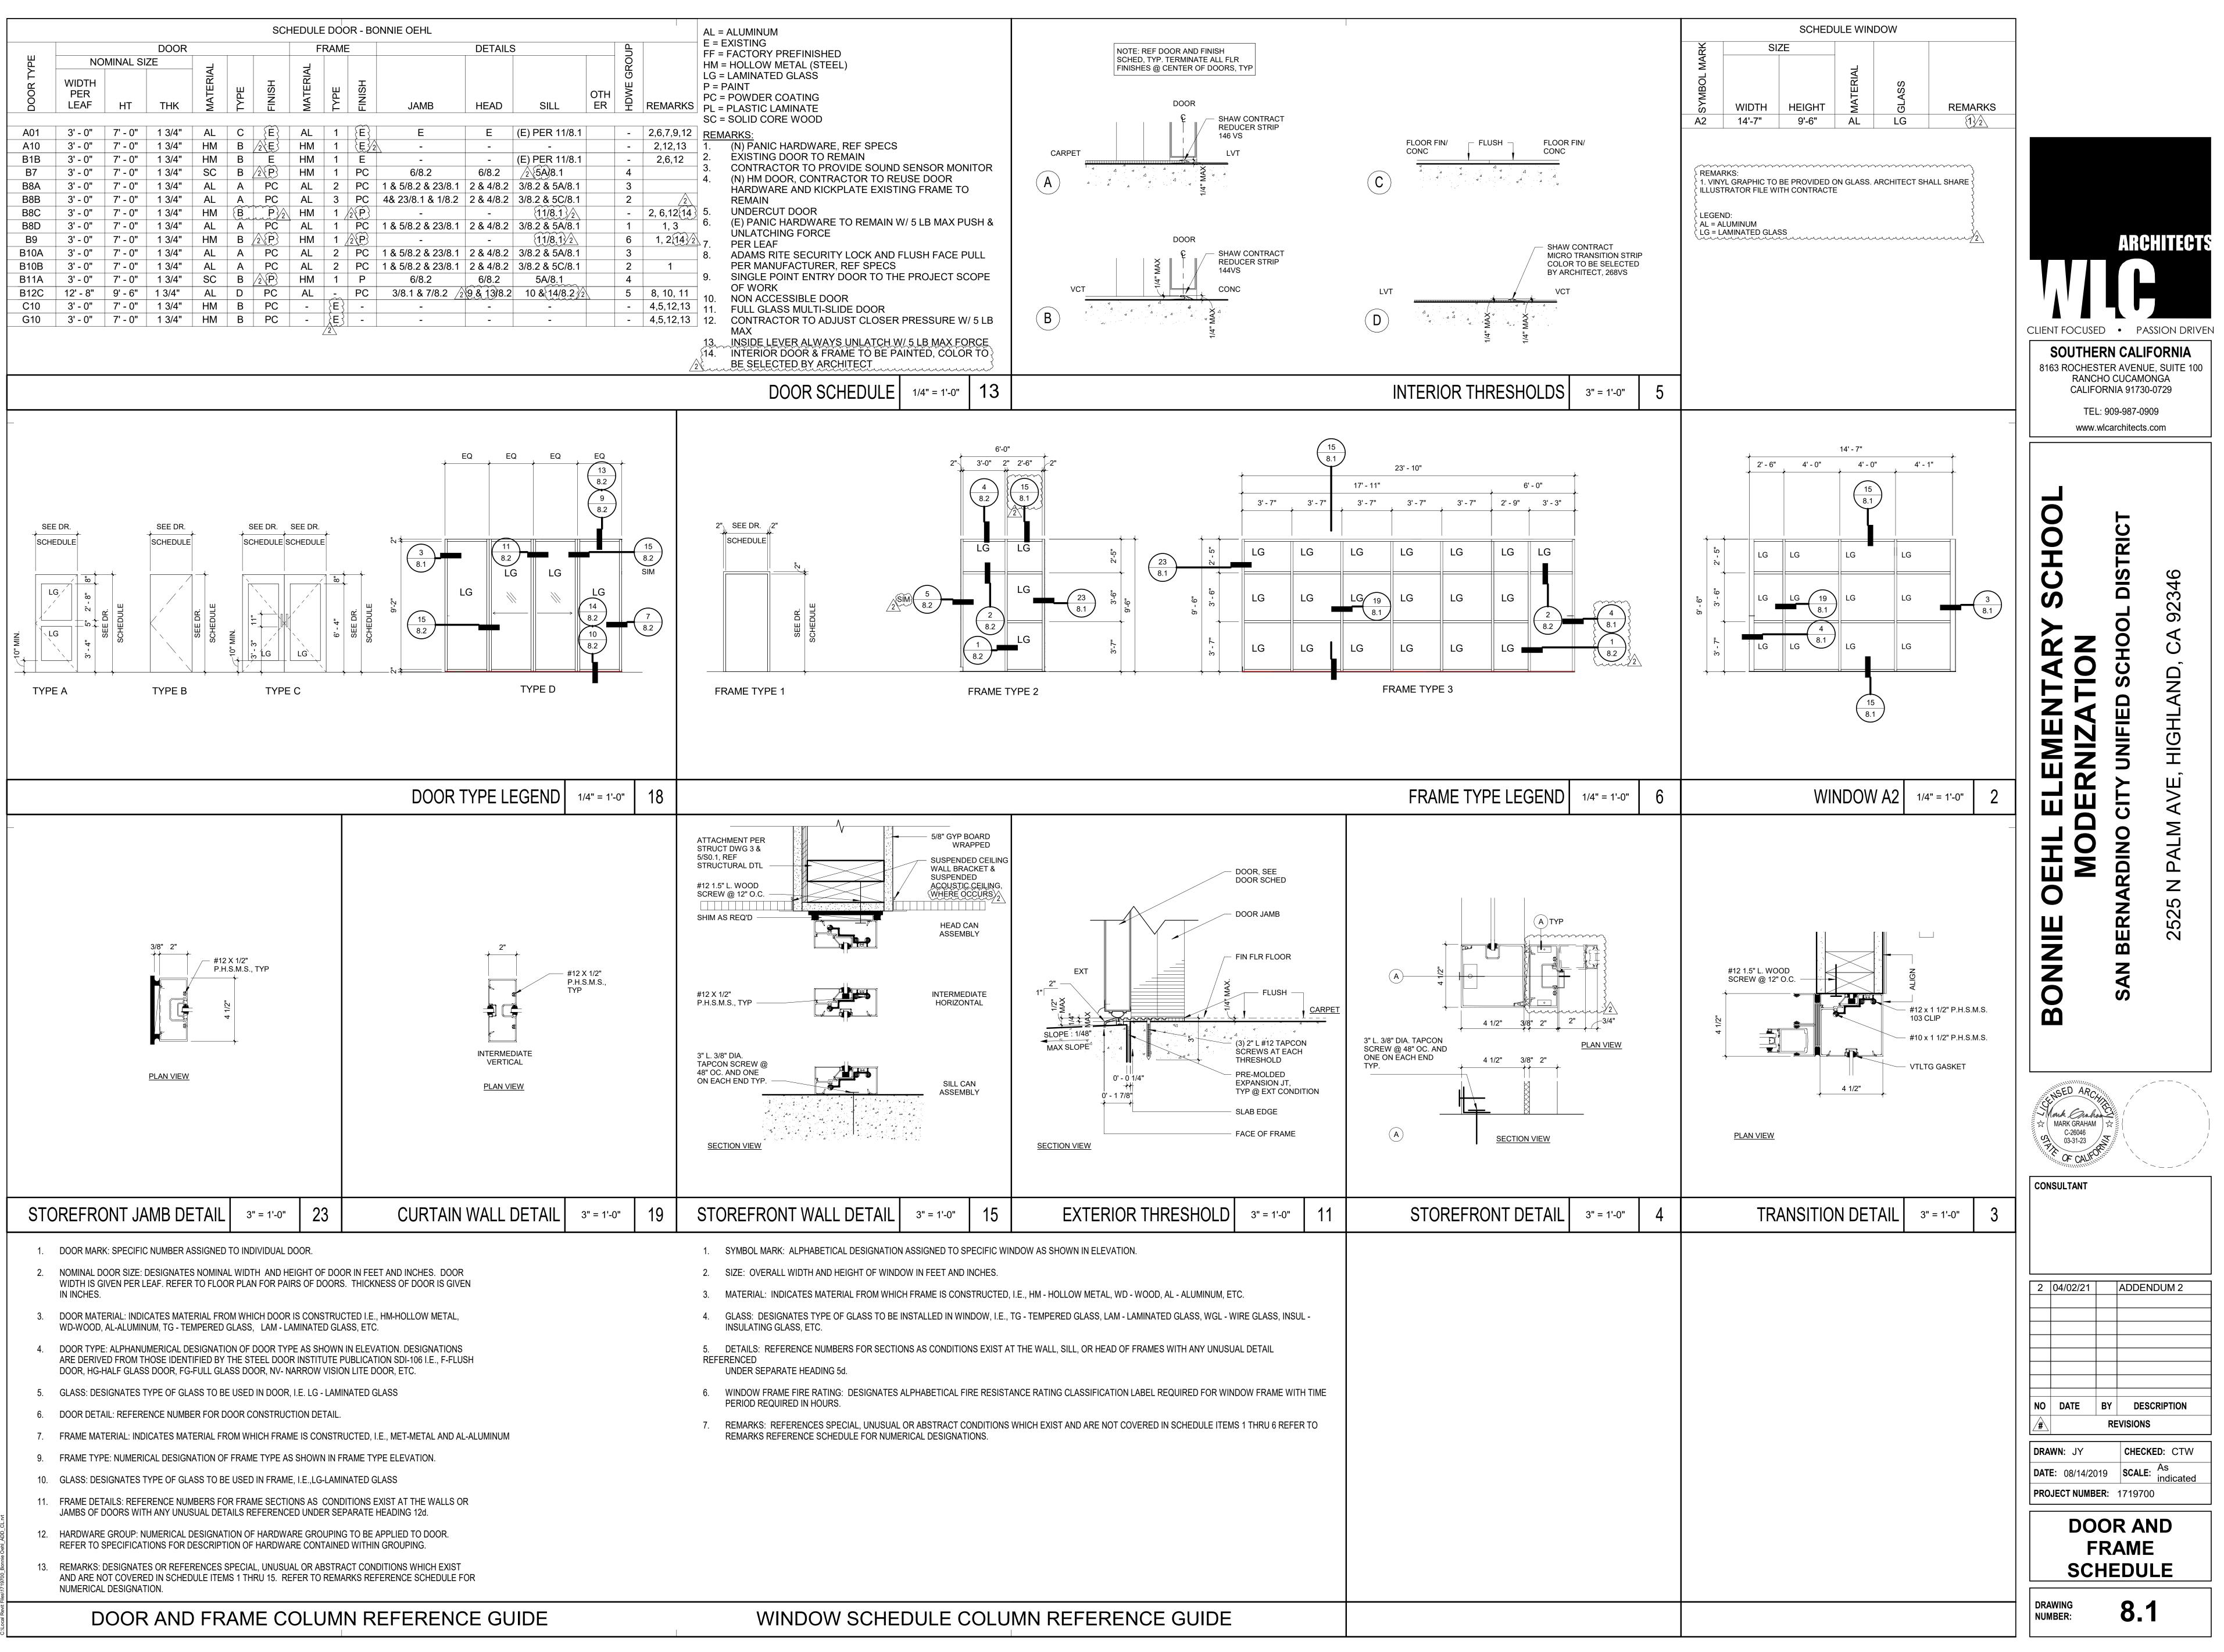



4/2/2021 12:07:43 PM C:\Local Revit Files\1719700_Bonnie Oehl_ADD_CL.rvt	

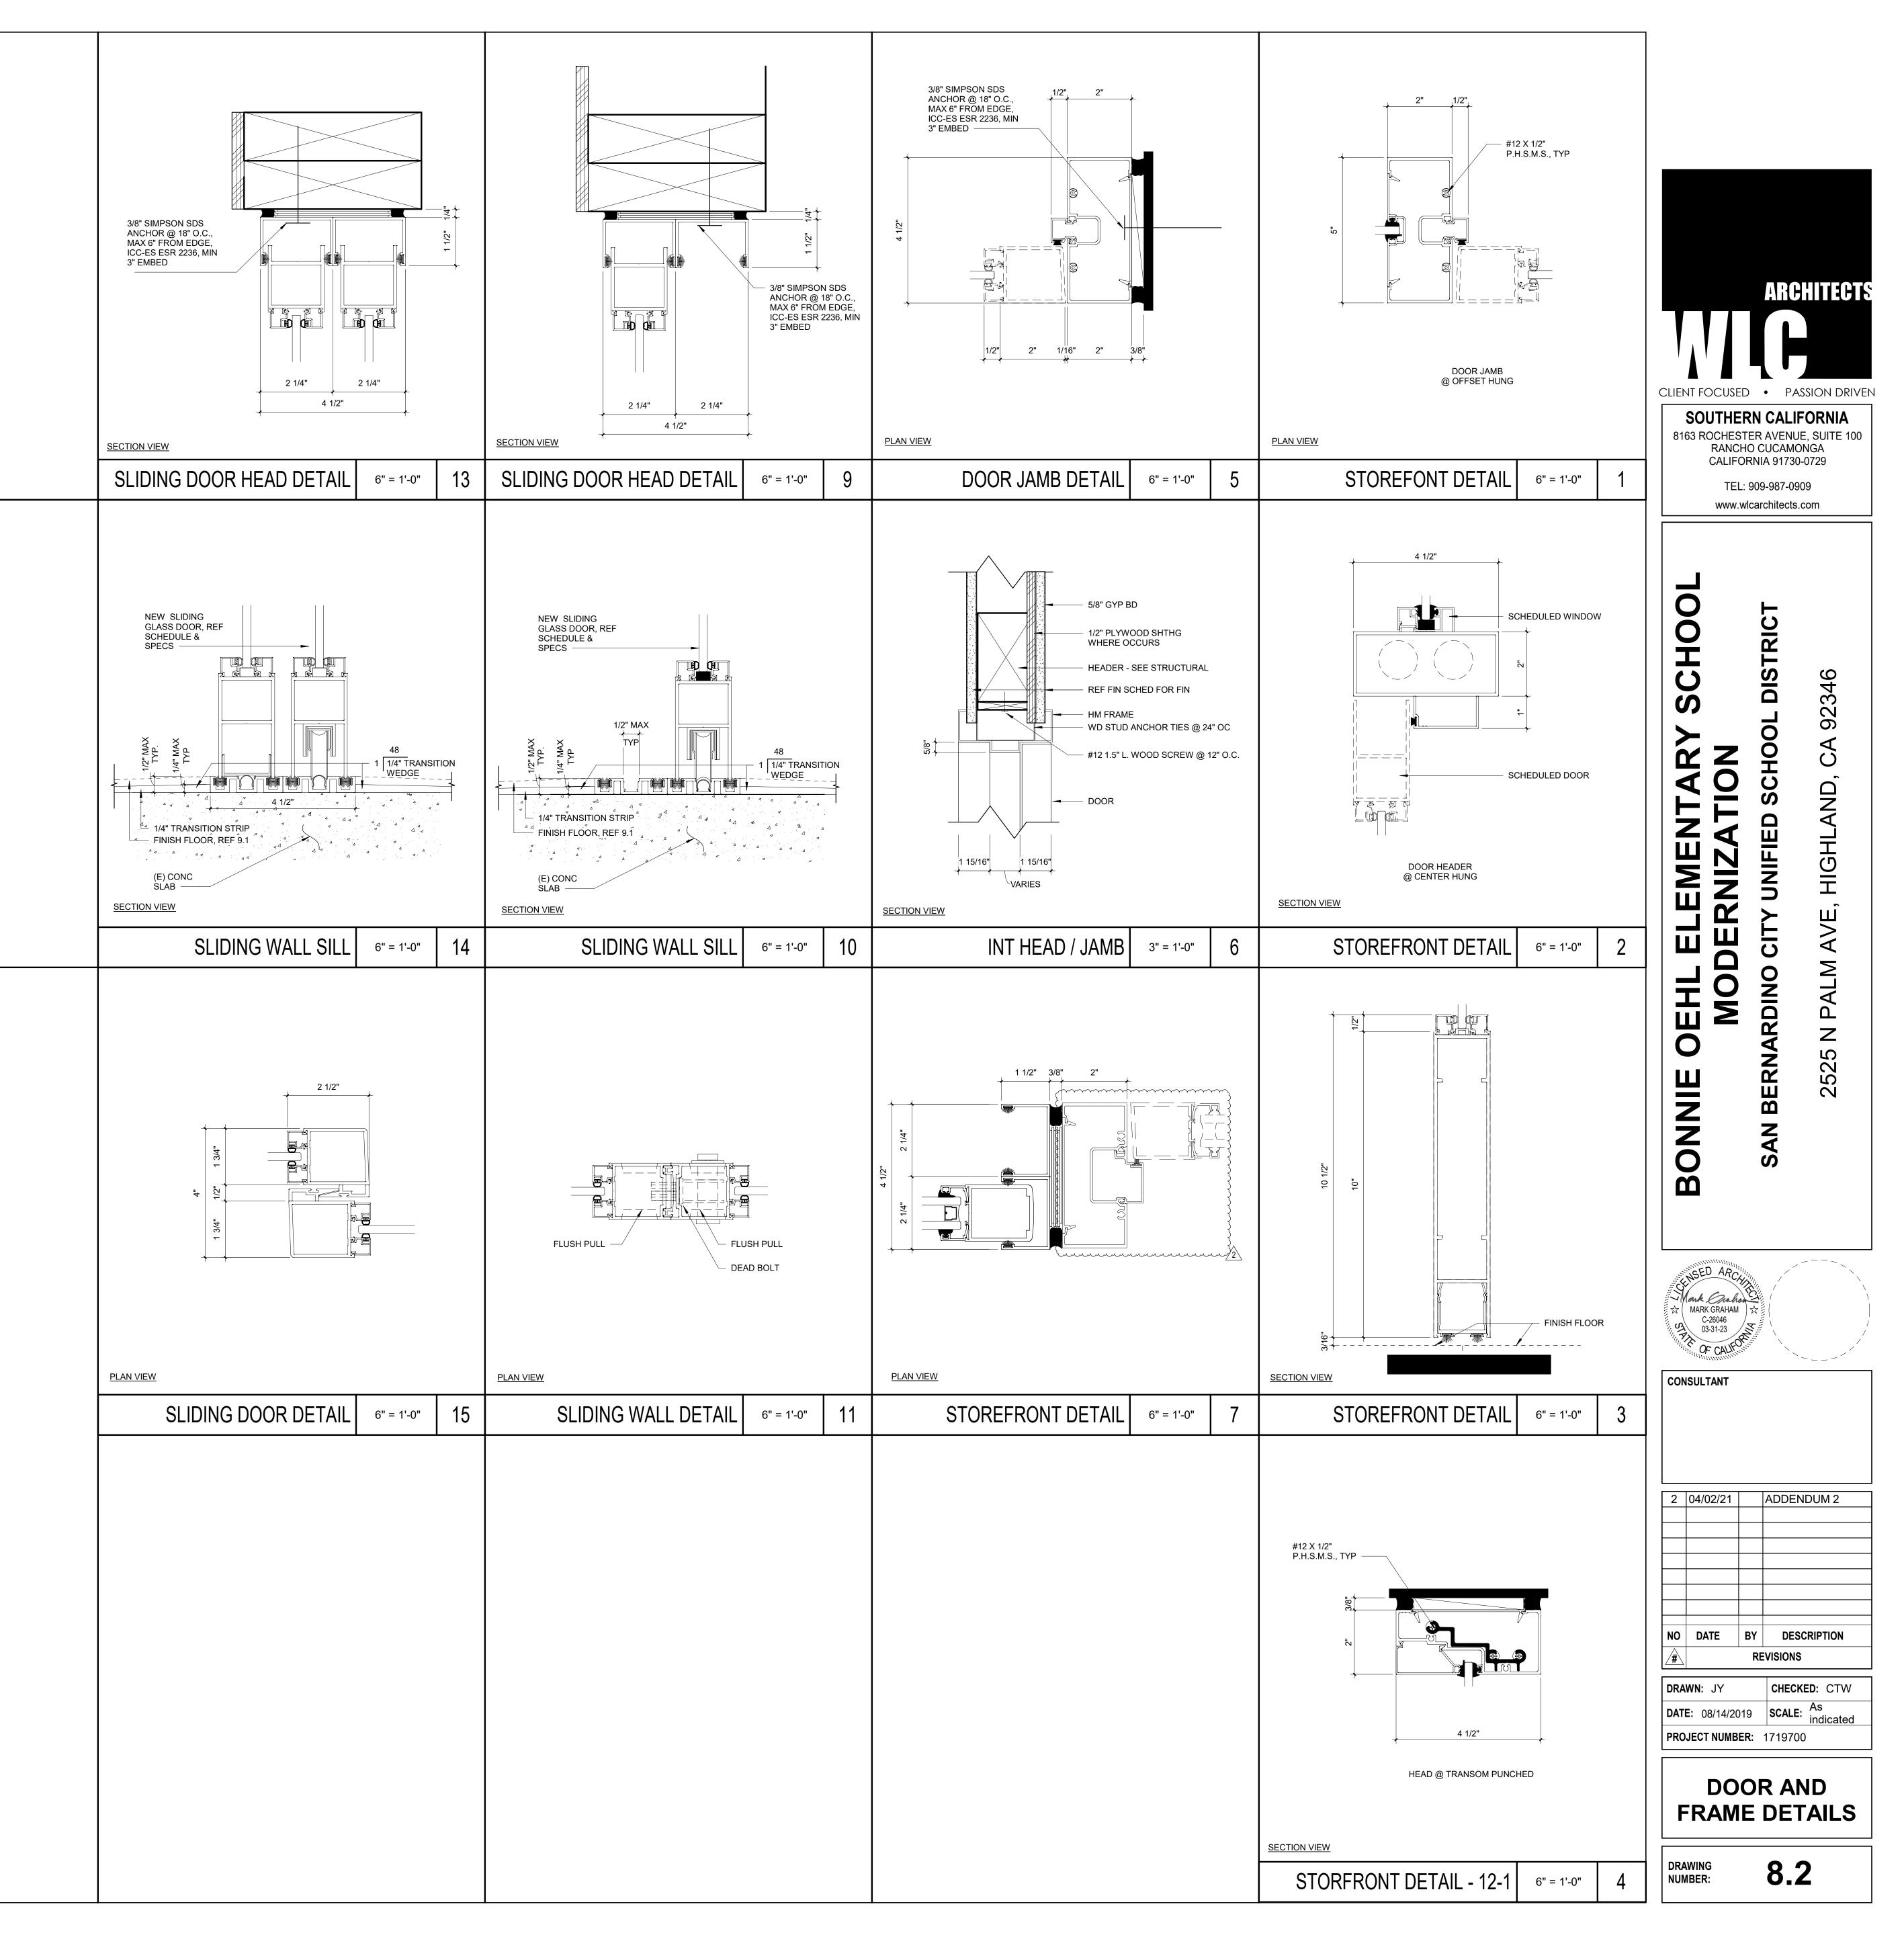

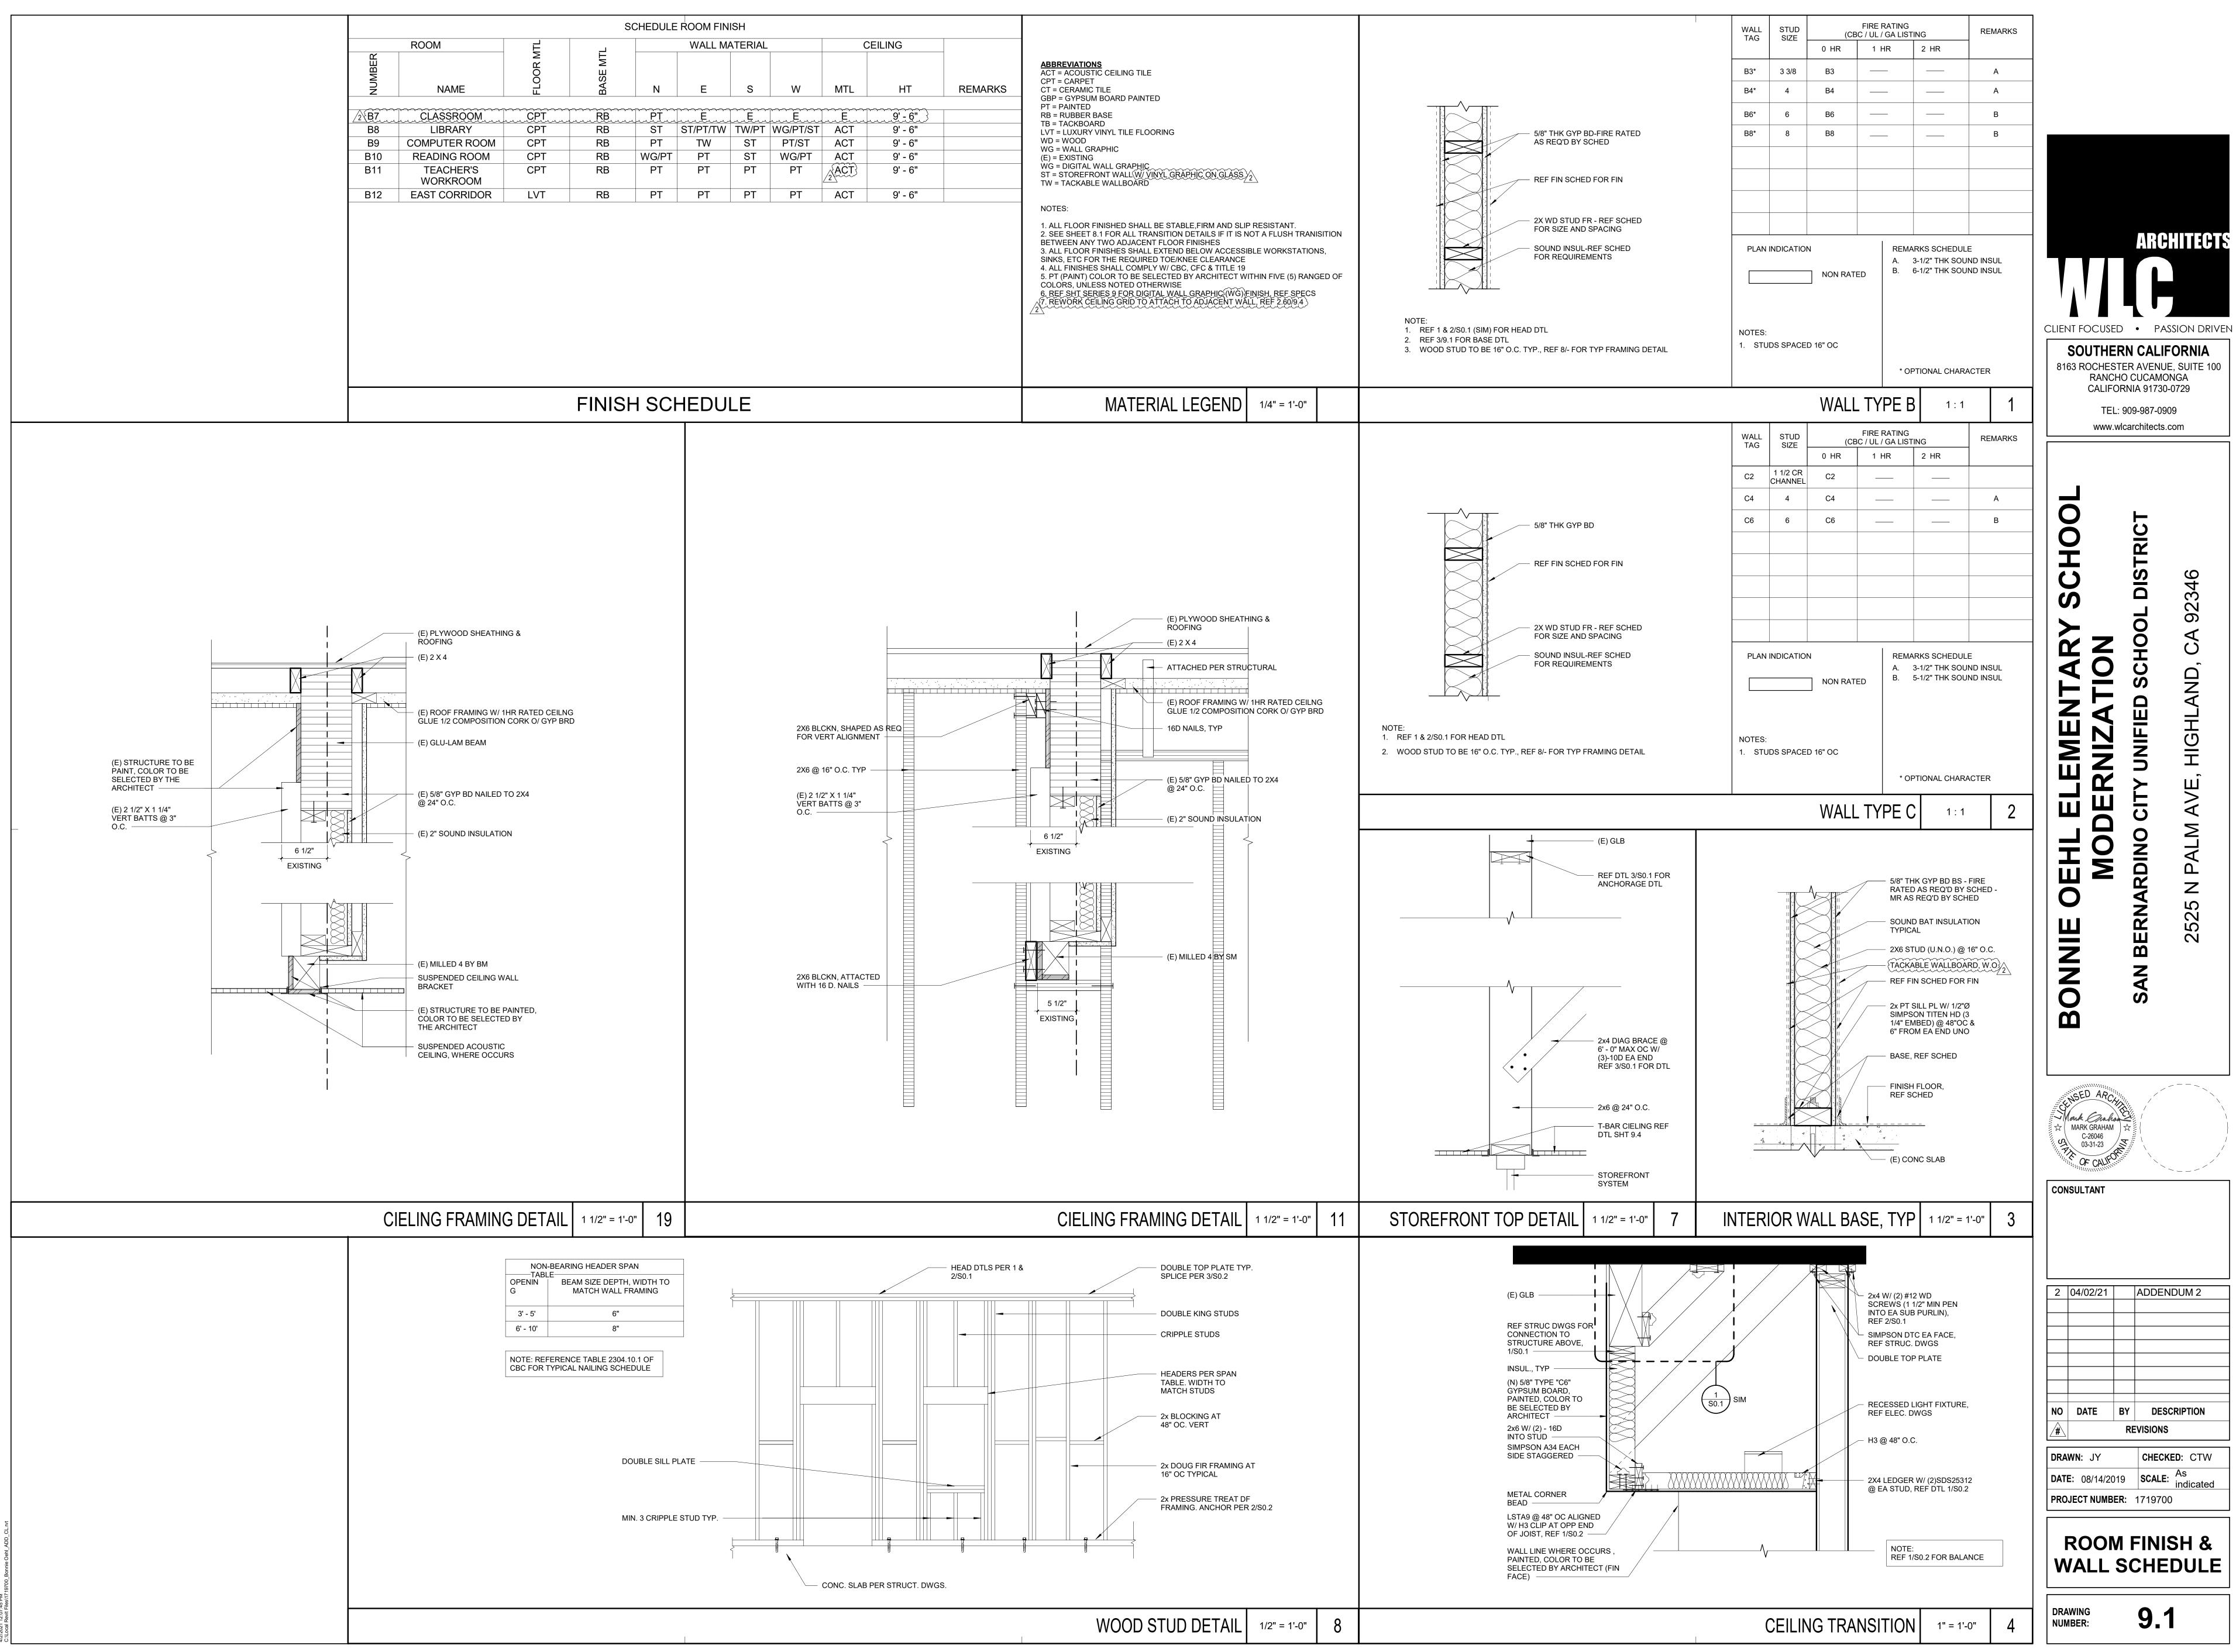

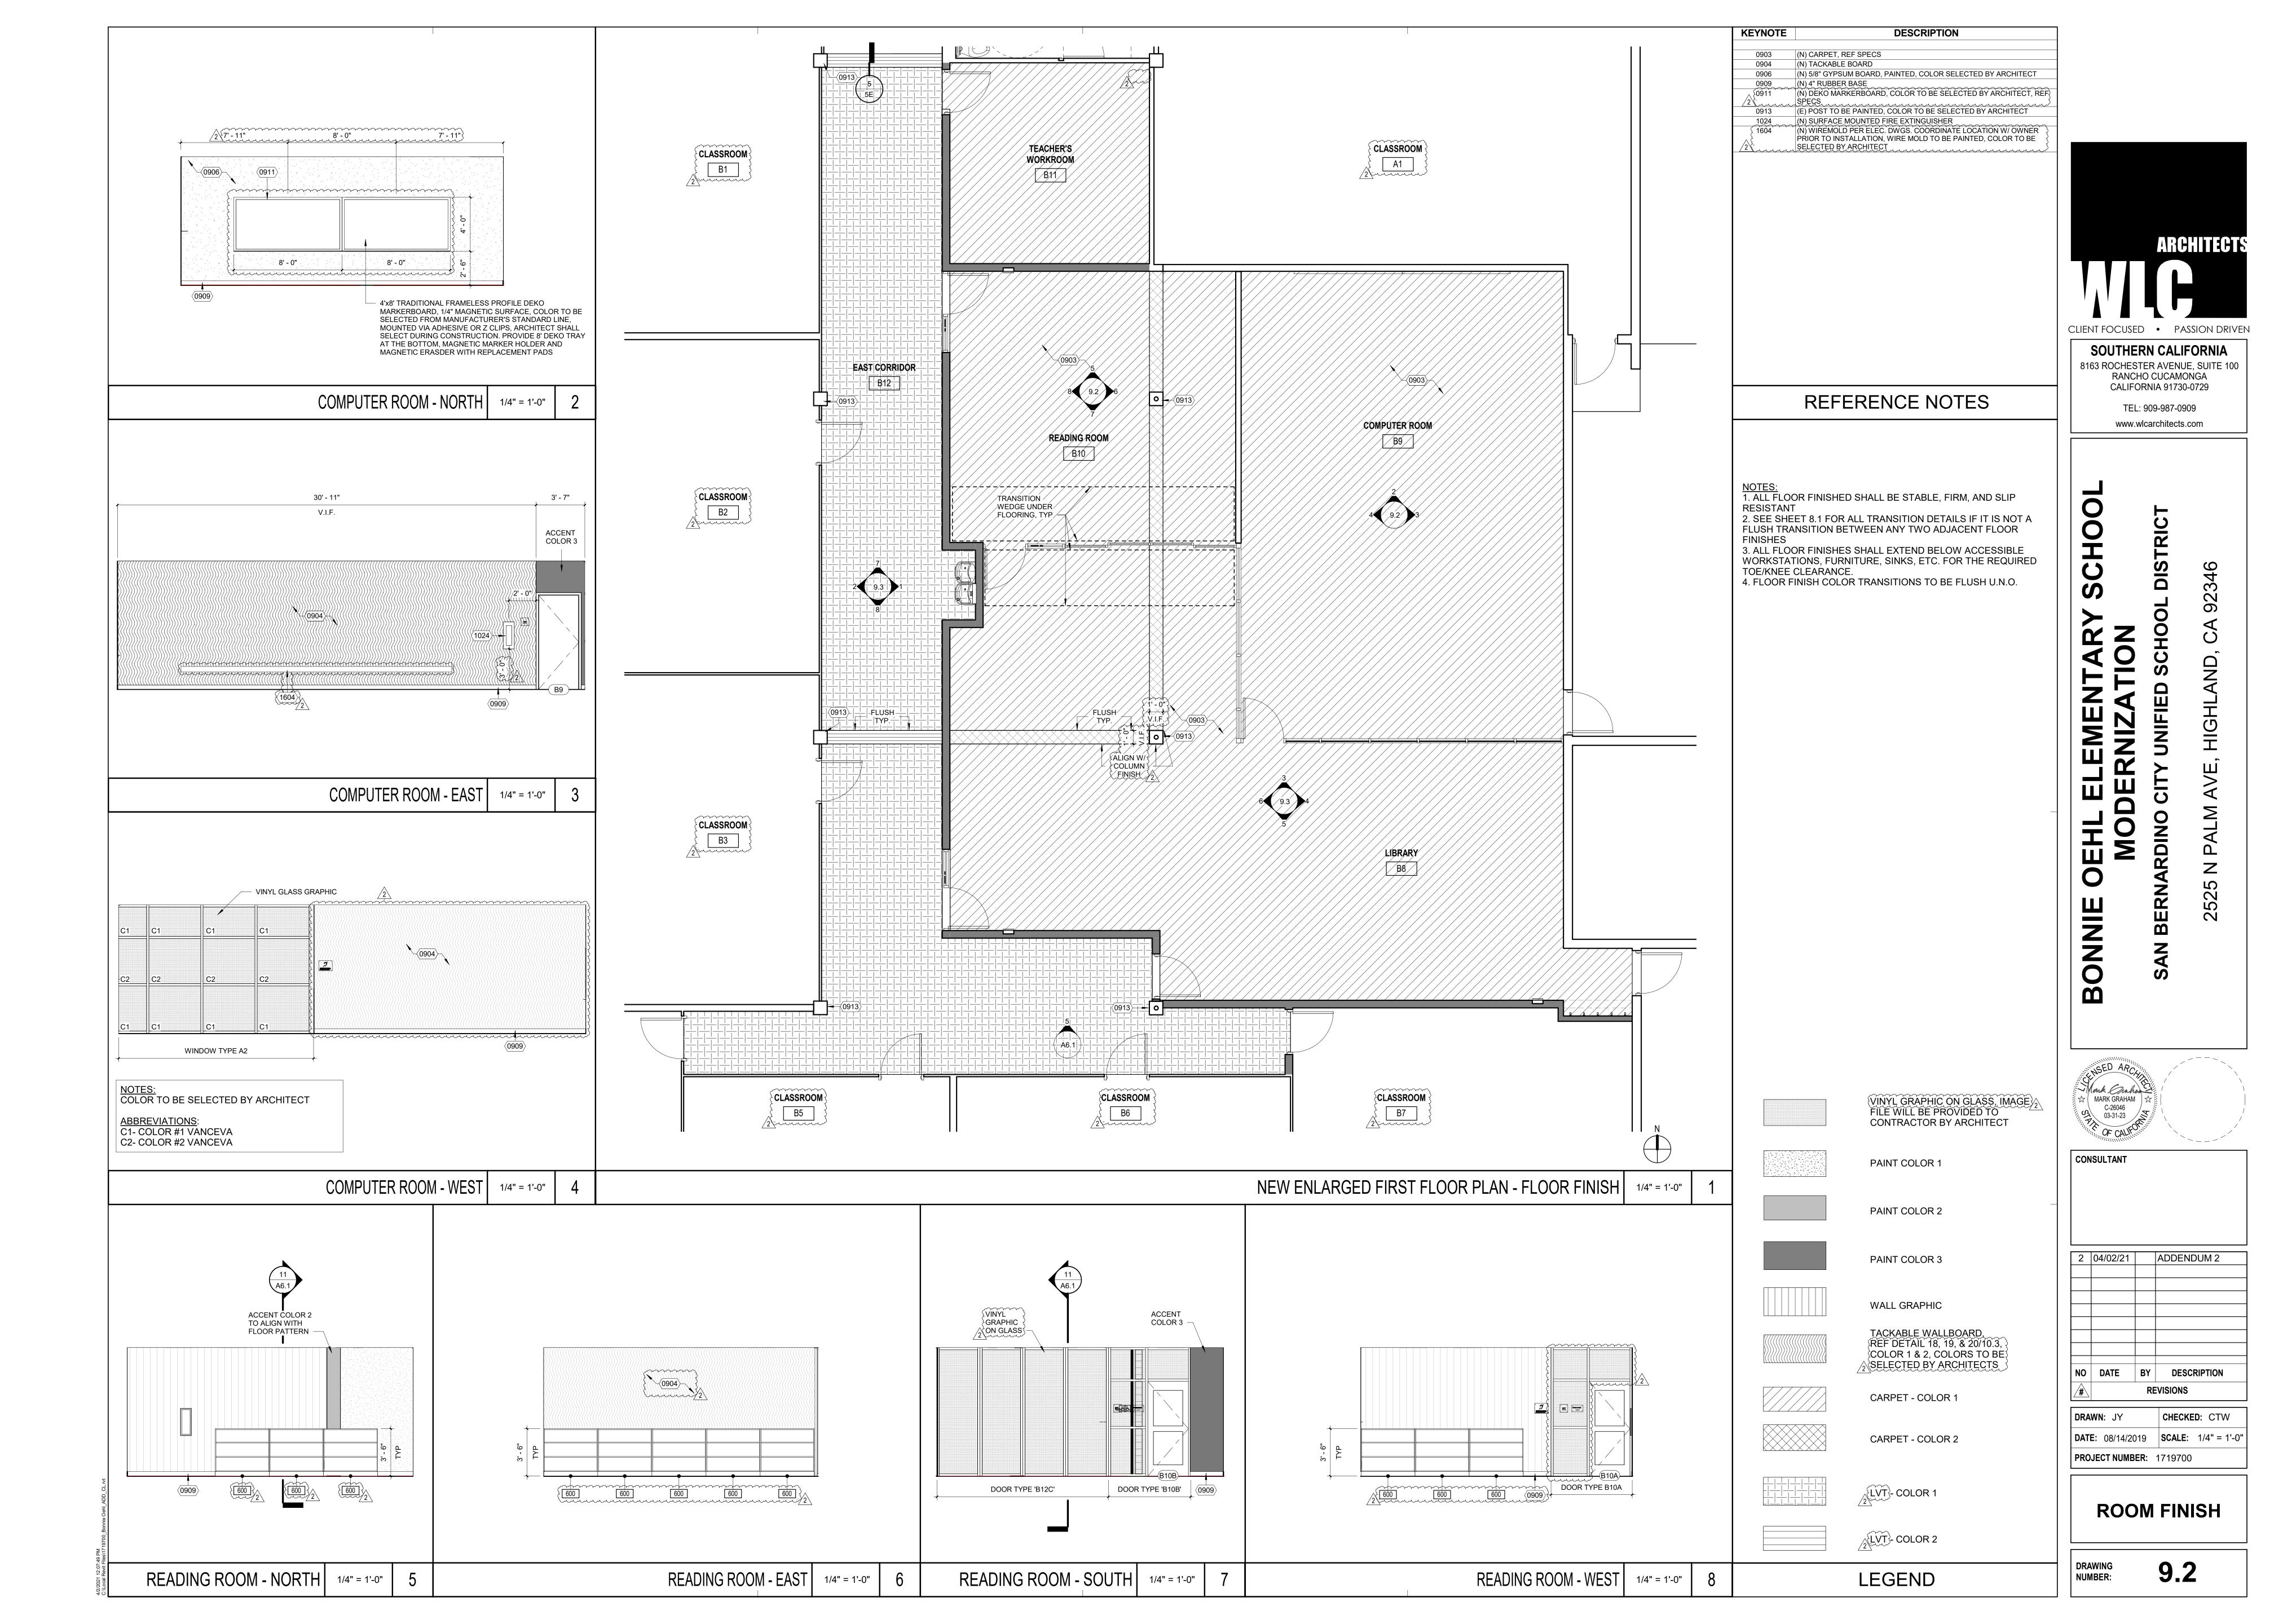

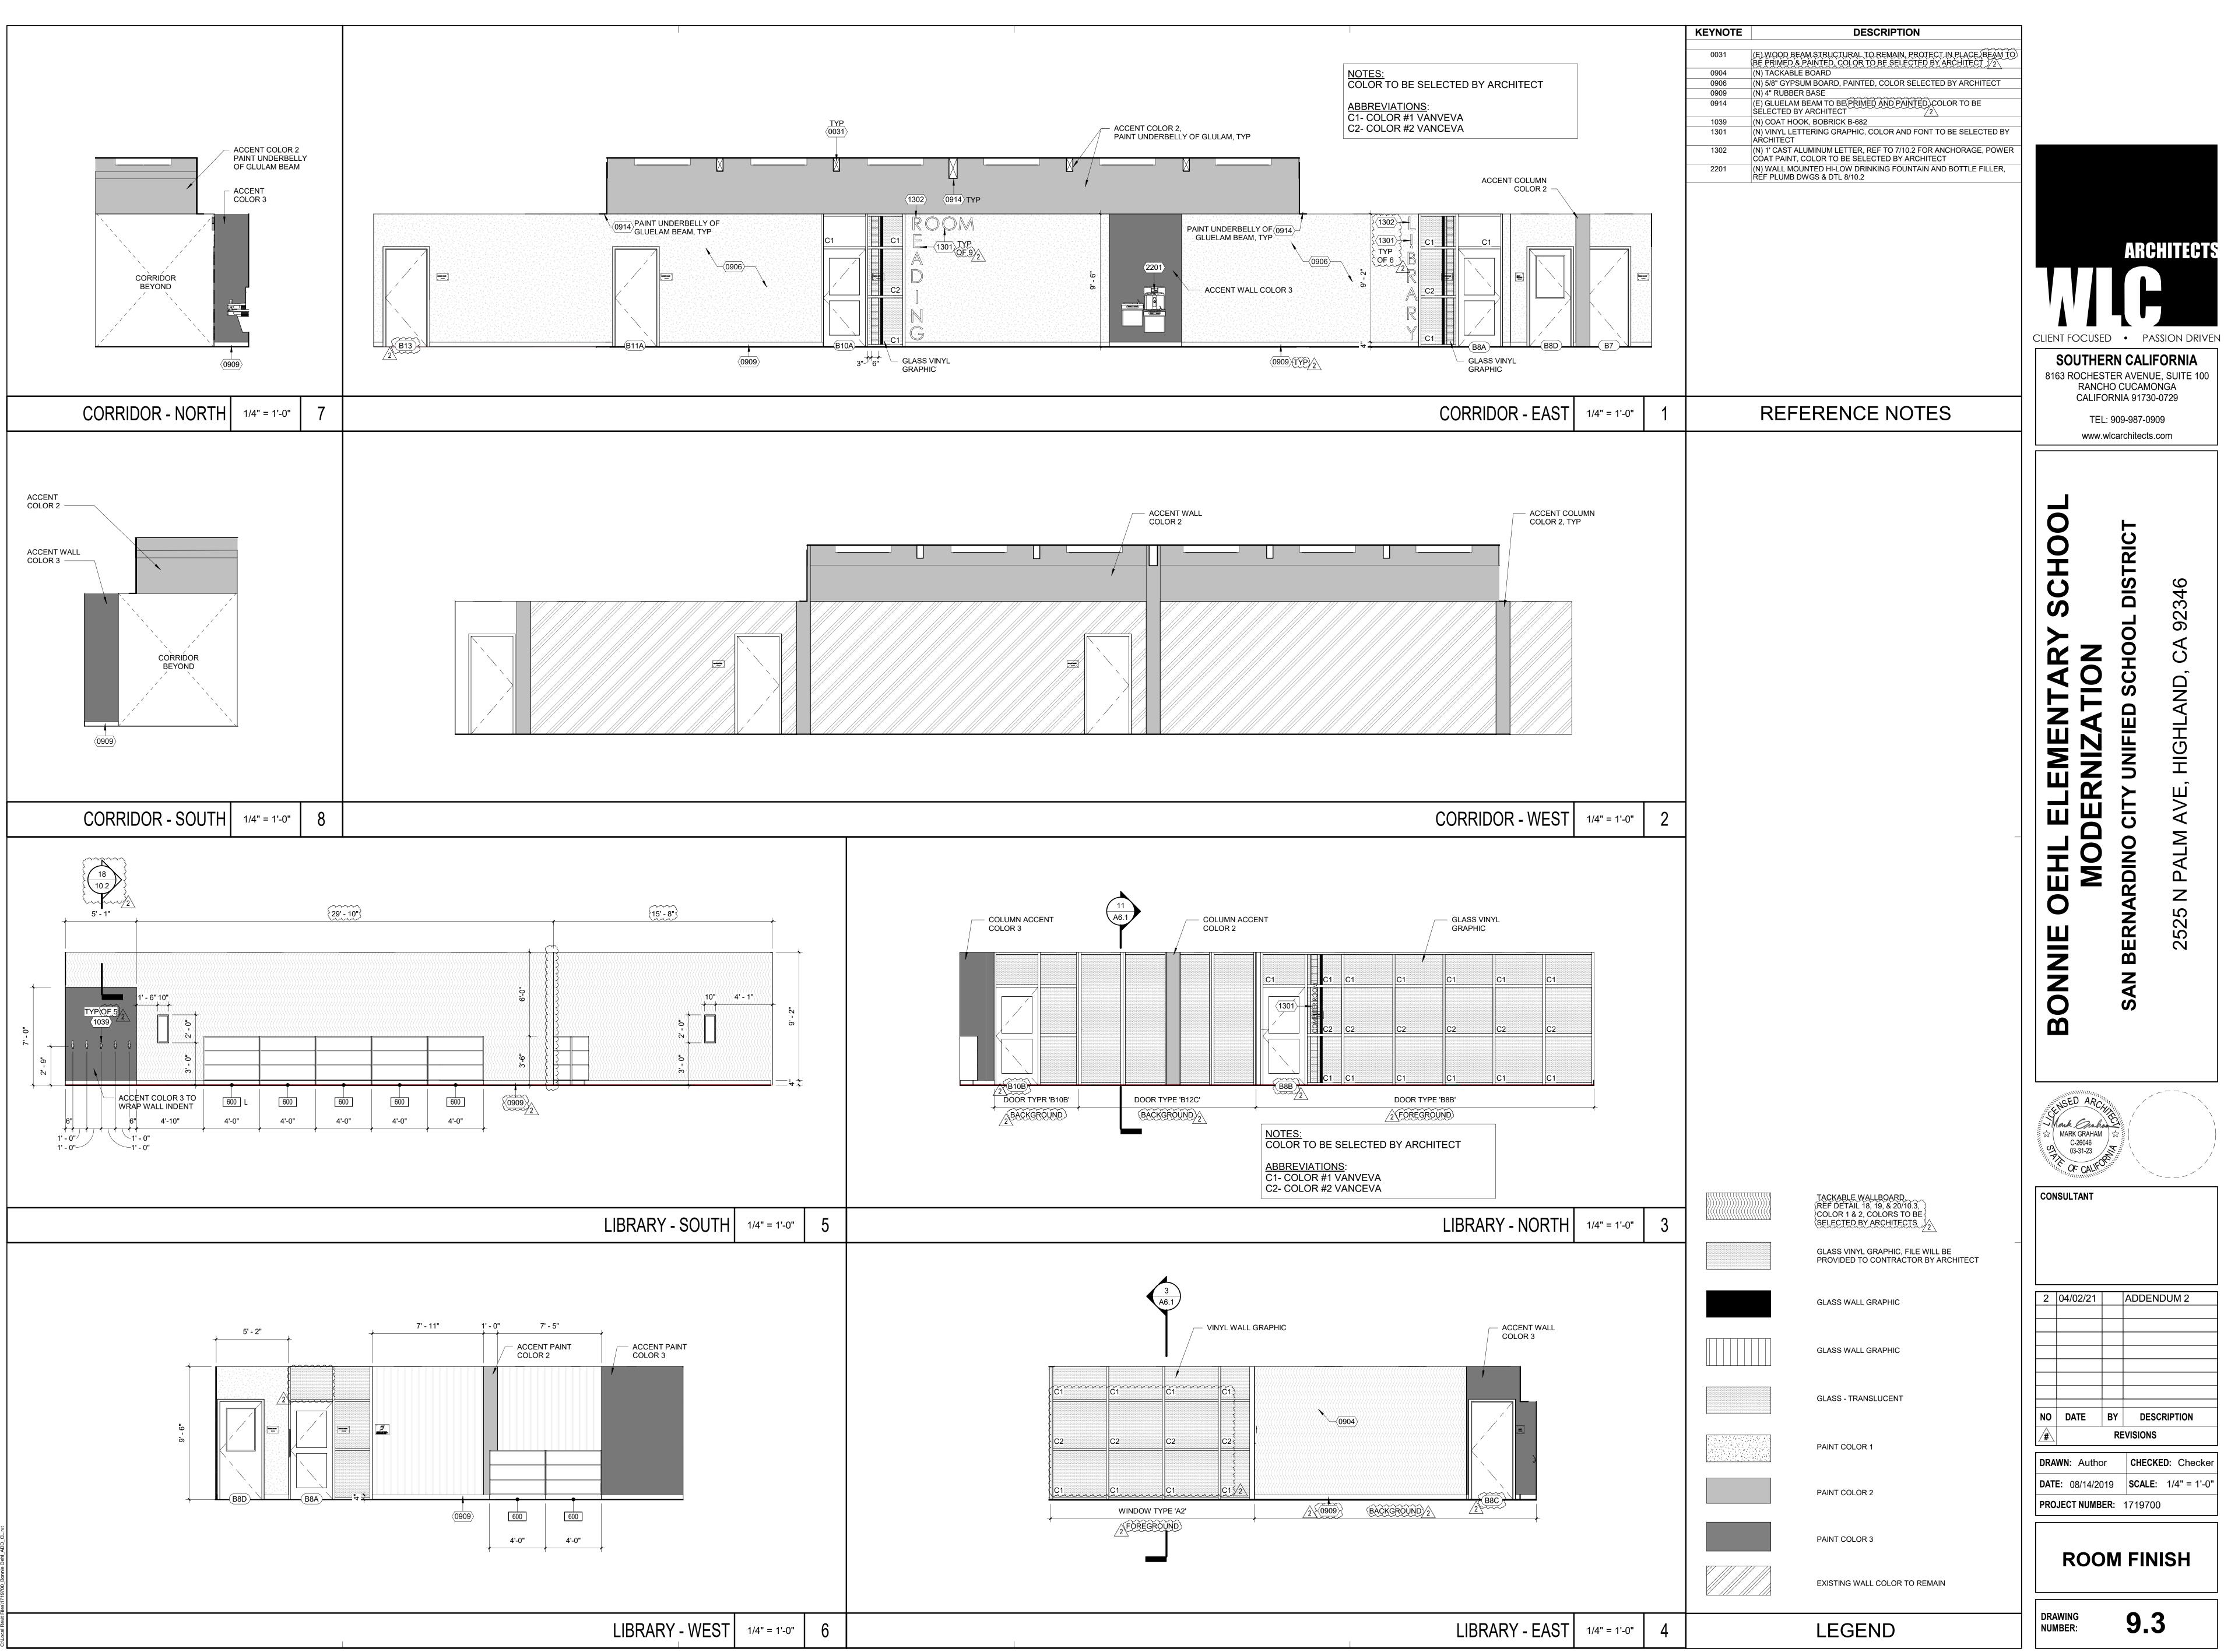

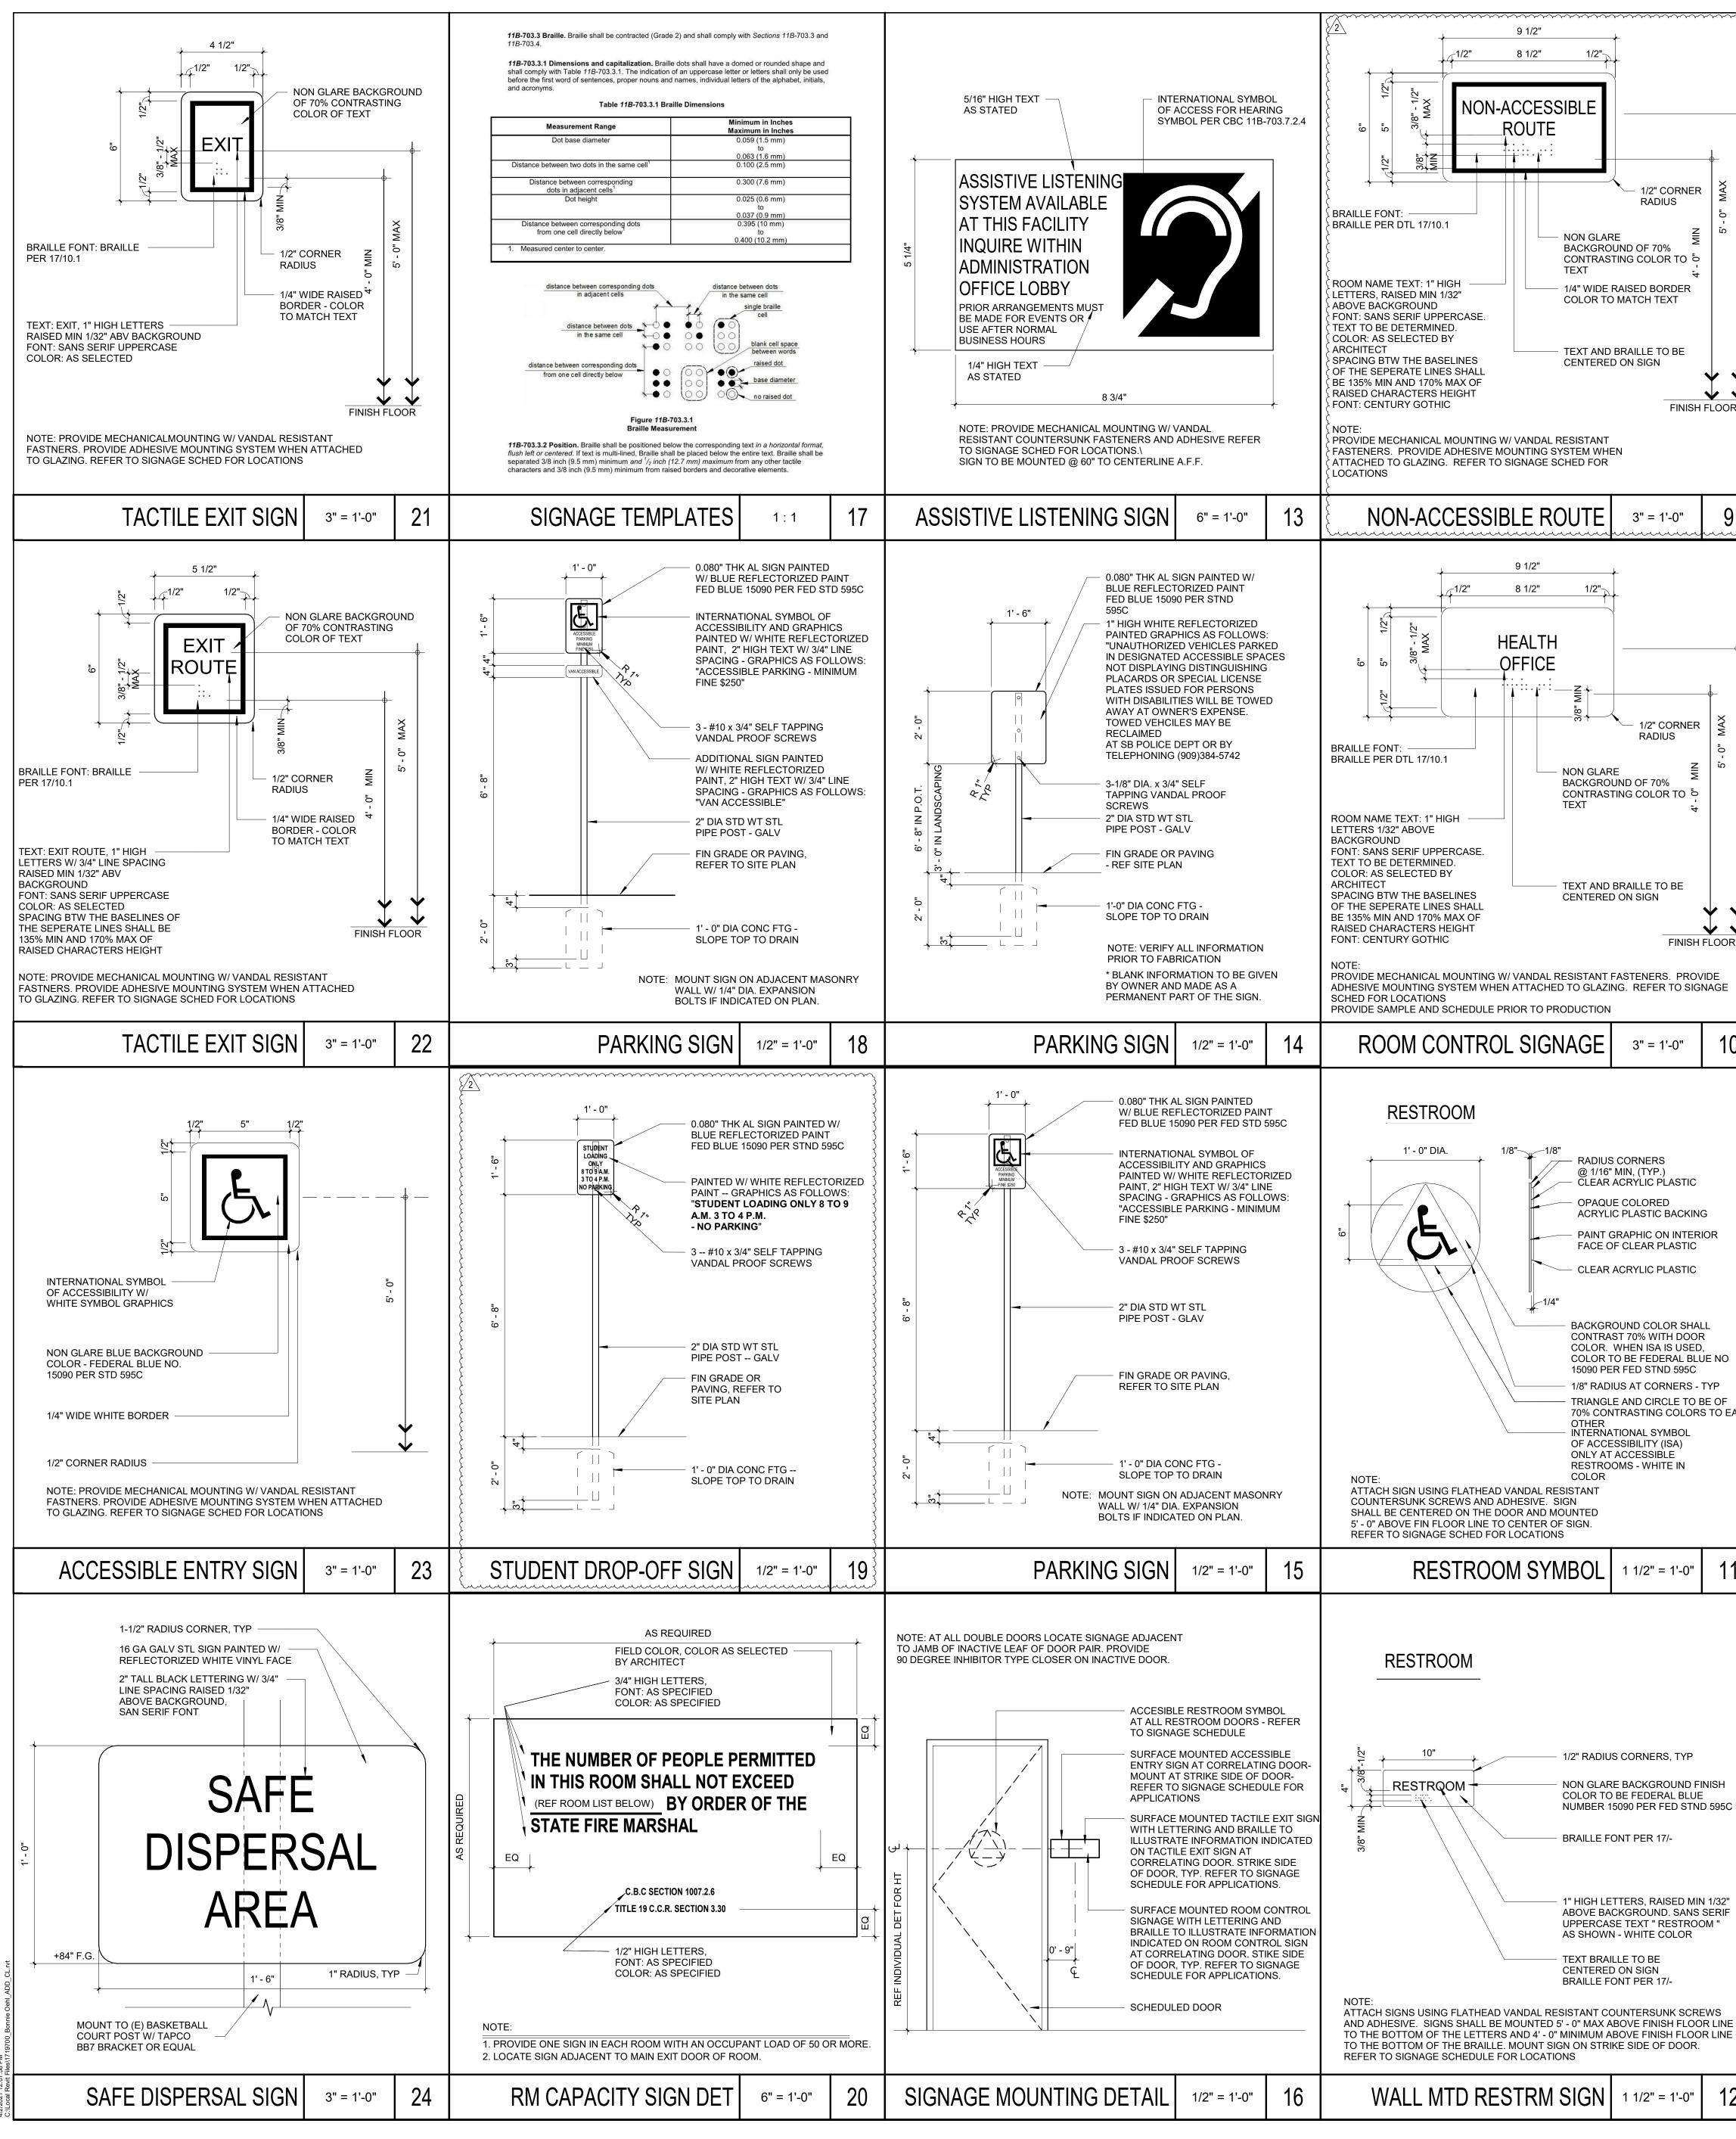

		ç	SIGNAGE S	SCHEDULE	
		ITEM DESCRIPTION	DETAIL	LOCATION	REMAR
	`}-	FEMALE RESTROOM DOOR SYMBOL	3/10.1	ALL FEMALE RESTROOM DOORS	1
		MALE RESTROOM DOOR SYMBOL	7/10.1	ALL MALE RESTROOM DOORS	1
		RESTROOM DOOR SYMBOL	11/10.1	ALL SINGLE USE RESTROOM DOORS	1
RNER X		MALE RESTROOM WALL SIGN	8/10.1	ALL MALE RESTROOMS	1, 2
5 - 0"		FEMALE RESTROOM WALL SIGN	4/10.1	ALL FEMALE RESTROOMS	1, 2
2 MIN		RESTROOM WALL SIGN	12/10.1	ALL SINGLE USE RESTROOMS	1, 2
'4 ER			17/10.1		1
-			21/10.1		1, 2,
E		TACTILE EXIT SIGN (CORRIDOR OR HALLWAY TACTILE EXIT SIGN (HORIZONTAL EXIT)	Y) 22/10.1 23/10.1	AT HORIZONTAL EXIT DOORS	1, 2,
- V	\checkmark	SAFE DISPERSAL SIGN	24/10.1	REFER TO DETAIL FOR LOCATION	-
		ROOM CONTROL SIGNAGE	10/10.1	ALL INTERIOR & EXTERIOR ROOMS	1, 2
		ASSISTIVE LISTENING SIGN	13/10.1	ALL CONFERENCE & ASSEMBLY SPACES	
		GATE ACCESS SIGN	9/10.2	ALL EXTERIOR EXIT GATES	-
		DIRECTIONAL ACCESS SIGN	24/10.1	REFER TO SITE PLAN FOR LOCATIONS	-
)" <u>C</u>) {	ACCESSIBLE PARKING SIGN	4/10.2	ALL ACCESSIBLE AUTO PARKING STALLS	4
un		ACCESSIBLE VAN PARKING SIGN	7/10.2	ALL ACCESSIBLE VAN PARKING STALLS	4
		LOADING ZONE SIGN	15/10.2	ALL BUS DROP OFF & LOADING AREAS	-
	-	ACCESSIBLE PARKING LOT SIGN	16/10.2	ALL ACCESSIBLE PARKING LOT ENTRIES	-
	, -	ACCESSIBLE SYMBOL	11/10.2	ALL ACCESSIBLE PARKING STALLS	-
	_ _ 	ROOM CAPACITY SIGN	20/10.1	REFER TO DETAIL FOR ROOM LOCATIONS	-
 	-	STUDENT DROP OFF SIGN	2 19/10.1	REFER TO DETAIL FOR ROOM LOCATIONS	
	-	NON-ACCESSIBLE ROUTE	2,9/10.1	REFER TO DETAIL FOR ROOM LOCATIONS	6 1,2
NISH FLOOF PROVIDE D SIGNAGE					
)" 1	0				
		MEN/BOYS		WOMEN/GIRLS	
				 1/8"1/8"	
STIC			CRYLIC PLASTIC		AR ACRYLIC PLASTIC
CKING			COLORED		QUE COLORED YLIC PLASTIC BACKIN
NTERIOR STIC			PLASTIC BACKING		
STIC			RAPHIC ON R FACE OF CLEAR		RIOR FACE OF CLEAR STIC
		@ 1/16" M	CORNERS /IN, (TYP.)	@ 1/	US CORNERS 16" MIN, (TYP.)
SHALL DOOR			ADIUS AT CORNERS - TYP GROUND COLOR	S	
		SHALL			ACKGROUND COLOR HALL CONTRAST 70%
USED, AL BLUE NO 595C			CONTRAST 70% DOOR COLOR. WHEN	W C	HALL CONTRAST 70% ITH DOOR COLOR. HEN ISA IS USED, DLOR TO BE FEDERAI
USED, AL BLUE NO		ISA IS FEDEF		W C B S	HALL CONTRAST 70% ITH DOOR COLOR. HEN ISA IS USED, DLOR TO BE FEDERAI LUE NO 15090 PER FE IND 595C
USED, NL BLUE NO 595C ERS - TYP E TO BE OF DLORS TO E		ISA IS FEDEF PER F INTER	DOOR COLOR. WHEN USED, COLOR TO BE RAL BLUE NO 15090	W C B B S S I N O	HALL CONTRAST 70% ITH DOOR COLOR. HEN ISA IS USED, DLOR TO BE FEDERAI LUE NO 15090 PER FE
USED, S95C ERS - TYP TO BE OF DLORS TO E OL		ISA IS FEDEF PER F INTER ACCES ACCES NOTE:	DOOR COLOR. WHEN USED, COLOR TO BE RAL BLUE NO 15090 ED STND 595C NATIONAL SYMBOL OF	W C B B S S N O O R	HALL CONTRAST 70% ITH DOOR COLOR. HEN ISA IS USED, DLOR TO BE FEDERAI LUE NO 15090 PER FEI FND 595C TERNATIONAL SYMBO F ACCESSIBILITY (ISA)
USED, SED, S95C ERS - TYP TO BE OF DLORS TO E		ISA IS FEDEF PER F INTER ACCES ACCES	DOOR COLOR. WHEN USED, COLOR TO BE RAL BLUE NO 15090 ED STND 595C NATIONAL SYMBOL OF SSIBILITY (ISA) ONLY AT SSIBLE RESTROOMS -	W C B S N O O R C	HALL CONTRAST 70% ITH DOOR COLOR. HEN ISA IS USED, DLOR TO BE FEDERAI LUE NO 15090 PER FEI IND 595C TERNATIONAL SYMBO F ACCESSIBILITY (ISA) NLY AT ACCESSIBLE ESTROOMS - WHITE IN
USED, S95C ERS - TYP TO BE OF DLORS TO E OL	ËĂ	ISA IS FEDEF PER F NOTE: ATTACH SIGN USING THREE FLATHEAD VANDAL RESISTANT COUNTERSUNK SCREWS AND ADHESIVE. SIGN SHALL BE CENTERED ON THE DOOR AND MOUNTED 5' - 0" ABOVE FIN FLOOR LINE TO CENTER OF SIGN. REFER TO SIGNAGE SCHED FOR LOCATIONS	DOOR COLOR. WHEN USED, COLOR TO BE RAL BLUE NO 15090 ED STND 595C NATIONAL SYMBOL OF SSIBILITY (ISA) ONLY AT SSIBLE RESTROOMS -	NOTE: ATTACH SIGN USING THREE FLATHEAD VANDAL RESISTANT COUNTERSUNK SCREWS AND ADHESIVE. 








3/8

NOTE: ATTACH SIGNS USING FLATHEAD VANDAL RESISTANT COUNTERSUNK ATTACH SIGNS USING FLATHEAD VANDAL RESISTANT COUNTERSUNK SCREWS SCREWS AND ADHESIVE. SIGNS SHALL BE MOUNTED 5' - 0" MAX ABOVE AND ADHESIVE. SIGNS SHALL BE MOUNTED 5' - 0" MAX ABOVE FINISH FLOOR FINISH FLOOR LINE TO THE BOTTOM OF THE LETTERS AND 4' - 0" MINIMUM LINE TO THE BOTTOM OF THE LETTERS AND 4' - 0" MINIMUM ABOVE FINISH ABOVE FINISH FLOOR LINE TO THE BOTTOM OF THE BRAILLE. MOUNT SIGN FLOOR LINE TO THE BOTTOM OF THE BRAILLE. MOUNT SIGN ON STRIKE SIDE OF ON STRIKE SIDE OF DOOR. REFER TO SIGNAGE SCHEDULE FOR LOCATIONS. DOOR. REFER TO SIGNAGE SCHEDULE FOR LOCATIONS. WALL MTD RESTRM SIGN 1 1/2" = 1'-0" 4 WALL MTD RESTRM SIGN 1 1/2" = 1'-0" 8 12

UPPERCASE TEXT "WOMEN OR

GIRLS" AS SELECTED -- WHITE


BRAILLE FONT PER 17/-

TEXT AND BRAILLE TO BE

CENTERED ON SIGN

COLOR

3/8". 3/8"

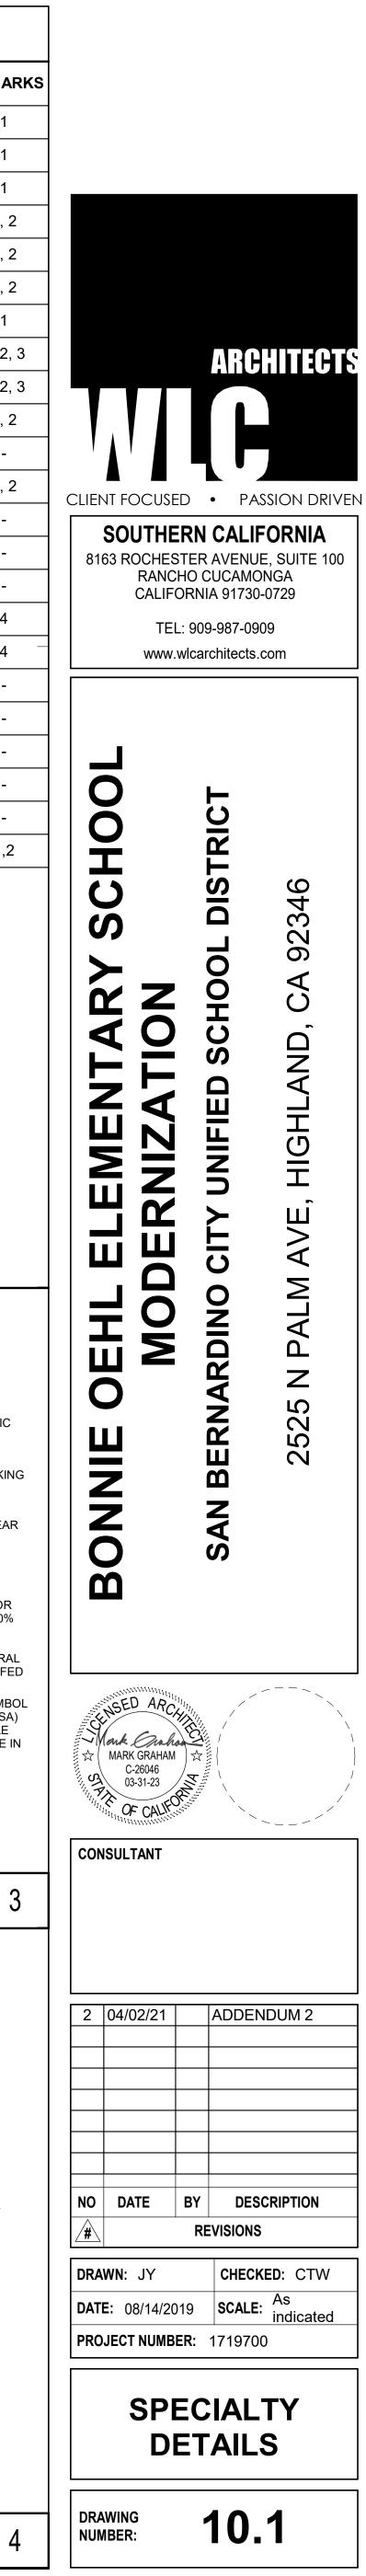


GIRLS" AS SELECTED -- WHITE


BRAILLE FONT PER 17/-

TEXT AND BRAILLE TO BE


CENTERED ON SIGN


COLOR

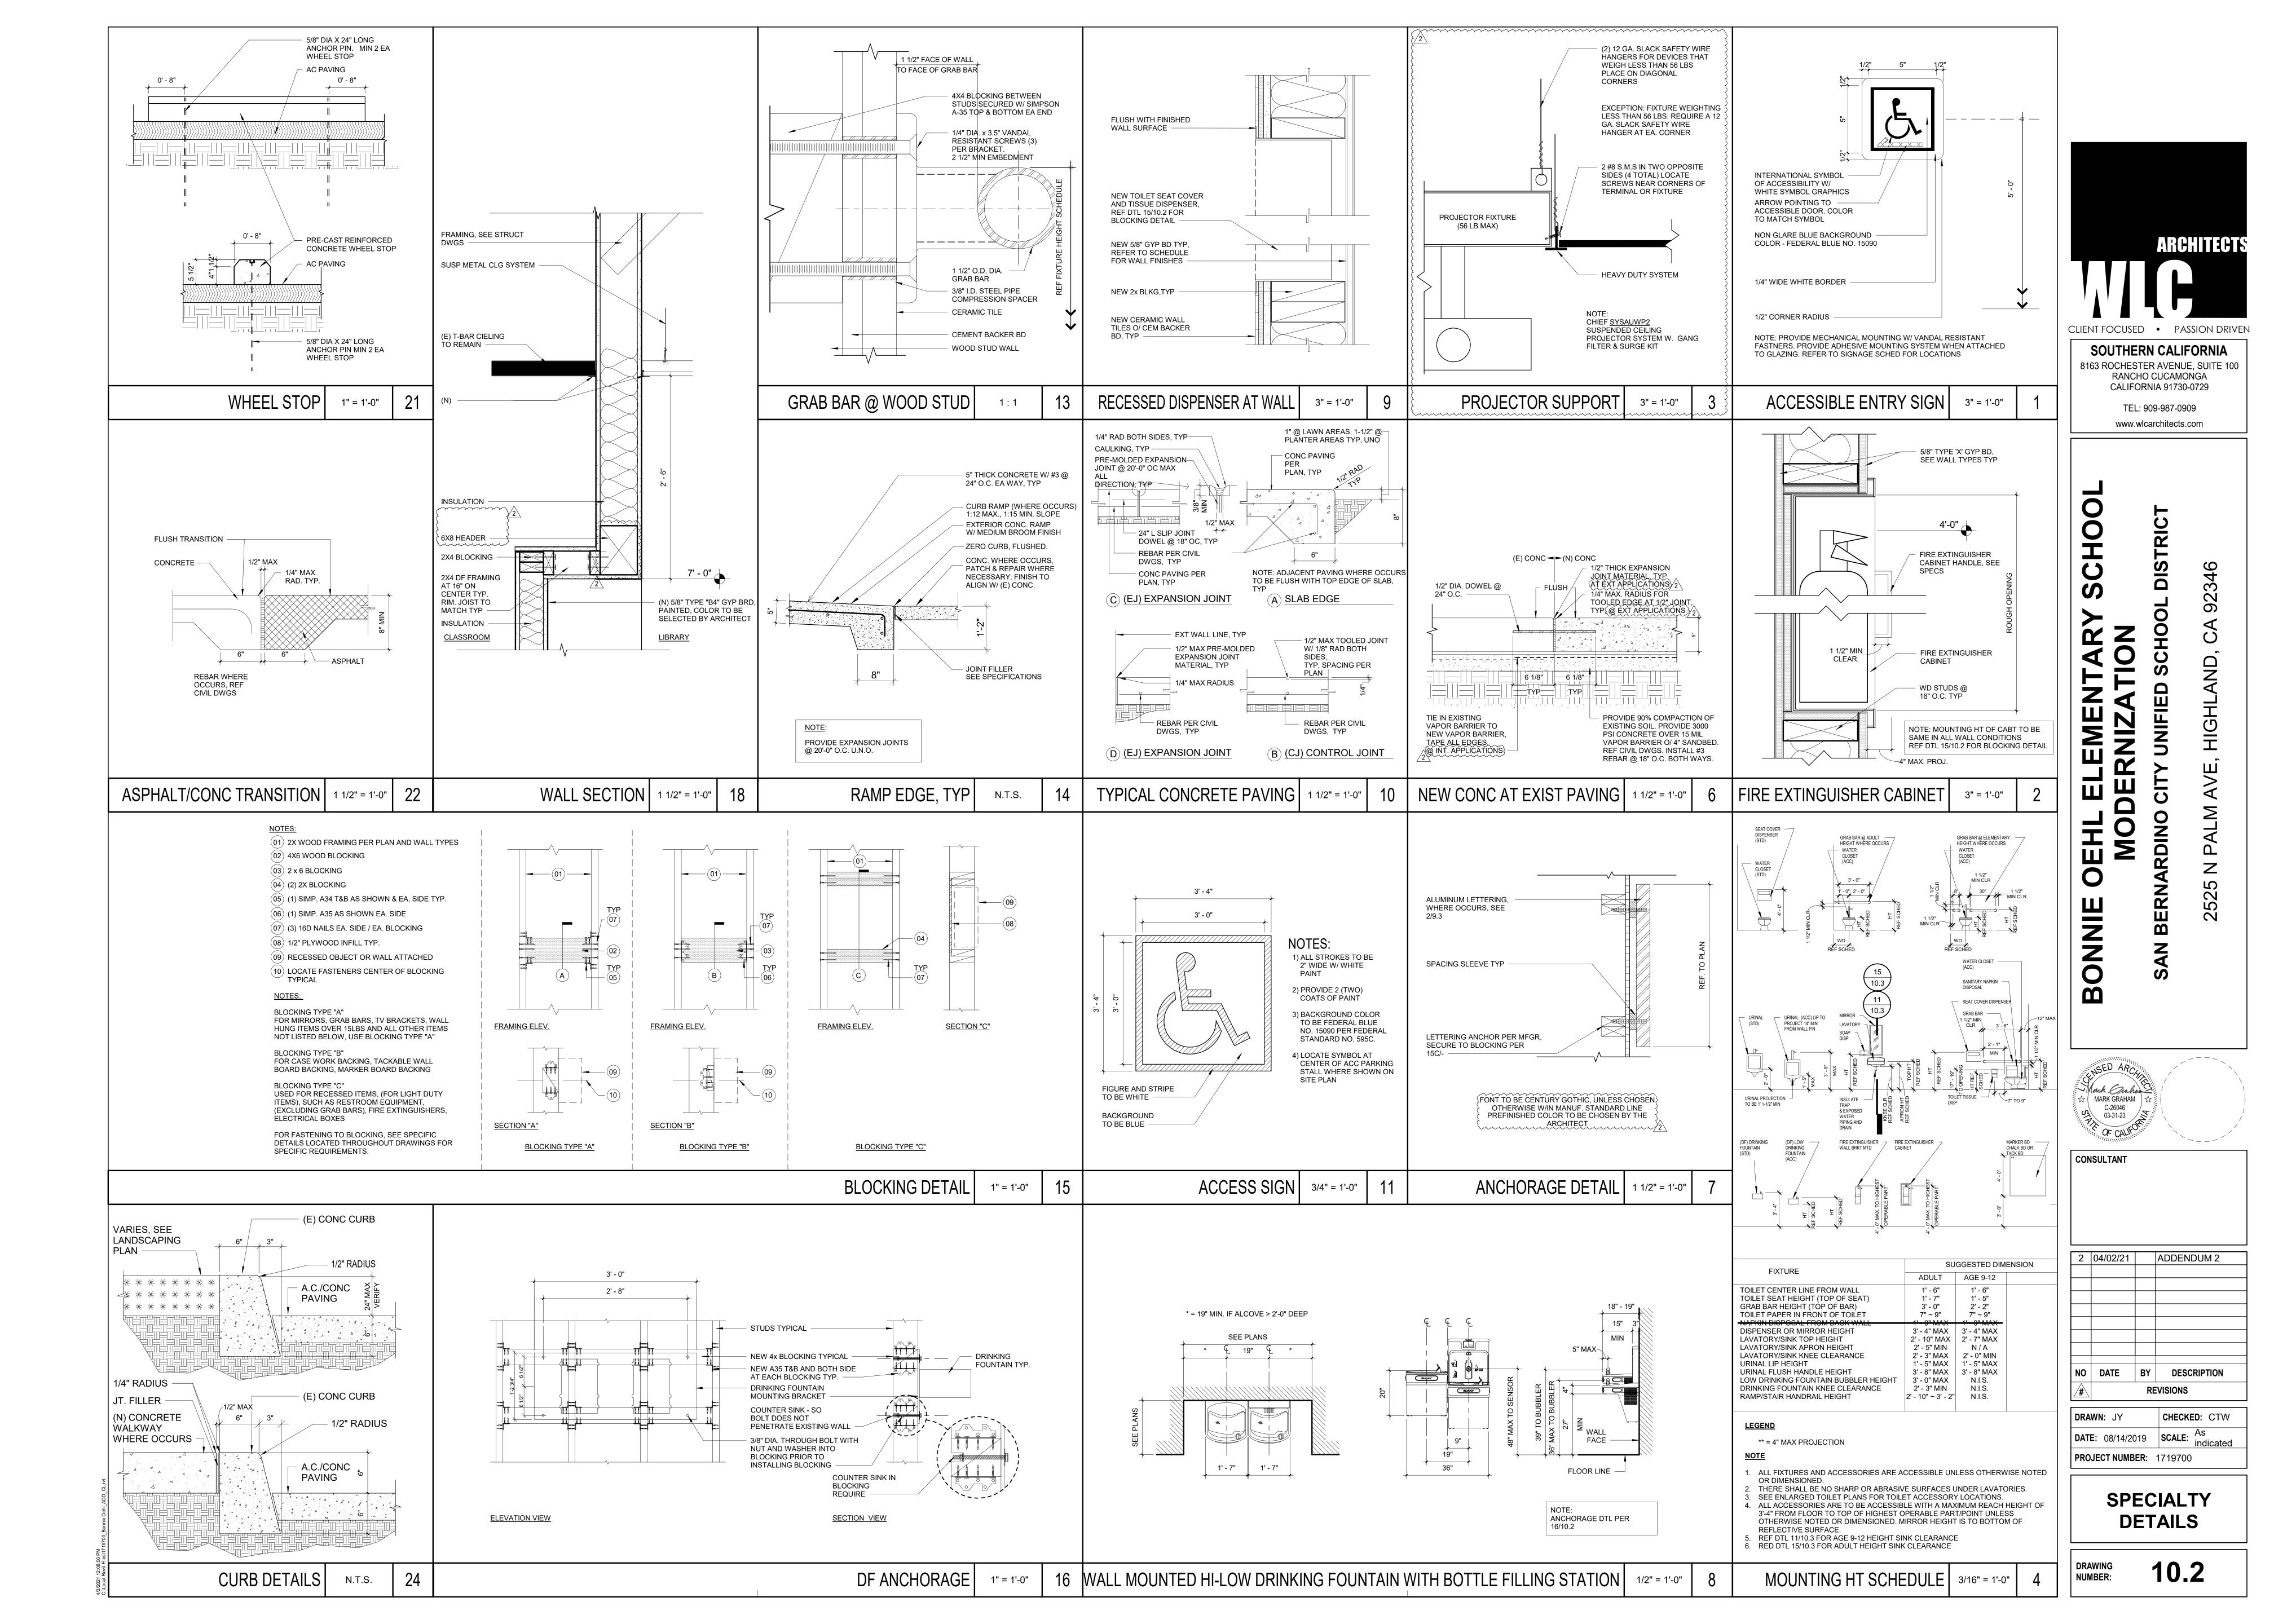


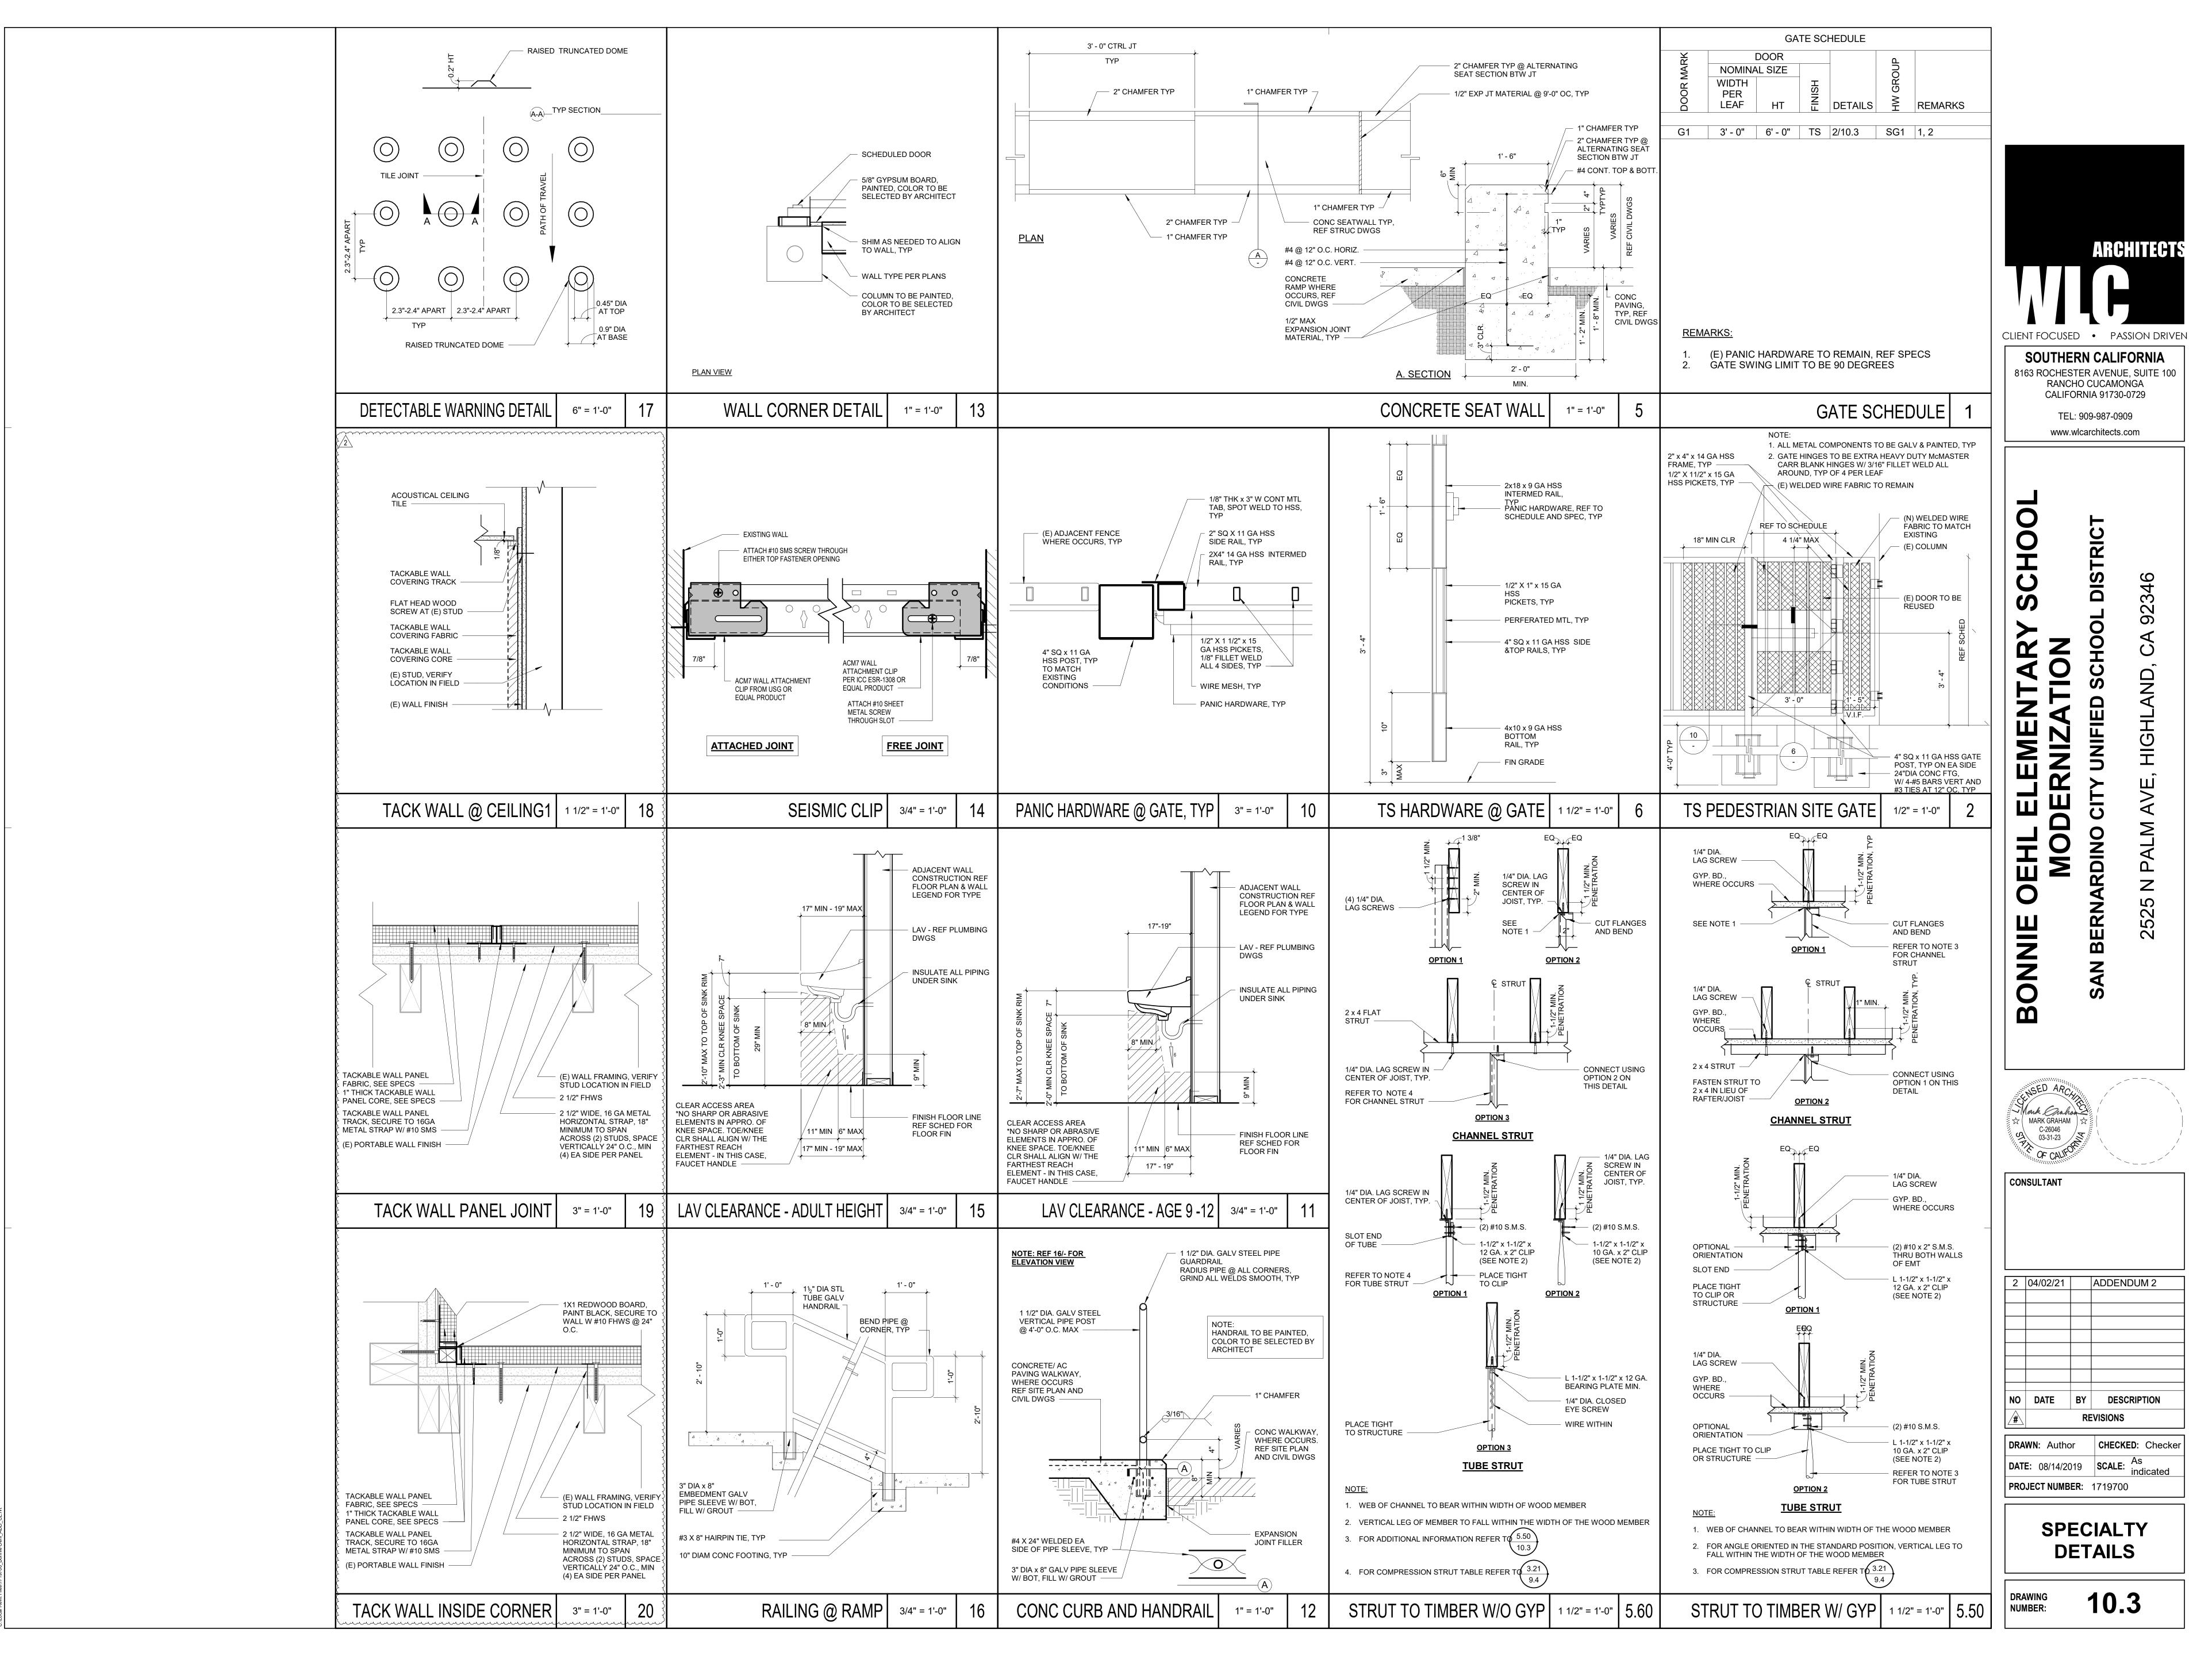


21 12:08:03 PM

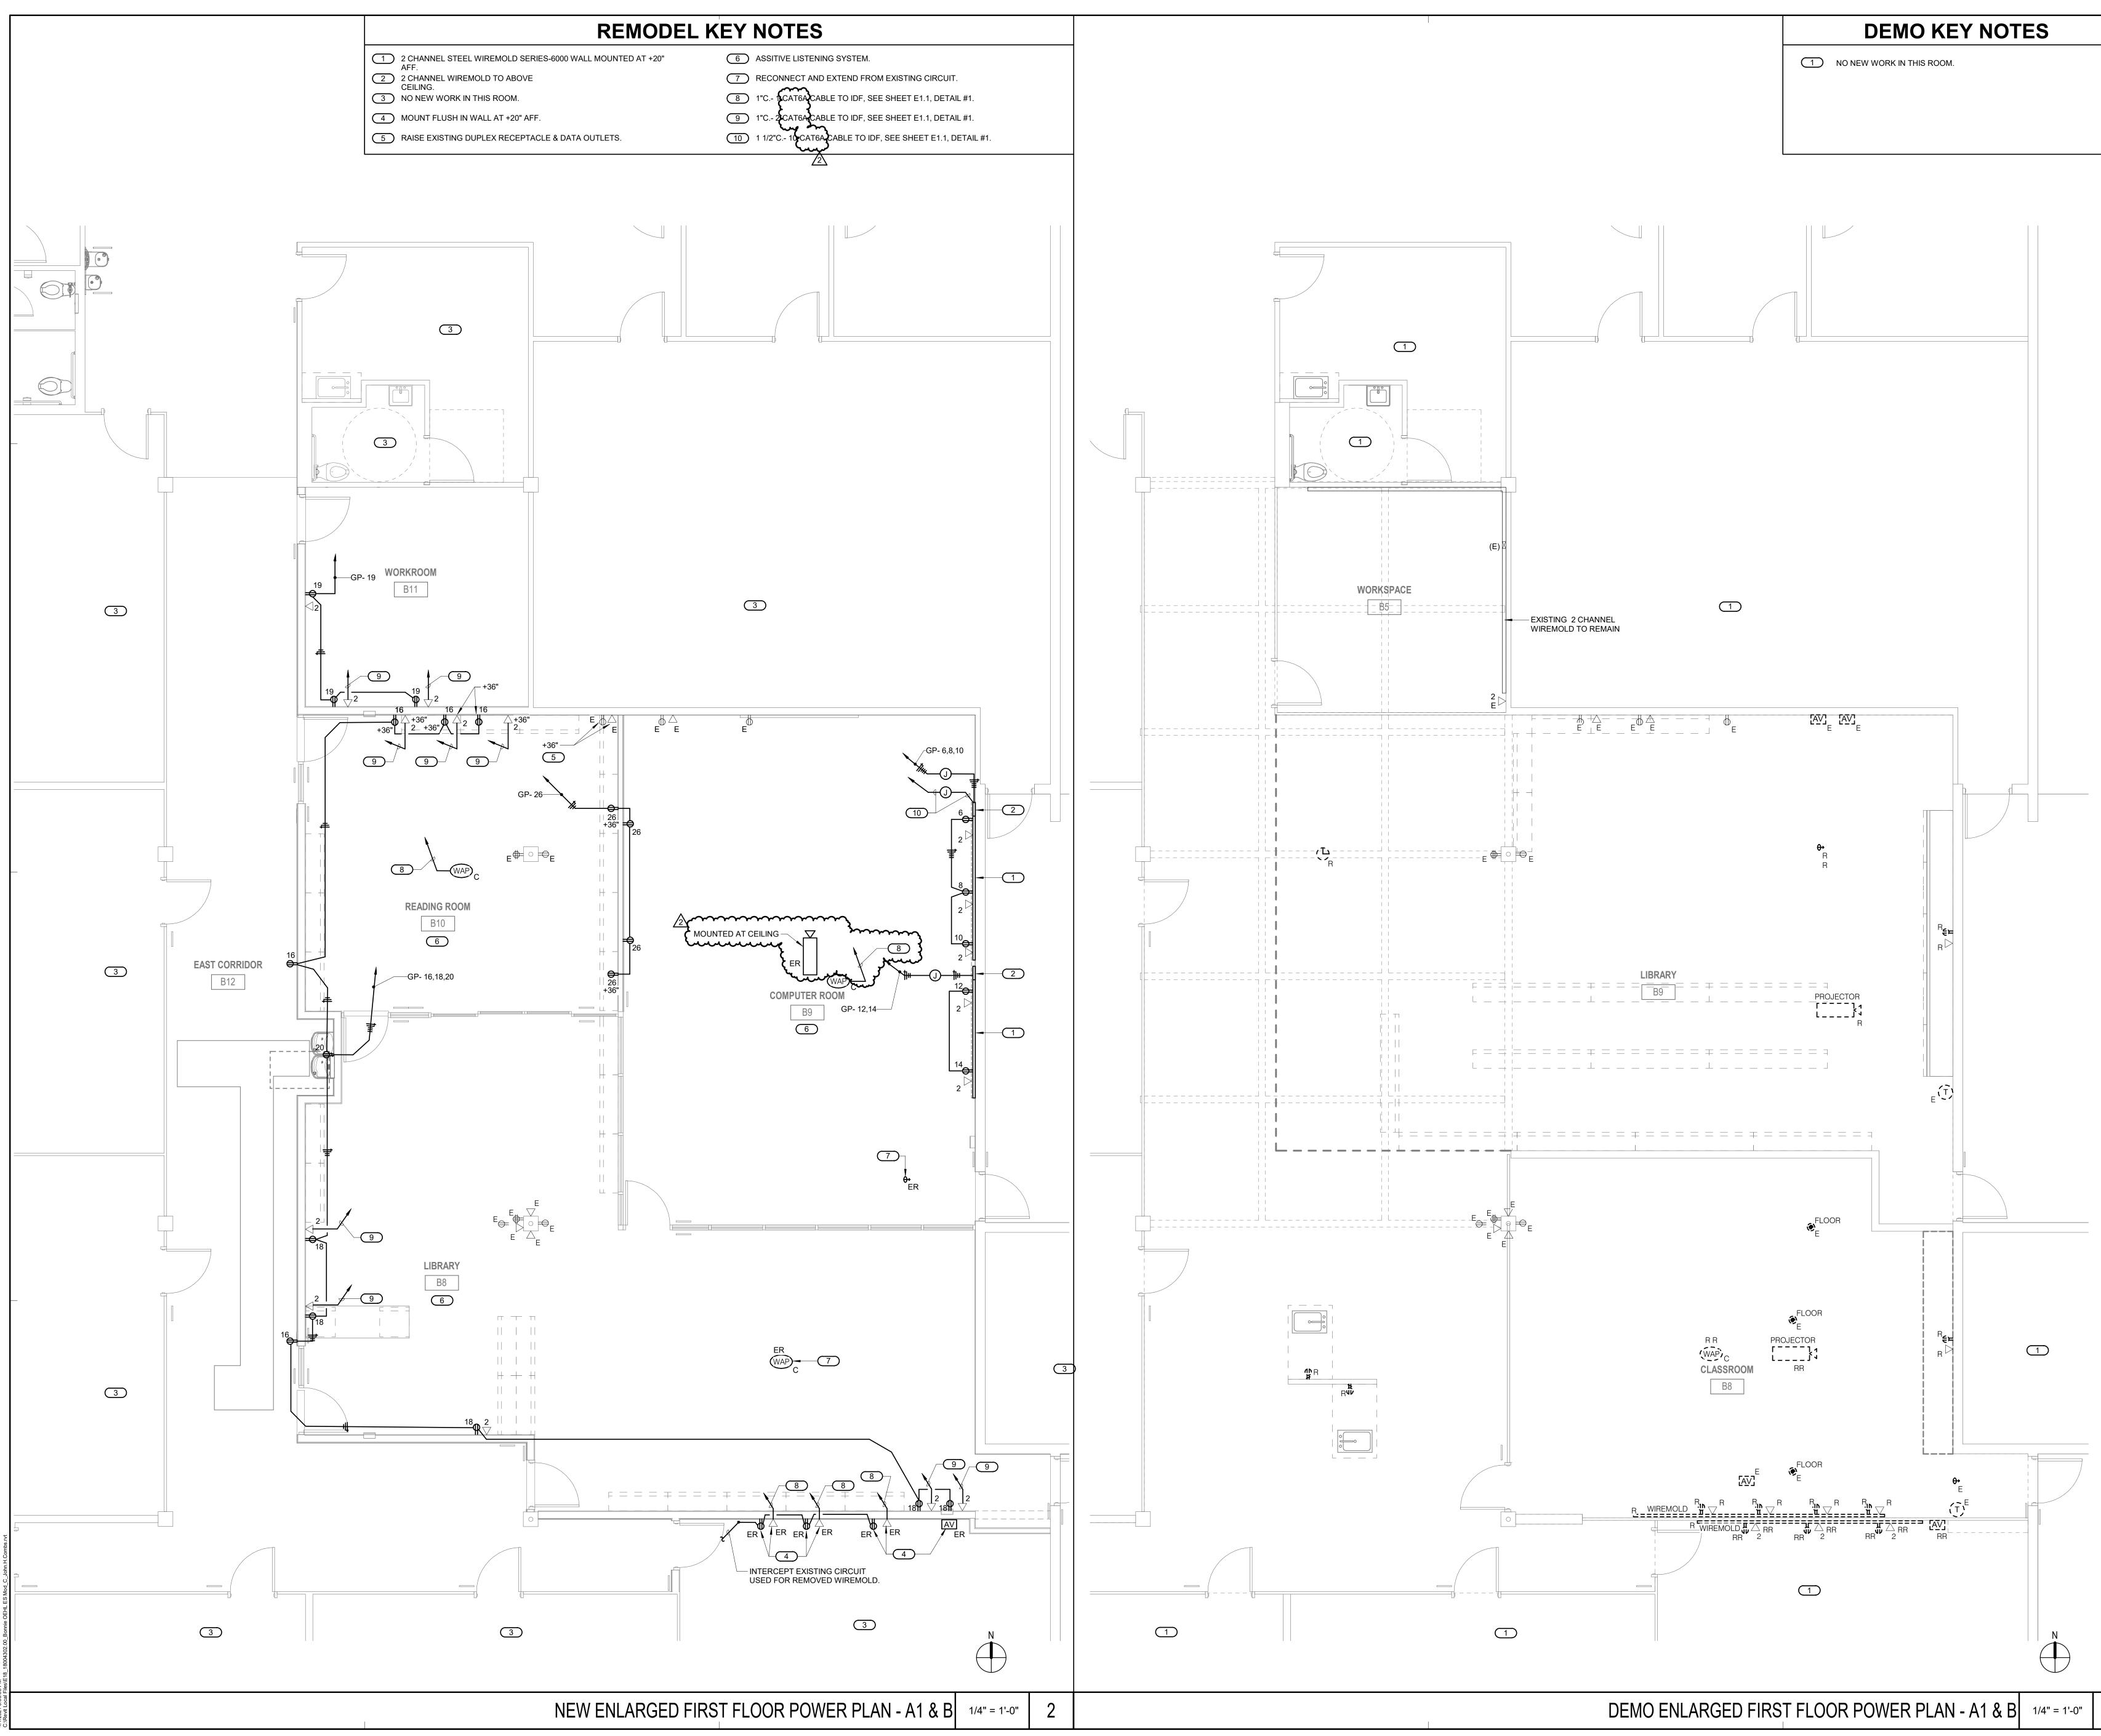

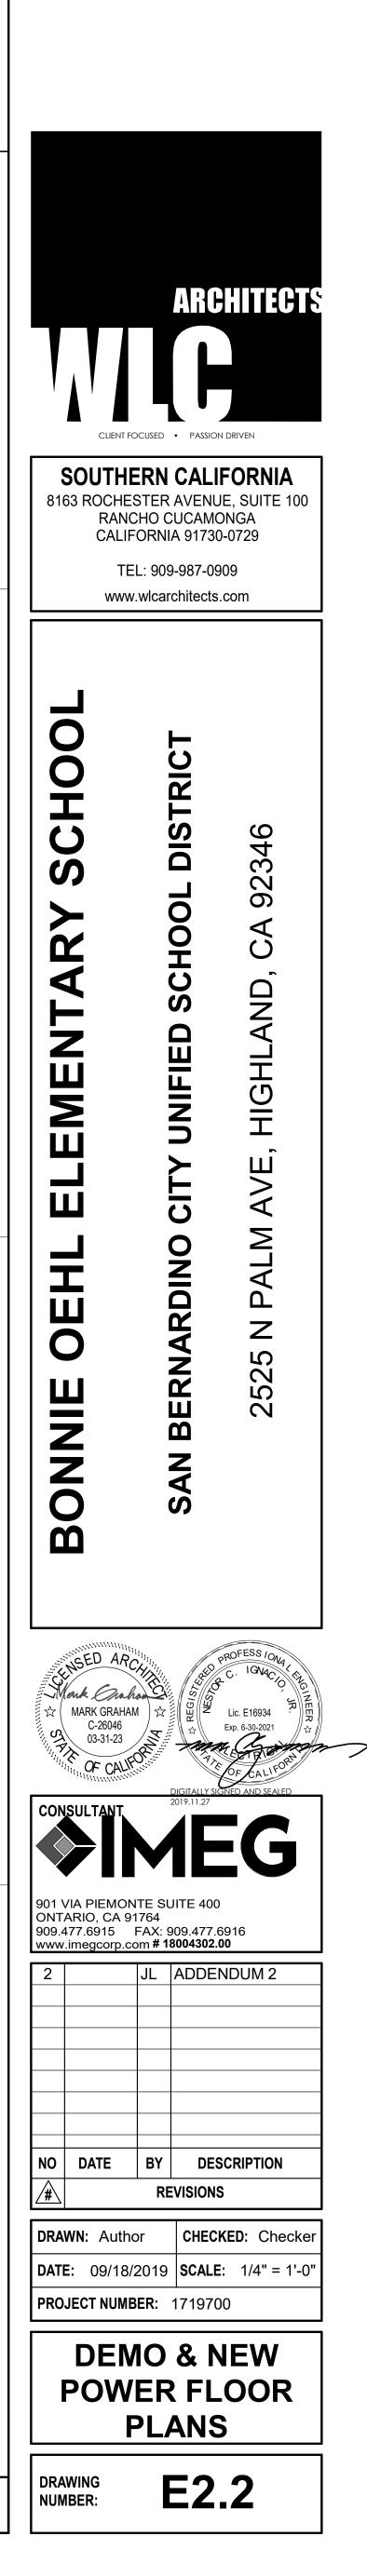


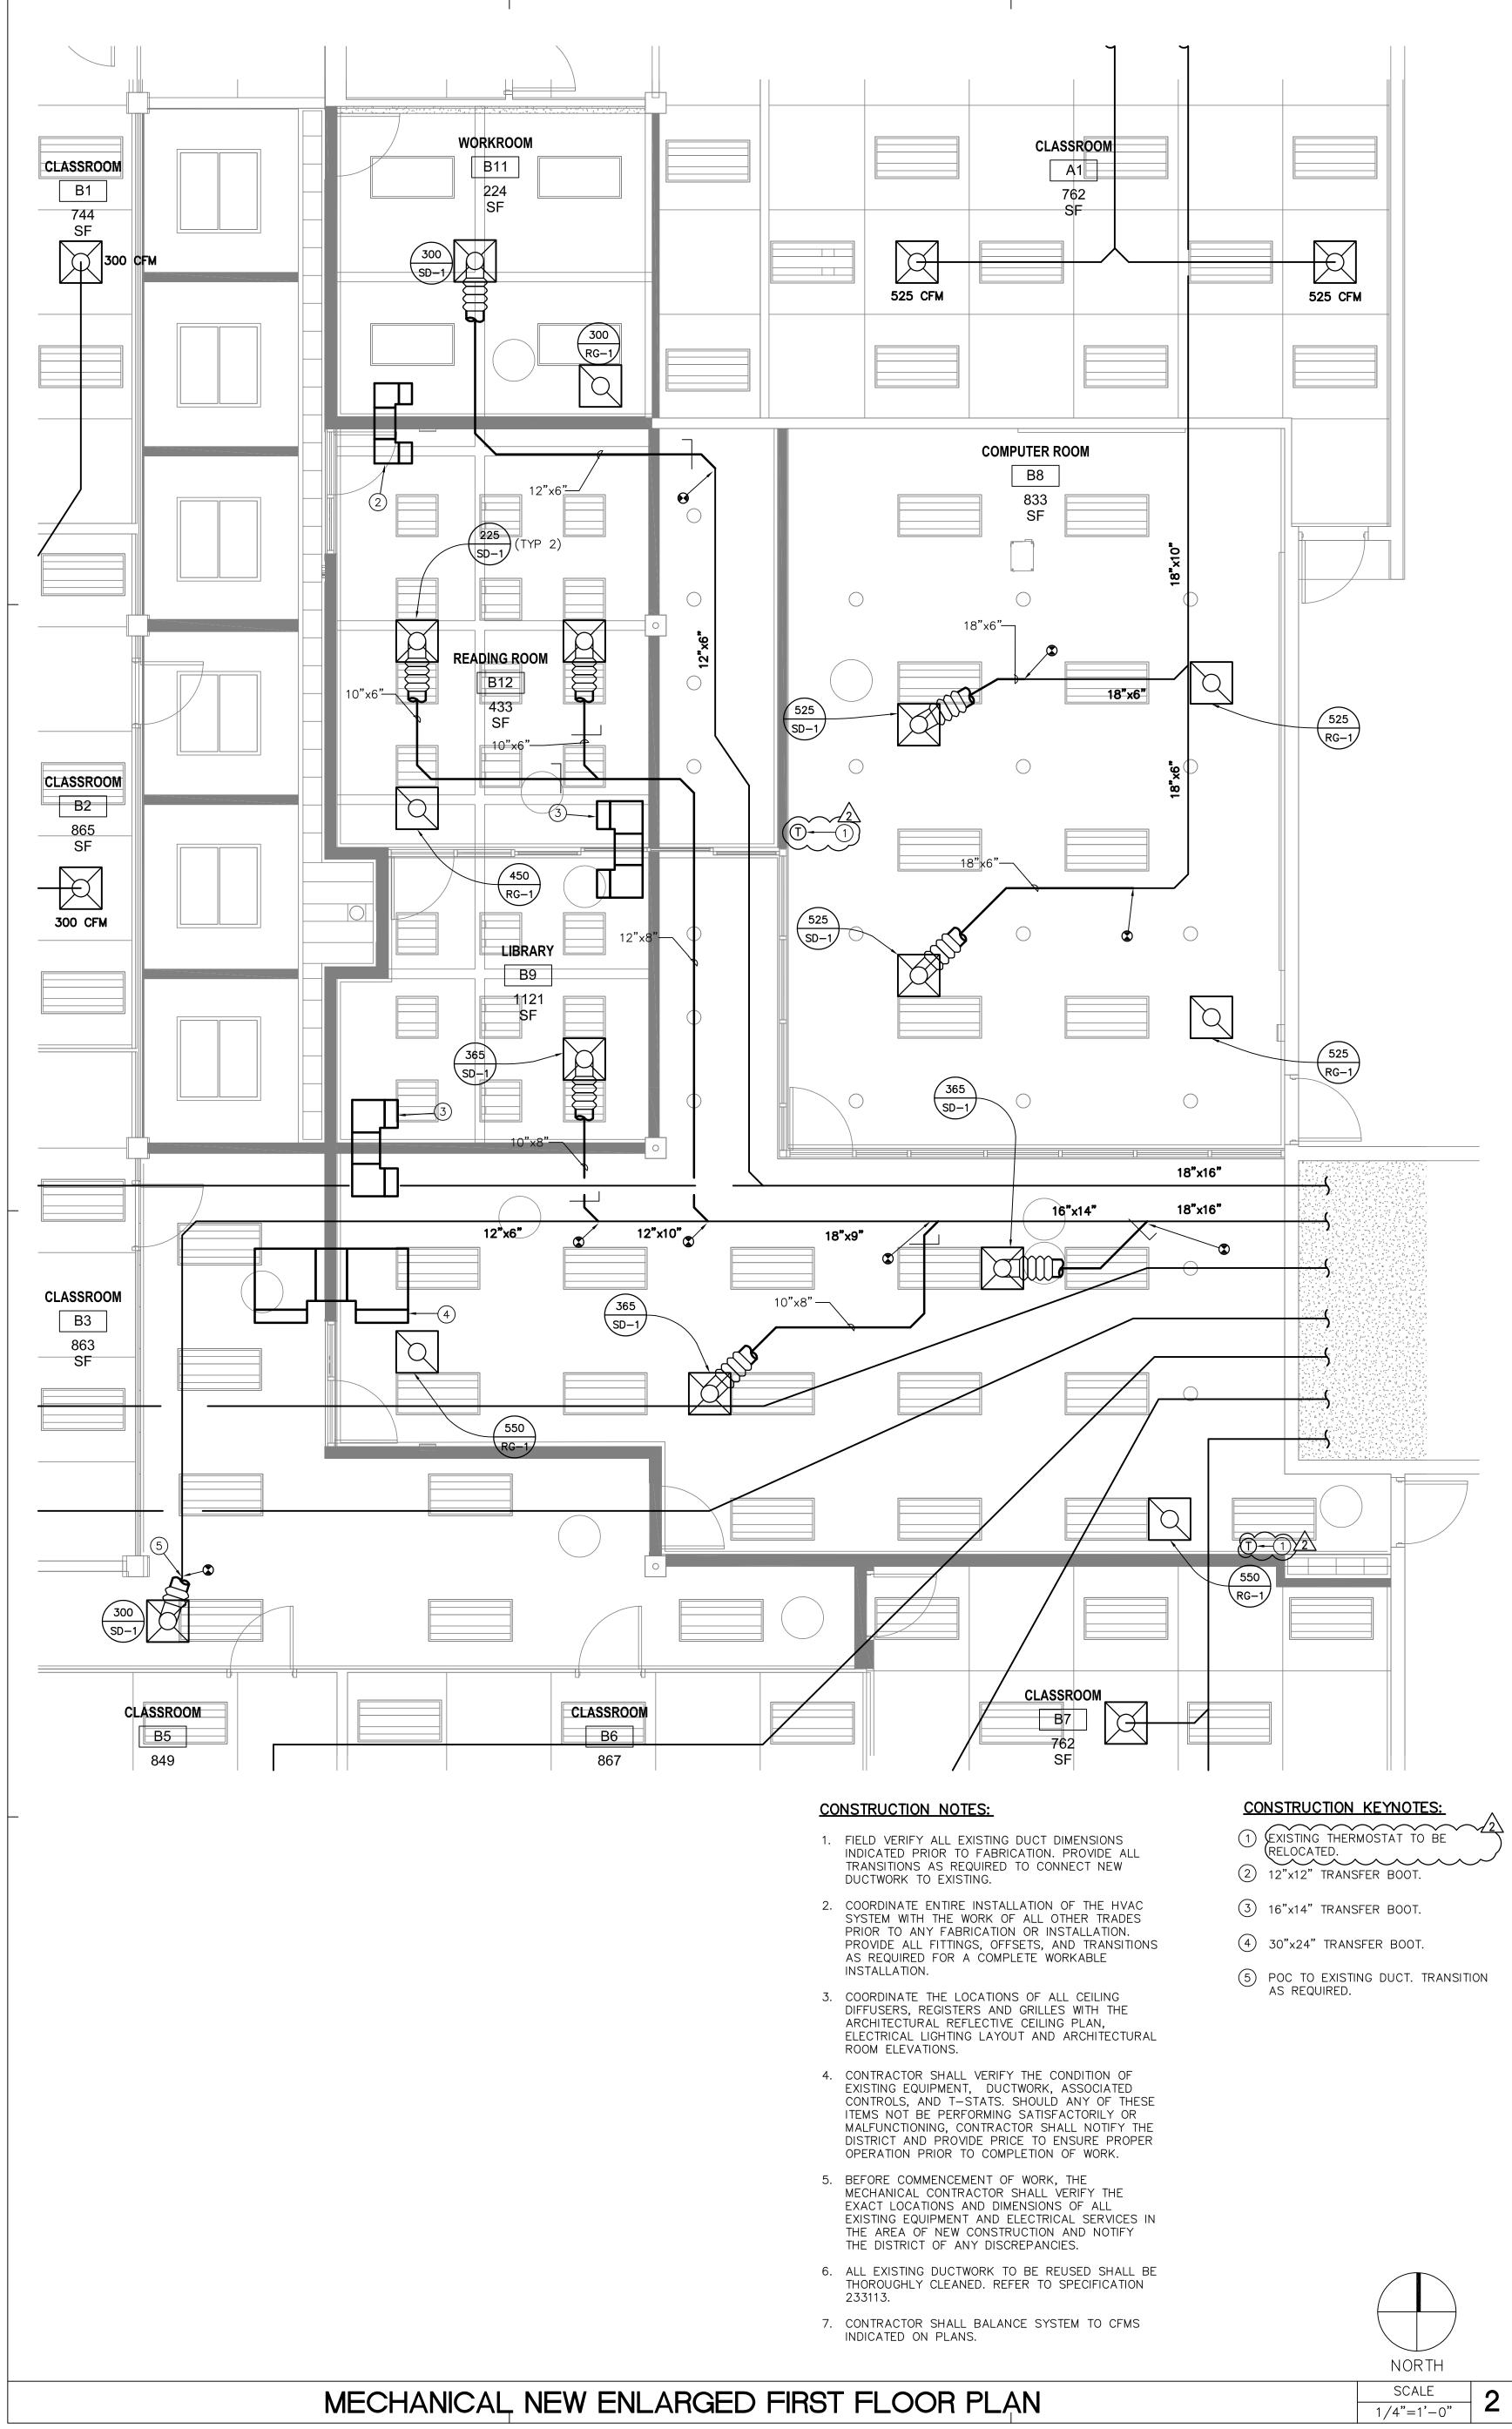

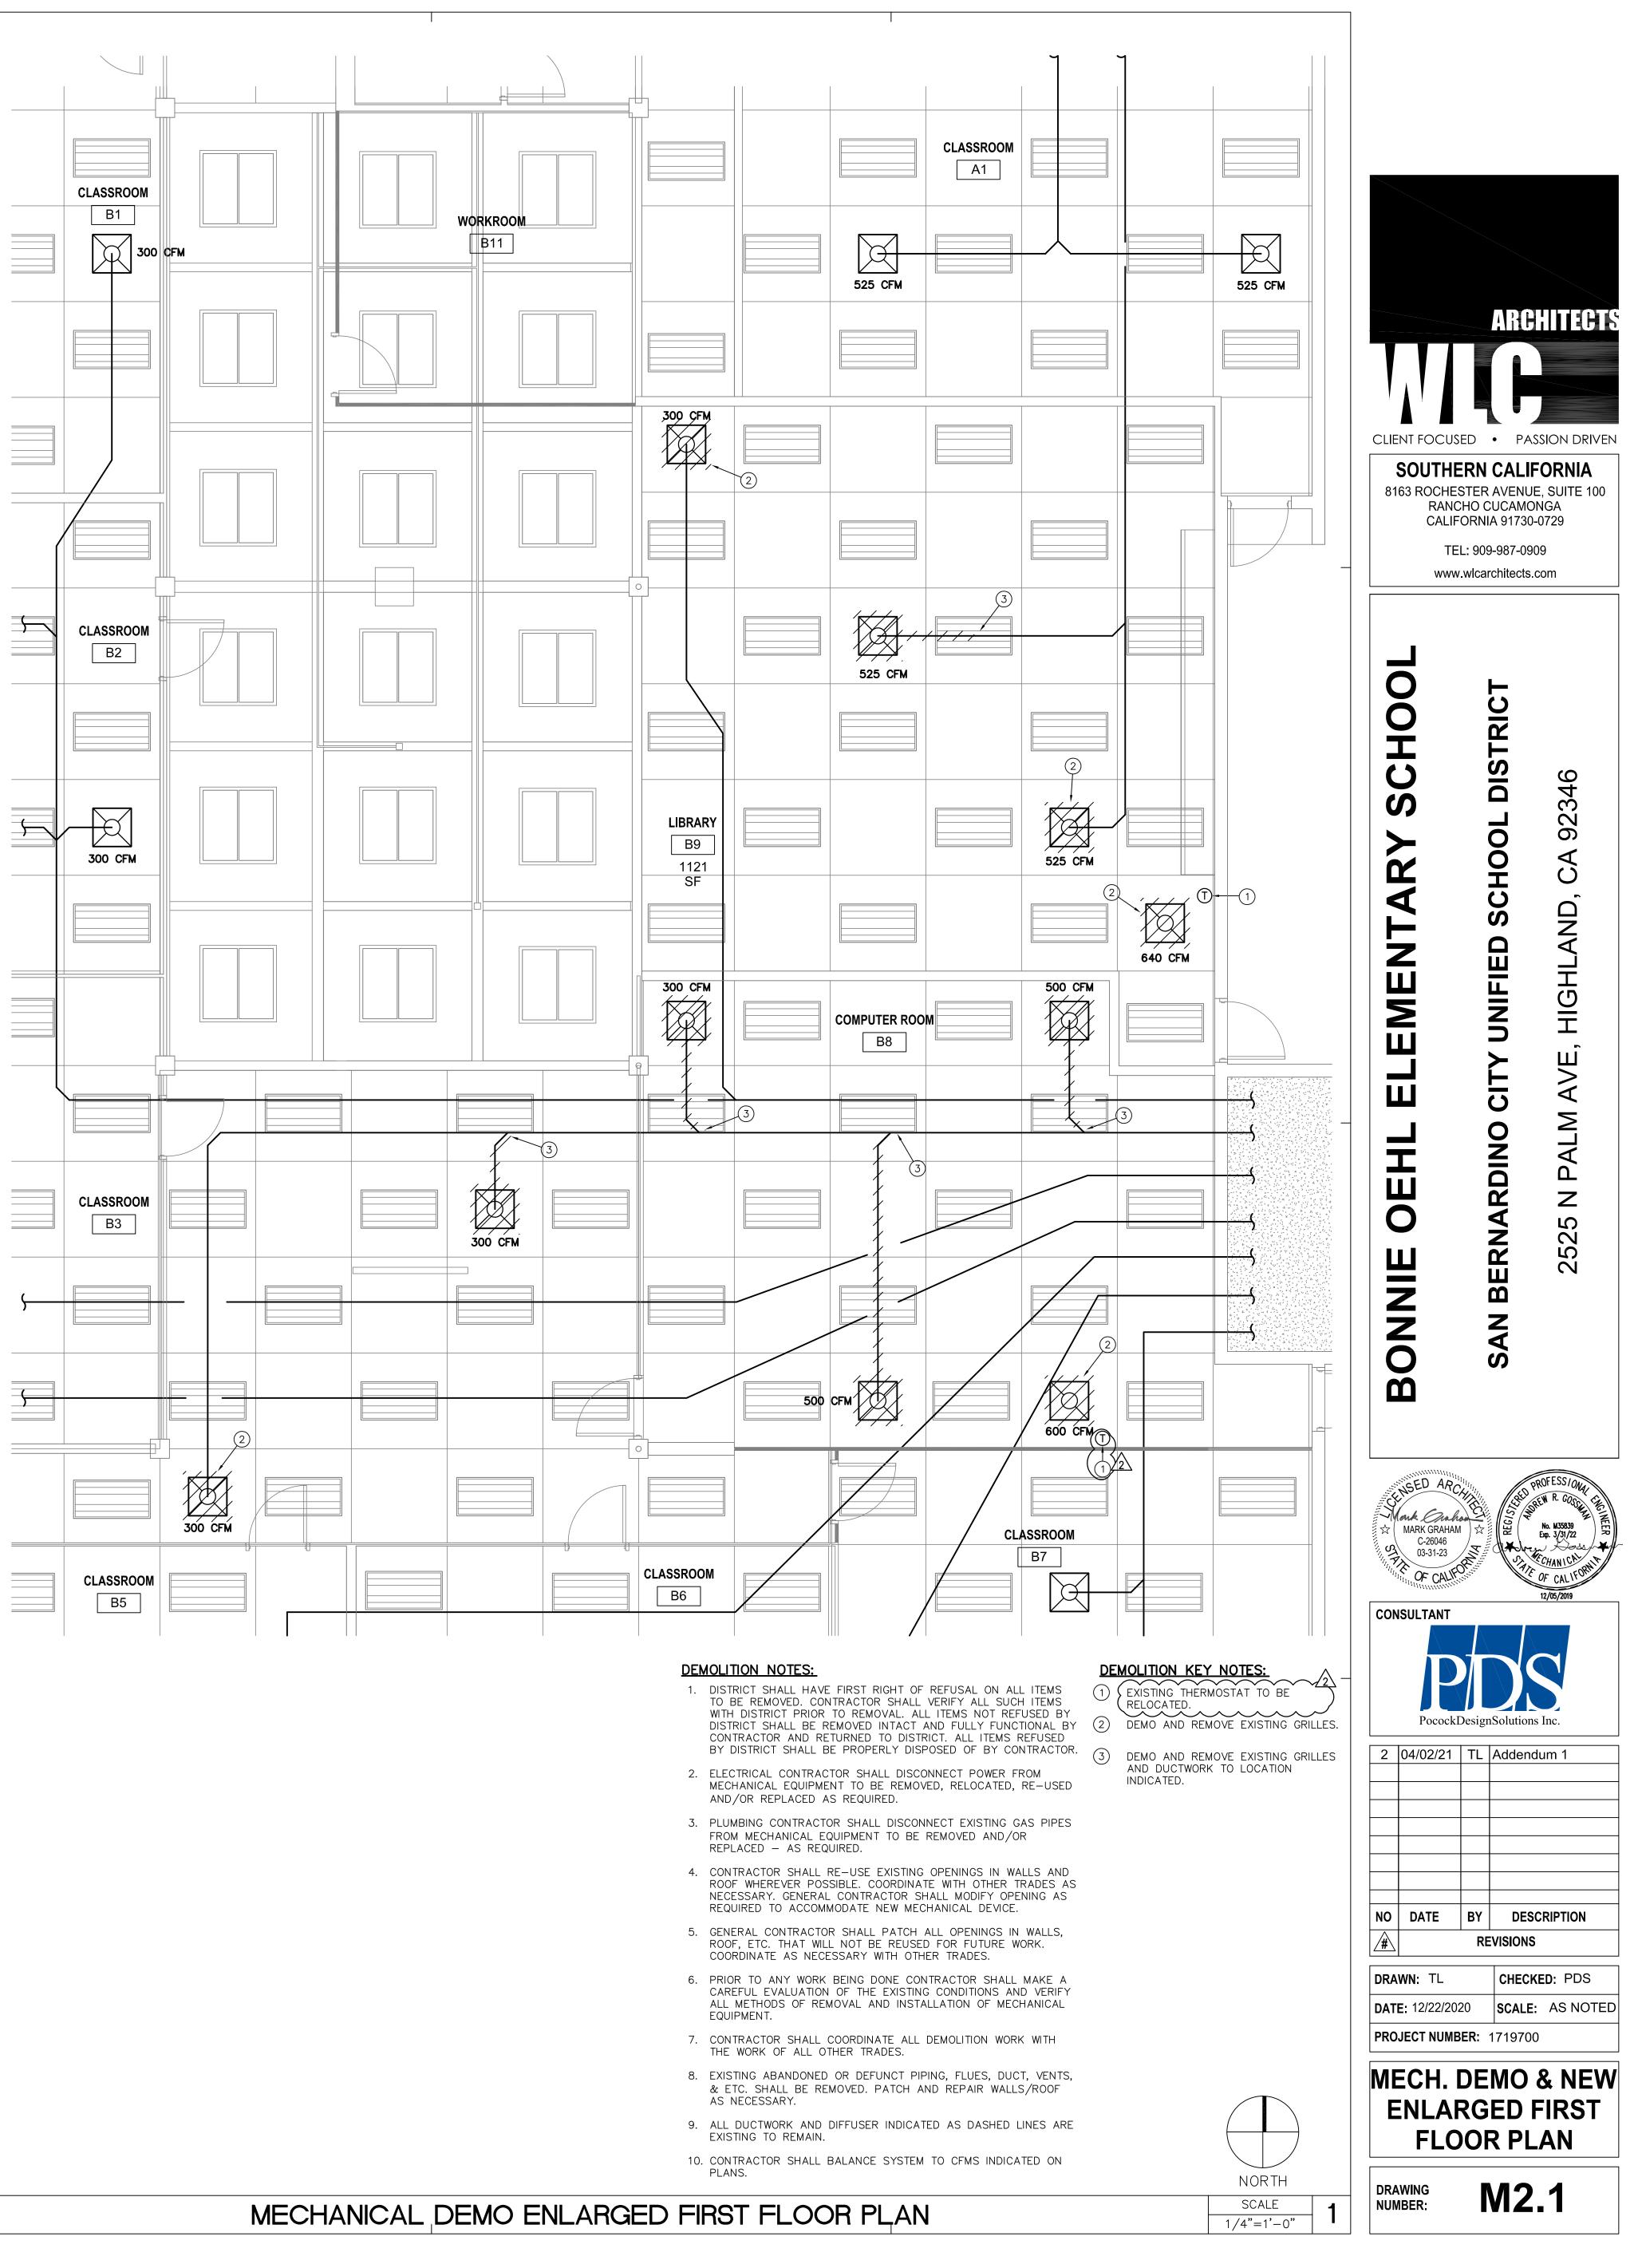

0

Z

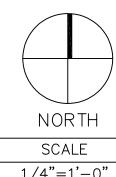



ASBESTOS ABATMENT SPECIFICATIONS

Prepared For

San Bernardino City Unified School District Facilities Management, Maintenance & Operations Department 956 West 9th Street San Bernardino, CA 92411

Site Location

Bonnie Oehl Elementary School 2525 North Palm Avenue Highland, CA 92346

Date: March 15, 2021



SECTION 02 82 00 ASBESTOS REMEDIATION

PART 1 – GENERAL

1.0 SCOPE OF WORK

1.1. Scope of Work

The scope of work for the abatement project will involve the abatement of Asbestos Containing Materials (ACM) prior to renovation activities at the subject property. The ACMs listed in the tables below are contained in the attached EFI Global Limited Asbestos, Lead & Hazardous Materials Assessment Report, dated December 21, 2018, prepared for the San Bernardino City Unifies School District, for Bonnie Oehl Elementary School, located at 2525 North Palm Avenue, Highland, CA 92346. This report details the specific materials that require special handling under this specification.

Note that the quantities listed in the below table are estimates only. It is the Contractor's responsibility to quantify materials that are to be impacted by the scheduled renovation activities, as outlined in the construction contract documents prior to bid submittal, as part of the Contractor's due diligence, and prior to initiating renovation activities.

Specific contractor responsibilities include, but are not limited to the following:

- The Contractor is responsible for the protection and decontamination of fixtures and equipment remaining in the work area, prior to, and after abatement.
- The Contractor shall furnish all labor, materials, services, insurance, equipment, and decontamination facilities to carry out the complete removal, and disposal of all ACM and ACCMs identified in these specifications that are to be impacted by the renovation activities.
- Work shall be performed in accordance with all applicable regulations, codes, ordinances, and standards of governing authorities having jurisdiction and the requirements specified herein. Where applicable state or local standards are more stringent than federal standards, the Abatement Contractor shall adhere to the most stringent standards.
- The Contractor shall extend full cooperation to the Owner in all matters involving the use of the Owner's facilities. At no time shall the Contractor cause or allow there to be caused conditions that may cause risk or hazard to the general public or conditions that might impair safe use of the facility. The use of the facility's electricity, water or like utilities by the Contractor shall be coordinated through the Owner.
- In addition, the Contractor shall furnish all labor, material, supervision, construction tools, and equipment necessary to perform the following work:
 - o Removal of all identified ACM and ACCM prior to renovation activities.
 - Provision and maintenance of environmental and occupational safety protective measures, equipment, and procedures at the work site, including appropriate engineering controls.
 - Cleaning of the work site to completely remove all visually apparent asbestos and reduce airborne asbestos fiber concentrations.
 - If, in the course of removal of ACM and ACCMs from the site, the Contractor discovers any other ACMs or PACMs other than those described in plans, reports, and / or specifications, the



Contractor shall notify the Owner and/or Consultant in writing, and after receiving the Owner's approval, the Contractor will remove and dispose of such item(s).

- With respect to available utilities, the Contractor shall coordinate access and use all utilities as needed for the duration of the project with the Owner. If utilities are unavailable, the Abatement Contractor will be required to provide the utilities at the Abatement Contractor's own cost.
- The Abatement Contractor shall obtain all necessary permits from the Owner, City of San Bernardino, and other local agencies, and the South Coast Air Quality Management District (SCAQMD), and any other authorities having jurisdiction.
- Packaging, transport, and disposal of all asbestos to a disposal site approved by the applicable federal, state, and local authorities shall be the sole responsibility of the Contractor, including any certifications or statements of non-friability requires by the landfill.
- Cooperation with the Owner and/or Consultant with regards to air monitoring and observation of procedures.

Below are summary tables of specific materials that require special handling under this specification:

Homogenous Materials Number	Material Description	Location	Asbestos Content (% Weight)	Material Quantity *	Friability **	Condition
1	Yellow Adhesive Associated with Multicolored Carpet	Room B8 Room B9	<1.0% Chrysotile	2,850 SF	Non- Friable	Good
2	2'x4' Ceiling Tiles	Room B8 Room B9	None Detected			
3	Drywall	Room B8 Room B9	None Detected			
4	Drywall Joint Compound	Room B8 Room B9	None Detected			
5	Fiberboard	Room B8 Room B9	None Detected			
6	4" Black Base Cove and Mastic	Room B8 Room B9	None Detected			

Table 1: Homogenous Building Materials & Asbestos Content

* All quantities are approximations and should be verified by an abatement contractor.

** Non-friable materials may be rendered friable during removal by mechanical or other aggressive methods.

1.2. DEFINITIONS

- 1. Abatement Procedures to control fiber release from Asbestos Containing Materials (ACM) or Asbestos Containing Construction Materials (ACCM). Includes removal, encapsulation, enclosures, repair, demolition, and renovation activities but does not include asbestos related disturbance.
- 2. Aggressive Method Means removal or disturbance of building material by sampling, abrading, grinding, or method that breaks, crumbles, or disintegrates intact ACM.
- 3. AHERA Asbestos Hazard Emergency Response Act, 40 CFR, Part 763, Subpart E, and subsequent amendments.



- 4. Air filtration and ventilation system A portable exhaust system, equipped with HEPA filtration, and capable of maintaining a constant air flow into a regulated area from adjacent areas and exhausted outside the regulated area.
- 5. Amended Water Water to which a surfactant (wetting agent) has been added.
- Area Sampling Means sampling of asbestos fiber concentrations which approximates the concentrations
 of asbestos in the theoretical breathing zone but is not actually collected in the breathing zone of an
 employee.
- 7. ANSI American National Standards Institute.
- 8. Asbestos Means the asbestos form varieties of chrysotile, crocidolite, amosite, anthophyllite, tremolite and actinolite.
- 9. Asbestos Containing Construction Material (ACCM) Means any manufactured construction material which contains more than one tenth of one percent (0.1%) asbestos by weight.
- 10. Asbestos Containing Material (ACM) Means any material containing more than one-percent (1%) asbestos.
- 11. Asbestos Containing Waste (Non-Hazardous) Non-friable asbestos containing material including, but not limited to: floor covering, roofing materials and cementitious materials requiring disposal.
- 12. Asbestos Containing Waste (Hazardous) Friable asbestos containing materials and asbestos contaminated objects and debris requiring disposal.
- 13. Asbestos Related Disturbance is the drilling, coring, removal or similar disturbance of ACCM or ACM not to exceed three (3) square feet in any one opening and not to disturb 100 square feet or greater cumulatively on any one project (contract).
- 14. ASTM American Society for Testing and Materials.
- 15. Authorized Person means any person authorized by the employer and required by work duties to be present in regulated areas
- 16. Building ID Number or Code A six-digit alphanumeric identification code assigned to each building on site. (not applicable to this project)
- 17. Bulk Samples Samples of building or other materials collected for analysis to determine the presence and quantities of asbestos.
- 18. Class I, II, III, and IV asbestos work has the meaning as defined in California Code of Regulations Title 8, Section 1529.
- 19. Class I Asbestos Work Activities involving the removal of thermal system insulation (TSI) and surfacing ACM and PACM
- Class II Asbestos Work Activities involving the removal of ACM which is not TSI or Surfacing Material. This
 includes, but is not limited to, the removal of asbestos containing wallboard, floor tiles, and sheeting,
 roofing and siding shingles, and construction mastics.



- 21. Class II Asbestos Work Repair and Maintenance operations where ACM, including TSI and surfacing ACM and PACM, is likely to be disturbed.
- 22. Clean Room An uncontaminated area of room, which is a part of the worker Decontamination Enclosure System with provisions for storage of worker's street clothes and clean protective equipment.
- 23. Closely Resemble Means the major workplace conditions, which have contributed to the levels of historic asbestos exposure, are no more protective than the conditions of the current workplace.
- 24. Competent Person Has the same meaning as defined in the California Code of Regulations Title 8, as it relates to "Competent Person."
- 25. Controlled Disturbance an activity by which a contractor disturbs an asbestos containing material or an asbestos containing construction material using the work practices allowed for in this specification and in compliance with regulatory limitations.
- 26. Critical Barrier One or more layers of plastic sealed over all openings into a work area or any other similarly places barrier sufficient to prevent airborne asbestos in a work area from migrating to an adjacent area.
- 27. Curtained Doorway A device to allow ingress and egress from one room to another while permitting minimal air movement between the rooms, typically constructed by placing two overlapping sheets of plastic over an existing or temporarily framed doorway, securing each along the top of the doorway, securing the vertical edge of one sheet along one vertical side of the doorway and securing the vertical edge of the opposite vertical side of the doorway. Other effective designs may be submitted for review.
- 28. Decontamination The process of eliminating asbestos contamination from building surfaces, objects, and property, by cloths, mops, or other utensils dampened with water and disposed of afterwards as asbestos contaminated waste.
- 29. Decontamination Enclosure System Means an enclosed area, which is adjacent and connected to the regulated area, consisting of an Equipment Room, Shower Room, and Clean Room for the decontamination of workers, materials, and equipment contaminated with asbestos.
- 30. Demolition The wrecking or taking out of any load supporting structural member of a facility together with any related handling operations.
- 31. Disturbance Means contact that releases fibers from ACM or PACM or debris containing ACM or PACM.
- 32. DOSH Division of Occupational Safety & Health or Cal/OSHA.
- 33. DOT Department of Transportation
- 34. DTSC Department of Toxic Substances Control.
- 35. Encapsulating Material A liquid material applied to asbestos containing materials which controls the possible release of asbestos fibers from the material either by creating a membrane over the surface (bridging agent) or by penetrating into the material and binding its components together (penetrating encapsulating material).
- 36. Encapsulation The application of an encapsulating material to asbestos containing materials to prevent the release of asbestos fibers into the air.



- 37. Enclosure The construction or application of an airtight, impermeable, permanent barrier around asbestos containing material to control the release of asbestos fibers into the air.
- Equipment Room A room within the worker decontamination enclosure system with provisions for storage of used clothing and equipment and for controlled transfer of materials and equipment into and out of the regulated area.
- 39. Facility Component Means any part of a facility including equipment.
- 40. Fixed Object A piece of equipment, furniture, or improvement in the work area, which cannot be removed from the work area.
- 41. Friable Asbestos Asbestos containing material which, when dry, can be crumbled, pulverized or reduced to a powder by hand pressure or as defined by current regulations.
- 42. Glove Bag Technique A method with limited applications for removing small amounts of asbestos containing material from short piping runs, valves, joints, elbows, and other non-planar surfaces in a work area. The glove bag assembly is a manufactured or fabricated device consisting of a glove bag (typically constructed of 6 mil fire-retardant polyethylene sheeting) two inward projecting long sleeve gloves, an internal tool pouch, and labeled for asbestos waste. The glove bag is constructed and installed in such a manner that it surrounds the object or material to be removed and contains all Asbestos fibers released during the process. All workers who are permitted to perform the glove bag technique shall be thoroughly trained, experienced, and skilled in this method.
- 43. Hazardous Waste Means friable asbestos generated and prepared for waste disposal. Does not include non-friable material or materials containing one-percent or less of asbestos as determined by PLM and/or the point counting method.
- 44. HEPA Filter Means a filtering system capable of trapping and retaining at least 99.97% of all monodispersed particles 0.3 microns in diameter or larger. For respirators this shall include NIOSH rated P-100 cartridges only.
- 45. HEPA Vacuum Vacuum system furnished with HEPA filtration.
- 46. High Volume Vacuum A vacuum system with the capacity to collect material through a four (4) inch diameter hose a minimum distance of 150 feet. This system shall e furnished with HEPA filter at the air exhaust port and water applicators within the hopper.
- 47. HVAC Heating, Ventilation, and Air Conditioning System.
- 48. Lockdown A material applied to surfaces where asbestos has been completely removed. The manufacturer shall determine the concentration of this material.
- 49. Member A component part of a structure complete in itself.
- 50. Movable Object A portable piece of equipment or furniture in the work area, which can be removed from the work area.
- 51. NESHAP National Emission Standards for Hazardous Air Pollutants (40 CFR Part 61).
- 52. NIOSH National Institute for Occupational Safety and Health.
- 53. Outside Air Air outside of buildings and structures.



- 54. Owner's Environmental Consultant Refers to the firm, company or individual designated by the Owner (Orange County Sanitation District).
- 55. PCM Phase Contrast Microscopy as it relates to clearance air, personnel exposure assessment, and ambient air monitoring. This procedure must follow the NIOSH Method 7400.
- 56. PLM Polarized Light Microscopy used for bulk sample analysis with dispersion staining for the determination and quantifying of asbestos in bulk samples of building materials.
- 57. Regulated Area Designated rooms, spaces or areas of the project in which asbestos abatement actions are to be performed or which may become contaminated as a result of abatement activities. A contained work area is a work area, which has been sealed and furnished with a decontamination enclosure system. A non-contained work area is an isolated or controlled access work area, which has not been sealed or furnished with a decontamination enclosure system.
- 58. Removal Means all operations where all ACM and/or presumed ACM is removed or stripped from structures or substrates including demolition.
- 59. Renovation Means the modifying of any existing structure, facility, or portion thereof.
- 60. SCAQMD South Coast Air Quality Management District.
- 61. Shower Room A room between the clean room and the equipment room in the worker decontamination enclosure system furnished with hot and cold running water controllable at the tap, and suitably arranged for complete showering during decontamination.
- 62. Staging Area Areas near the waste transfer airlock where containerized asbestos waste is temporarily placed prior to permanent removal from the work area.
- 63. Surfactant A chemical wetting agent added to water.
- 64. TEM Transmission Electron Microscopy as defined for asbestos clearance air sampling. This procedure must follow the NIOSH Method 7402.
- 65. TSI Thermal System Insulation as defined in AHERA.
- 66. USEPA or EPA United States Environmental Protection Agency
- 67. Visible Emissions Any emissions from a known or suspected asbestos containing material that is visually discernible.
- 68. Waste Transfer Airlock A decontamination system provided for transferring containerized waste from inside to outside of the work area.

1.3. NOTIFICATIONS

Notification of asbestos abatement activities shall be provided by Contractor as requires and in accordance with all applicable federal, state, and local agencies prior to the start of abatement activities.

1.4. REGULATORY COMPLIANCE

Regulatory Requirements shall include, but not be limited to:



OSHA: U.S. Department of Labor, Occupational Safety and Health Administration, (OSHA), including but not limited to:

Occupational Exposure to Asbestos, Tremolite, Anthophyllite, and Actinolite: Final Rules Title 29, Part 1910, Section 1001 and Part 1926, Section 1101 of the Code of Federal Regulations

Respiratory Protection: Title 29, Part 1910, Section 134 of the Code of Federal Regulations

Construction Industry: Title 29, Part 1926.1101 of the Code of Federal Regulations

Access to Employee Exposure and Medical Records: Title 29, Part 1910, Section 2 of the Code of Federal Regulations

Hazard Communication: Title 29, Part 1910, Section 1200 of the Code of Federal Regulations

Specifications for Accident Prevention Signs and Tags: Title 29, Part 1910, Section 145 of the Code of Federal Regulations

DOT: U.S. Department of Transportation (DOT), including, but not limited to:

Hazardous Substance: Title 29, Part 171 and 172 of the Code of Federal Regulations

EPA: U.S. Environmental Protection Agency (EPA), including but not limited to:

Asbestos Hazard Emergency Response Act (AHERA), 15 U.S.S. Section 2641

Asbestos Abatement Projects: Worker Protection Rule, Title 40 Part 763, Subpart G of the Code of Federal Regulations

National Emission Standard for Hazardous Air Pollutants (NESHAPS): National Emission Standard for Asbestos, Title 40, Part 61, Subparts A and B and Subpart M (Revised Subpart B) of the Code of Federal Regulations

Cal-OSHA: Title 8, Article 4, California Code of Regulations Construction Industry Safety Orders, Section 1529 "Asbestos" or current revised California regulations.

SCAQMD: South Coast Air Quality Management District, Rule 1403 and Rule 222

2.0 CONTRACTOR SUBMITTALS

2.1. Manufacturer's Product Data

- HEPA-Filtered Negative Air Equipment
- HEPA-Filtered Vacuum Equipment
- Respirators
- Pressure Differential Monitor
- Surfactants
- Encapsulants



2.2. Plan for Removal and Demolition of Asbestos

The Abatement Contractor shall prepare and submit a detailed job specific plan of the work procedure to be used in the removal and demolition of materials containing asbestos at least tw0-weeks prior to the start of work. A generalized "boiler-plate" type of plan will not be accepted.

- The plan shall be prepared and signed by the Contractor and Contractor's Competent Person
- Such plan shall include a sketch showing the location, size, and details of asbestos control areas, location and details of the change room, layout of the change room, details and location of waste container pass out airlock system, and locations of the HEPA-filtered negative air equipment, if applicable.
- The plan shall also include interface of trades involved in the construction, sequencing of the asbestosrelated work, disposal plan, type of wetting agent and removal encapsulates to be used, respirators, protective equipment, pressure differential monitoring devises, and a detailed description of the method to be employed in order to control pollution.
- The plan shall include copied of emergency, security, and contingency plans as follows:
 - A plan to provide emergency and fire evacuation for removing workers from the work zone. A copy of this plan shall be filed with the local fire and/or ambulance unit.
 - A plan for maintaining security of the work zone. The security plan shall provide a means for preventing accidental or unauthorized entry.
 - A contingency plan addressing emergency, equipment failures, and barrier failure. This plan shall include telephone numbers of representatives of the Contractor to be contacted in emergencies.
- The plan shall be approved b the Owner and/or Consultant prior to the start of asbestos abatement work.
- Prior to beginning work, the Owner and/or Consultant and Contractor shall meet and discuss in detail the asbestos plan, including work procedures and safety precautions.

2.3 Administrative and Contractor Closeout Submittals

2.3.1. Notification of Equipment Rental

If rental equipment is to be used during asbestos handling and disposal, written notification concerning the intended use of the equipment will be furnished to the rental agency, with a copy to the Owner and/or Consultant.

2.3.2. Landfill Delivery Records

Within three days after delivery of ACM and ACCM to the landfill, submit detailed delivery tickets and hazardous waste manifests, prepared, signed, and dated by an agent of the landfill, certifying the amount of materials delivered to the landfill.

2.3.3. Waste Disposal Site Approval

Submit the recommended waste disposal site to the Owner and/or Consultant for approval prior to the start of the project. Submit written evidence to the Owner and/or Consultant prior to disposal, that the waste disposal site is approved for asbestos disposal by the EPA and other applicable authorities. At job completion, these records shall be inserted into the job binder and transmitted to the Owner and/or Consultant.

2.3.4. Personnel Training Certificates

Prior to the start of ACM and ACCM abatement activities, the Contractor shall submit to the Owner and/or Consultant a declaration certifying that all of the Contractor's employees have been adequately trained in accordance with CCR Title 8, Section 1529. The Contractor shall also submit proof that all personnel who will be permitted to enter contaminated wok areas have been adequately trained in accordance with CCR Title 8, Section 1529 for certification as an Asbestos Worker of Supervisor for Class I and II asbestos abatement projects.



2.3.5. Medical Examination and Certification

Prior to the start of ACM and ACCM abatement activities, the Contractor shall submit proof that all personnel who will be permitted to enter contaminated work areas had had medical examinations in accordance with CCR Title 8, Section 1529 and 29 CFR 1910.134. In addition, the Contractor shall provide a written certification signed by a licensed physician that all workers and supervisors have meet or exceeded all of the medical prerequisites listed herein and in CCR Title 8, Section 1529 and 29 CFR 1910.134.

2.3.6. Testing Laboratory

The Contractor shall submit:

- The name, address, and telephone number of each testing laboratory selected for the sampling, analysis, and reporting of airborne concentrations of asbestos fibers along with evidence that each laboratory selected holds the appropriate state license and/or permits;
- Certification that each laboratory is American Industrial Hygiene Association (AIHA) accredited; and
- Persons counting the samples have been judged proficient by current inclusion on the AIHA Asbestos Analysis Registry and have been successfully participated in the laboratory in the Proficiency Analytical Testing Program.

2.3.7. Personal Air Sampling Results

The Contractor shall have performed complete fiber counting for personal air sampling and provide results to the Owner and/or Consultant for review within 48 hour of sample collection. The Contractor will notify the Owner and/or Consultant immediately of any airborne levels of asbestos fibers in excess of the PEL.

2.3.8. Pressure Differential Recordings

If utilized, the Contractor shall review and report the pressure differential recordings within 4 hours from the end of each work day, and immediately report to the Owner and/or Consultant variance in the minimum permissible pressure differential (0.02 inch water column, relative to adjacent, unsealed areas) that could cause adjacent unsealed areas to have asbestos fiber concentrations in excess of 0.01 fibers per cubic centimeter or background, whichever is greater.

2.3.9. Asbestos Disposal Quantity Report

The Contractor shall review and report to the Owner and/or Consultant, within 4 hours from the end of each workday, the amount of asbestos containing materials removed during the previous day.

2.3.10. Contractor Licensing Board Asbestos Certification

Submit a copy of the Contractor's California State Contractor's Licensing Board Asbestos Certification in accordance with the California Business and Professional Code, Section 7058.5, to the Owner and/or Consultant.

2.3.11. Contractor Class C Asbestos Removal License

Submit proof that the Contractor possesses a current California Class C Asbestos Removal License to the Owner and/or Consultant.

2.3.12. Hazardous Waste Hauler License and EPA Transporter's Number

Submit proof that the Contractor's Hazardous Waste Hauler possesses a current Hazardous Waste Hauler License and EPA Transporter's Number to the Owner and/or Consultant.



2.3.13. At Job Completion

Contractor shall transmit the job binder to Owner and/or Consultant. Contents shall be as describes in this section plus any additional items as designated by the Owner and/or Consultant.

2.4 Quality Assurance

- Where the methods or procedure are specified, they shall constitute the minimum measures and shall in no way relieve the Contractor of sole responsibility for the means, measures, methods, techniques, sequences, or safety measures in connection with the work.
- The removal of asbestos shall be supervised by a licensed supervisor who has experience in this field of construction and can furnish a record of satisfactory performance on at least three projects for work of comparable type and size.
- Subcontractor qualifications shall be the same in form and quantity as required for the Contractor.

3.0 PRODUCTS

Products to be supplied by the Contractor, include, but are not limited to, the following.

- Polyethylene: Polyethylene sheeting in various sizes to minimize the frequency of joints.
- Tape: Glass fiber or other tape capable of sealing joints of adjacent plastic sheets and for attachment of plastic sheeting to finished or unfinished surfaces of dissimilar materials under both dry and wet conditions.
- Surfactant (Wetting Agent)" Shall consist of materials that are non-toxic and non-irritating to skin and eye and non-carcinogenic. The wetting agent shall consist of 50% polyoxyethylene or pologlycolester and 50% polyoxyethylene ether, or the equivalent. Wetting agents shall be applied by means of an airless sprayer or equivalent.
- Encapsulant: Shall conform with EPA requirements, and shall contain no toxic or hazardous substances and no solvents.
- Impermeable Containers: Air and water-tight, suitable to receive and retain any asbestos-containing or contaminated materials until disposal time at an approved site and labeled in accordance with applicable Cal-OSHA regulations (CCR Title 8, Section 1529). Two types if impermeable containers shall be used:
- 6-millimeter (mil) plastic bags
- Metal of fiber drums with tightly fitting lids
- Warning Labels and Sighs: In conformance with applicable Cal-OSHA regulation (CCR Title 8, Section 1529).
- Other Materials: Provide all other materials, such as lumber, nails, and hardware that may be required to construct and dismantle the decontamination area and the barriers that isolate the work area.

4.0 EXECUTION

4.1. Material Handling

- Deliver materials in original packages, containers, or bundles bearing the name of the manufacturer and the brand nae
- Store materials subject to damage off the ground, away from wet or damp surfaces, and under cover sufficient to prevent damages or contamination.
- Removal of all ACMs from the premises. Dispose of materials that become contaminated with asbestos in accordance with applicable regulatory standards.



4.2 Equipment

4.2.1. Respirators

The Contractor shall provide workers with personally issued and marked respiratory equipment approved by National Institute for Occupational Safety and Health (NIOSH) and meeting the specifications of Cal-OSHA. The respiratory equipment shall be suitable for the asbestos exposure level in the work area according to CCR Title 8, Section 1529(i). The Contractor shall provide disposable HEPA (P100) cartridges as required, with sufficient replacement cartridges.

4.2.2 Personal Protective Equipment

The Contractor shall provide workers, the Owner and/or Consultant, and authorized visitors with sets of protective disposable clothing, lead covers, gloves, eye protection, and foot covers of sizes to properly fit individual workers and visitors whenever they are required to enter the work area. The Contractor shall also provide access and use of the Contractor's change room and provide a minimum of four sets of personal protective equipment (PPE) per day for visitors and sufficient sets as required for workers and the Owner and/or Consultant. The PPE, both new and used, shall remain the property of the Contractor.

4.2.3 Change Rooms

Provide a temporary unit with a separate equipment room, decontamination locker room, and a clean locker room for personnel requires to wear whole body protective clothing.

- Separate each room from the others and from the control area by airlocks
- Provide two separate lockers for each asbestos worker, one in each locker room
- Keep street clothing and street shoes in the clean locker
- Vacuum and remove asbestos contaminated disposable protective clothing while still wearing respirators in the equipment room. Seal clothing in impermeable bags of containers for disposal.
- Do not remove disposable protective clothing in the decontamination locker room
- Remove work clothing in the decontamination locker room
- Tag and bag cloth work clothes for laundering and keep work shoes in the decontamination locker room
- Do not wear work clothing between home and work
- Provide showers with hot and cold running water
- Locate showers between the decontamination locker room and the clean locker room and require employees to shower before changing into street clothes.
- Shower wastewater shall be handled and disposed of as ACM or shall be filtered through a final filter of at least 0.5-micron particle size collection capability before disposal into the sanitary sewer system.
- Handle and dispose of wastewater filters as ACM.
- Clean asbestos-contaminated work clothing in accordance with CCR Title 8, Section 1529 or use disposable clothing.
- Change rooms shall be physically attached to the work area whoever feasible and required.

4.2.4 Eye Protection

Furnish goggles for personnel engaged in asbestos operations when a full-face respirator is not being used.

4.2.5 Caution Signs and Labels

Provide caution signs printed in English and Spanish at approaches to asbestos work areas. Locate signs at such distances that personnel may read the sign and take the necessary precautions before entering the work area. Provide caution labels printed in English and Spanish. Affix labels to friable asbestos materials, scrap, waste, debris,



sealed impermeable bags, asbestos waste drums, and other asbestos containing products. Caution sign labels shall conform to the requirements defined in CCR Title 8, Section 1529.

4.2.5 Fire Extinguisher

A minimum of one 4A/60BC dry chemical extinguisher shall be maintained at each of the following locations:

- At each electrical panel
- At each corner of the work area
- Within 5 feet of the external entry to the shower room from the work area
- Within 5 feet of the external entry to the shower room from the clean room

4.3 Tools and HEPA-Filtered Negative Air System

Where a negative pressure enclosure is utilized, the Contractor shall provide a HEPA-filtered negative air system in accordance with American National Standards Institute (ANSI) Z9.2 and as specified herein.

4.3.1 HEPA-Filtered Negative Air System

Where a negative pressure enclosure is utilized, the Contractor shall provide a HEPA-filtered negative air system in each work area.

- Provide HEPA-filtered negative air equipment designed for a minimum of one work area air change every 15 minutes and additional air change flow rate sufficient to maintain a minimum pressure differential of minus 0.02 inches of water column relative to adjacent, unsealed areas.
- The HEPA-filtered negative air system shall operate continuously, 24 hours per day, until the asbestos control area enclosure is removed. The Contractor is responsible for providing all necessary manpower and/or equipment including but not limited to emergency power, security, and fire watch to ensure 24-hour operations.
- Replace filters as required to maintain the efficiency of the system
- The building heating, ventilation, and air conditioning system shall not be used as the HEPA-filtered negative air system for the work area.

4.3.2 Additional Ventilation Units

The Contractor shall provide additional units to the site in accordance with these Specifications for use inside the containment in the event engineering controls are not effective in controlling the fiber count below the PEL during the removal process. The unit(s) shall be placed inside the containment as additional filtration in manner to move the air away from the worker's breathing zones and towards the exhaust unit(s).

4.3.3 Backup Ventilation Units

The Contractor shall provide at a minimum one additional HEPA-filtered negative air system unit for up to every ten units on the site as a replacement in case a ventilation unit fails to operate properly. These backup units must be stored on site during the entire project duration.

4.3.4 Filters

Filters on vacuums and exhaust equipment shall be absolute HEPA-filters and Underwriters Laboratories (UL) 586 labeled.



4.3.5 Negative Pressure Differential Monitor

- The Contractor shall provide a manometer-type of magnehelic-type negative pressure differential monitor with minor scale divisions of 0.02 inches of water and accuracy within plus or minus 1%
- The Contractor will calibrate the manometer as recommended by the manufacturer.
- The Contractor shall furnish recorded readings of the pressure differential between locations in the work area and adjacent unsealed areas at the beginning of each workday and every two working hours thereafter.
- The Contractor will collect pressure differential readings at several points inside the work area, including the furthest point from the HEPA-filtered negative air equipment.

4.4 Worker Protection

4.4.1 Abatement Contractor Responsibility

Prior to commencement of work, all workers shall be instructed and shall be knowledgeable in the appropriate procedures of personal protection and asbestos removal.

The Contractor shall be solely responsible for enforcing worker protection requirements.

4.4.2 Reporting Unusual Events

When an event of unusual significant nature occurs at the site, the Contractor shall prepare and submit a special report listing chain of events, persons participating, responses, and similar pertinent information. When such events are known or predictable in advance, advise the Owner and/or Consultant at the earliest possible date. Unusual events would include breaches of containment.

4.4.3 Reporting Accidents

If a significant accident occurs at the site or anywhere else work is in progress, the Contractor shall prepare and submit appropriate reports to the Owner and/or Consultant. For this purpose, a significant accident is defined to include events where personal injury is sustained, or property loss if substance is sustained.

4.5 General Work Area Requirements

4.5.1 *Respirators*

- Workers shall always wear a respirator properly fitted on the face while in the work area
- Workers wearing tight-fitting face pieces shall be clean-shaven to the extent that the hair does not interfere with the sealing surface of the respirator. This must be documented by a standard respirator fit test.
- The Contractor shall instruct and train workers in proper respirator use.

4.5.2 Clothing

Workers shall war disposable, full-body coveralls and disposable head covers and footwear suitable for asbestos work in the work area.

4.6 Decontamination Unit Requirements

At all work areas, the Contractor shall set up a change room, shower, and equipment room outside the work area. Where feasible and required, the change room, shower and equipment room will be attached to the work area. All workers without exception shall:



- Remove and properly store street clothes in the change room and put on new disposable coveralls, head covers, footwear, and cleaned respirator before entering the work area
- Remove the disposable coveralls, head covers, and footwear in the equipment room and dispose of them in an appropriate asbestos waste container. Still wearing their respirator, workers shall proceed to the showers and remove their respirators while showering with soap and tempered water. Wetted HEPA respirator cartridges shall be disposed of in appropriate asbestos containers.
- This procedure shall be followed each time a worker leaves the work area
- Workers shall not eat, drink, smoke of chew gum or tobacco in the work area
- The Contractor shall also provide disposable coveralls, head coverings, and footwear to the Owner and/or Consultant.
- All persons entering the work area shall wear an approved respirator and disposable coveralls, head coverings, and footwear.

4.7 Personal Air Monitoring

Daily personal air monitoring shall be constructed by the Contractor in order to determine the airborne concentrations of asbestos to which workers may be exposed. Copies of the analytical results for the daily personal monitoring shall be submitted to the Owner and/or Consultant within 48-hours of sample collection.

4.8 Sign-In / Sign-Out Log and Daily Activity Report

- The Contractor shall maintain a sign-in / sign-out log in the immediate vicinity of the change room or any
 decontamination area. This log shall be maintained from the time the first activity is performed involving
 the disturbance of ACM and ACCM until the time final air test results. All persons entering the work area,
 including Contractor's workers, Owner and/or Consultant, and Government officials, shall be required to
 sign in and out each time upon entering and leaving the work area. All persons shall indicate name time,
 company or agency represented, and reason for entering the work area.
- The Contractor shall maintain a daily activity report describing work performed, materials and methods used, inspection(s) made, test(s) taken, and any unusual conditions or problems.
- Except for governmental inspectors having jurisdiction, no visitors shall be allowed in any work area, except as authorized by the Owner and/or Consultant.

4.9 Housekeeping

The Contractor shall at all times keep the premises free from accumulation of waste materials or rubbish caused by their employees. Bags of asbestos material and other waste materials shall be removed immediately at the completion of work. Maintain surfaces of the work area free of debris and keep waste from being distributed outside of the immediate work area.

4.9.1 Removal of Asbestos Waste Containers

The Contractor shall provide a waste container removal system. Asbestos waste containers shall not be removed through the change rooms. The waste container removal system shall consist of a wash-down station inside the work area, a washroom, a waste container holding area. Provide airlocks between each area and an airlock with access to outside the work area from the holding areas. Provide caution signs as specified herein for asbestos work areas. The waste container removal system shall be a temporary unit constructed to prevent the escape of asbestos fibers from the area. The system shall be physically attached to the work area. Personnel entering the waste container removal system shall not be used to enter or exit the work area. Access to outside the waste container removal system shall be sealed except during the removal of asbestos waste containers. Perform cleanup of the waste container removal system as specified herein for enclosed work areas. Do not remove the waste container removal system enclosure and caution signs prior to receipt of the Consultant's clearance sample results. All asbestos waste containers shall be removed from the work area daily.



4.9.2 Procedure for Disposal of Asbestos

Do not remove any ACM or ACCMs from the site without approval from the Owner and/or Consultant. Procedure for hauling and disposal of asbestos waste shall comply with 40 CFR 61, Subpart M and CCR Title 8.

4.10 Work Area Preparation

4.10.1 Warning Signs

The Contractor will provide Warning Signs meeting regulatory requirements at each visual and physical barrier.

4.10.2 Critical Barriers

Where appropriate, the Contractor shall seal all openings with two layers of 6-mil minimum polyethylene as a containment barrier to prevent leakage of air into the outside environment or other portions of the building. Individually seal ventilation openings in walls (supply and exhaust), wall-mounted fixtures, doorways, windows, convectors, and other wall and floor openings into the work area with adhesive tape alone or with two layers of polyethylene sheeting at least 6-mil (true), taped securely in place with adhesive tape.

4.10.3 Pre-Cleaning

- The Contractor shall pre-clean movable objects to be salvaged for the Owner within the proposed work areas using HEPA vacuum equipment or wet cleaning methods as appropriate. The Contractor shall move such items to storage or other areas as directed by the Owner.
- The Contractor shall pre-clean immovable objects such as mechanical and electrical equipment and fixtures within the proposed work area using HEPA vacuuming equipment or wet cleaning methods as appropriate.
- Prior to placing plastic sheeting, clean the work area(s) and immediately adjacent areas physically connected to abatement areas using HEPA vacuum equipment or wet-cleaning methods as appropriate. Do not use methods that raise dust such as broom sweeping or vacuuming with non-HEPA equipped vacuum cleaners.

4.10.4 Containment

Where necessary, the Contractor will contain work areas with two layers of 4-mil plastic sheeting on walls and ceilings, and two layers of 6-mil plastic sheeting on floors, or as otherwise directed in writing by the Owner and/or Consultant.

4.10.5 Decontamination Unit

The Contractor shall construct worker and waste container / equipment decontamination units in compliance with EPA guidelines. Provide sufficient numbers of lockers in change and clean rooms or worker's clothing with one locker reserved for Owner and or Consultant personnel.

4.10.6 Emergency Exits

The Contractor shall establish emergency exits and procedure for each work area, satisfactory to fire officials and provide fire extinguishers as required.



4.10.7 Work Area Maintenance

The Contractor shall ensure that barriers and plastic enclosures remain effectively sealed and taped. Inadvertent tears in plastic shall be repaired with fiber tape and the tear covered by plastic applied with spray-adhesive, overlapping the tear by 6 inches on all sides.

If, during performance of abatement work, suspect ACM is observed outside of abatement enclosures, or if damage occurs to the enclosure barrier(s), work shall stop immediately upon discovery, appropriate repairs will be made (by the Contractor), and all such debris will be collected using appropriate vacuums and wet methods.

5.0 ASBESTOS REMOVAL

5.1 General Work Area Requirements

In a work area, the Contractor shall:

- Remove and dispose of all ACMs, ACCMs and PACMs in accordance with the methods and procedure outlined in CCR Title 8, Section 1529.
- All asbestos removal shall be supervised by a competent person.
- Where appropriate, enclose work areas under differential air pressure for the duration of the asbestos removal and subsequent cleaning phases and until all areas have been air-tested and found to be in compliance with the specific air quality clearance level detailed in Section 6.2 of these specifications.
- Perform appropriate cleaning using HEPA vacuum or wet cleaning methods of all areas physically connected to areas receiving asbestos removal.
- Dispose of all contaminated or otherwise removed materials and wastes in sealed and labeled containers in an approved sanitary landfill.
- Never use high-pressure water streams to remove any type of ACM or ACCM.
- After removal, all surfaces shall be wet-cleaned and HEPA vacuumed to remove residual accumulated material. After cleaning, surfaces shall appear free of visible material.
- Prior to the removal of the plastic sheeting from the wall, apply approved sealant on all concrete or wood substrate, structural steel, and piping surfaces from which the material was removed and to plastic sheeting prior to its removal.
- Following related repair work remove any remaining floor and wall plastic, including seals on openings, and dismantle worker waste container/equipment decontamination areas and leave all areas clean.
- Eating, smoking, or applying cosmetics shall not be permitted in the work area.

5.2 Removal of OSHA Class I Materials

Removal of Class I Osha materials is anticipated for this project. Contractor shall remove the Class I OSHA materials in accordance with appropriate federal, state, and local regulations. The Contractor is responsible for processing any permits with the SCAQMD.

Should the Contractor choose to utilize mechanical methods of other means that would or could potentially render non-friable material friable, the Contractor shall adhere to the work practices for Class I OSHA materials in accordance with appropriate federal, state, and local regulations. The Abatement Contractor is responsible for processing any permits with the SCAQMD, for the removal of materials via mechanical methods or other means that could potentially render a non-friable material friable. Exterior stucco (Texture Coat) will be removed in containment.



5.3 Removal of OSHA Class II Materials

5.3.1 Vinyl Flooring Tile and/or Flooring Mastic

The Contractor is responsible for the removal / abatement of any of the identified flooring materials, per the construction bid documents. The Contractor shall demonstrate to the Consultant that the flooring materials do not extend underneath any of the fixtured, cabinets, o other permanent items, in each room, where removal / abatement of asbestos containing flooring materials is scheduled to occur.

The Contractor shall adhere to the following additional work practices regarding the removal of vinyl flooring tile and/or mastic:

- Vinyl floor and/or mastic shall be removed with hand tools and, to the extent feasible, substantially intact.
- Vinyl flooring and/or mastic removal operations involving the use of mechanized work methods, including motorized floor buffers and mechanical chipping, shall be conducted utilizing Class I work methods.
- Low-odor, solvent-based mastic removers may be used to remove ACM mastic, provided the waste generated is managed in accordance with applicable state and federal regulations. Use of solvent-based mastic removers will be followed by suitable rinse (as per manufacturer's recommendations) to remove any residual mastic remover.

5.3.2 Roofing Materials

The Contractor shall adhere to the following additional work practices regarding the removal of roofing materials:

- Roofing materials shall be removed with hand tools, and to the extent feasible, substantially intact.
- Roofing materials shall not be dropped or thrown to the ground. The material shall be carrier or passed down by hand, or the materials will be lowered to the ground via covered, dust-tight chute, crane, or hoist.
- The Contractor will spray large areas of roofing material thoroughly with amended water, using spray equipment recommended by the surfactant manufacturer and capable of providing a mist application to reduce the chance of release of fibers. Spray the roofing material repeatedly during the abatement work process to maintain wet conditions, but do not use excessive amounts of water that results in ponding or leakage into the building.
- While materials that have been removed remain on the roof, the material shall either be kept wet, placed in an impermeable waste container, or wrapped in plastic sheeting.

5.0 CLOSURE

6.1 Waste Labeling

- ACM should be placed in labeled, leak-tight containers and/or wrapping. The labels for friable ACMs shall contain all information as specified in Occupational Safety and Health Standards of the Department of Labor, under 1926.1101(k)(2)(iii) and Title 8, Section 5229, an any local regulations.
- For temporary storage on site, ACMs shall be stored in a secured area. The area shall be demarcated with Asbestos Warning Signs.

6.2 Clearance

- Work areas and all other decontaminated areas and cleaned areas shall be considered clean when:
 - The work area passes a visual inspection by the Consultant and
 - Air testing performed by the Consultant, complies with the EPA recommended re-occupancy level of 70 structures per square millimeter, when analyzed by Transmission Electron Microscopy).
- TEM analysis will be conducted in accordance with EPA AHERA Regulations



- Areas that do not comply with the standard of cleaning for final clearance shall continue to be cleaned by and at the Consultant's expense until the specified standard is achieved a evidence by results of air sampling tests by the Consultant. The costs of all follow-up tests necessitated by the failure of the air tests to meet the cleaning criteria shall be borne by the Contractor. Follow-up testing shall occur within a time allotted for gross removal or all costs to the Owner, attributed to delayed occupancy or usage, shall be borne by the Contractor.
- When the clearance is achieved, as indicated above, and an inspection determined that the area has been
 visually decontaminated, the decontamination enclosure system shall be removed, the area thoroughly wet
 cleaned, and materials from the equipment room and shower disposed of as contaminated waste. The
 remaining barriers between contaminated and clean areas and all seals on openings into the work area and
 fixtured shall be removed and disposed of as contaminated waste.

6.3 Tear Down

All plastic sheeting, tape, cleaning materials, clothing, and all other disposable material used in the asbestos removal operation or item used in the work area shall be packed into sealable 6-mil plastic bags. These bags must be marked with labels as required by Cal-OSHA in CCR Title 8, Section 1529.

END OF SECTION